



GUARDRAIL AND END TREATMENT SCHEDULE

SHEET NUMBER	FROM STATION	TO STATION	LEFT	RIGHT	REMOVE EXISTING G.R. END TREATMENT *		INSTALL NEW G.R. END TREATMENT				INSTALL NEW GUARDRAIL (L.F.)	
					(NEAR-SIDE)	(FAR-SIDE)	(NEAR-SIDE)		(FAR-SIDE)			
							TYPE	L.F. *	TYPE	L.F. *		
PROJECT NO. 11BC-01-01M												
19	** ① 568+44	570+70		●	NONE	NONE	0	F-350	37.5	MOD-G R=20'	20	106 125
22	② 630+86	13+92		●	TYPE-G	NONE	94	MOD-G R=20'	20	MOD-F-350 A-1	37.5 25	55 50
22	③ 18+39	16+93	●		SRT	TYPE-G	20	F-350	37.5	MOD-G R=20'	20	0 37.5
22	④ 14+47	13+98	●		NONE	NONE	50	NONE		MOD A-1	25	25
22	-4+59	-2+44		●	TYPE-G	TYPE-G	40	MOD-G R=20'	20	MOD-G R=20'	20	0
25	⑤ 16+77	14+44		●	NONE	NONE	0	NONE		NONE		75 212.5
25	-15+39	-12+79	●		MOD-A	MOD-A	126	MOD A-1	25	MOD A-1	25	212 37.5
** SEE BELOW												
	① 568+27	569+51										
	② 631+08	631+58										
	③ -18+00	-17+63										
	④ -13+84	-13+59										
	⑤ -16+53	-14+42										
TOTALS							330.00	F-350 (2) MOD A-1 (1) MOD-G (2)	140.00	F-350 (1) ₃ MOD A-1 (2) MOD-G (3)	147.50 135.00	473.00 487.50

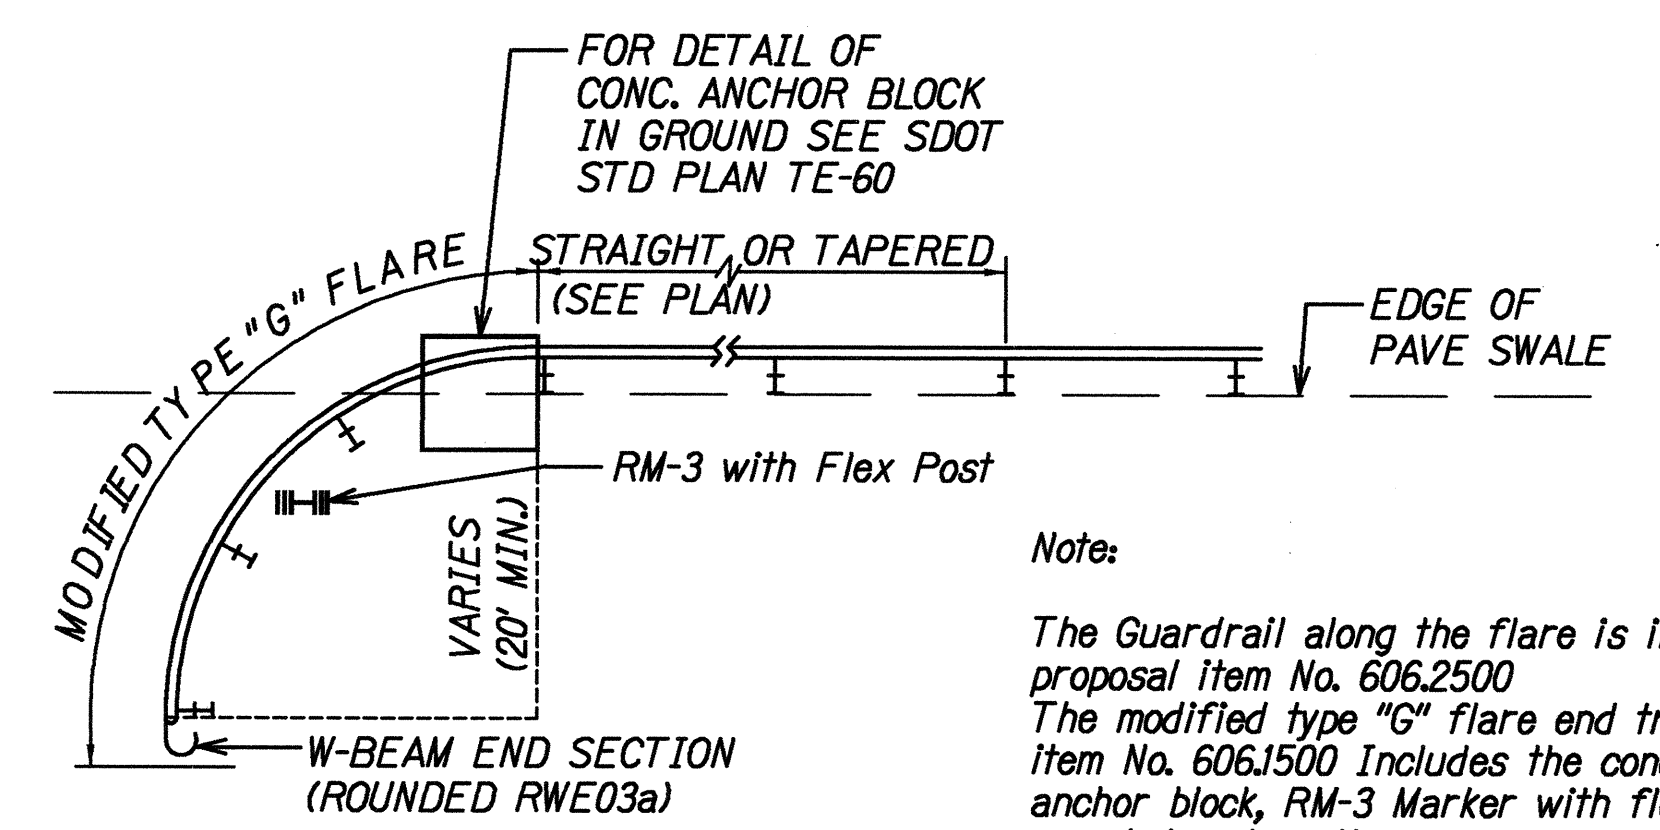

Note:
The Guardrail along the flare is included in proposal item No. 606.2500
The modified type "G" flare end treatment item No. 606.1500 includes the concrete anchor block, RM-3 Marker with flex post, rounded end section.

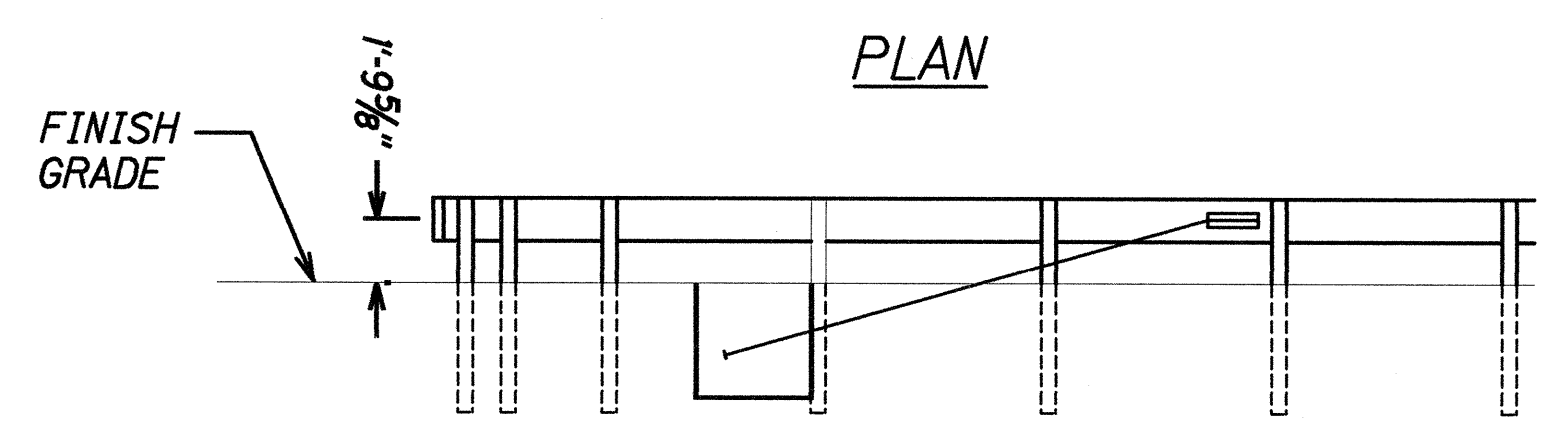

MODIFIED TYPE "G" END TREATMENT (TYP.)
SCALE: N.T.S.

* - REMOVAL SHALL BE CONSIDERED INCIDENTAL TO GUARDRAIL END TREATMENT

NOTE:

1. FLEAT-350 ABBREVIATED AND SHOWN AS F-350
2. MODIFIED TYPE A-1 ABBREVIATED AND SHOWN AS MOD A-1
3. MODIFIED TYPE G ABBREVIATED AND SHOWN AS MOD-G

ORIGINAL PLAN	DATE
SURVEY PLOTTED BY	
DRAWN BY	
TRACED BY	
DESIGNED BY	
CHECKED BY	
NOTE BOOK NO.	

THIS WORK WAS PREPARED BY ME OR UNDER MY SUPERVISION AND CONSTRUCTION OF THIS PROJECT WILL BE UNDER MY OBSERVATION.
Masahiro Nishida
 DATE: March 29, 2001

STATE OF HAWAII
 DEPARTMENT OF TRANSPORTATION
 HIGHWAYS DIVISION
GUARDRAIL SCHEDULE
 HAWAII BELT ROAD RESURFACING
 HONOKUA TO PAHOEHOE
 PROJECT NO. 11BC-01-01M
 Scale: None Date: March, 2001
 SHEET No. 28 OF SHEETS

"AS-BUILT"