


FED. ROAD DIST. NO.	STATE	PROJ. NO.	FISCAL YEAR	SHEET NO.	TOTAL SHEETS
HAWAII	HAW.	11M-02-02M	2002	14	58

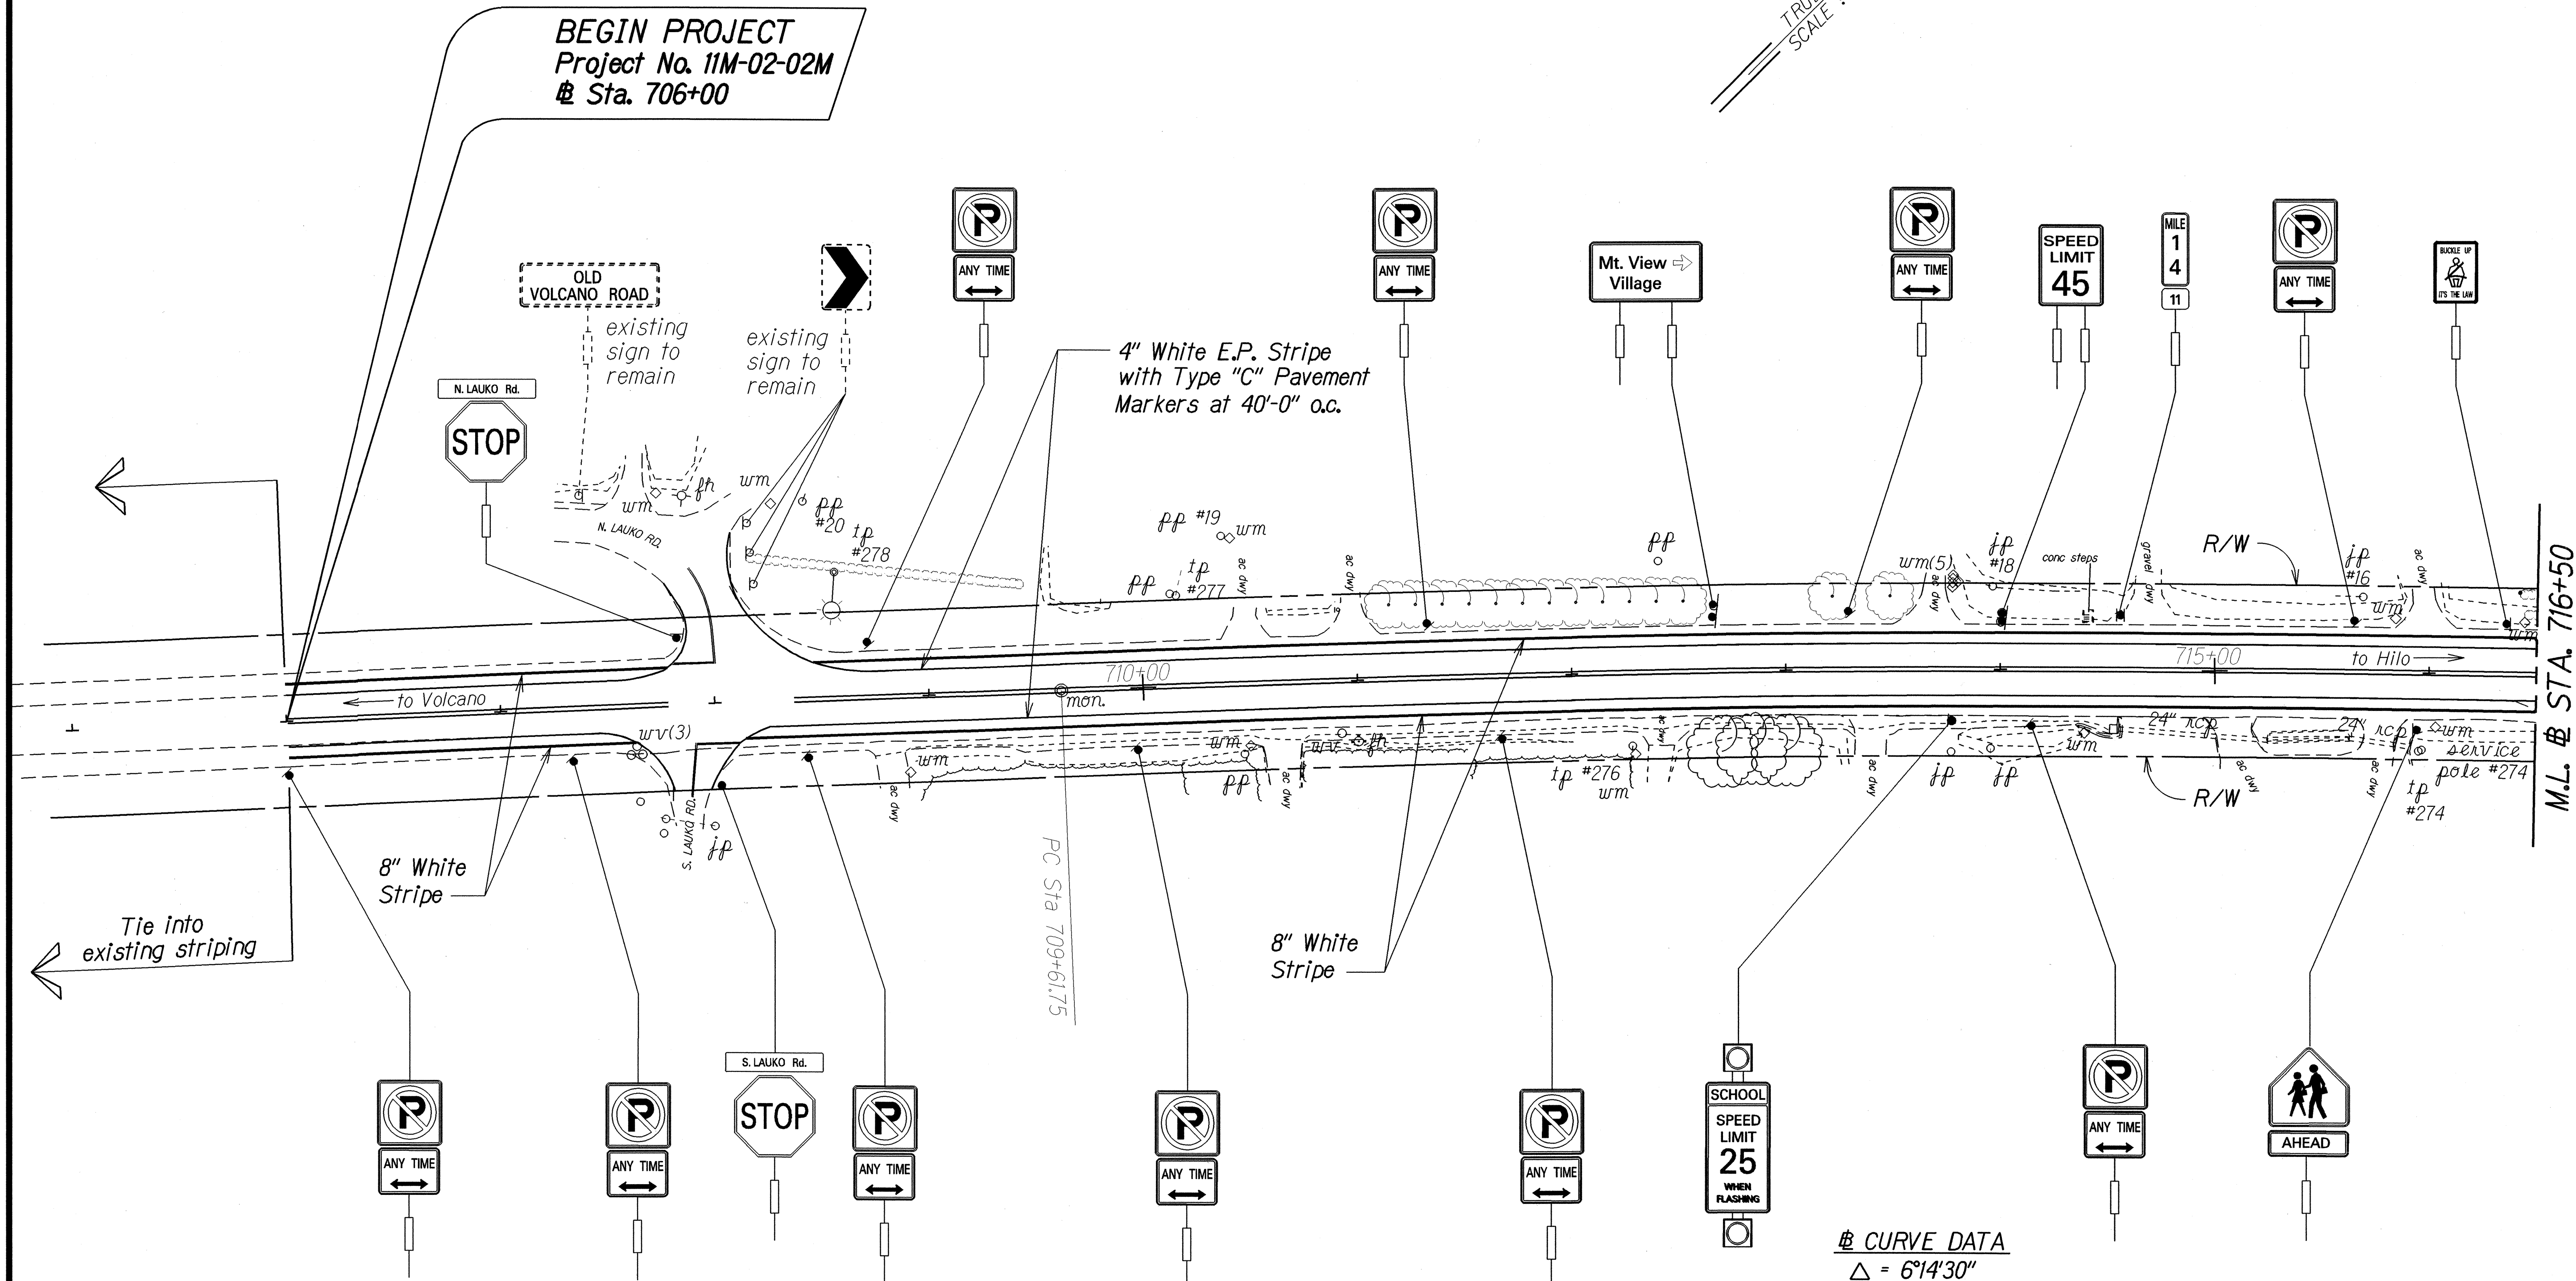

TRUE NORTH
SCALE: 1" = 40'

CURVE DATA
 $\Delta = 6^\circ 14' 30''$
 $D = 00^\circ 30' 00''$
 $R = 11,459.16'$
 $T = 624.79'$
 $L_c = 1,248.33'$
 $C = 1,247.72'$
 $S. E. = 0.04 \text{ ft/ft}$

SURVEY PLOTTED BY	DATE
DRAWN BY	
DESIGNED BY	
QUANTITIES BY	
CHECKED BY	

STATE OF HAWAII
DEPARTMENT OF TRANSPORTATION
HIGHWAYS DIVISION


**ROADWAY PLAN
SIGNAGE AND STRIPING**

VOLCANO ROAD RESURFACING
VICINITY OF MOUNTAIN VIEW SCHOOL
PROJECT NO. 11M-02-02M

Scale: 1" = 40' Date: April, 2002

SHEET No. 1 OF 2 SHEETS

FED. ROAD DIST. NO.	STATE	PROJ. NO.	FISCAL YEAR	SHEET NO.	TOTAL SHEETS
HAWAII	HAW.	11M-02-02M	2002	15	58

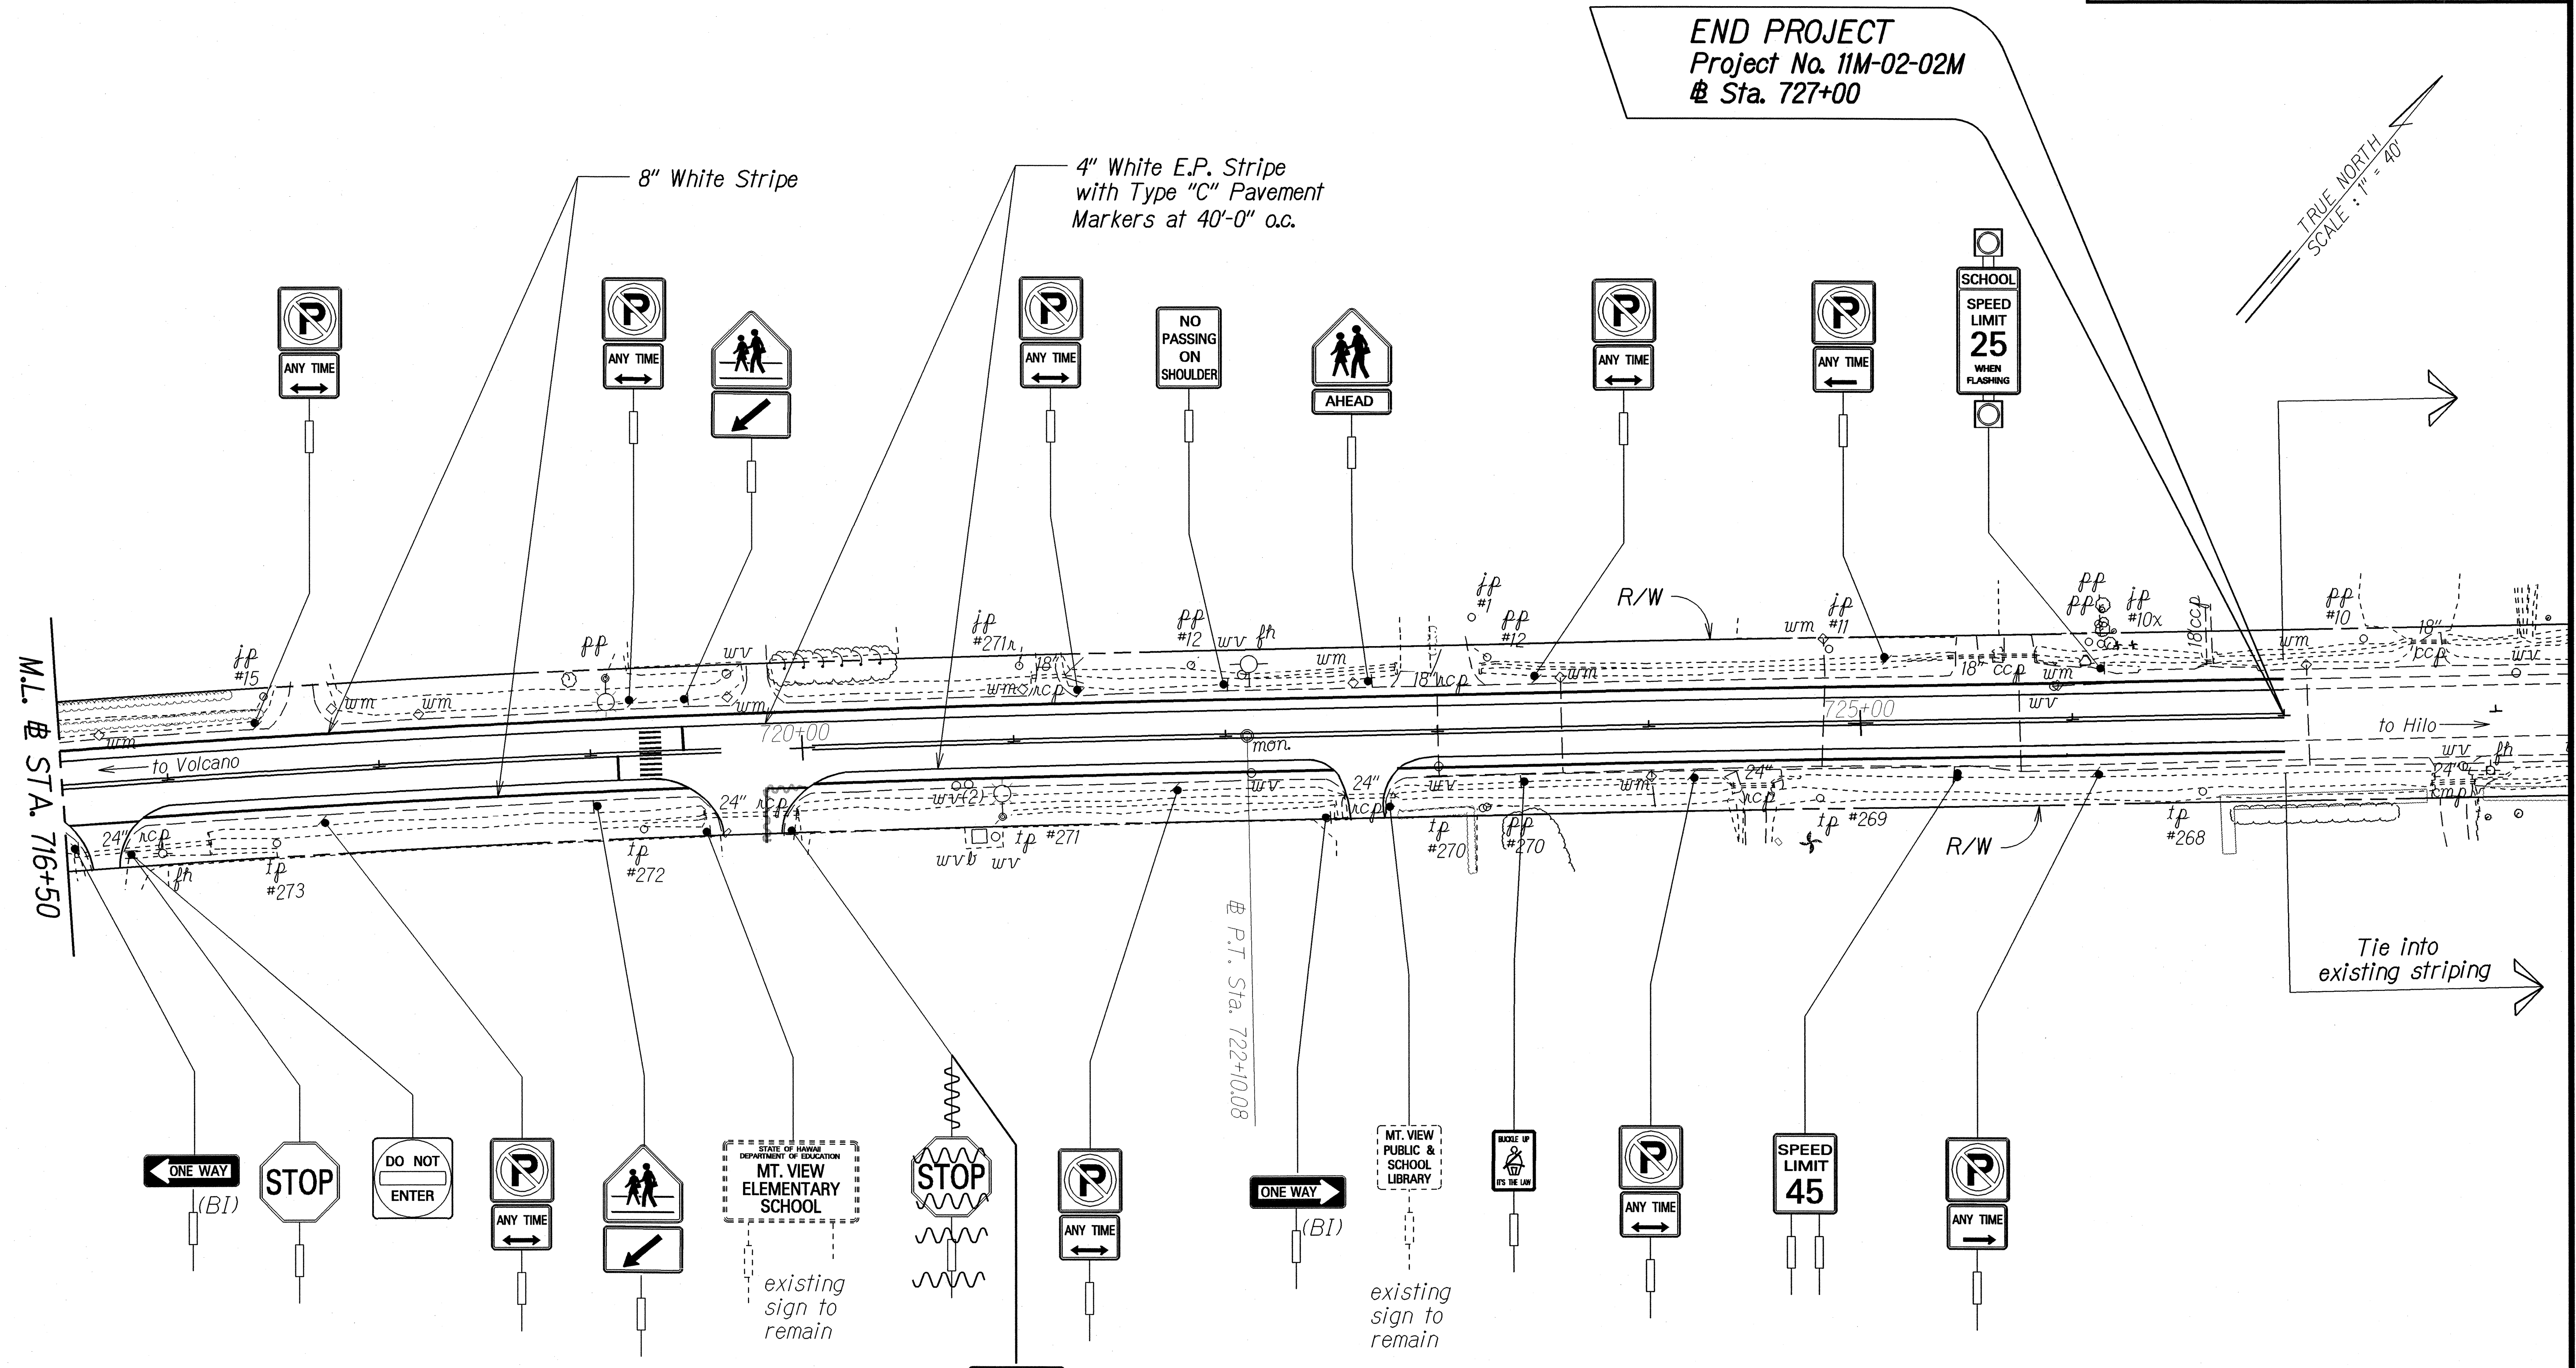

CURVE DATA
 $\Delta = 6^{\circ}14'30''$
 $D = 00^{\circ}30'00''$
 $R = 11,459.16'$
 $T = 624.79'$
 $L_c = 1,248.33'$
 $C = 1,247.72'$
 $S. E. = 0.04 \text{ ft/ft}$

LEGEND FOR AS-BUILT POSTINGS	
	Squiggly line for as-built deletion
	Double line for as-built deletion
Roadway	Text for as-built posting

STATE OF HAWAII
DEPARTMENT OF TRANSPORTATION
HIGHWAYS DIVISION

ROADWAY PLAN
SIGNAGE AND STRIPING
VOLCANO ROAD RESURFACING
VICINITY OF MOUNTAIN VIEW SCHOOL
Project No. 11M-02-02M

Scale: 1" = 40' Date: April, 2002

SHEET No. 2 OF 2 SHEETS

DATE: _____
SURVEY PLOTTED BY: _____
DRAWN BY: _____
DESIGNED BY: _____
CHECKED BY: _____

"AS-BUILT"