


INDEX TO DRAWINGS	
SHEET NO.	DESCRIPTION
1	TITLE SHEET
2	STANDARD PLANS SUMMARY
3	GENERAL NOTES
4	TYPICAL SECTIONS
5 - 6	NPDES GENERAL NOTES
7	LEGEND
8 - 9	ROADWAY PLANS
10 - 11	ROADWAY PLAN RECONSTRUCTION AREAS
12	RECONSTRUCTION AREA SCHEDULE AND DETAILS
13	PAVEMENT MARKING LEGEND & NOTES
14 - 15	ROADWAY PLAN SIGNAGE AND STRIPING
16	SIGN NOTES
17	SIGN DETAILS
18	SIGN SCHEDULE
19	MISCELLANEOUS SCHEDULES
20	CONSTRUCTION SIGN PLAN & SCHEDULE
21 - 39	CROSS SECTIONS
40	GUARDRAIL AND REFLECTOR MARKER SCHEDULE
41	GUARDRAIL DETAILS AND NOTES
42 - 58	GUARDRAIL DETAILS

Sheet Nos. 198-1 and 405-1 are supplementary sheets to this project. Total sheet count after "As-Built" posting 60 sheets.




HAWAII DISTRICT DESIGNED BY
ROBERT TAIRA
P.S. & E. BY
933-8866
PHONE
MAY, 2002
DATE

STATE OF HAWAII
DEPARTMENT OF TRANSPORTATION
HIGHWAYS DIVISION
HONOLULU, HAWAII
"AS-BUILT"
PLANS FOR
VOLCANO ROAD RESURFACING
VICINITY OF MOUNTAIN VIEW SCHOOL
PROJECT NO. 11M-02-02M
DISTRICT OF PUNA
ISLAND OF HAWAII

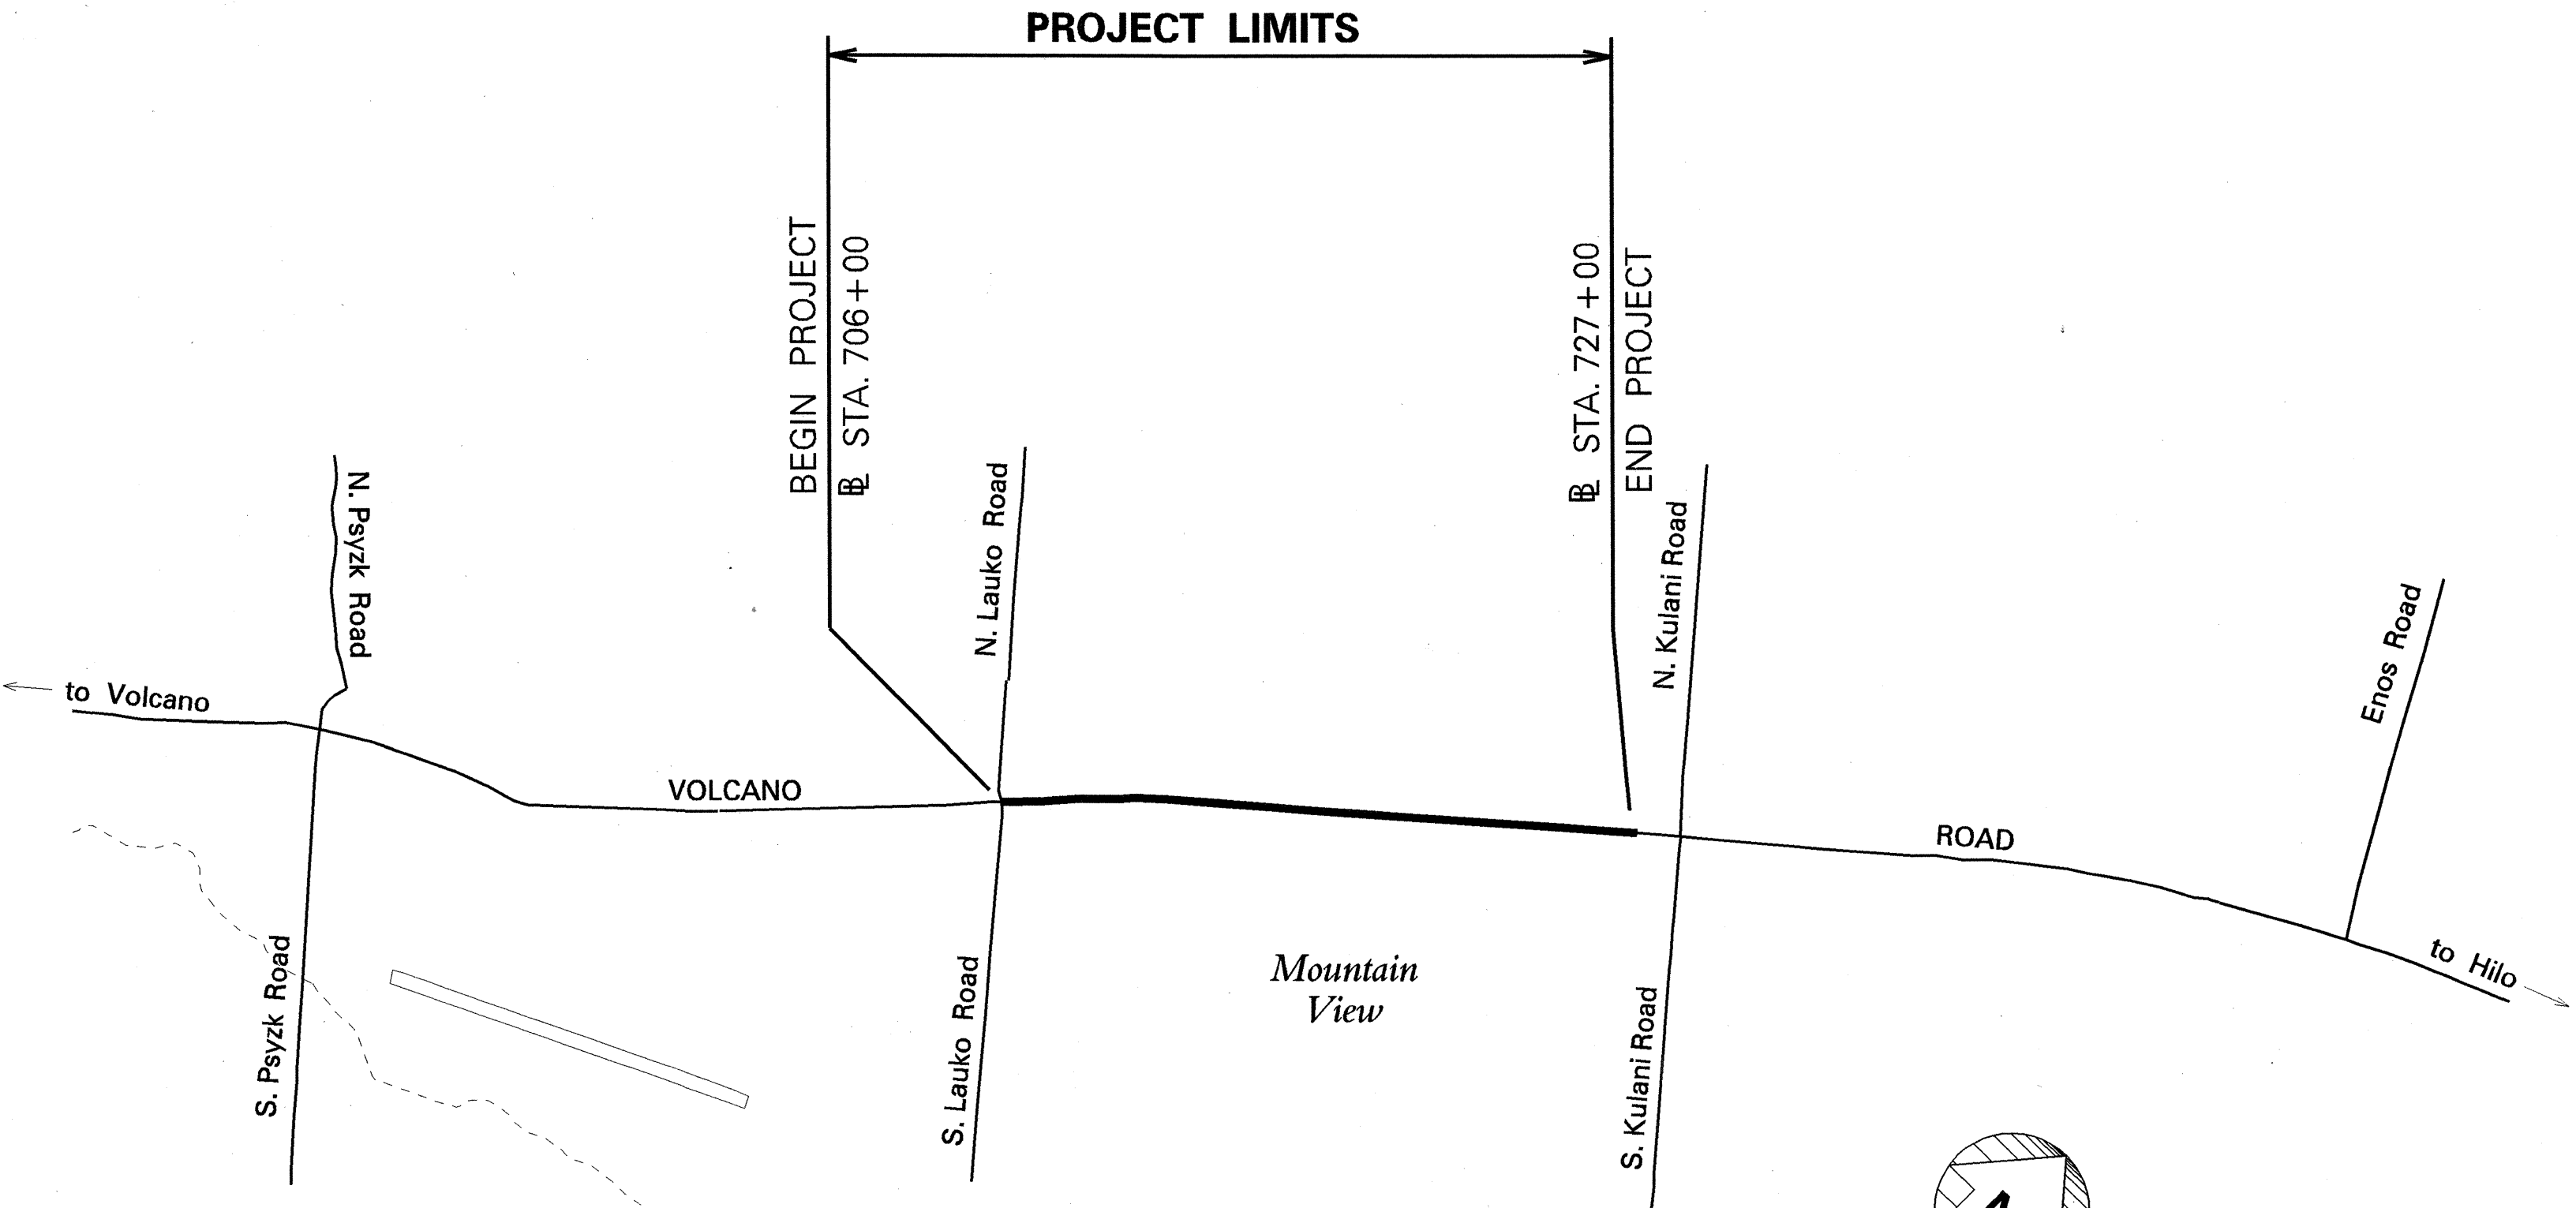

LAYOUT PLAN
NET LENGTH OF PROJECT..... 0.40 MILES

FED. ROAD DIST. NO.	STATE	PROJ. NO.	FISCAL YEAR	SHEET NO.	TOTAL SHEETS
HAWAII	HAW.	11M-02-02M	2002	1	58

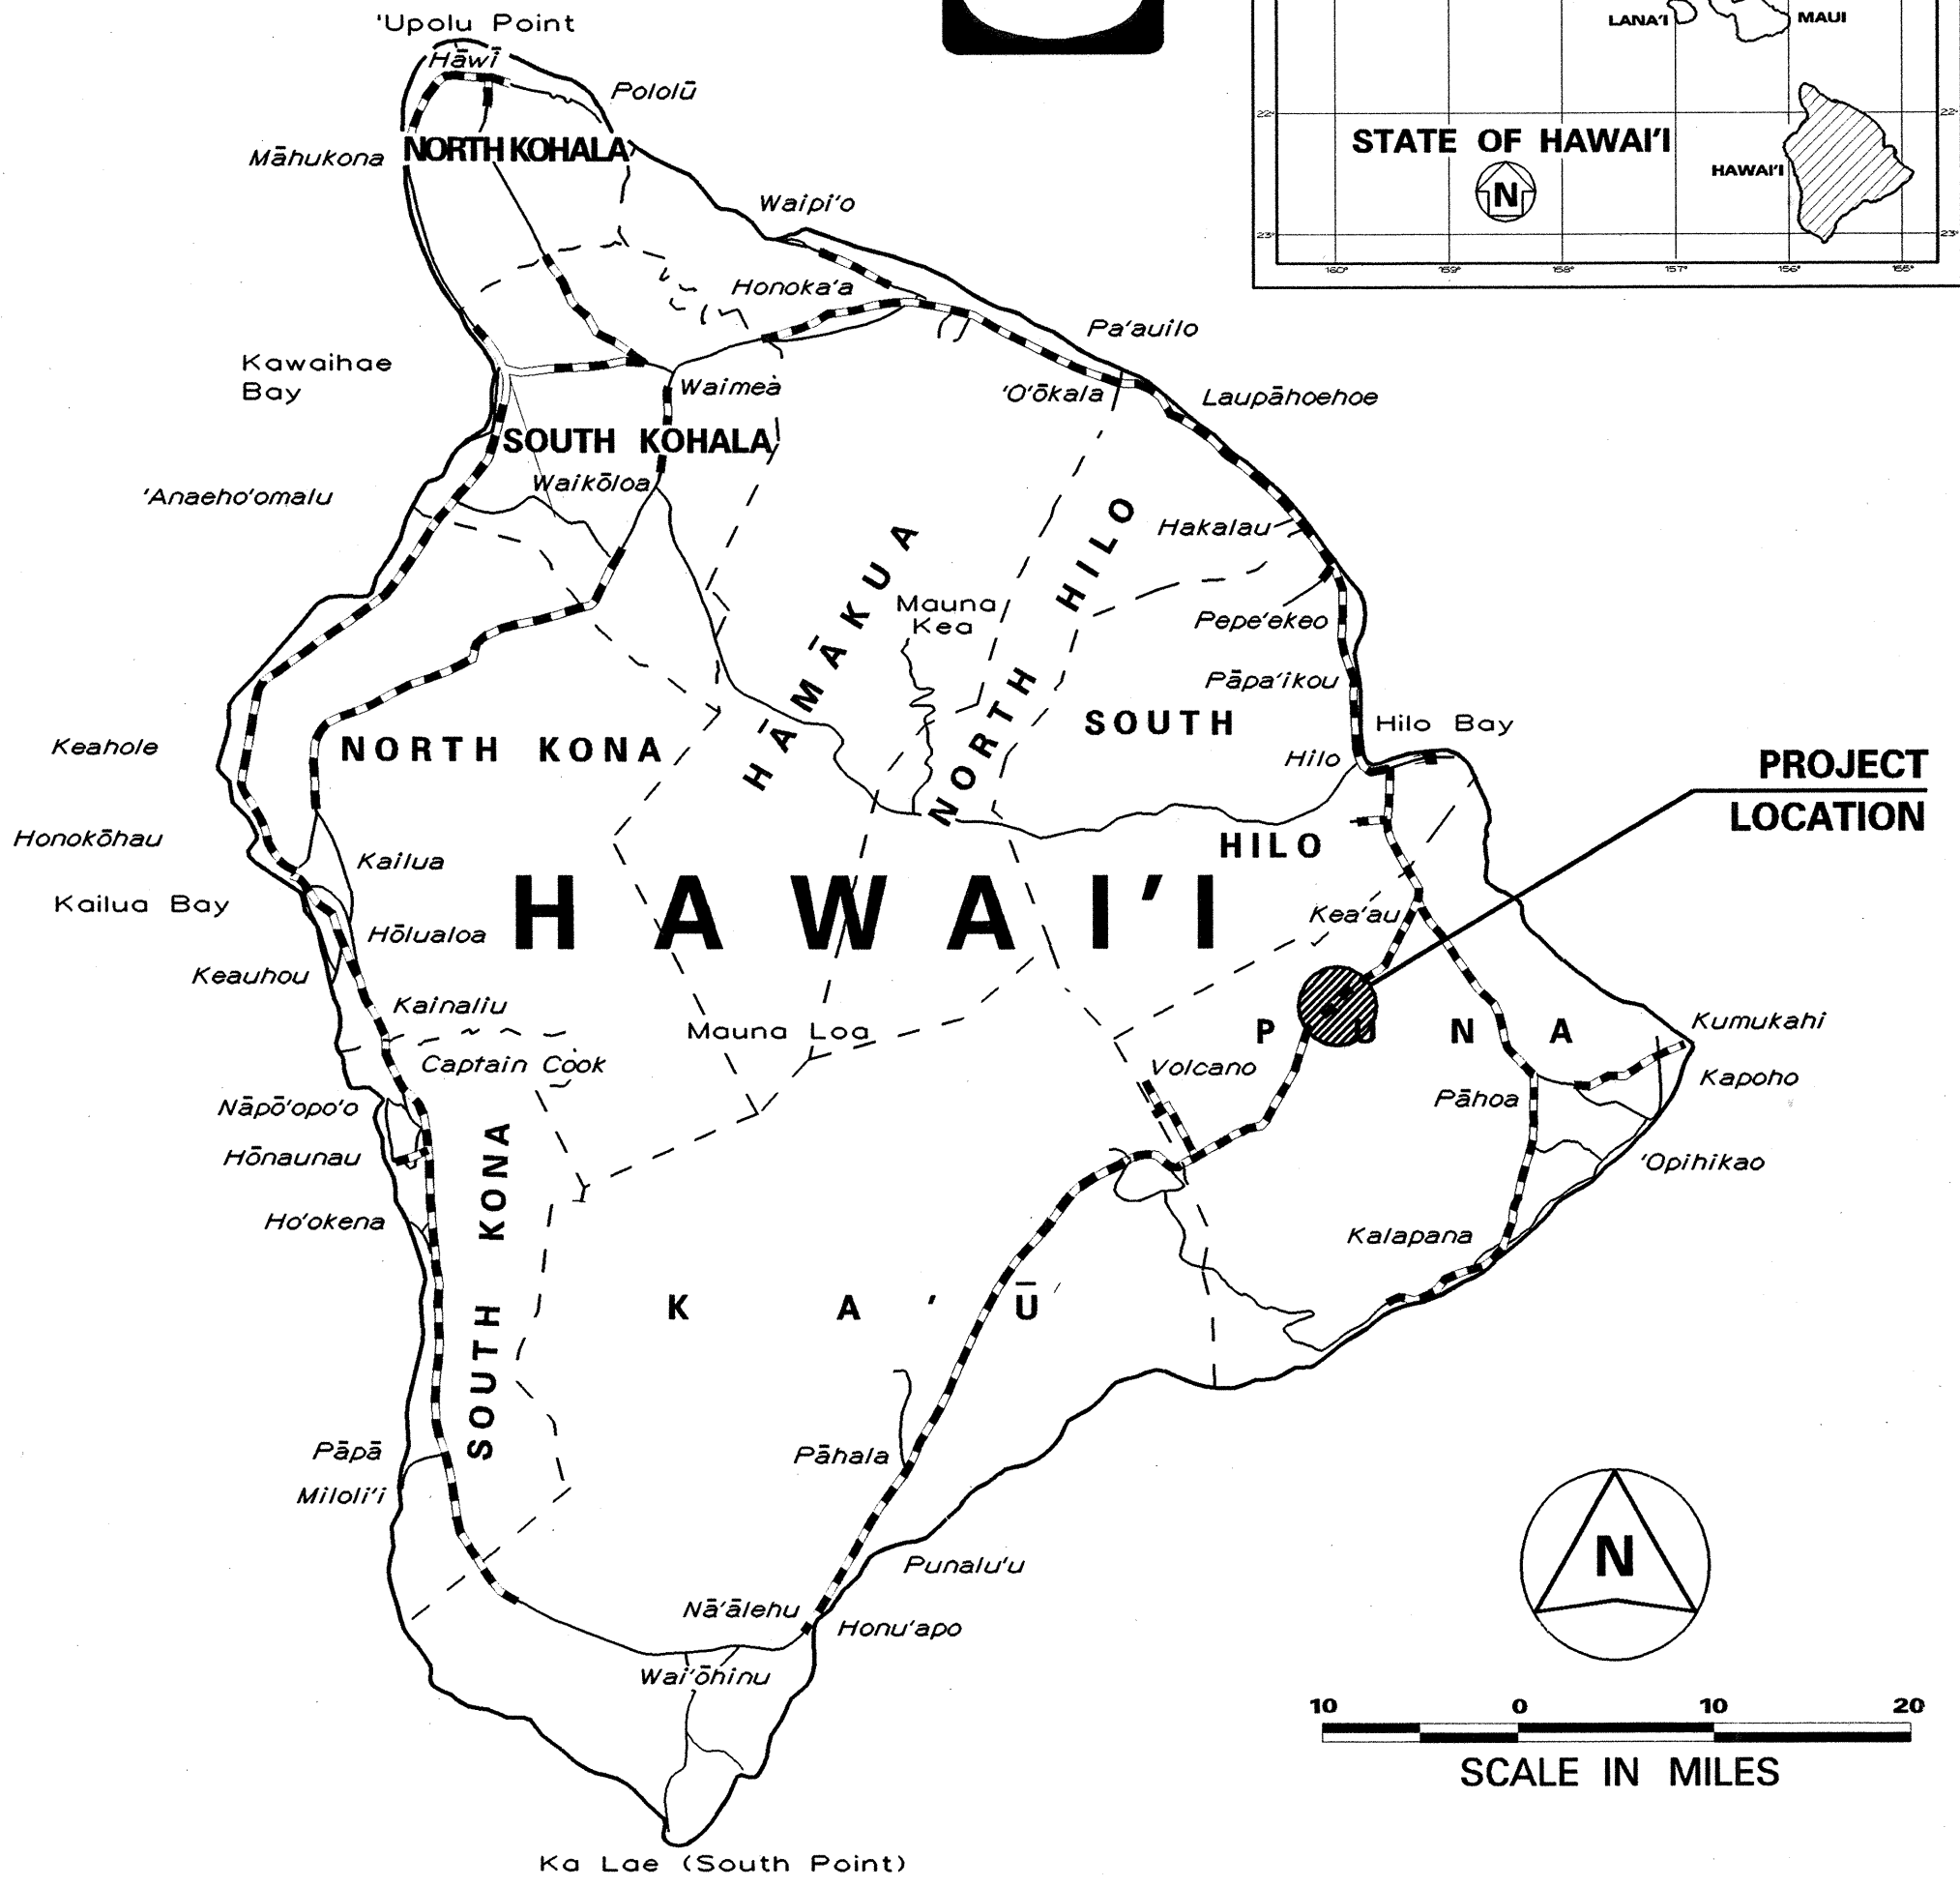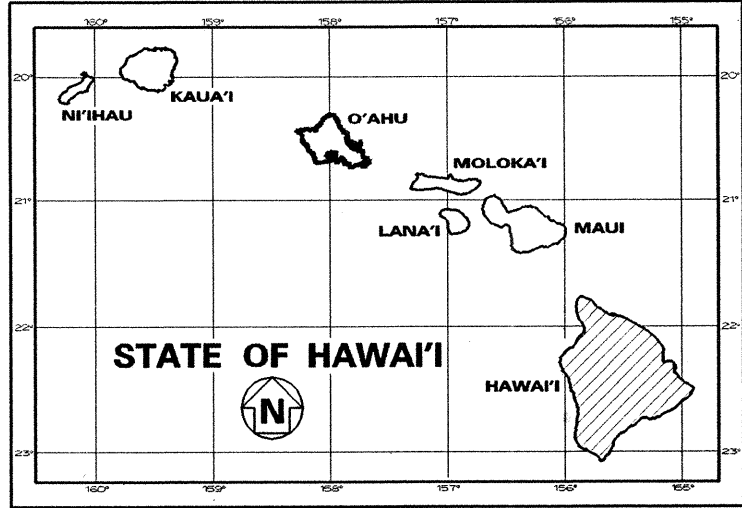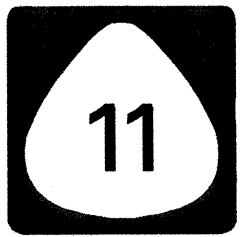

----- FEDERAL AID PROJECTS PREVIOUSLY CONSTRUCTED OR UNDER CONSTRUCTION

MILE POST 14.16 TO MILE POST 13.76

CHANGES MADE DURING CONSTRUCTION HAVE BEEN INCORPORATED ON THESE PLANS EXCEPT CHANGES IN THE ORIGINAL THEORETICAL QUANTITIES. FOR ACTUAL QUANTITIES, REFER TO PROJECT LEDGER AND/OR SUPPLEMENTARY BOOK.
7/17/03
RESIDENT ENGINEER DATE

DEPARTMENT OF TRANSPORTATION
STATE OF HAWAII
APPROVED:
5-13-02
DATE