



FED. ROAD DIST. NO.	STATE	PROJ. NO.	FISCAL YEAR	SHEET NO.	TOTAL SHEETS
HAWAII	HAW.	11A-01-02	2003	7	30

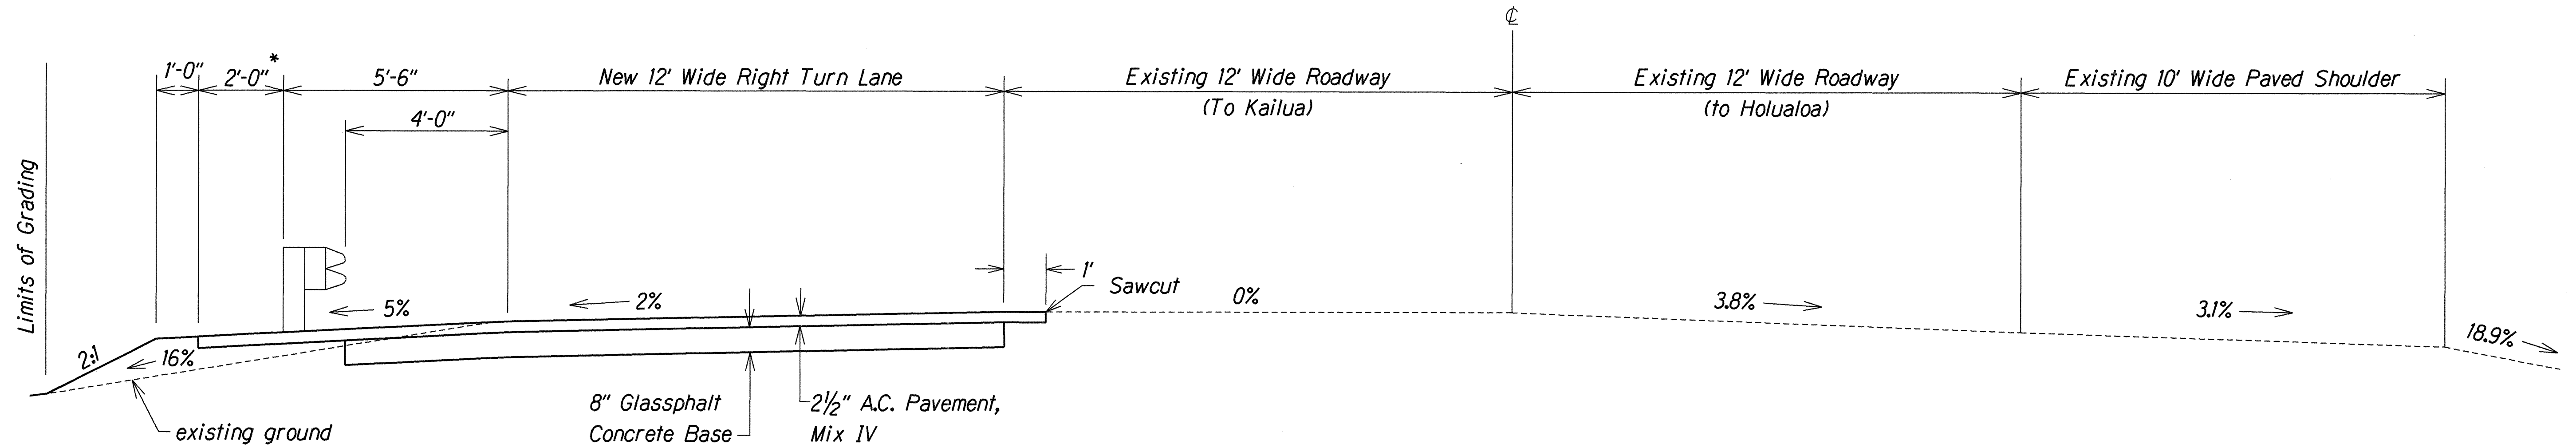

* This Detail For Paving Behind Guardrails Supersedes the Detail Shown on Sheet 10.


TYPICAL SECTION - HUALALAI ROAD

Scale: 1/2"=1'-0"

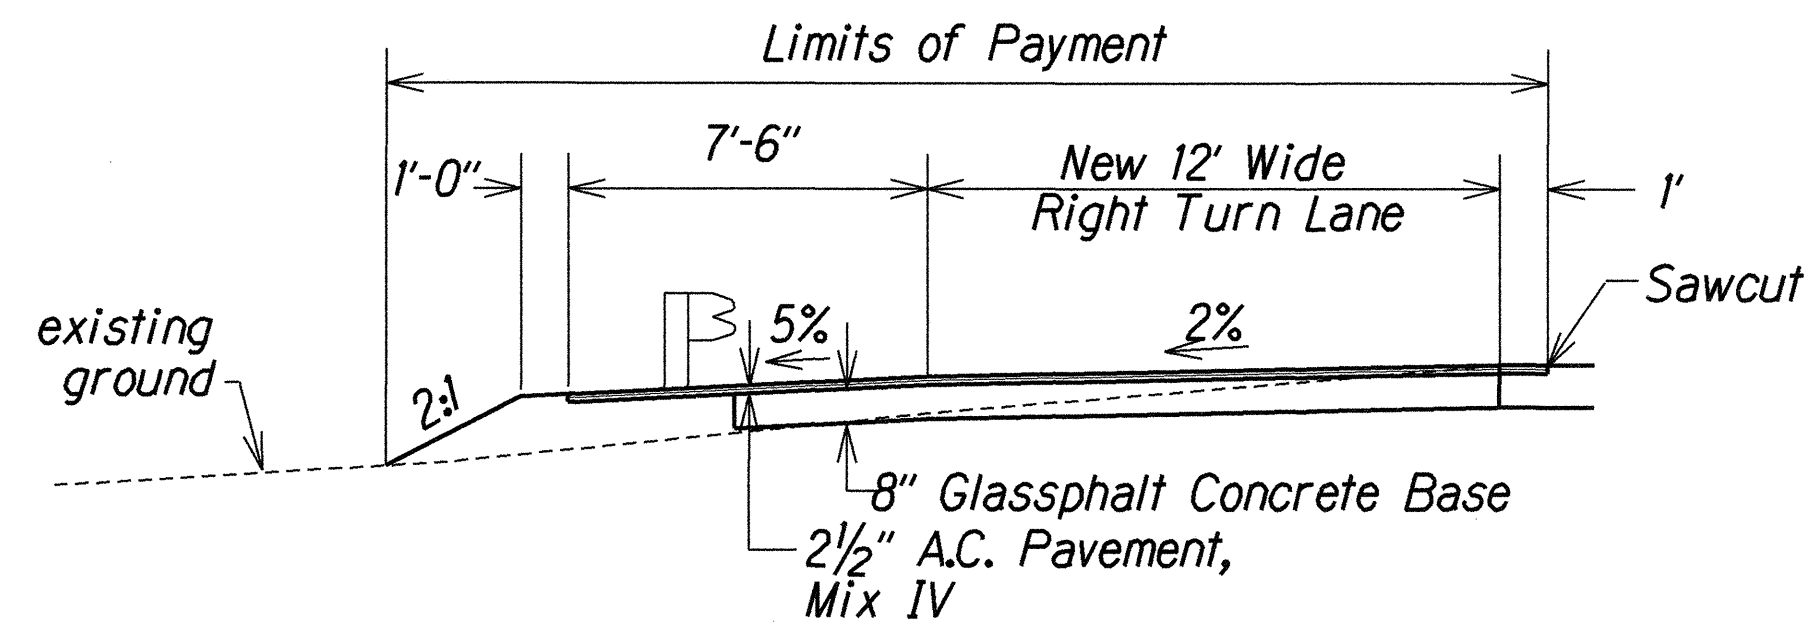


HUALALAI ROAD - Sta. 0+80

Scale: 1/4"=1'-0"

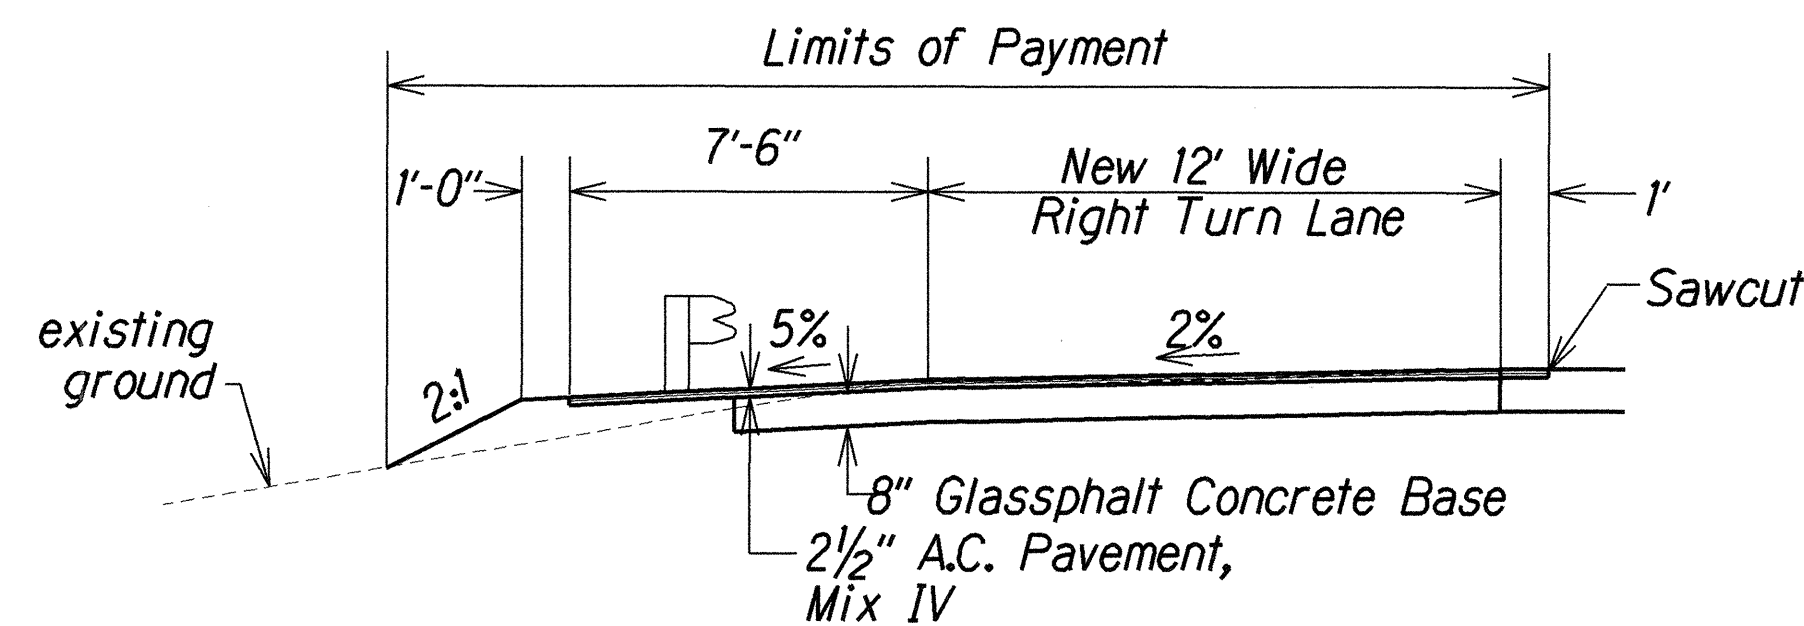


HUALALAI ROAD - Sta. 1+80

Scale: 1/4"=1'-0"

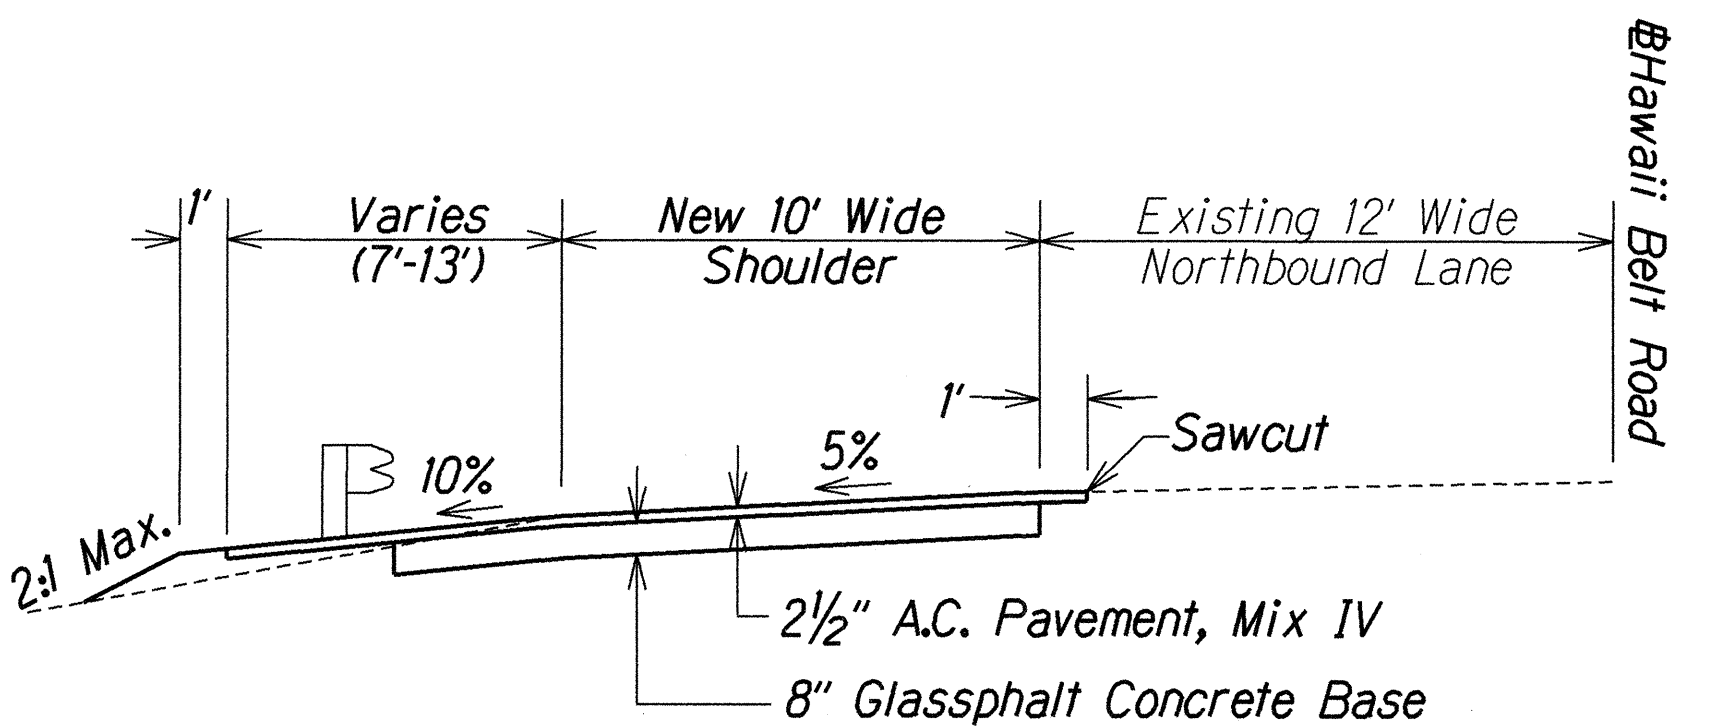


HAWAII BELT ROAD

Scale: 1/4"=1'-0"

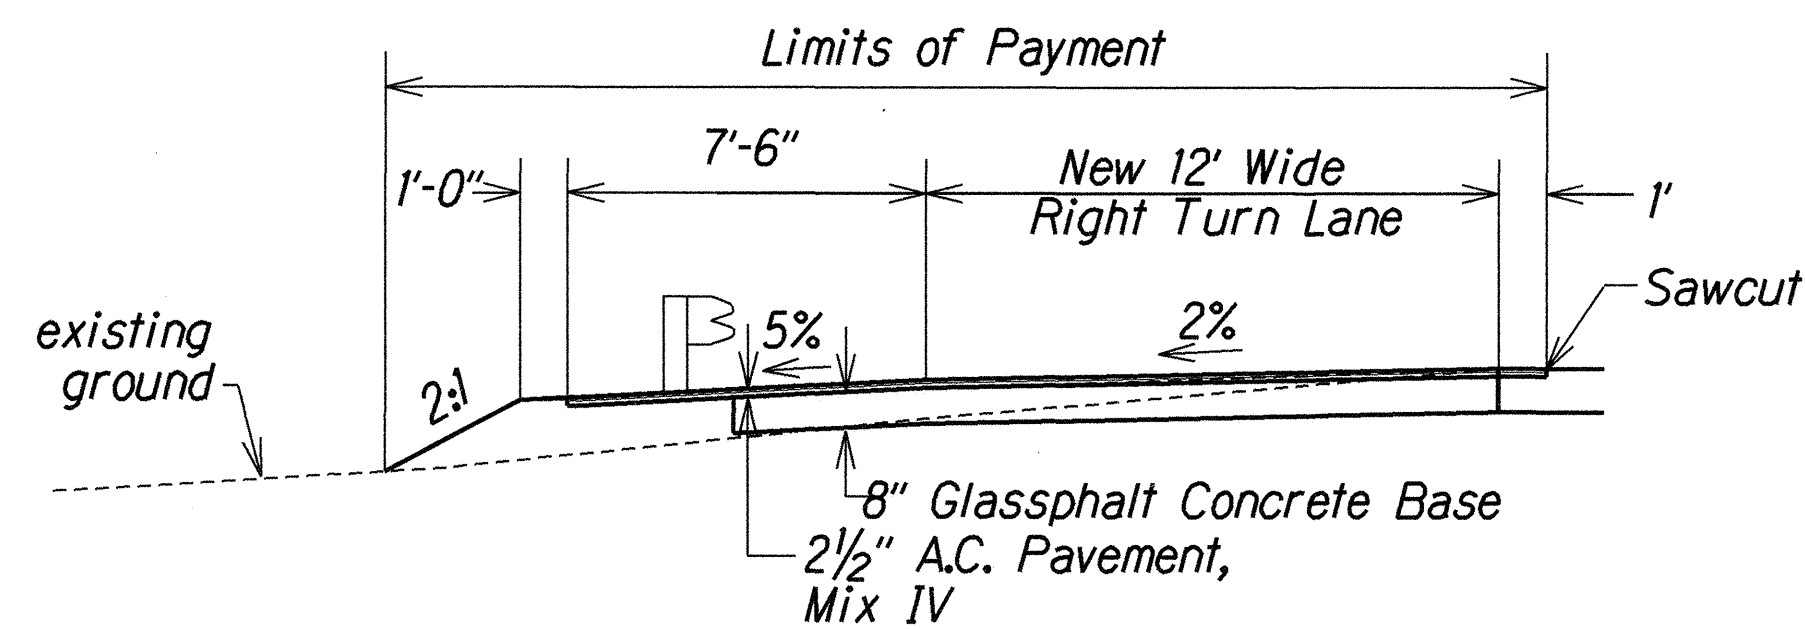

HUALALAI ROAD - Sta. 1+30


Scale: 1/4"=1'-0"

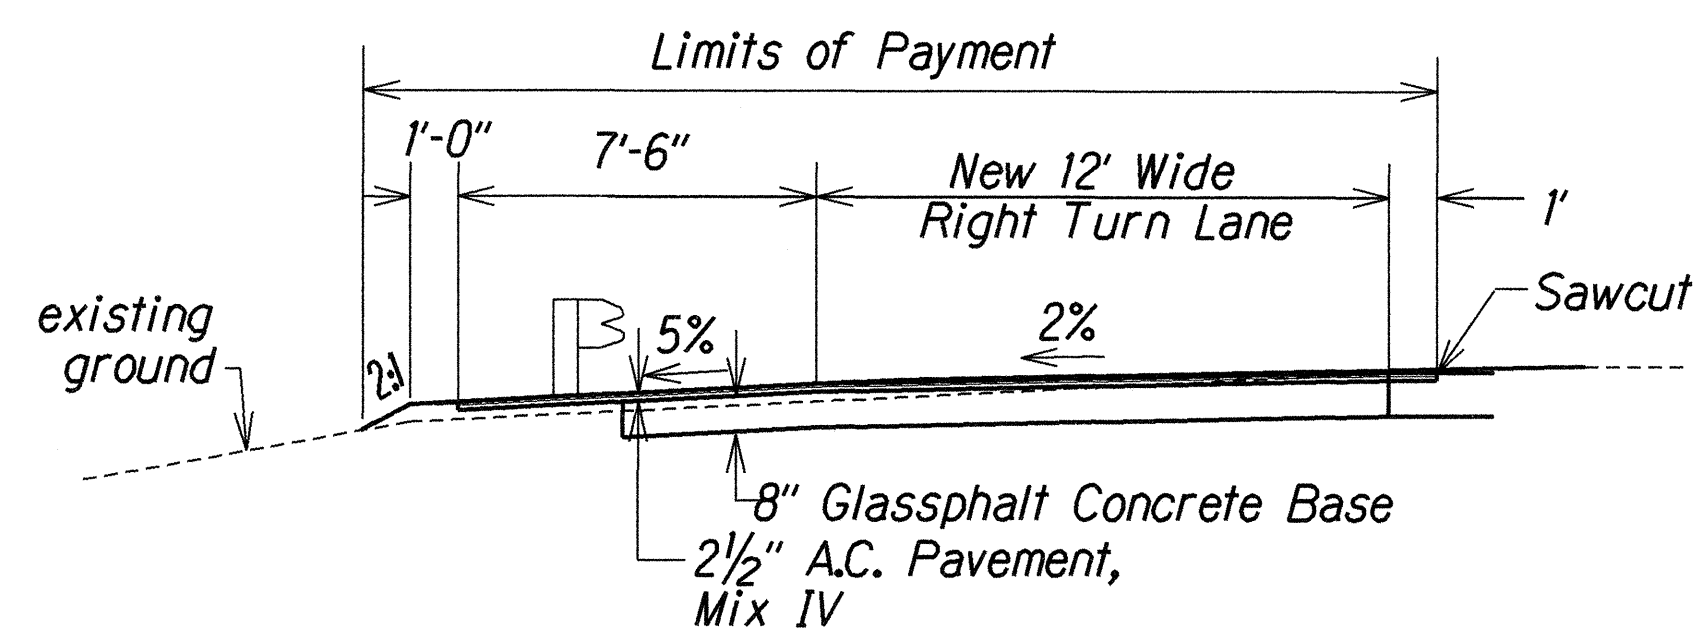

HUALALAI ROAD - Sta. 2+30

Scale: 1/4"=1'-0"

DATE	11/11/02
DESIGNED BY	EDWIN H. MARUYAMA
CHECKED BY	EDWIN H. MARUYAMA
NOTED BY	EDWIN H. MARUYAMA
ORIGINAL PLAN	EDWIN H. MARUYAMA

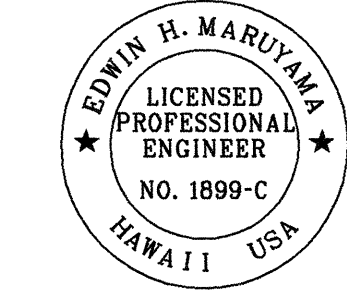

THIS WORK WAS PREPARED BY ME OR UNDER MY SUPERVISION
 Edwin H. Maruyama
 FUJITA & ASSOCIATES INC.

STATE OF HAWAII
DEPARTMENT OF TRANSPORTATION
HIGHWAYS DIVISION

TYPICAL SECTIONS

Hawaii Belt Road
Intersection Improvements
At Police Station Road and Hualalai Road
Project No. 11A-01-02

Scale: As Shown Date: Dec., 2002

SHEET No. TSI OF 1 SHEETS