



FED. ROAD DIST. NO.	STATE	FED. AID PROJ. NO.	FISCAL YEAR	SHEET NO.	TOTAL SHEETS
HAWAII	HAW.	11K-01-03M	2003	20	20

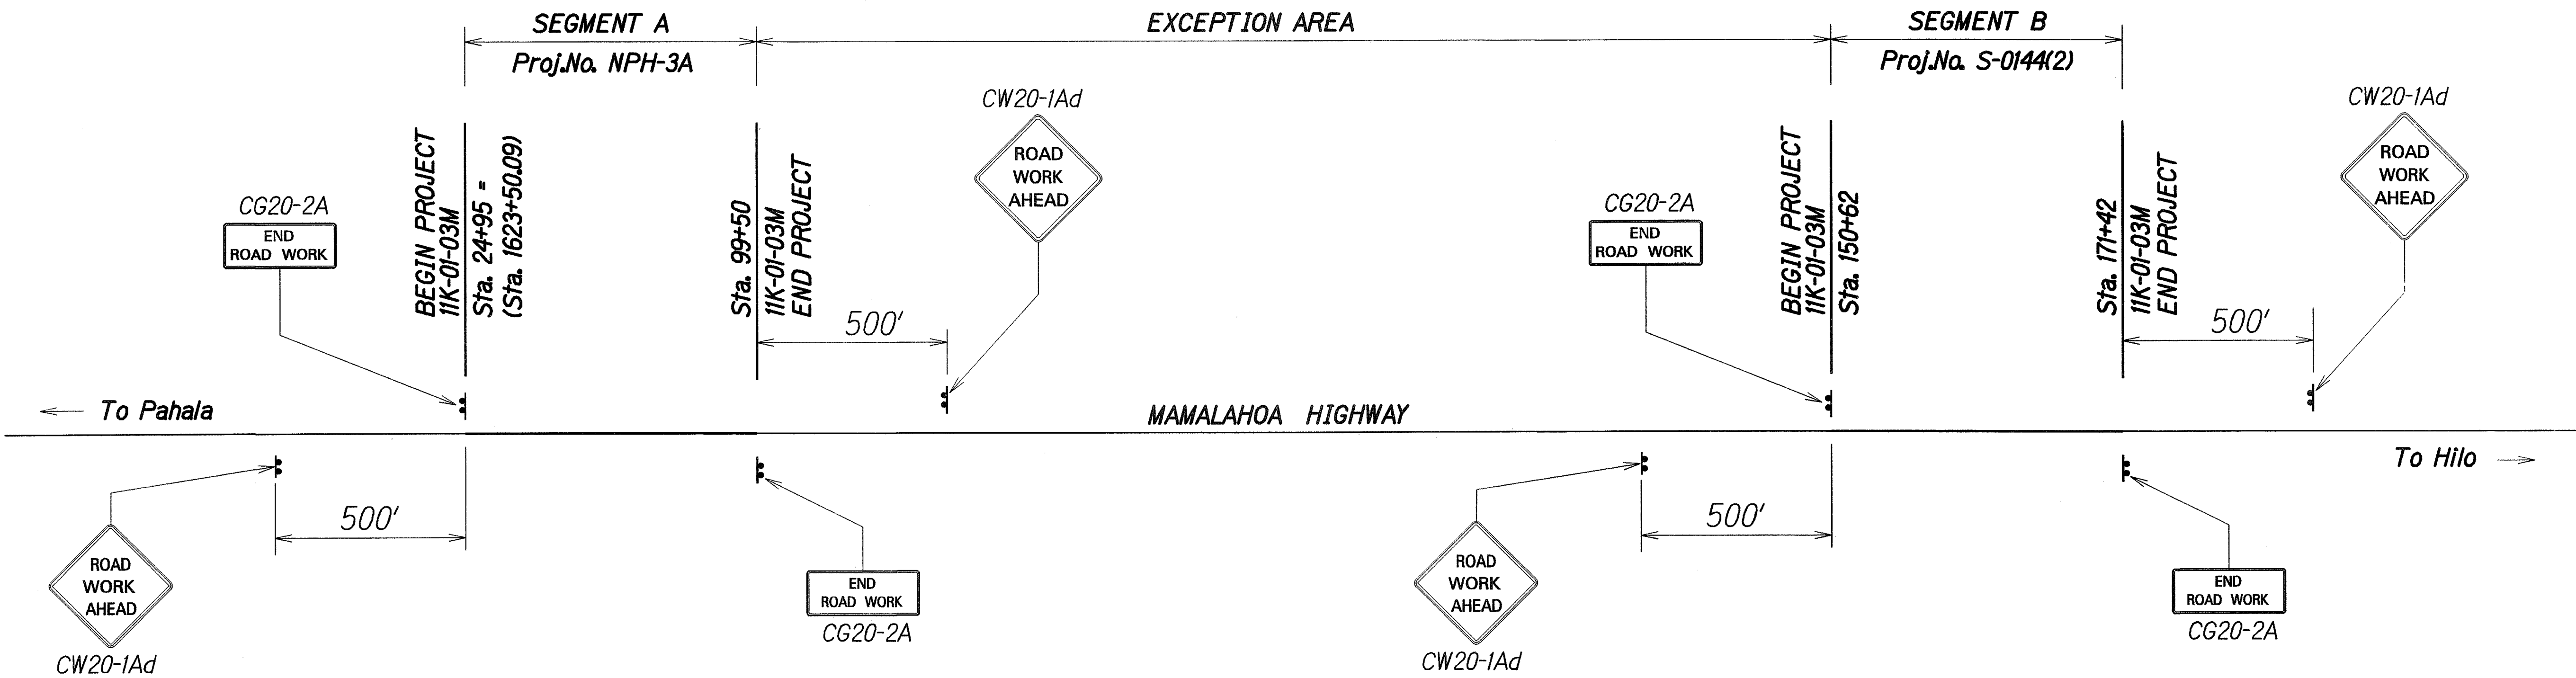


CONSTRUCTION SIGN PLAN
Not To Scale

CONSTRUCTION SIGN SCHEDULE					
PROJECT NO.	ROUTE 11 CENTERLINE STATION	LEFT	RIGHT	ITEM No. 621.7121 (no posts)	ITEM No. 621.7120 (two posts)
NPH-3A	1636+50 1628+50		●		CW20-1Ad
	1631+50 1623+50	●			CG20-2A
	99+50		●		CG20-2A
	104+50	●			CW20-1Ad
S-0144(2)	145+50		●		CW20-1Ad
	150+62	●			CG20-2A
	171+50		●		CG20-2A
	176+50	●			CW20-1Ad
Total Construction Signs				0	8

* - Final locations of all signs to be determined in the field by the Engineer.

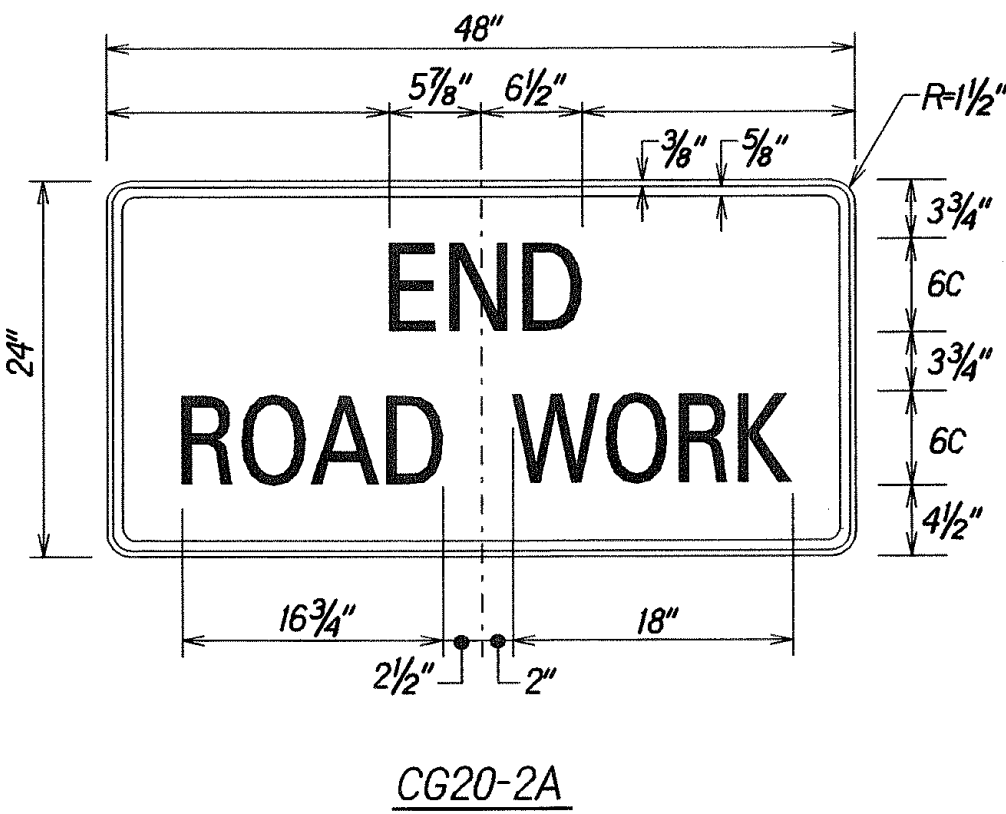

SIGN DETAILS
Not To Scale

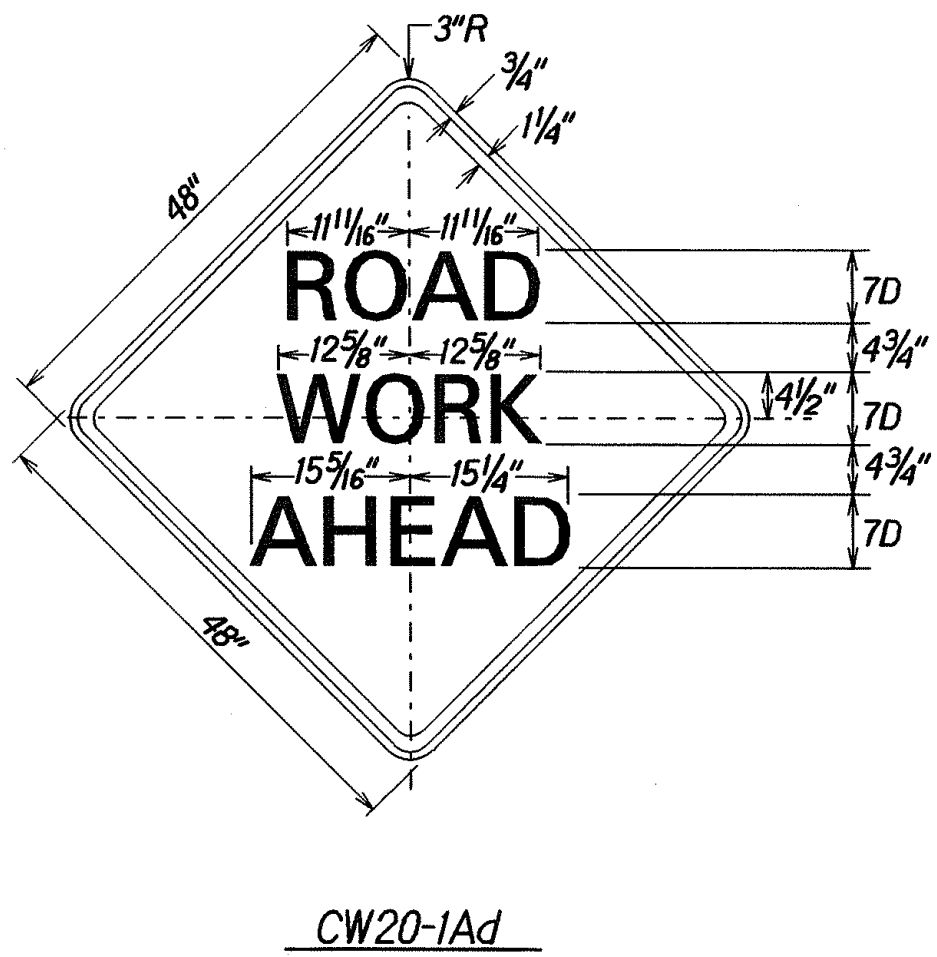

LEGEND FOR AS-BUILT POSTINGS	
	Squiggly line for as-built deletion
	Double line for as-built deletion
Roadway	Text for as-built posting

STATE OF HAWAII
DEPARTMENT OF TRANSPORTATION
HIGHWAYS DIVISION

**CONSTRUCTION SIGN
PLAN & SCHEDULE**

MAMALAHOA HIGHWAY RESURFACING, VICINITY
OF HAWAII VOLCANOES NATIONAL PARK
PROJECT NO. 11K-01-03M

Scale: As Shown Date: April, 2003

SHEET No. 1 OF 1 SHEETS

ORIGINAL PLAN	DATE
DESIGNED BY	
DRAWN BY	
CHECKED BY	
NOTED BY	
QUANTITIES BY	
DATE	

"AS-BUILT"