



FED. ROAD DIST. NO.	STATE	PROJ. NO.	FISCAL YEAR	SHEET NO.	TOTAL SHEETS
HAWAII	HAW.	11K-01-03M	2003	7	20

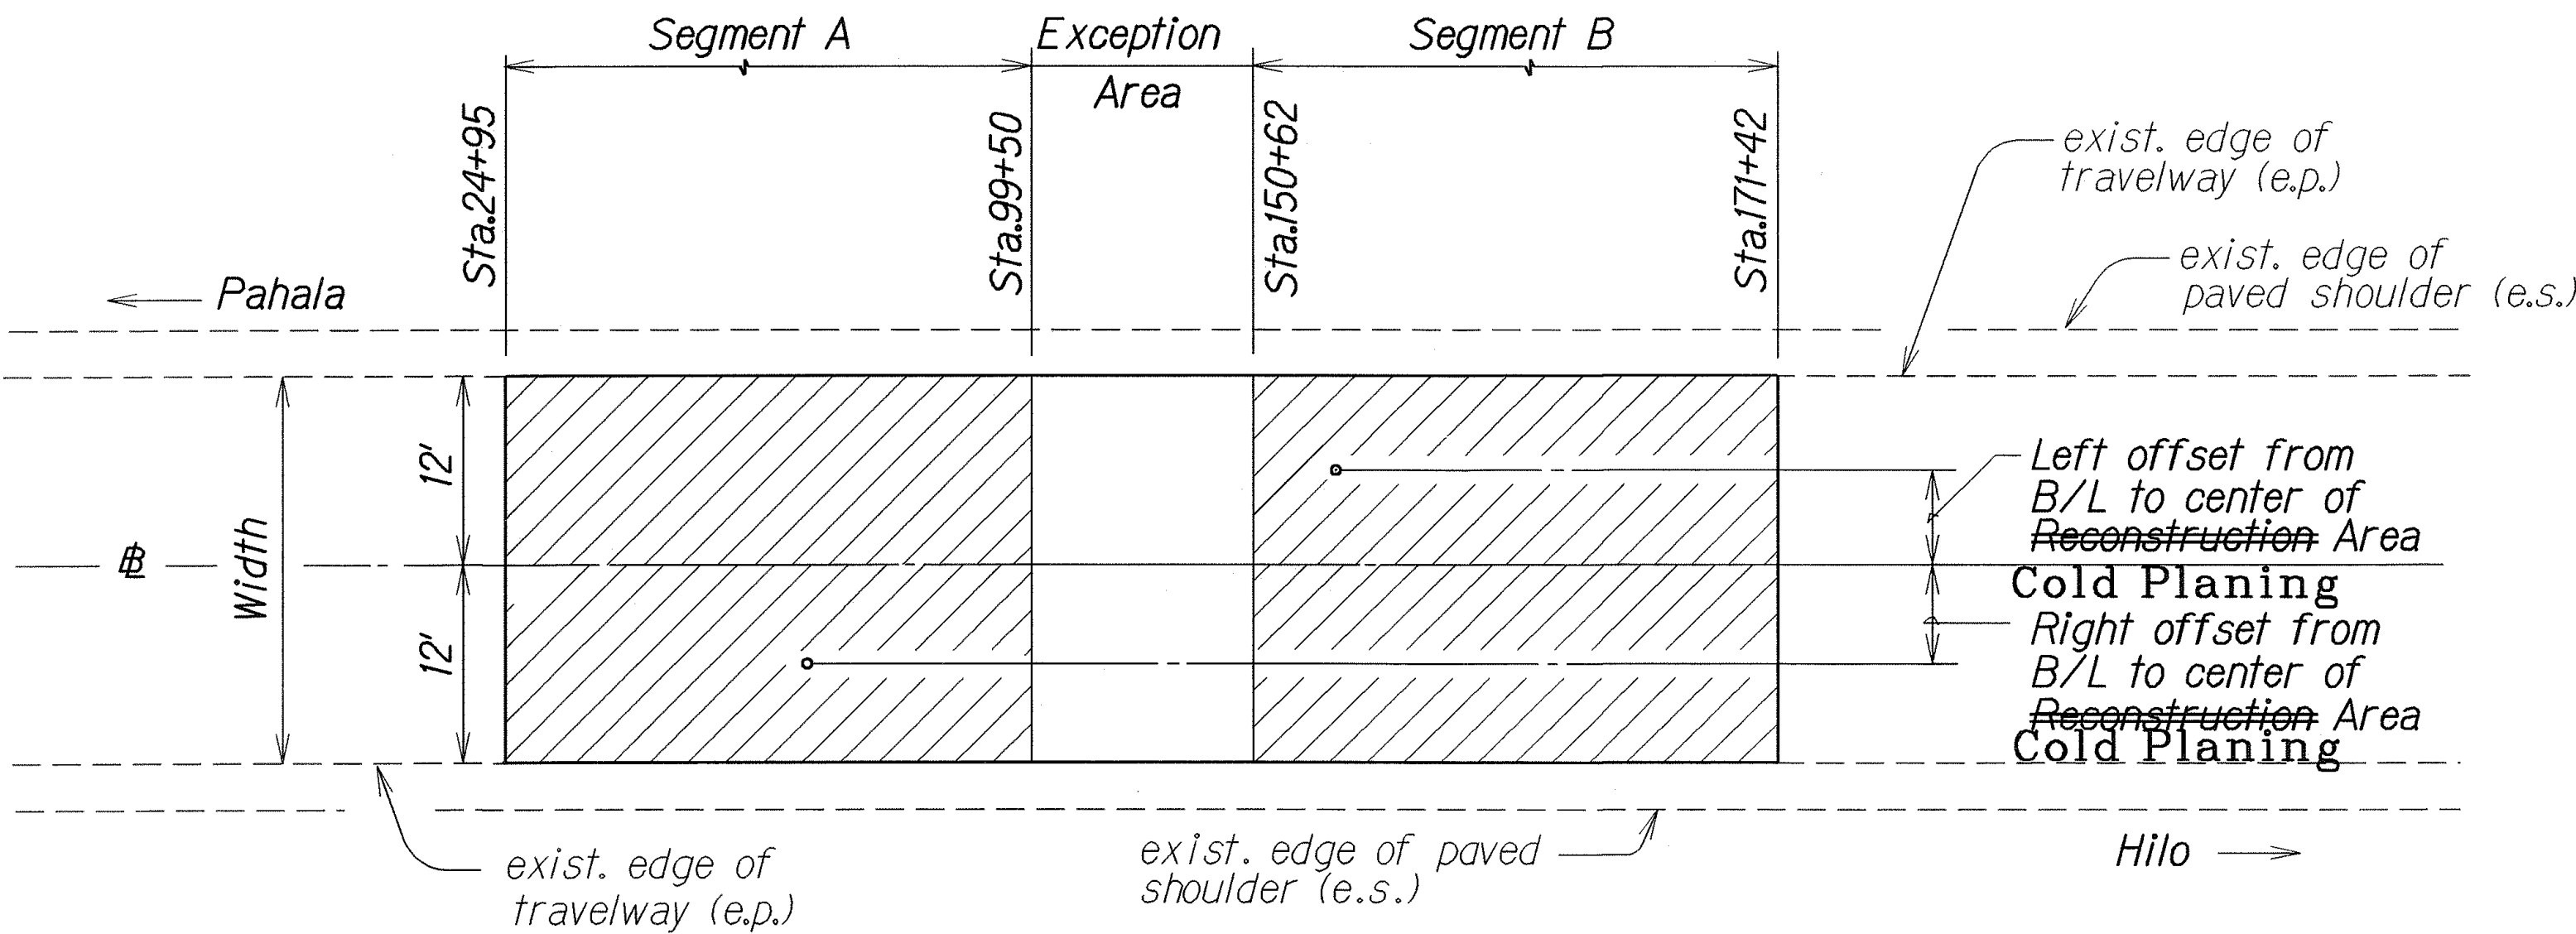


COLD PLANING
TYPICAL RECONSTRUCTION PLAN
Not To Scale


COLD PLANING RECONSTRUCTION AREA SCHEDULE						
SEGMENT	STATION		OFFSET FROM RD. C. TO CENTER RECON. AREA (L.F.)		LENGTH (L.F.)	WIDTH (L.F.)
	FROM	TO	MAUKA	MAKAI		
A			Right	Left		
	24+95	99+50	6	6	7,455	24
B			Left	Right		
	150+62	171+42	6	6	2,080	24
TOTAL						228,840

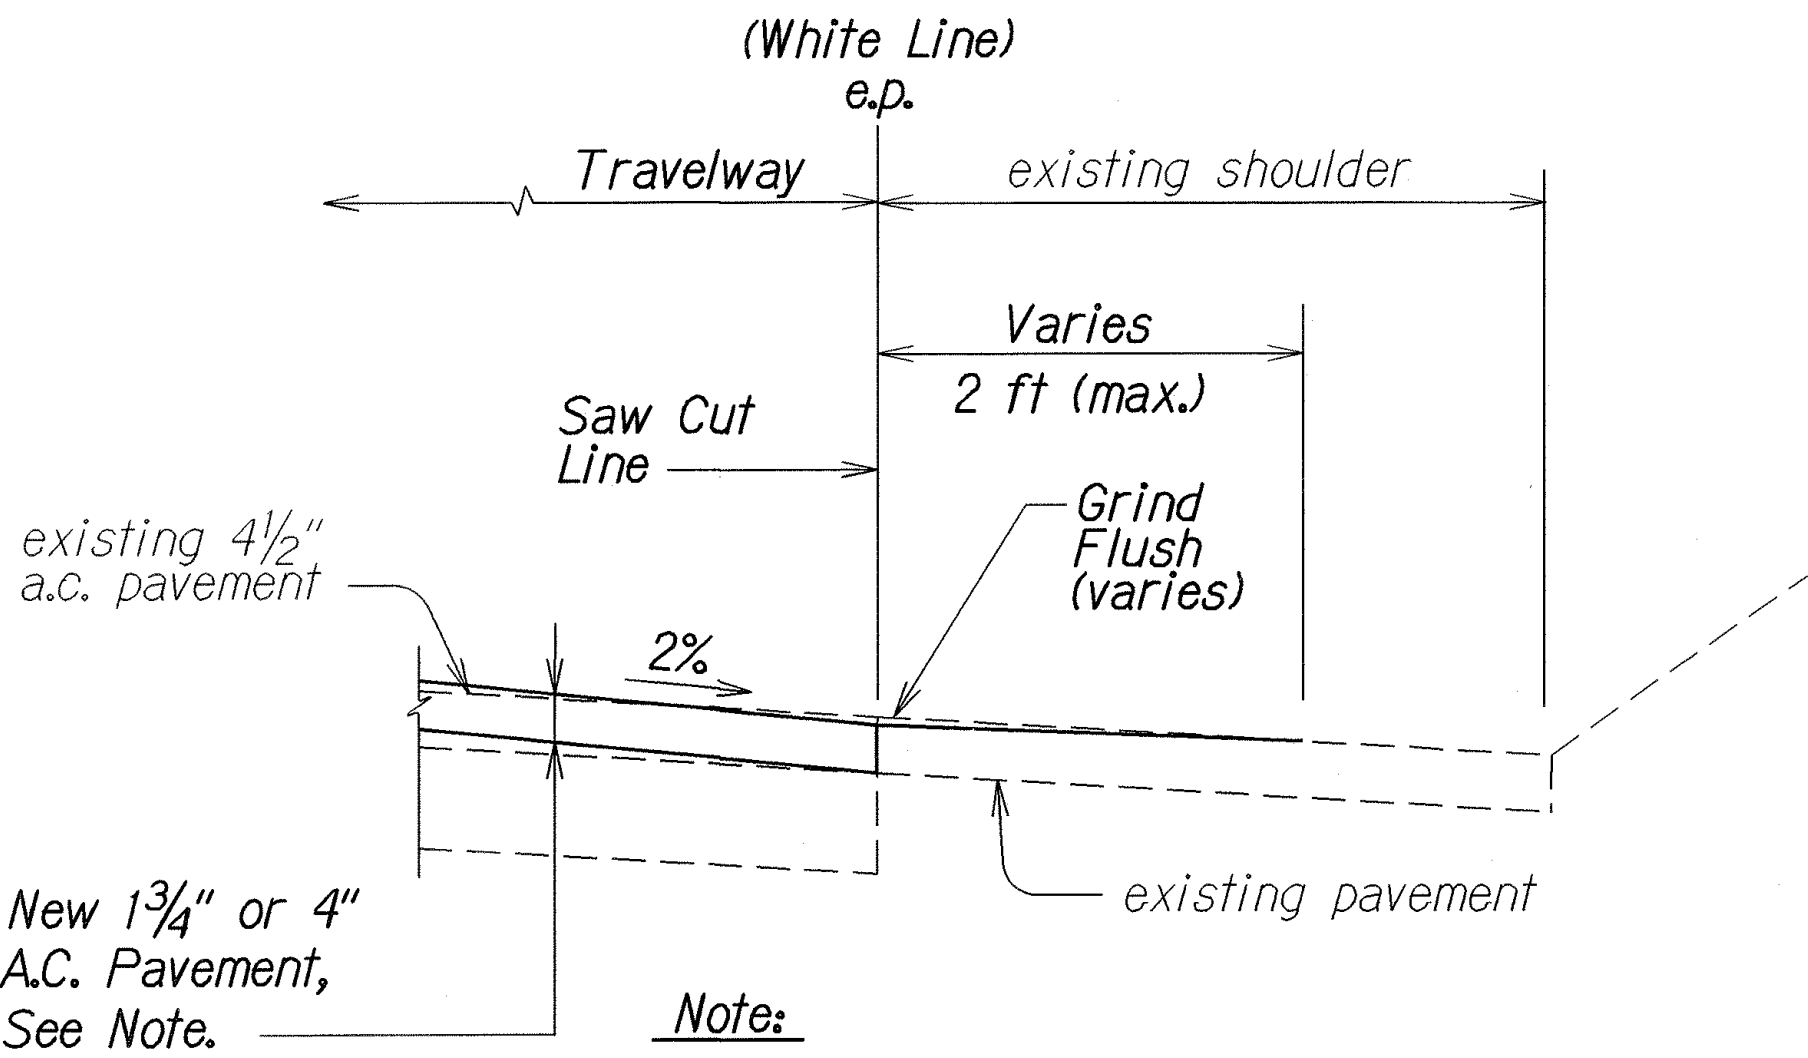

RESURFACING AT PAVED SHOULDER DETAIL (CUT)
Not To Scale

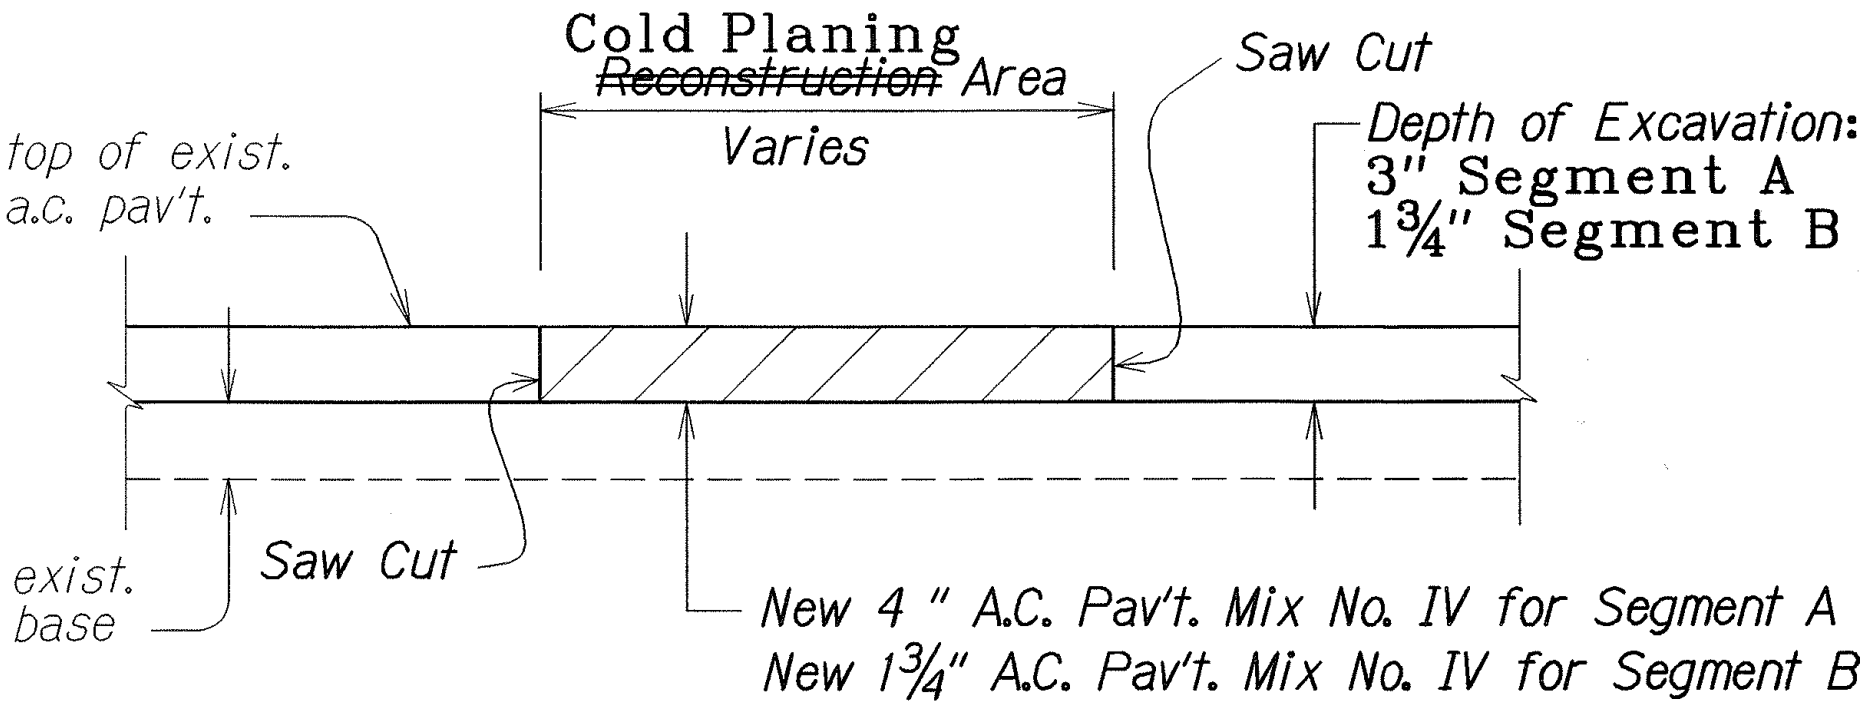

COLD PLANING
A.C. PAVEMENT RECONSTRUCTION DETAIL
Not To Scale

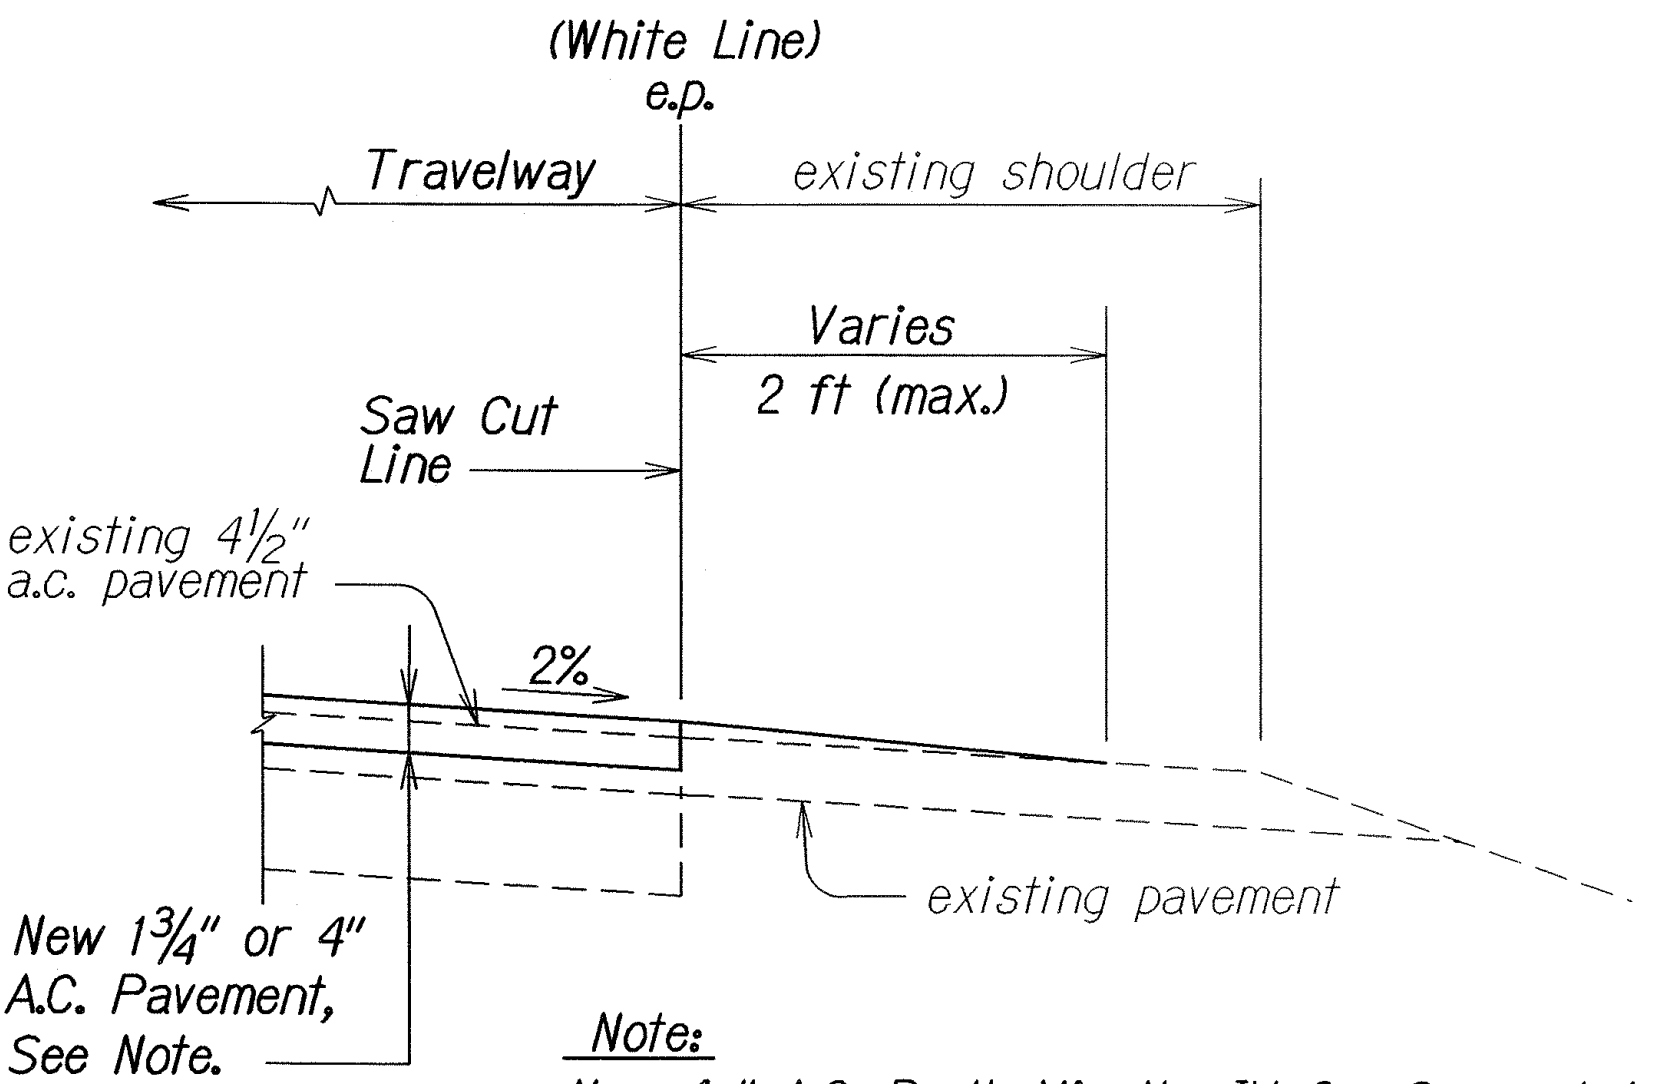

RESURFACING AT PAVED SHOULDER DETAIL (FILL)
Not To Scale

ORIGINAL PLAN	SURVEY PLOTTED BY	DATE
NOTE BOOK	DRAWN BY	
6/11/2003	DESIGNED BY	
N. H. HAWAII	CHECKED BY	

LEGEND FOR AS-BUILT POSTINGS	
	Squiggly line for as-built deletion
	Double line for as-built deletion
Roadway	Text for as-built posting

STATE OF HAWAII
DEPARTMENT OF TRANSPORTATION
HIGHWAYS DIVISION

**RECONSTRUCTION AREA
SCHEDULE AND DETAILS**
MAMALAHOA HIGHWAY RESURFACING, VICINITY
OF HAWAII VOLCANOES NATIONAL PARK
PROJECT NO. 11K-01-03M
Scale: None Date: April, 2003
SHEET No. 1 OF 1 SHEETS