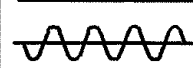
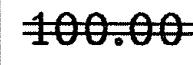


FED. ROAD DIST. NO.	STATE	FED. AID PROJ. NO.	FISCAL YEAR	SHEET NO.	TOTAL SHEETS
HAWAII	HAW.	11K-01-03M	2003	16	20

SIGN REPLACEMENT, REMOVAL, AND INSTALLATION SCHEDULE												
STATION	LEFT	RIGHT	TYPE	SIGN TO REMAIN	REMOVE	INSTALL (10 SQ. FT. OR LESS)		INSTALL (GREATER THAN 10 SQ. FT.)		DESTINATION SIGN		RM-3 W/O POST
						W/POST	WO/POST	W/POST	WO/POST	SIZE (SQ. FT.)	POST INSTALL.	
Project No. NPH-3A												
26+21	●		R2-5a (45)		1	1						1
39+05		●	" SERVICES/NEXT LEFT "	1								
41+05		●	W2-2 (L)		1	1						1
48+30	●		R1-1		1	1						1
48+84		●	R1-1		1	1						1
50+89	●		" Pi'i Mauna/Drive "	2								
51+65		●	" ADOPT A HIGHWAY "	2								2
55+04	●		W2-2 (R)		1	1						1
56+02		●	W1-2 (R)		1	1						1
57+02	●		" SERVICES/NEXT LEFT "	1								
58+79	●	●	D-2 (CREST/4020ft/1227m) (30"x18")		2	2						2
67+22	●		" ADOPT A HIGHWAY "	2		1						2
72+33	●		W1-2 (L)		1	1						1
159+05		●	" ADOPT A HIGHWAY "	2								2
Project No. S-0144(2)												
161+50		●	" HILO 28 Mi. "	1								
164+87	●		" PARK ENTRANCE 1/2 MILE VISTOR CENTER "	1								
168+38	●		W2-2(R)		1	1						# 2
Project No. NPH-3A ( Pi'i Mauna Drive )												
0+95		●	R2-1 (15)		1	1						1
TOTALS				12	11	#12	0	0	0	0	0	#18
CONTRACT ITEM NUMBER						621.5100	621.5000			621.0200	621.0200	621.4030

LEGEND FOR  
AS-BUILT POSTINGS

 Squiggly line for  
as-built deletion  
 Double line for  
as-built deletion  
Roadway Text for as-built  
posting

STATE OF HAWAII  
DEPARTMENT OF TRANSPORTATION  
HIGHWAYS DIVISION

SIGN SCHEDULE

MAMALAHOA HIGHWAY RESURFACING, VICINITY  
OF HAWAII VOLCANOES NATIONAL PARK  
PROJECT NO. 11K-01-03M

Scale: None Date: April, 2003

SHEET No. 1 OF 1 SHEETS

Note:

See Sheet No. 15 for Standard Sign  
Notes and Sign Details.

Sign (D3-2) (Pi'i Mauna Drive) installed  
at Sta. 41+05 Rt. & Sta. 55+04 Lt.

"AS-BUILT"

ORIGINAL PLAN	SURVEY PLOTTED BY	DATE
NOTE BOOK	DRAWN BY	
6/11/03/03/03	TRACED BY	
N. H. H. H.	CHECKED BY	