
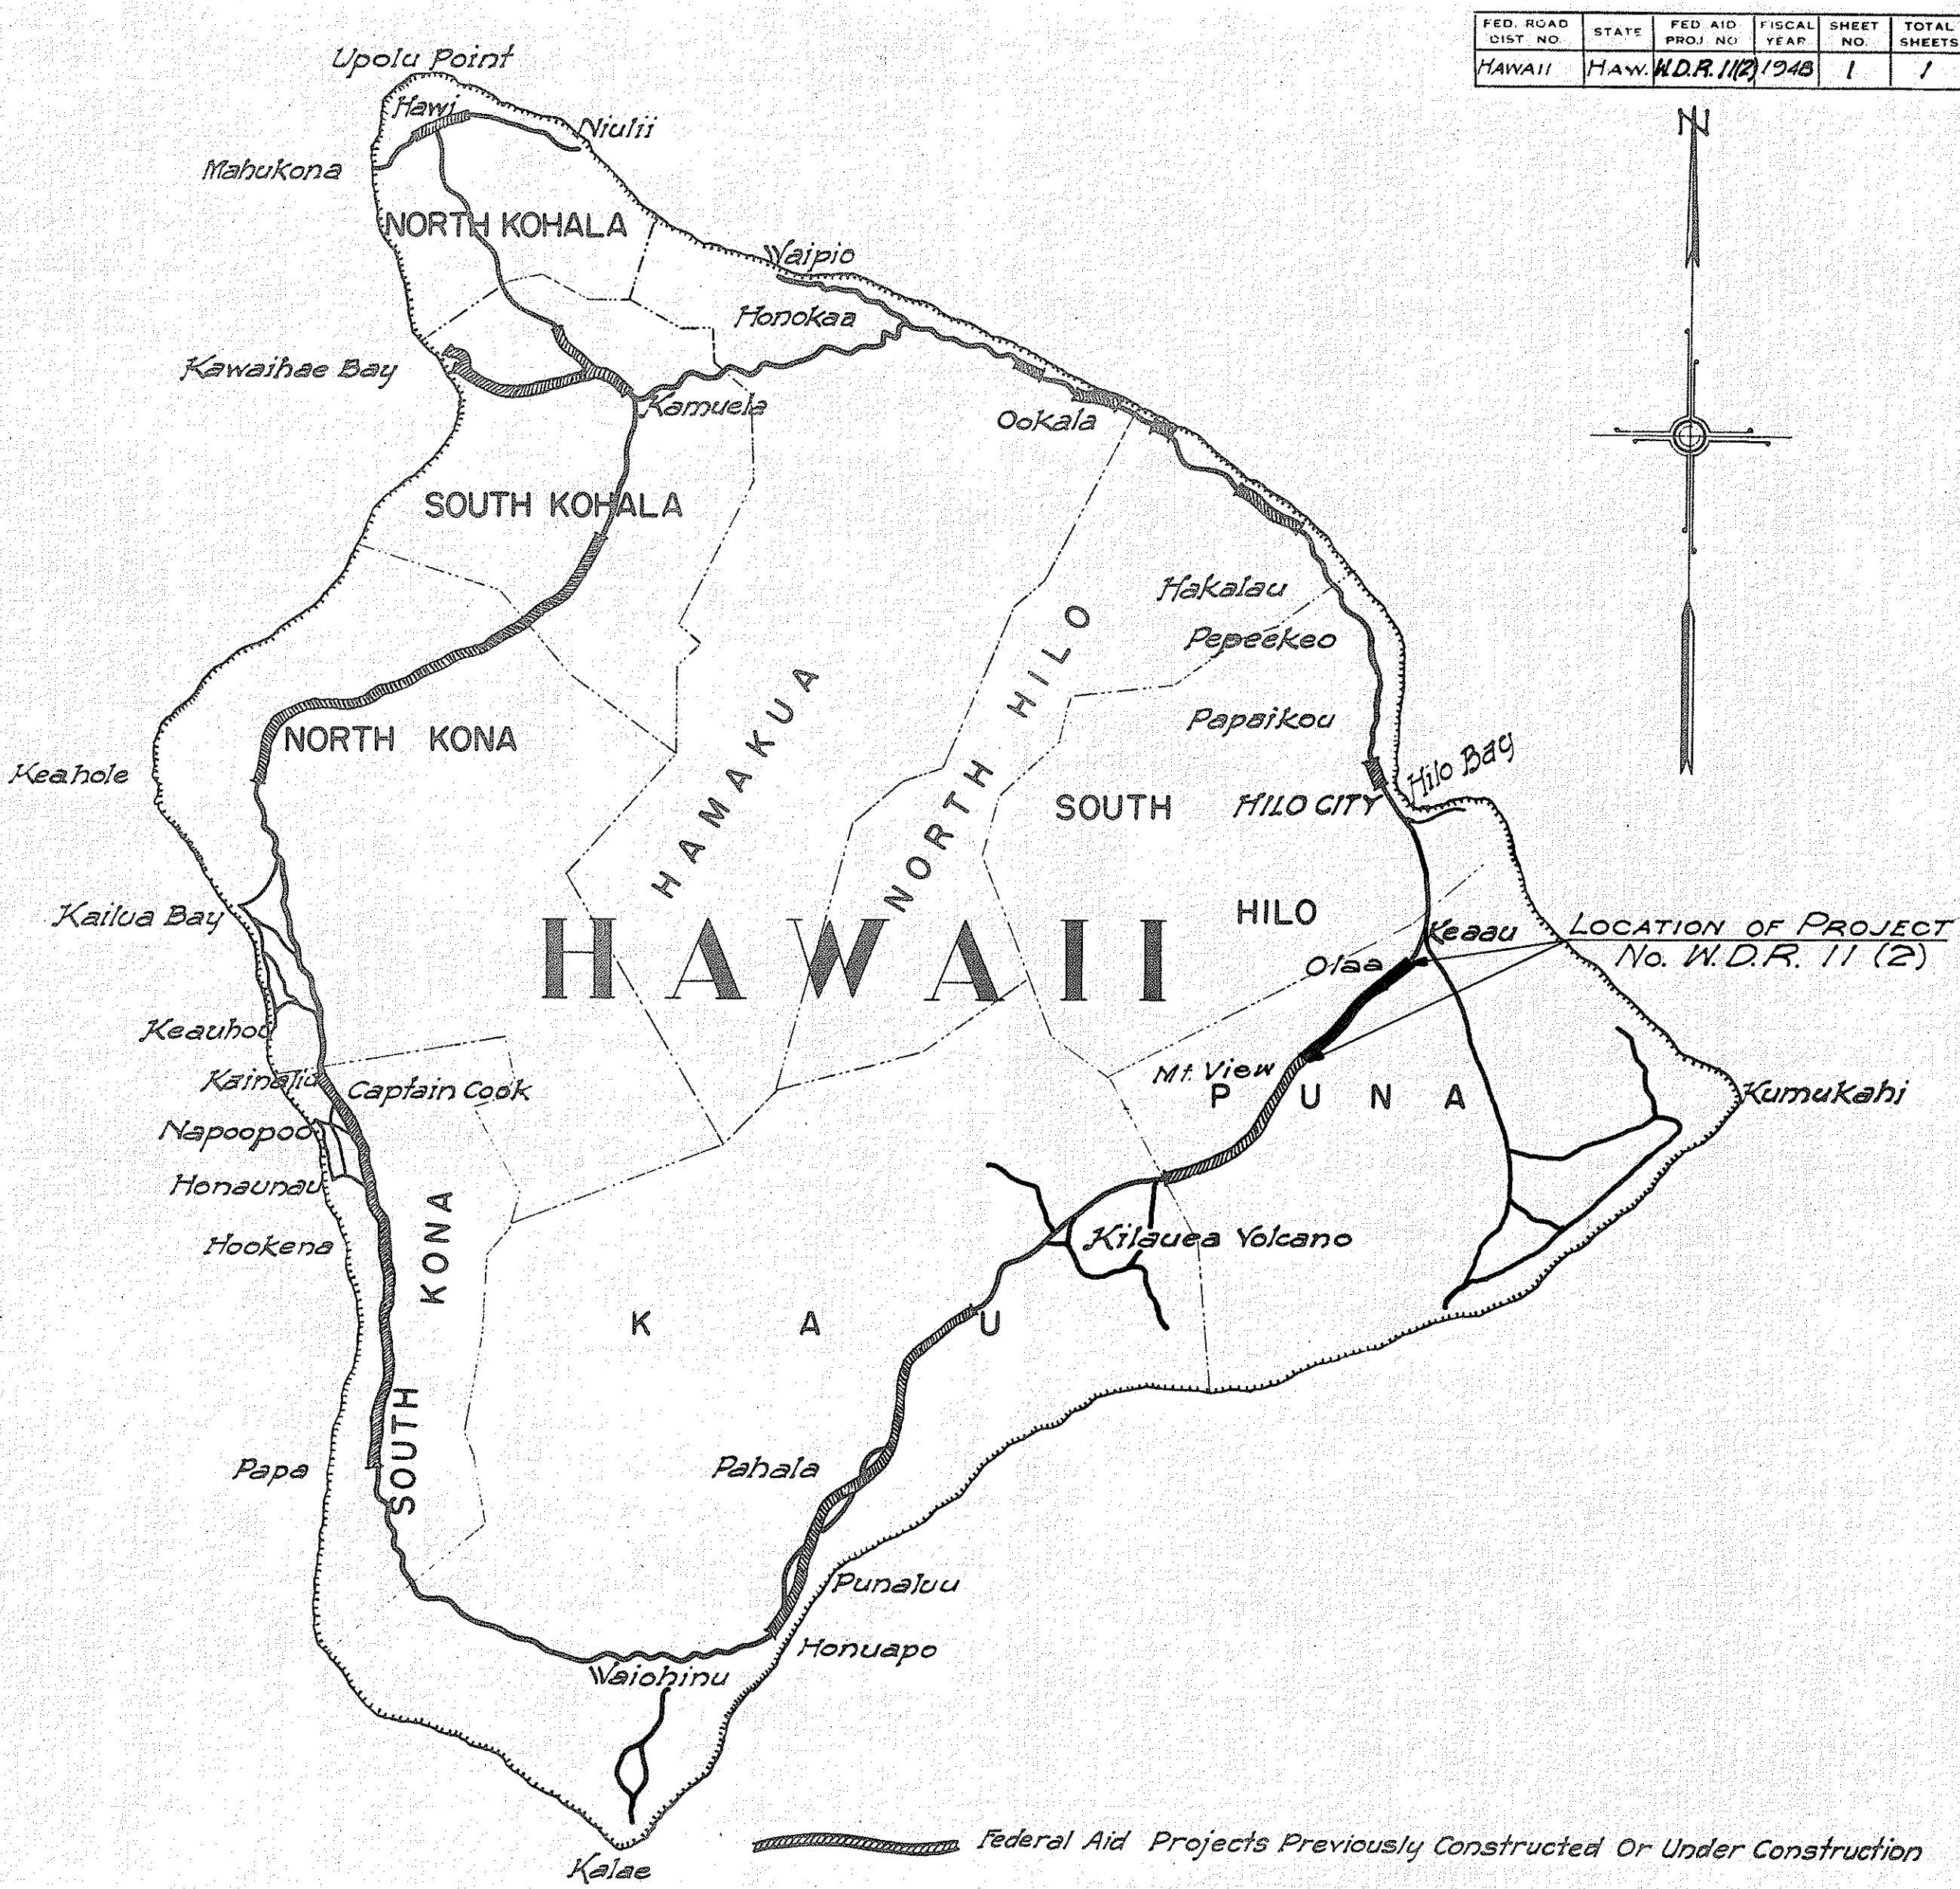


INDEX TO DRAWINGS	
SHEET	DESCRIPTION
1	TITLE SHEET

TERRITORY OF HAWAII
TERRITORIAL HIGHWAY DEPARTMENT
HONOLULU T.H.

PLANS OF
REHABILITATION
OF A PORTION OF
VOLCANO ROAD
WAR DAMAGE REHABILITATION PROJECT NO. W.D.R. 11 (2)
DISTRICT OF PUNA
ISLAND OF HAWAII

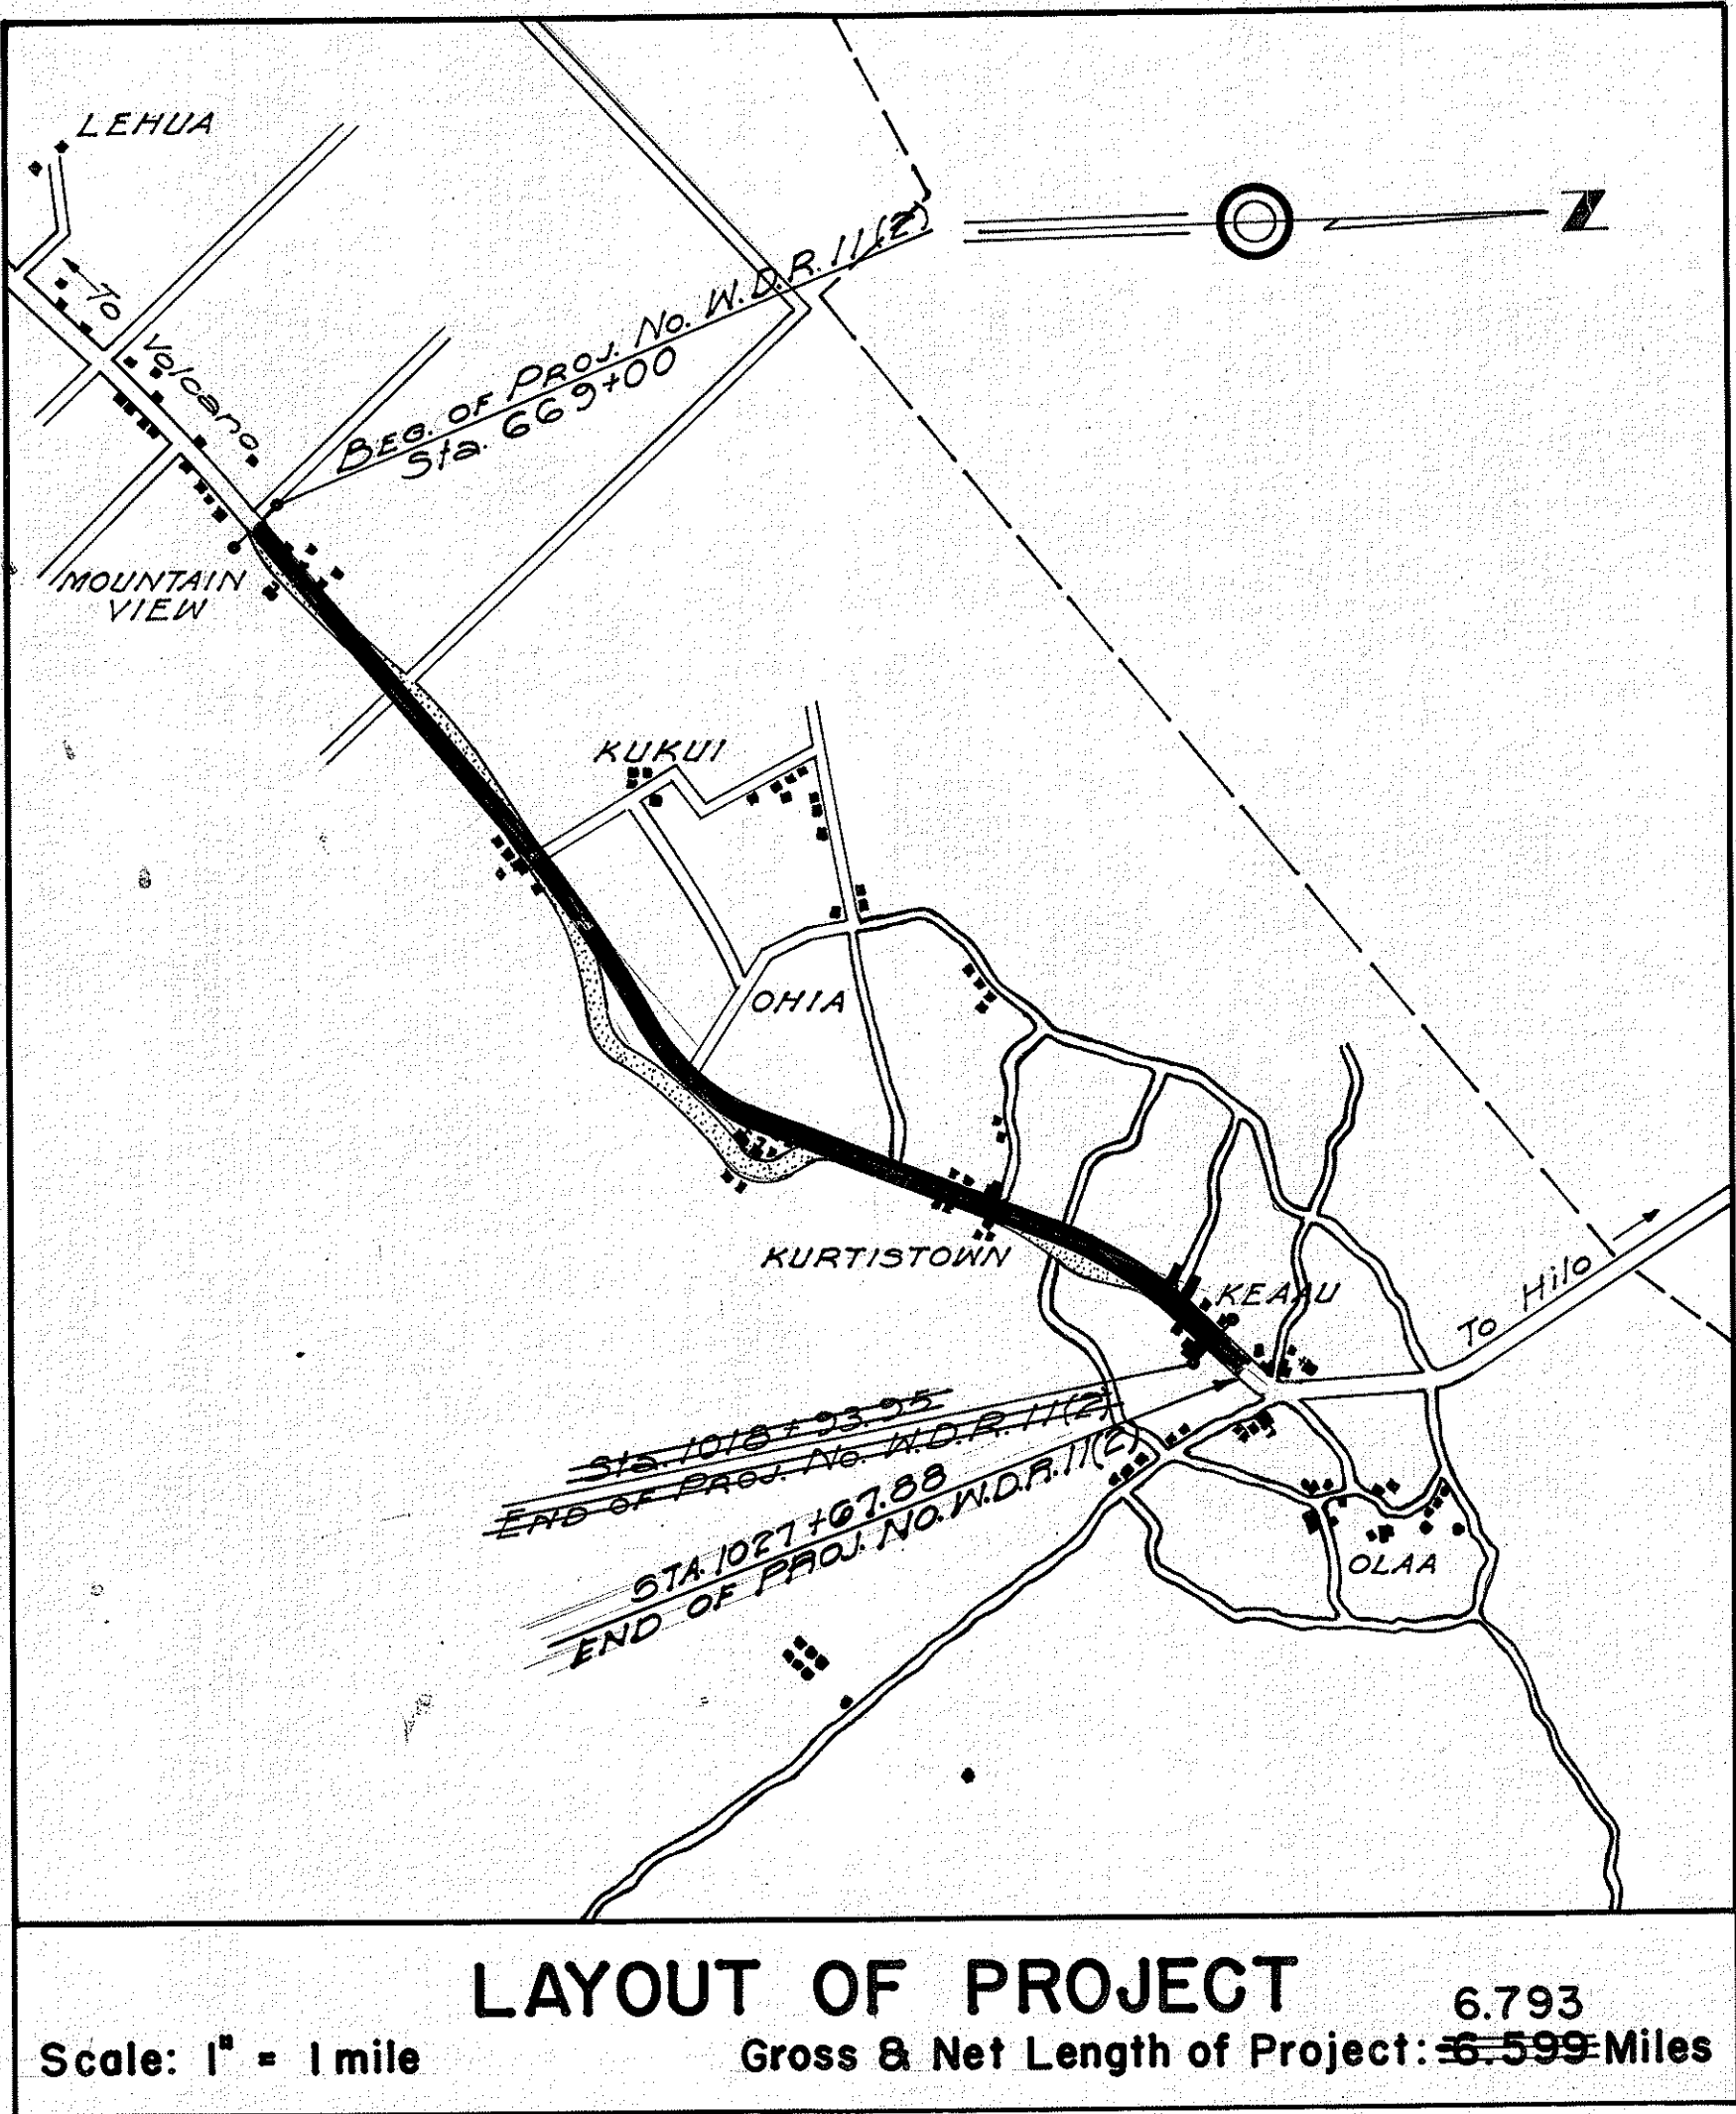

NOTE:
 ALL CHANGES MADE DURING CONSTRUCTION HAVE BEEN NOTED IN RED ON THESE TRACINGS AND CHECKED BY:

Maletia O. Peterson, Jr.
 RESIDENT ENGINEER
 DATE Feb. 12, 1951

APPROVED: *[Signature]* DATE 8-2-48
 TERRITORIAL HIGHWAY ENGINEER

RECOMMENDED FOR APPROVAL: DATE: _____

DISTRICT ENGINEER
 PUBLIC ROADS ADMINISTRATION
 FEDERAL WORKS AGENCY

APPROVED: _____ DATE: _____

DIVISION ENGINEER
 PUBLIC ROADS ADMINISTRATION
 FEDERAL WORKS AGENCY