

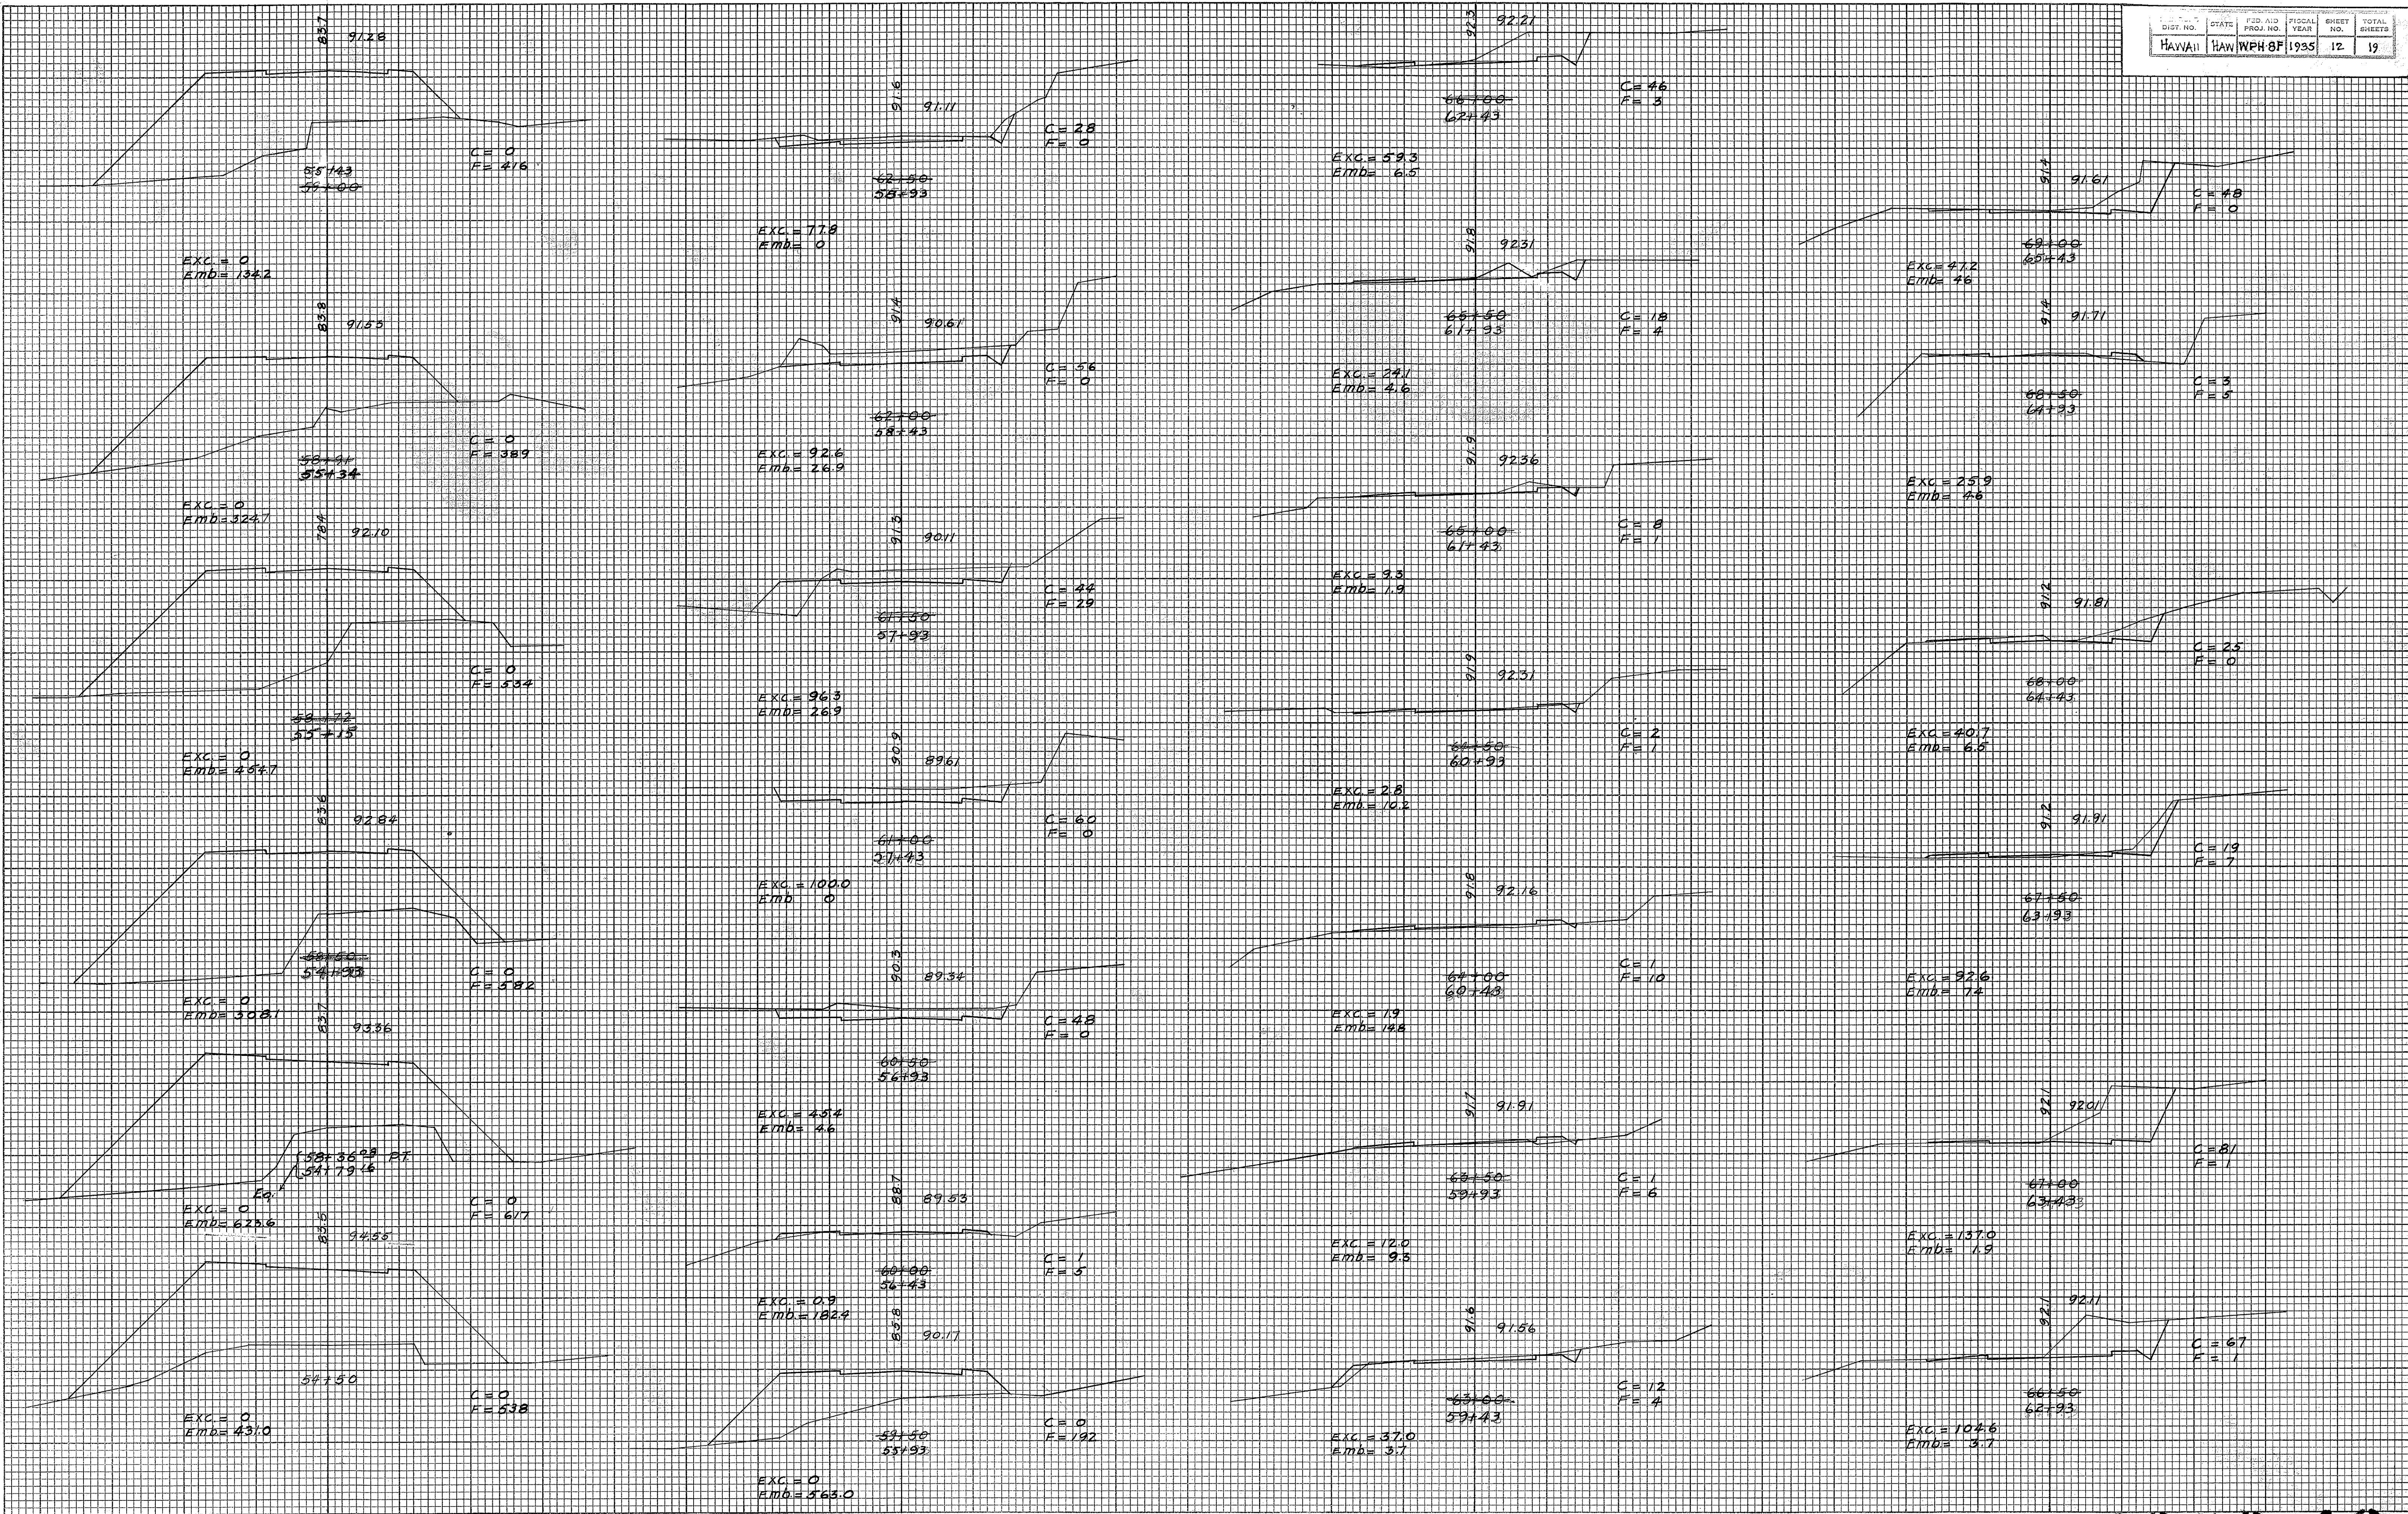
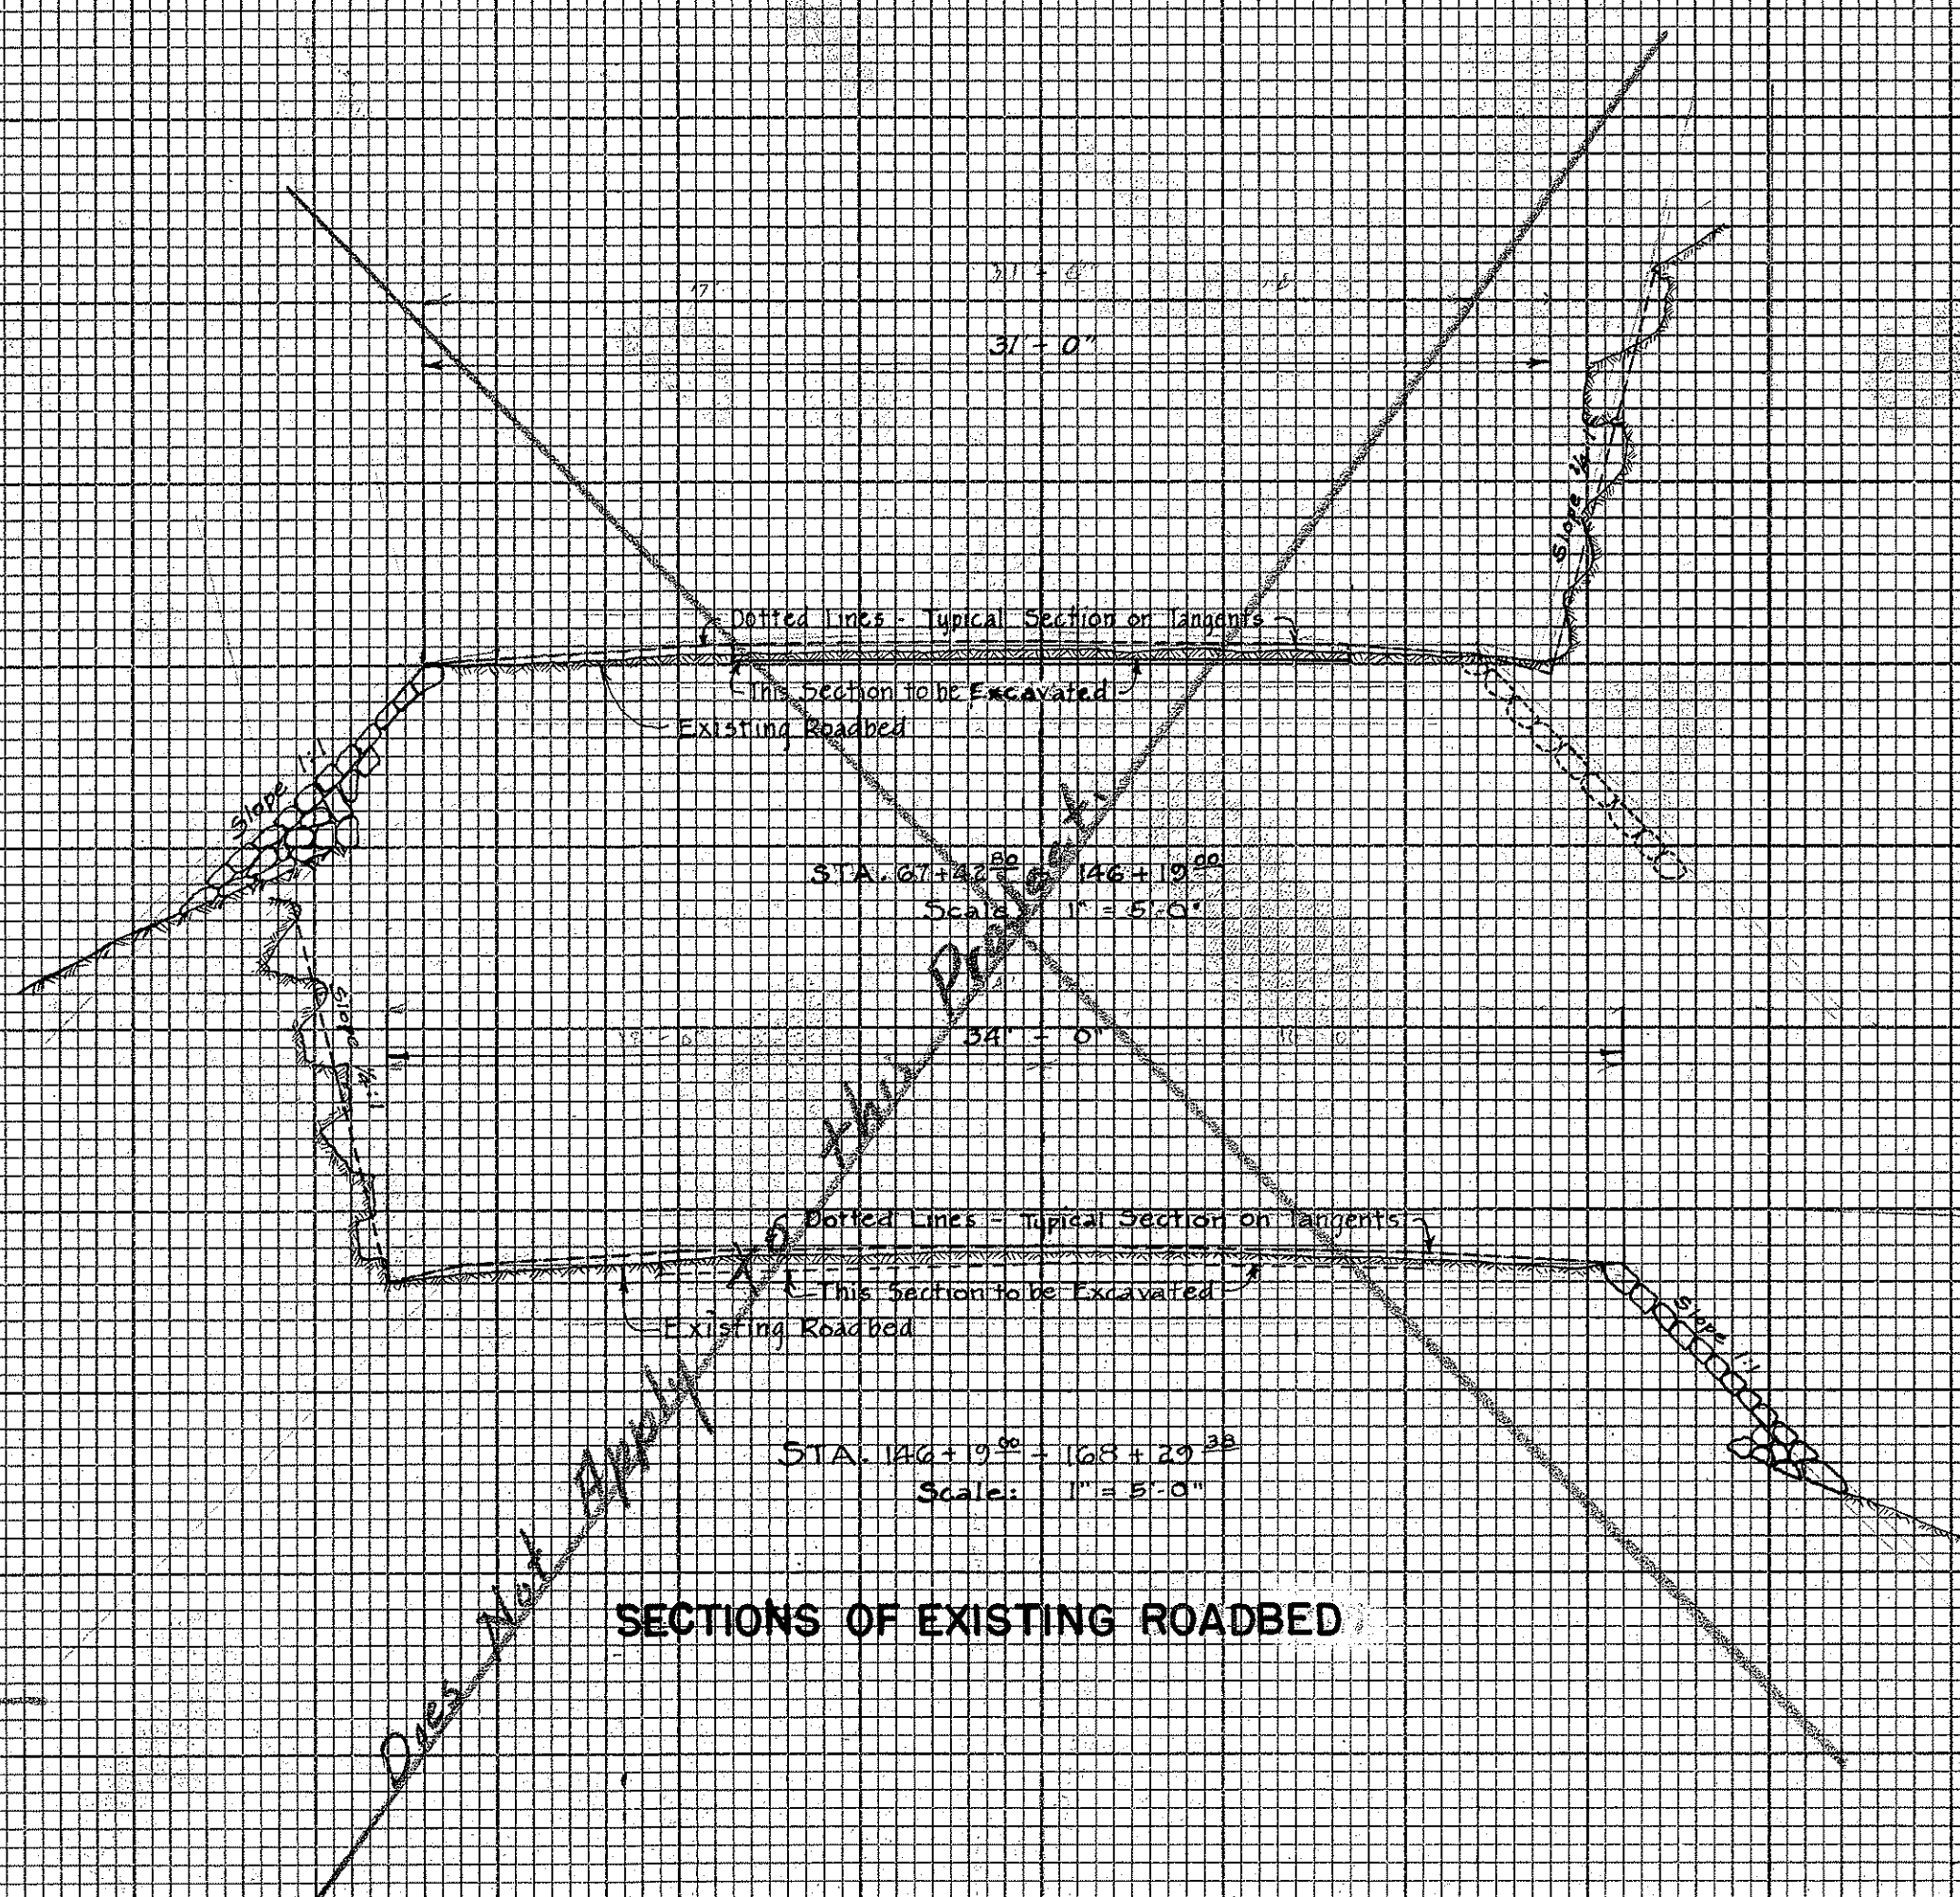
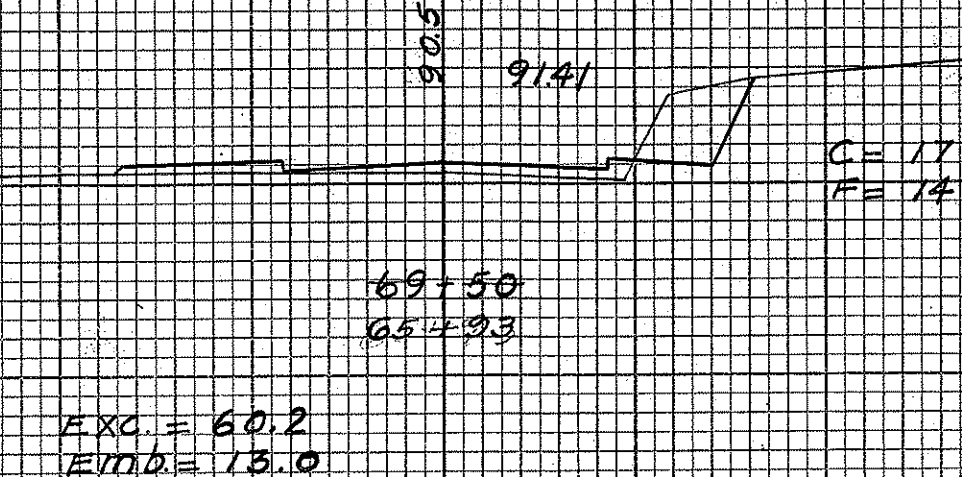
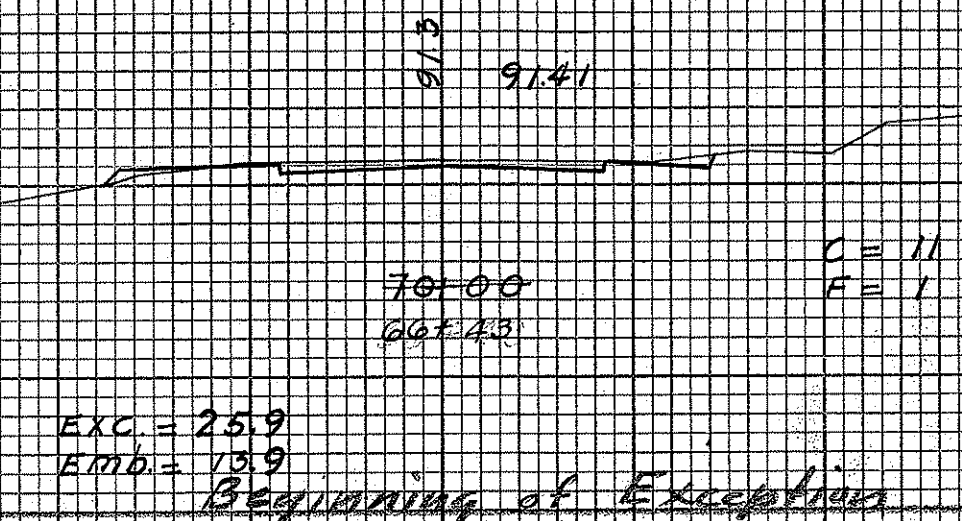


ORIGINAL SURVEY		BY	DATE
	SURVEYED	<i>J.M.L.</i>	<i>1-35</i>
	PLOTTED	<i>J.M.L.</i>	<i>6-17-36</i>
NOTE BOOK	TEMPLATE	<i>J.M.L.</i>	<i>6-17-36</i>
	AREAS	<i>J.M.L.</i>	<i>6-17-36</i>
NO.	AREAS CHECKED	<i>A.H.A.</i>	<i>6-18-36</i>

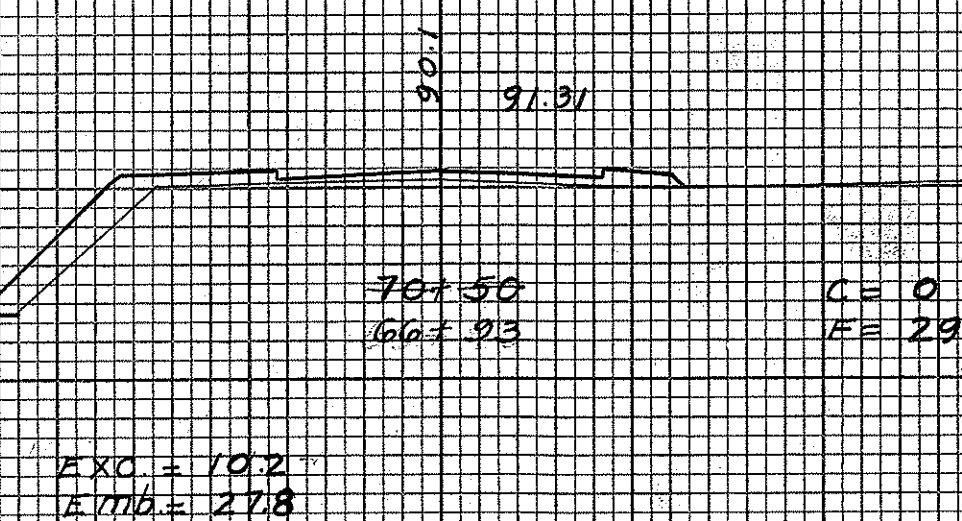


FINAL SURVEY	BY _____	DATE _____
SURVEYED		
PLOTTED		
TEMP. PLATE		
NOTE BOOK	AREAS _____	AREAS CHECKED _____
NO. _____		

ORIGINAL SURVEY	DATE
SURVEYED	1-35
PLOTTED	6-19-35
TEMPLATE	6-18-35
NOTE BOOK	6-17-35
AREAS	6-17-35
AREAS CHECKED	6-21-35
NO.	

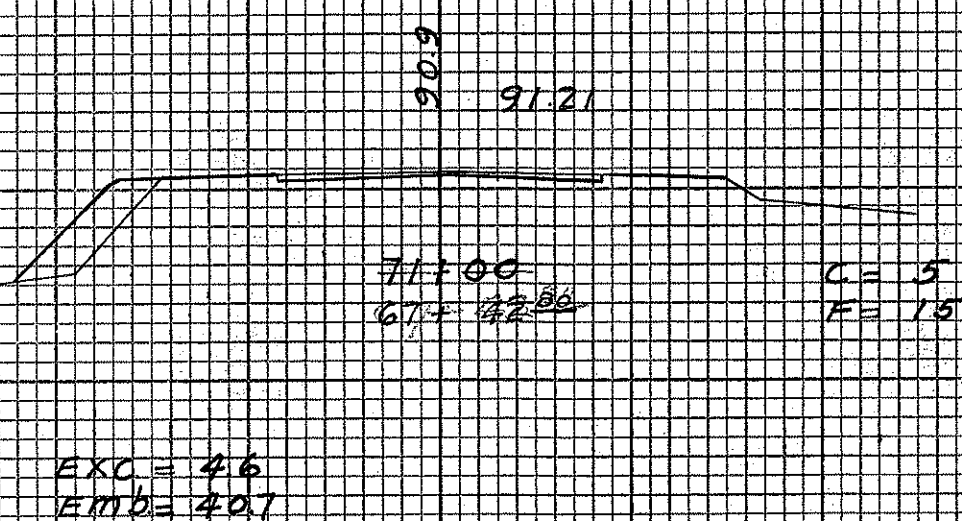

















FINAL SURVEY	DATE
NO.	
BY	
PLotted	
Template	
Areas	
Checked	

ORIGINAL SURVEY	DATE
NO.	
BY	
Plotted	
Template	
Areas	
Checked	

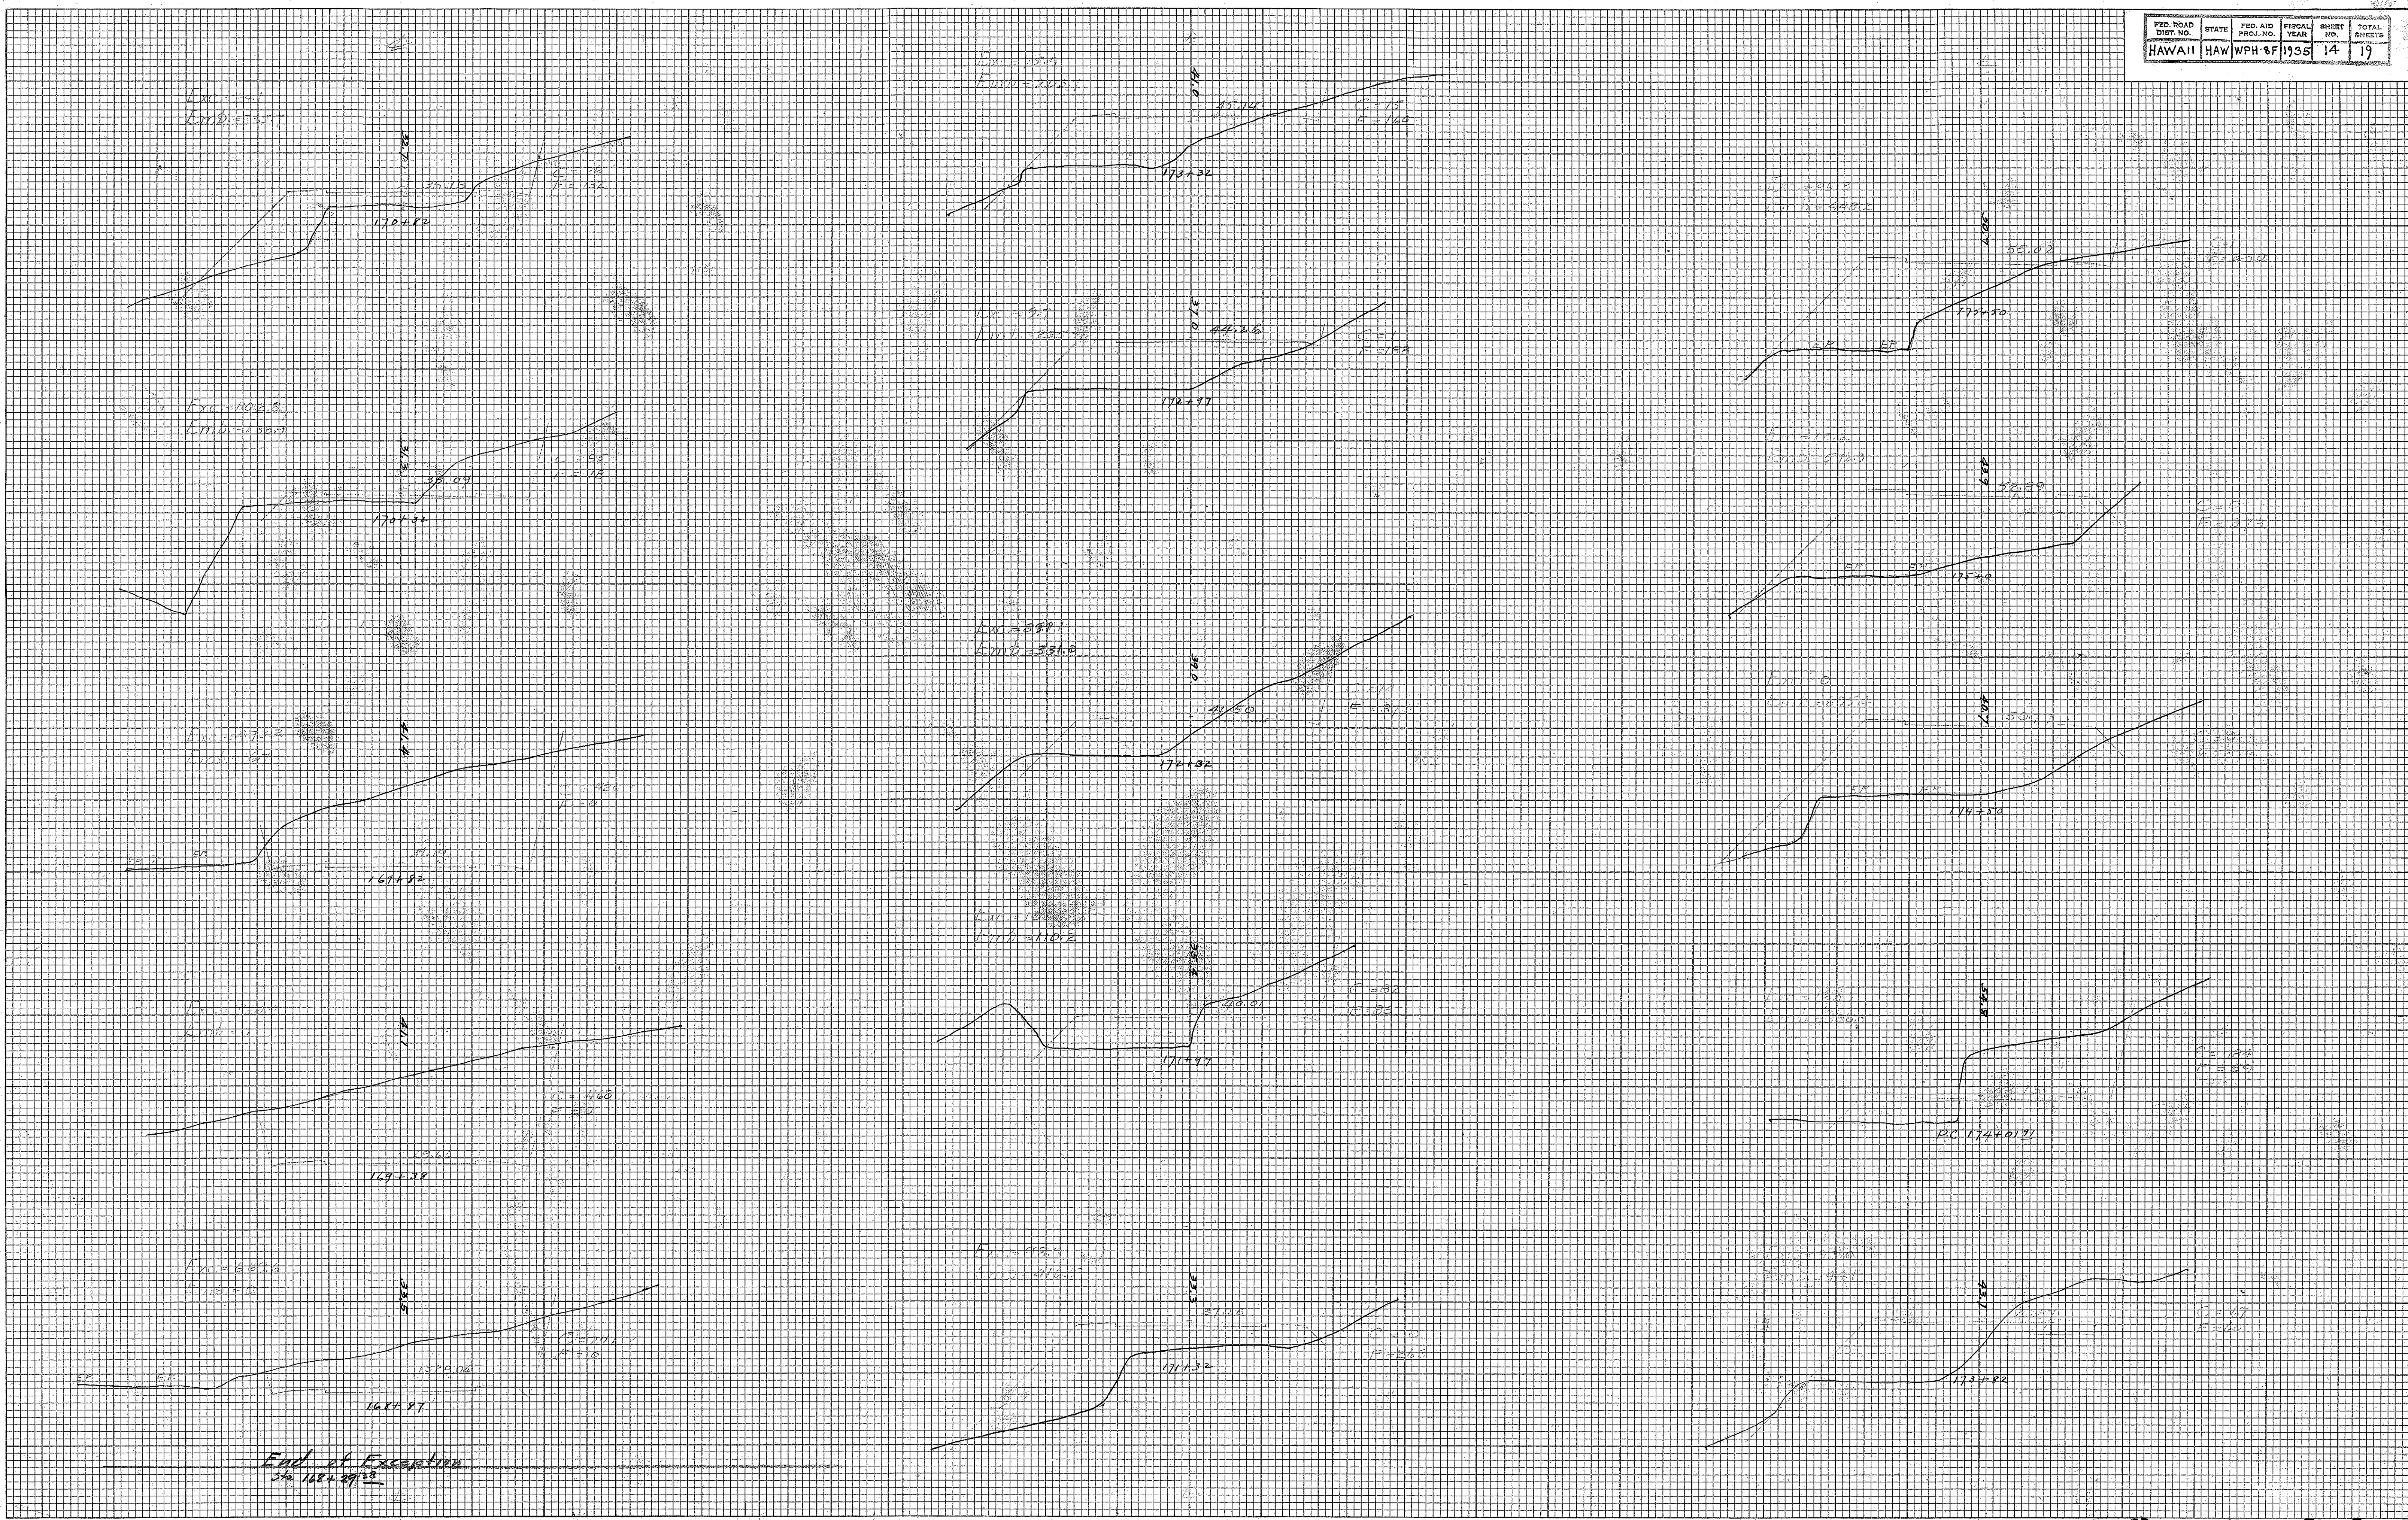

FINAL SURVEY	DATE
BY	
SURVEYED	
PLOTTED	
NOTE BOOK	
AREAS CHECKED	
NO.	


ORIGINAL SURVEY	DATE
BY	
SURVEYED	
PLOTTED	
NOTE BOOK	
AREAS CHECKED	
NO.	

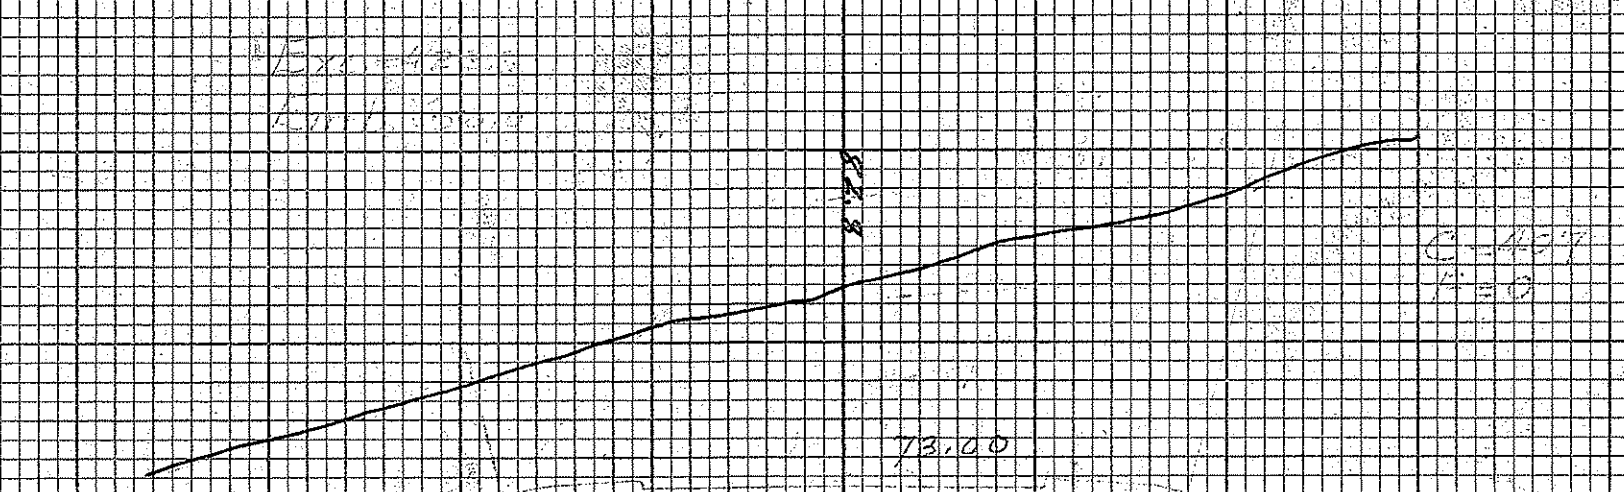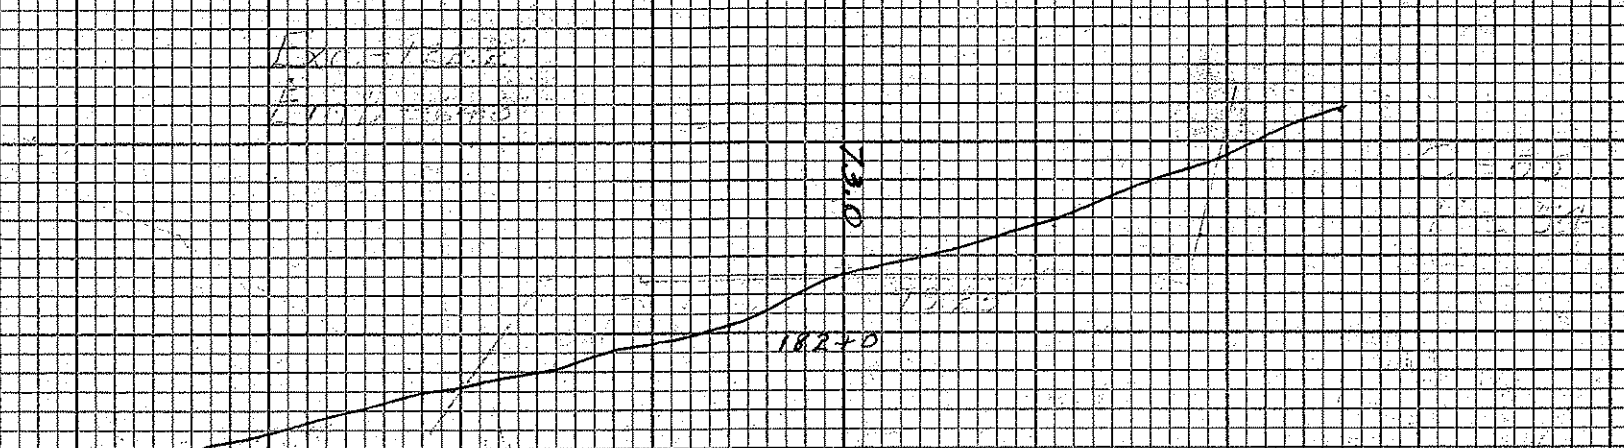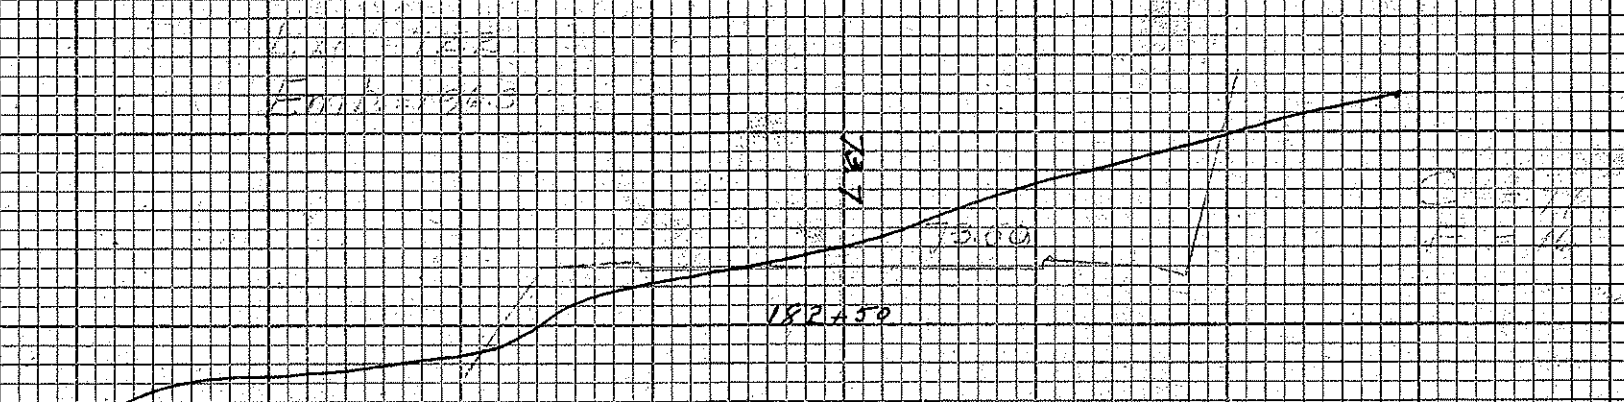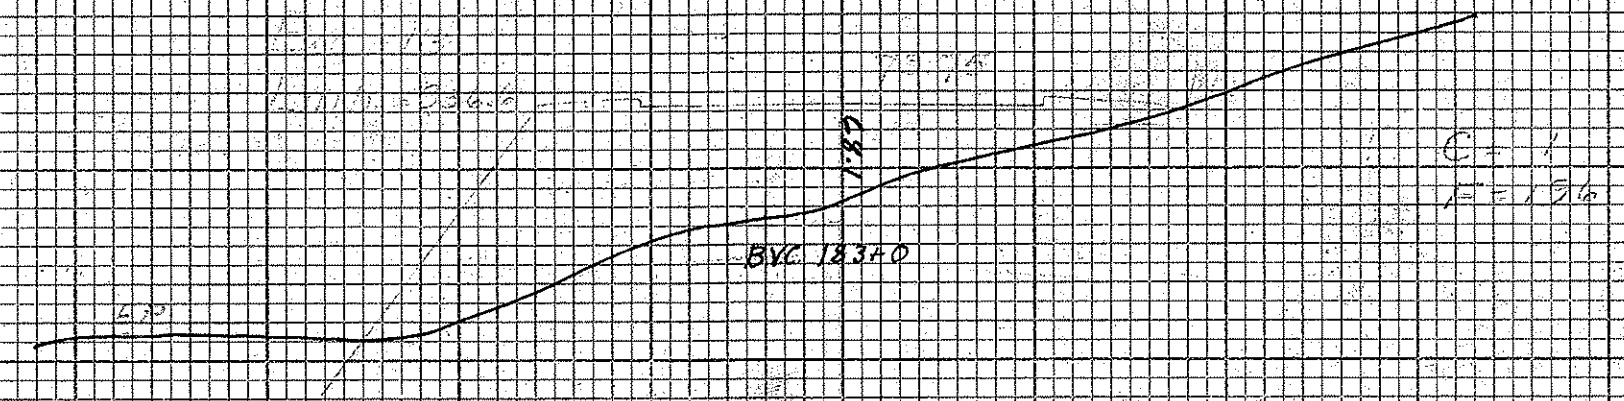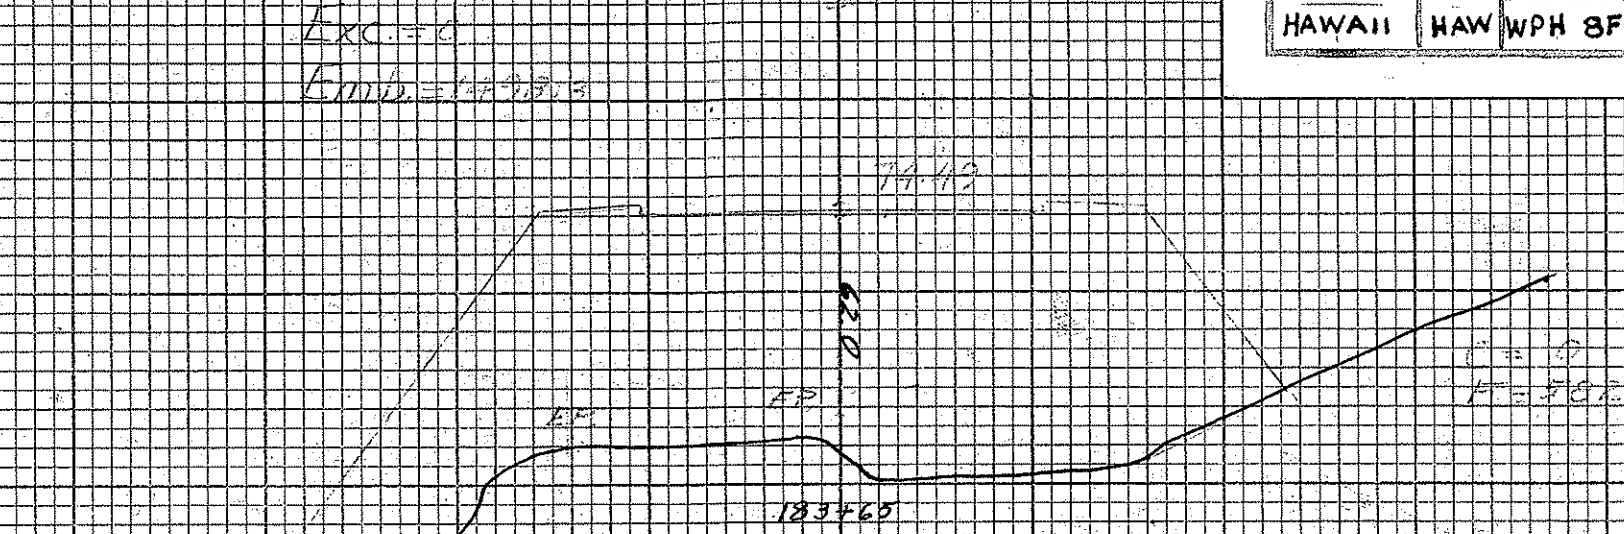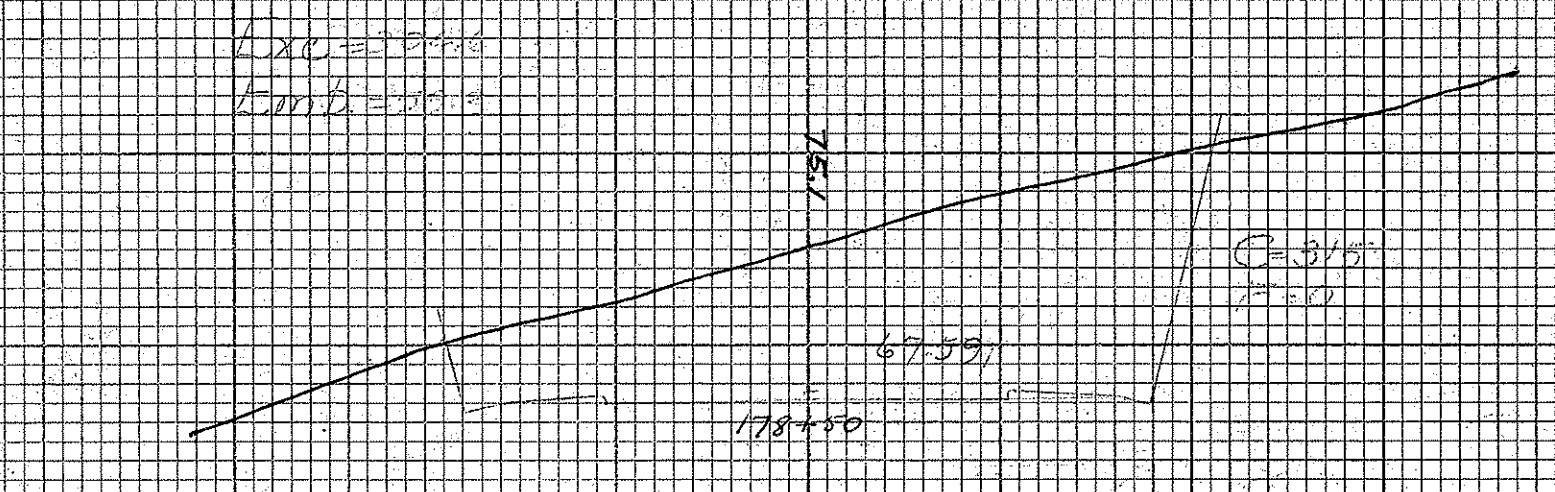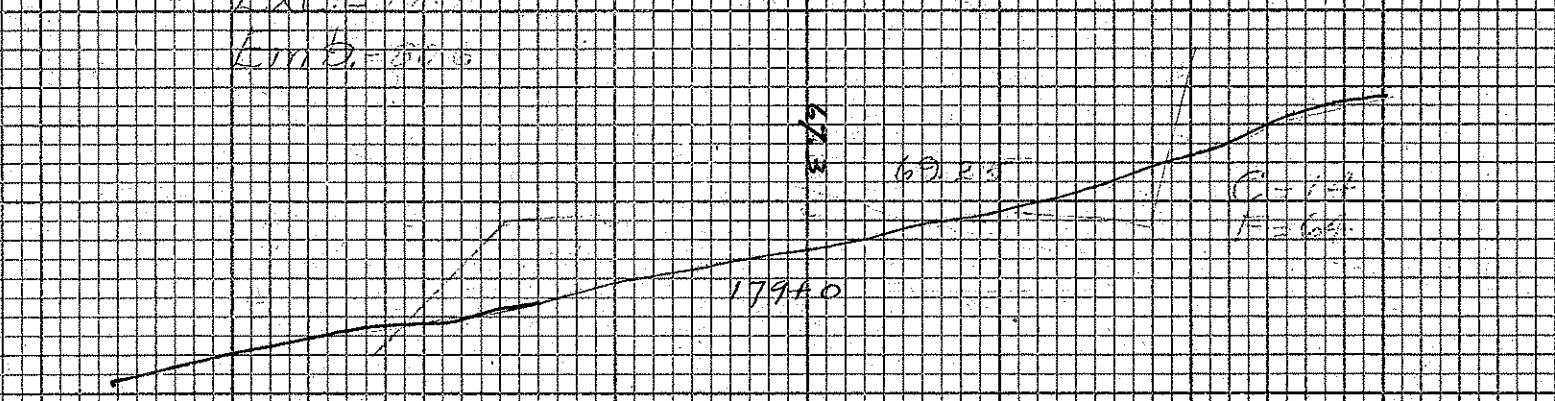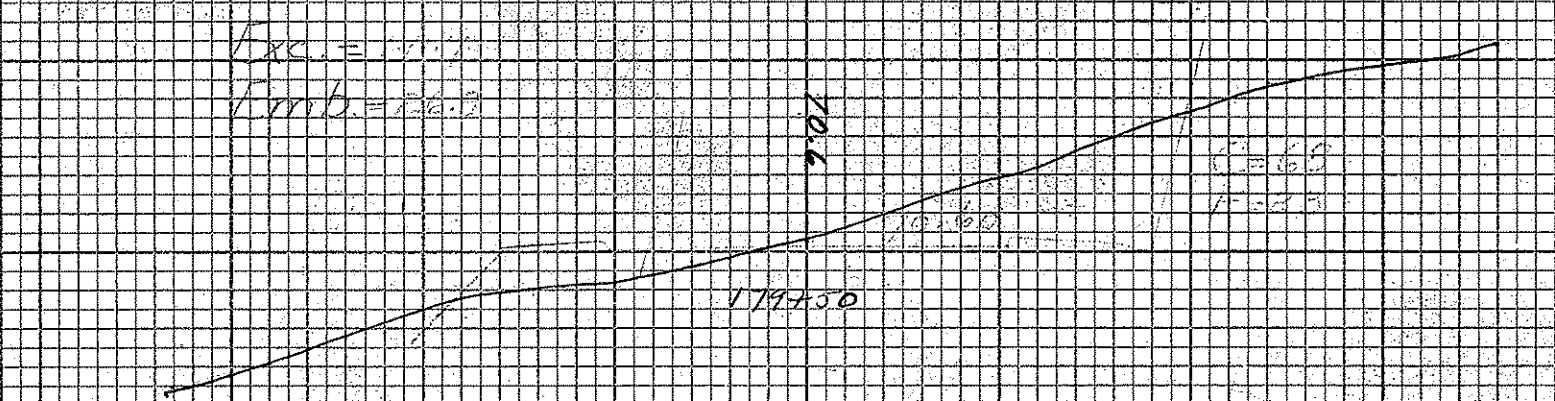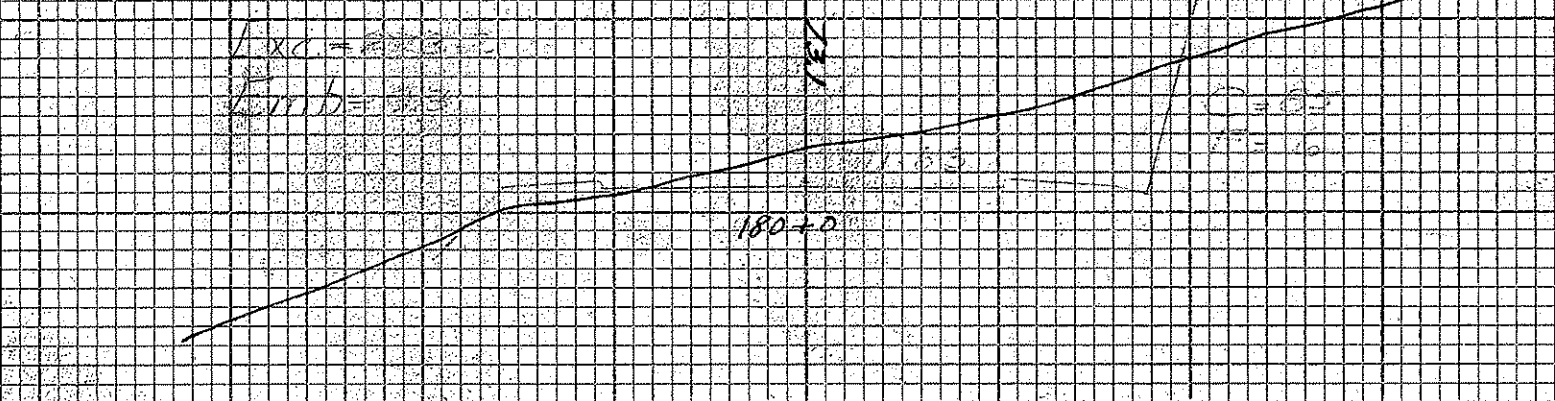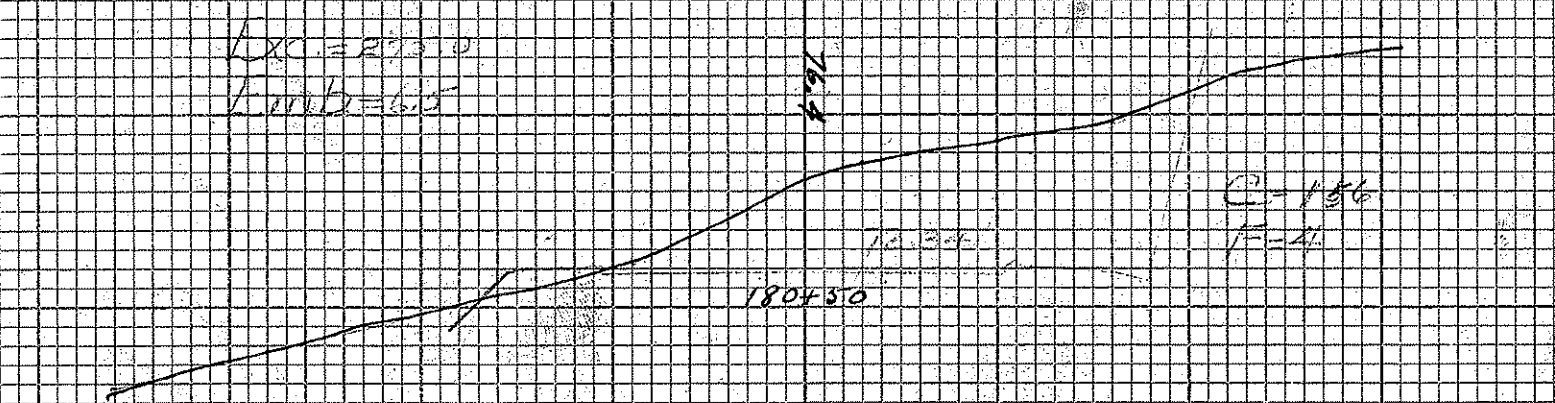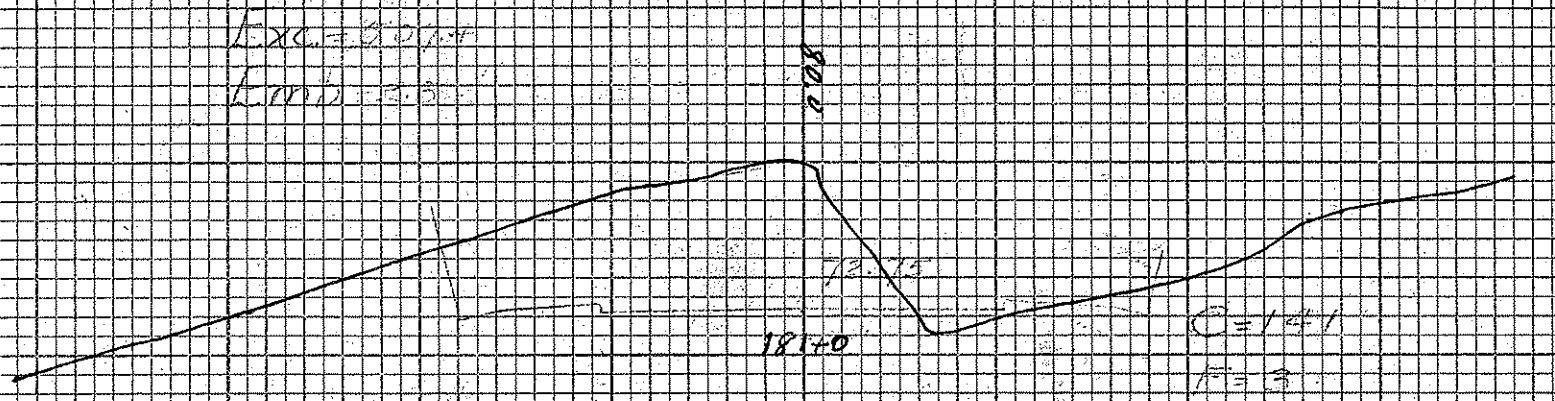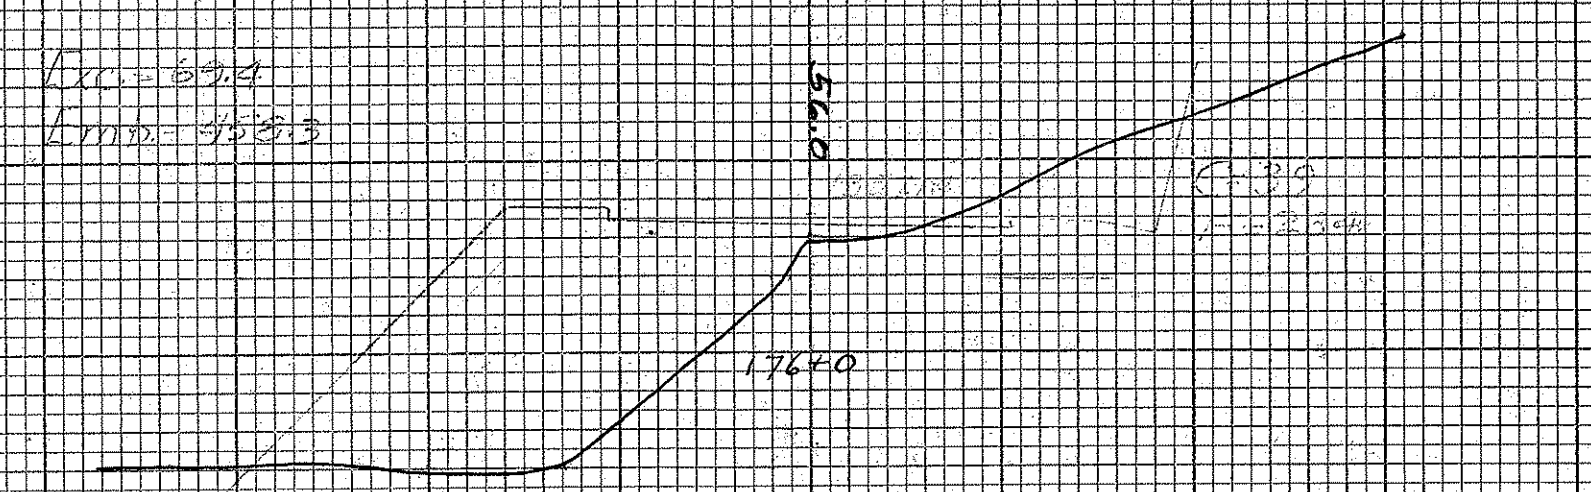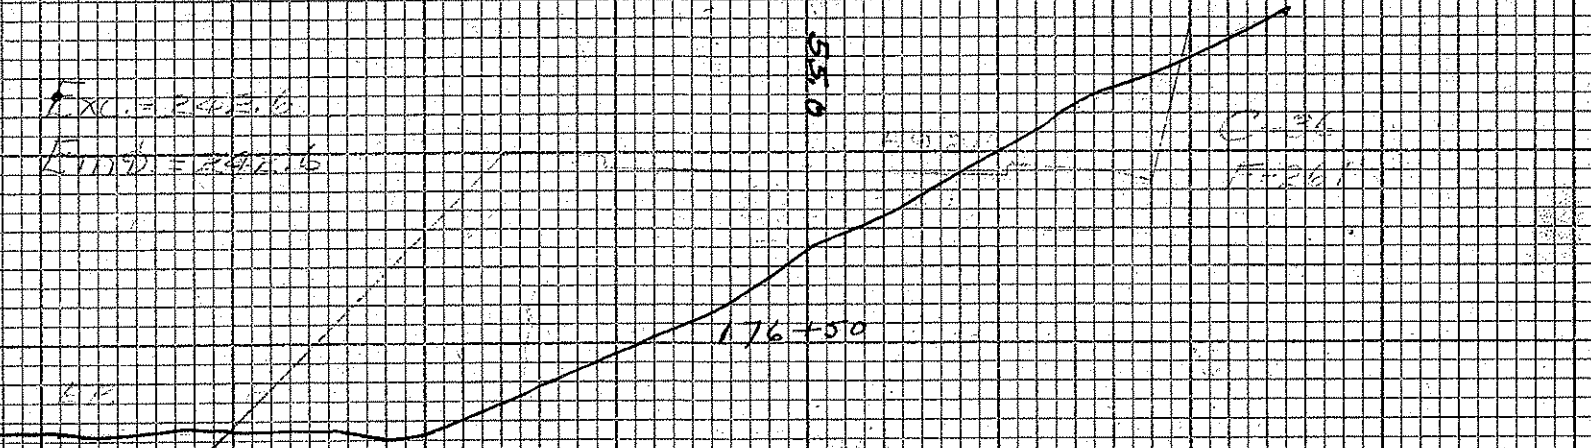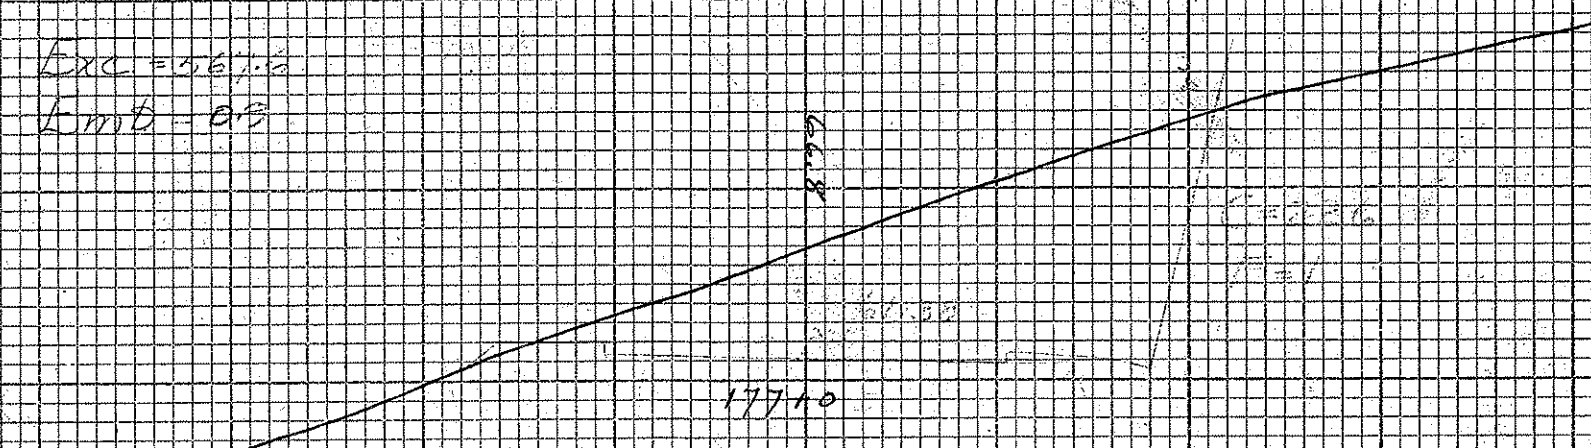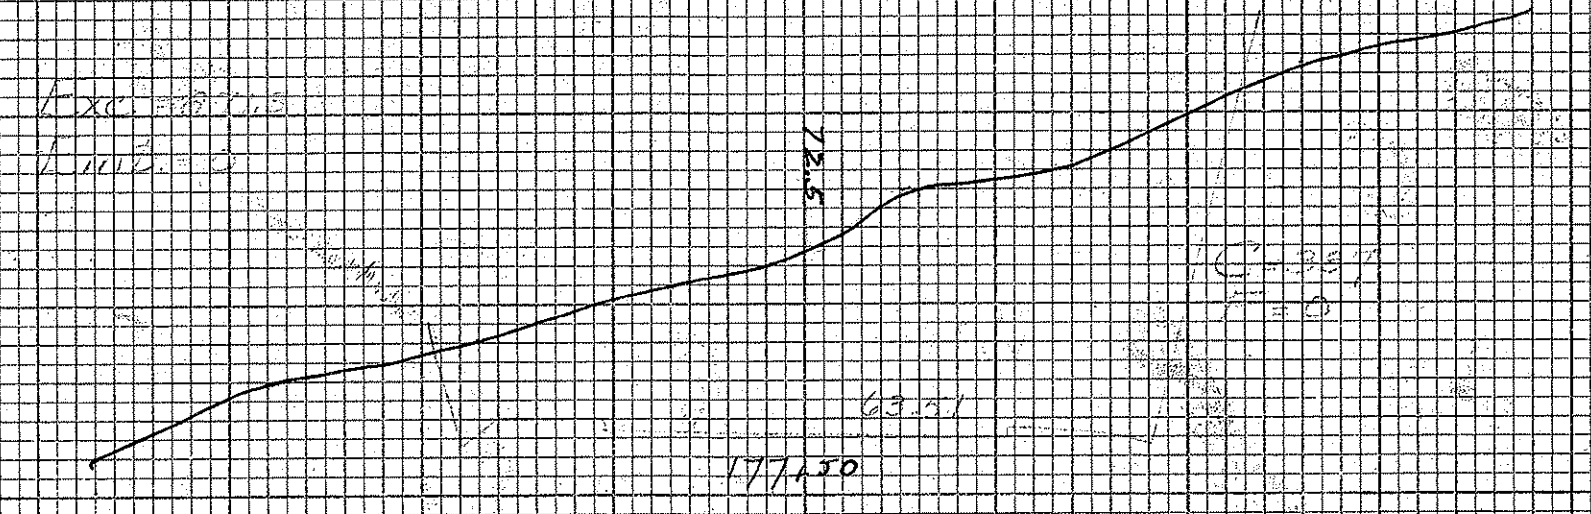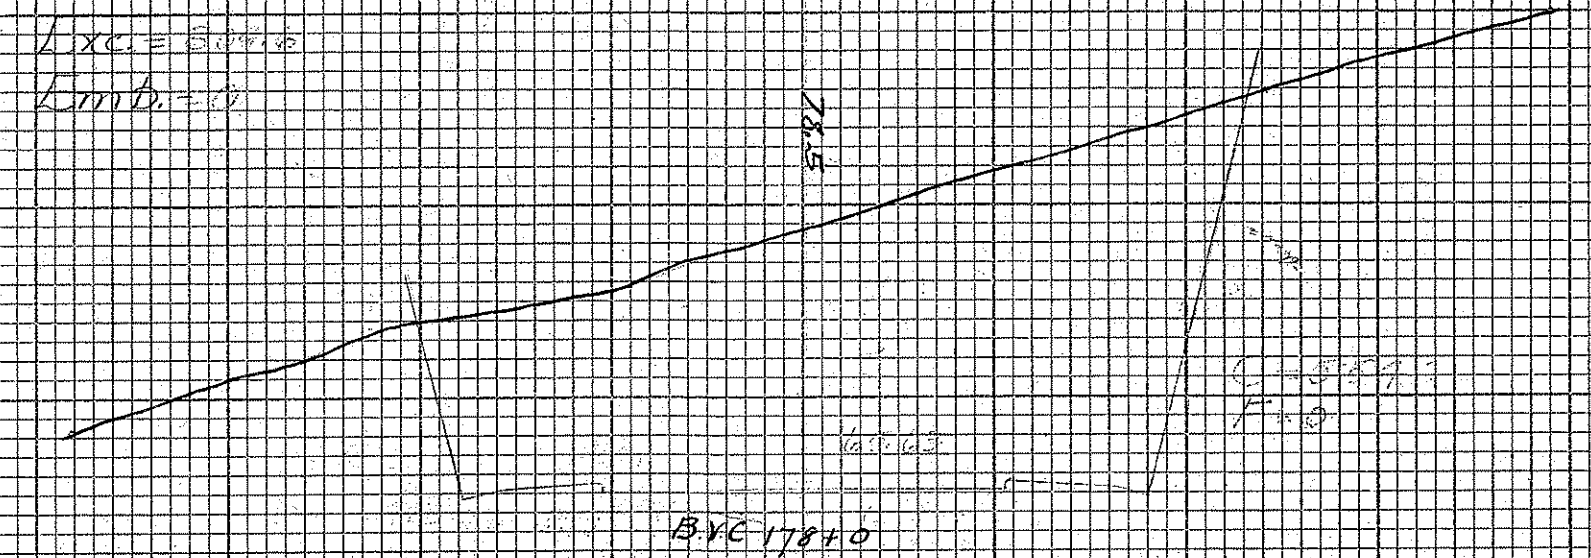

Note: Fill Slope 3/4 = 1.56/1.22 = 1.90/1.00

FINAL SURVEY	SURVEYED	BY	DATE
	PLOTTED		
NOTE BOOK	TEMPLATE		
	AREAS		
NO.	AREAS CHECKED		

ORIGINAL				BY	DATE
SURVEY	SURVED			GC	10 - 35
	PLOTTED			W.C.	10 - 35
NOTE BOOK	TEMPLATE			GC	11 - 35
	AREAS			W.C. & B.T.	11 - 35
NO.	AREAS CHECKED			W.C. & B.T.	11 - 35

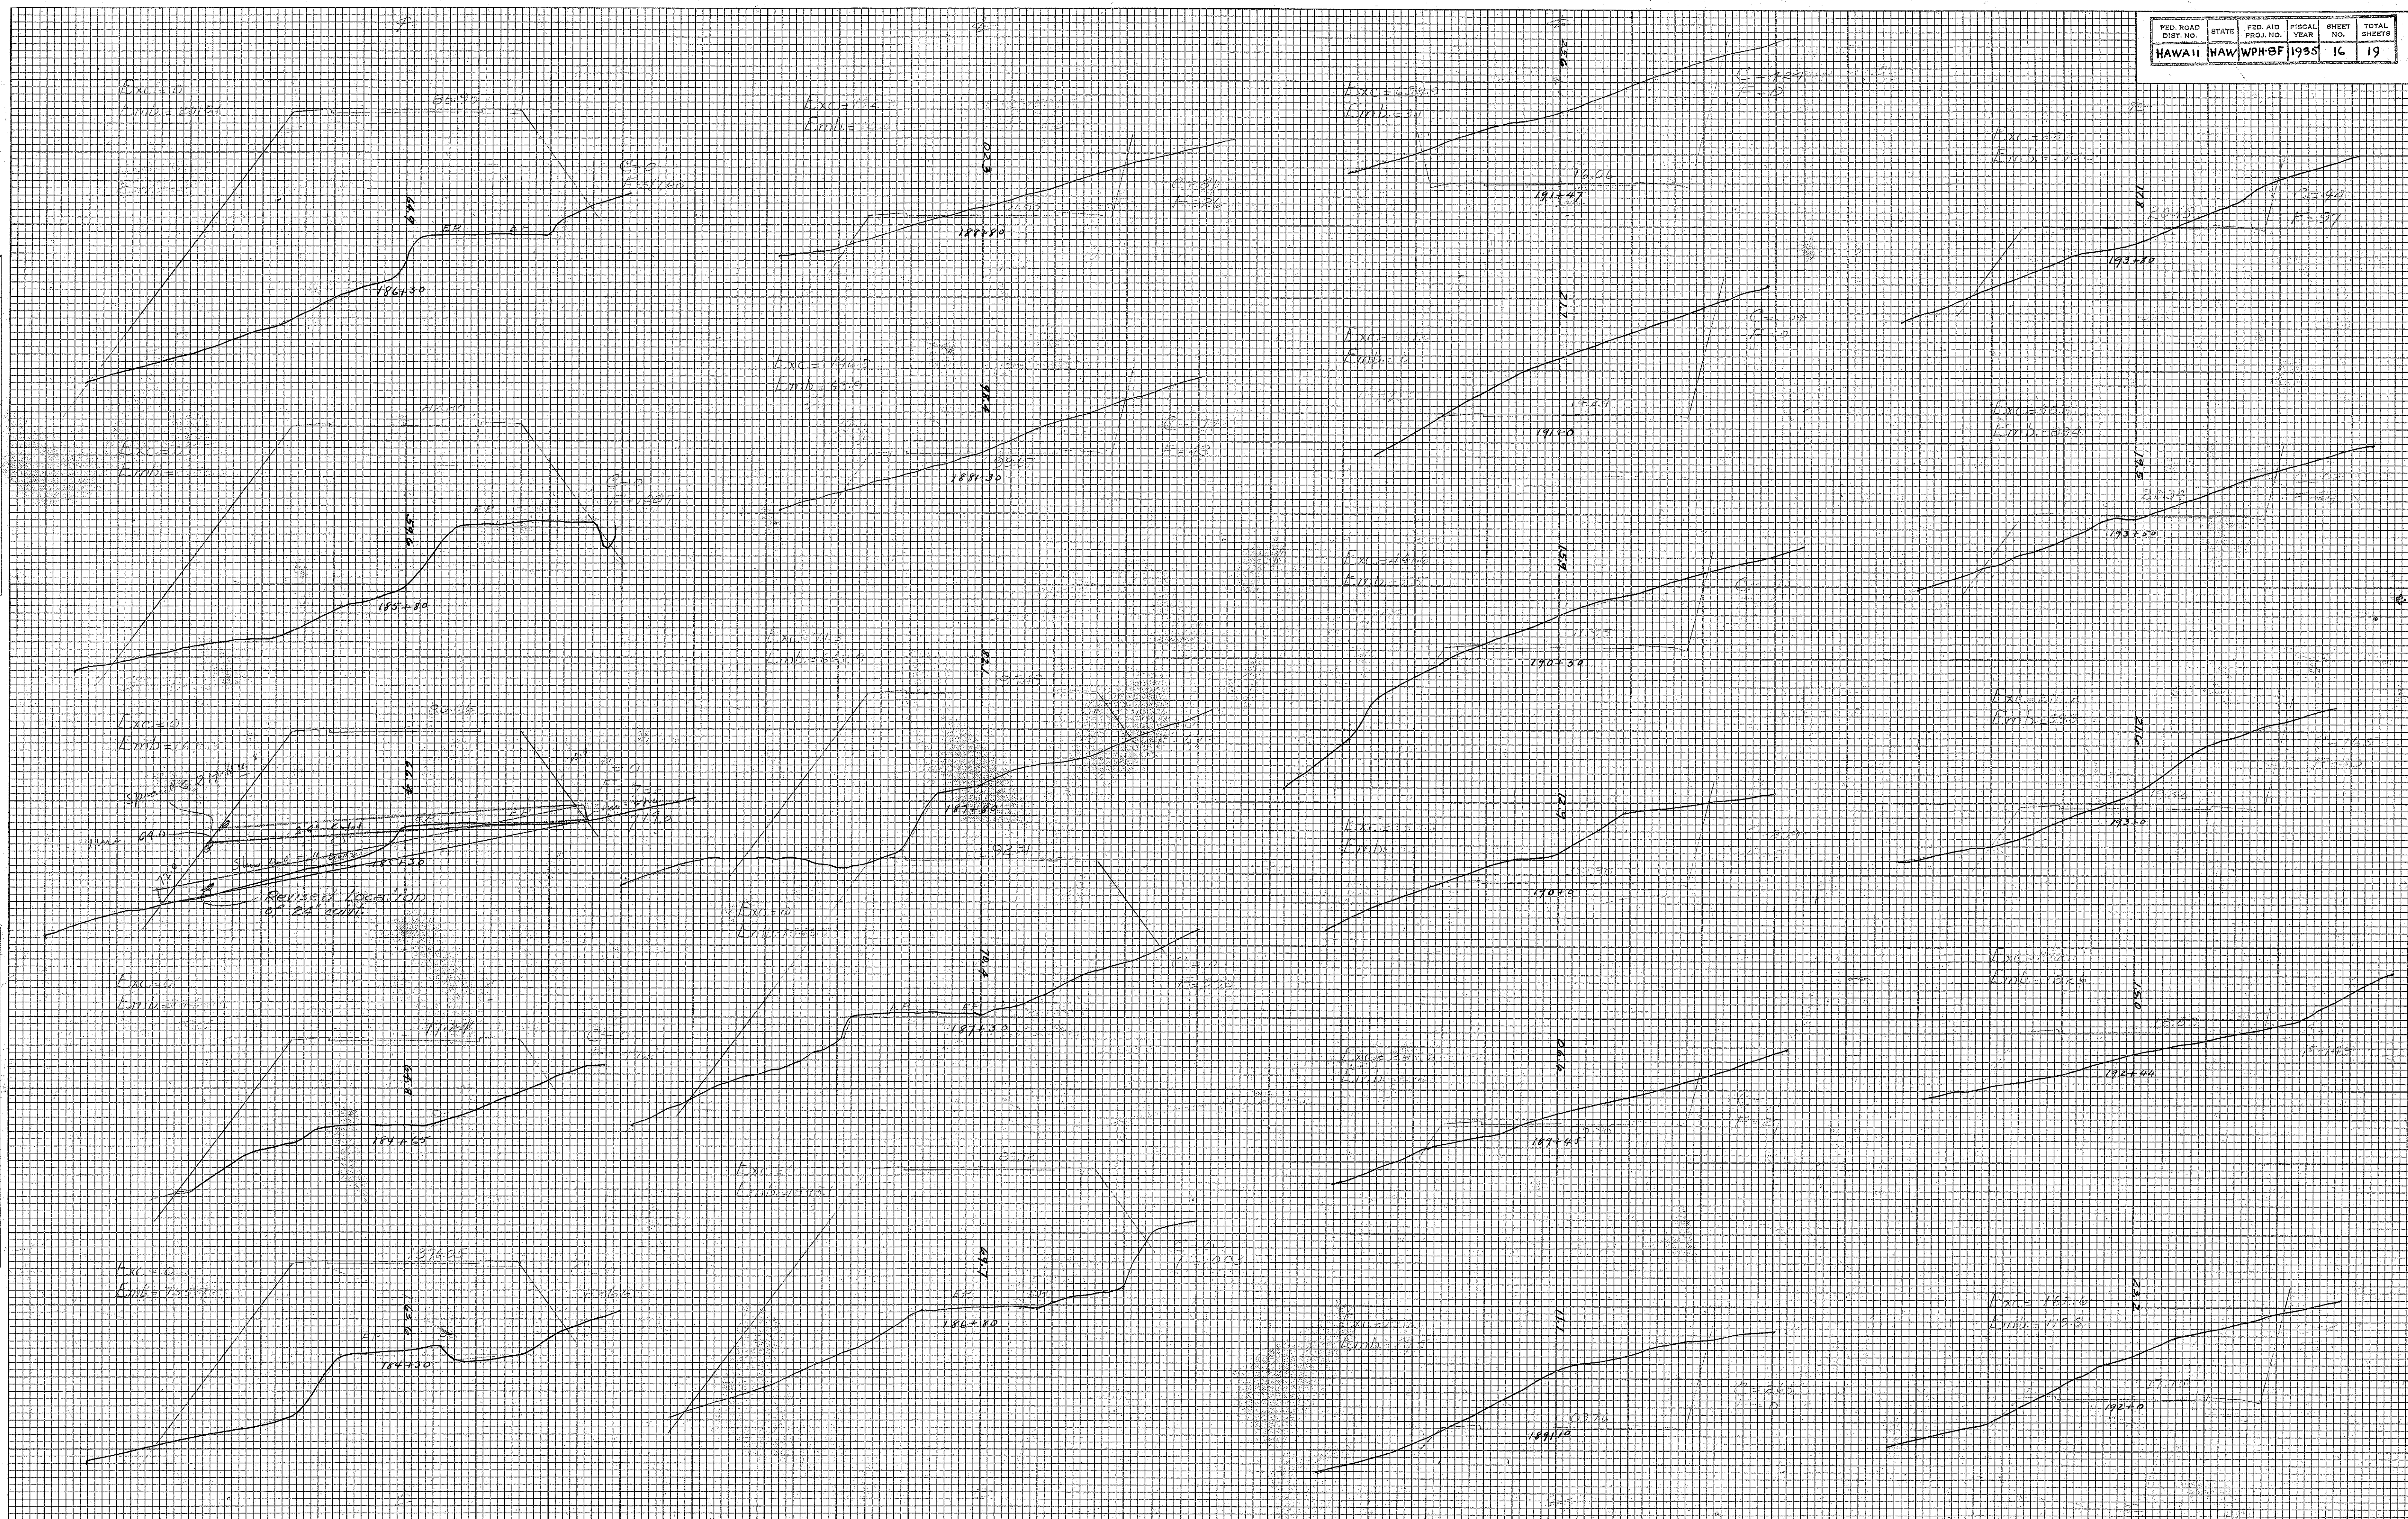

4352.16


ORIGINAL SURVEY	BY	DATE
SURVEYED	GC	11-35
PLOTTED	W.C.	11-35
TEMPLE		11-35
AREAS	128.84 6.00	11-35
AREAS CHECKED	69 3.50	11-35
NO.		

PLATE 3—CROSS SECTION: O. P. R. & R. E. STANDARD
KEUFFEL & ESSER CO., NEW YORK.

4352.17

FINAL SURVEY	SURVEYED _____	6Y _____	DATE _____
NOTE BOOK	PLOTTED _____		
NO.	TEMPLATE _____		
	AREAS _____		
	AREAS CHECKED _____		

ORIGINAL			BY	DATE
SURVEY	SURVEYED		GC	10-35
	PLOTTED		GC	11-35
NOTE BOOK	TEMPLATE		GC	11-35
	AREAS		GC	11-35
NO.	AREAS CHECKED		W.R. E. R.R.	11-35

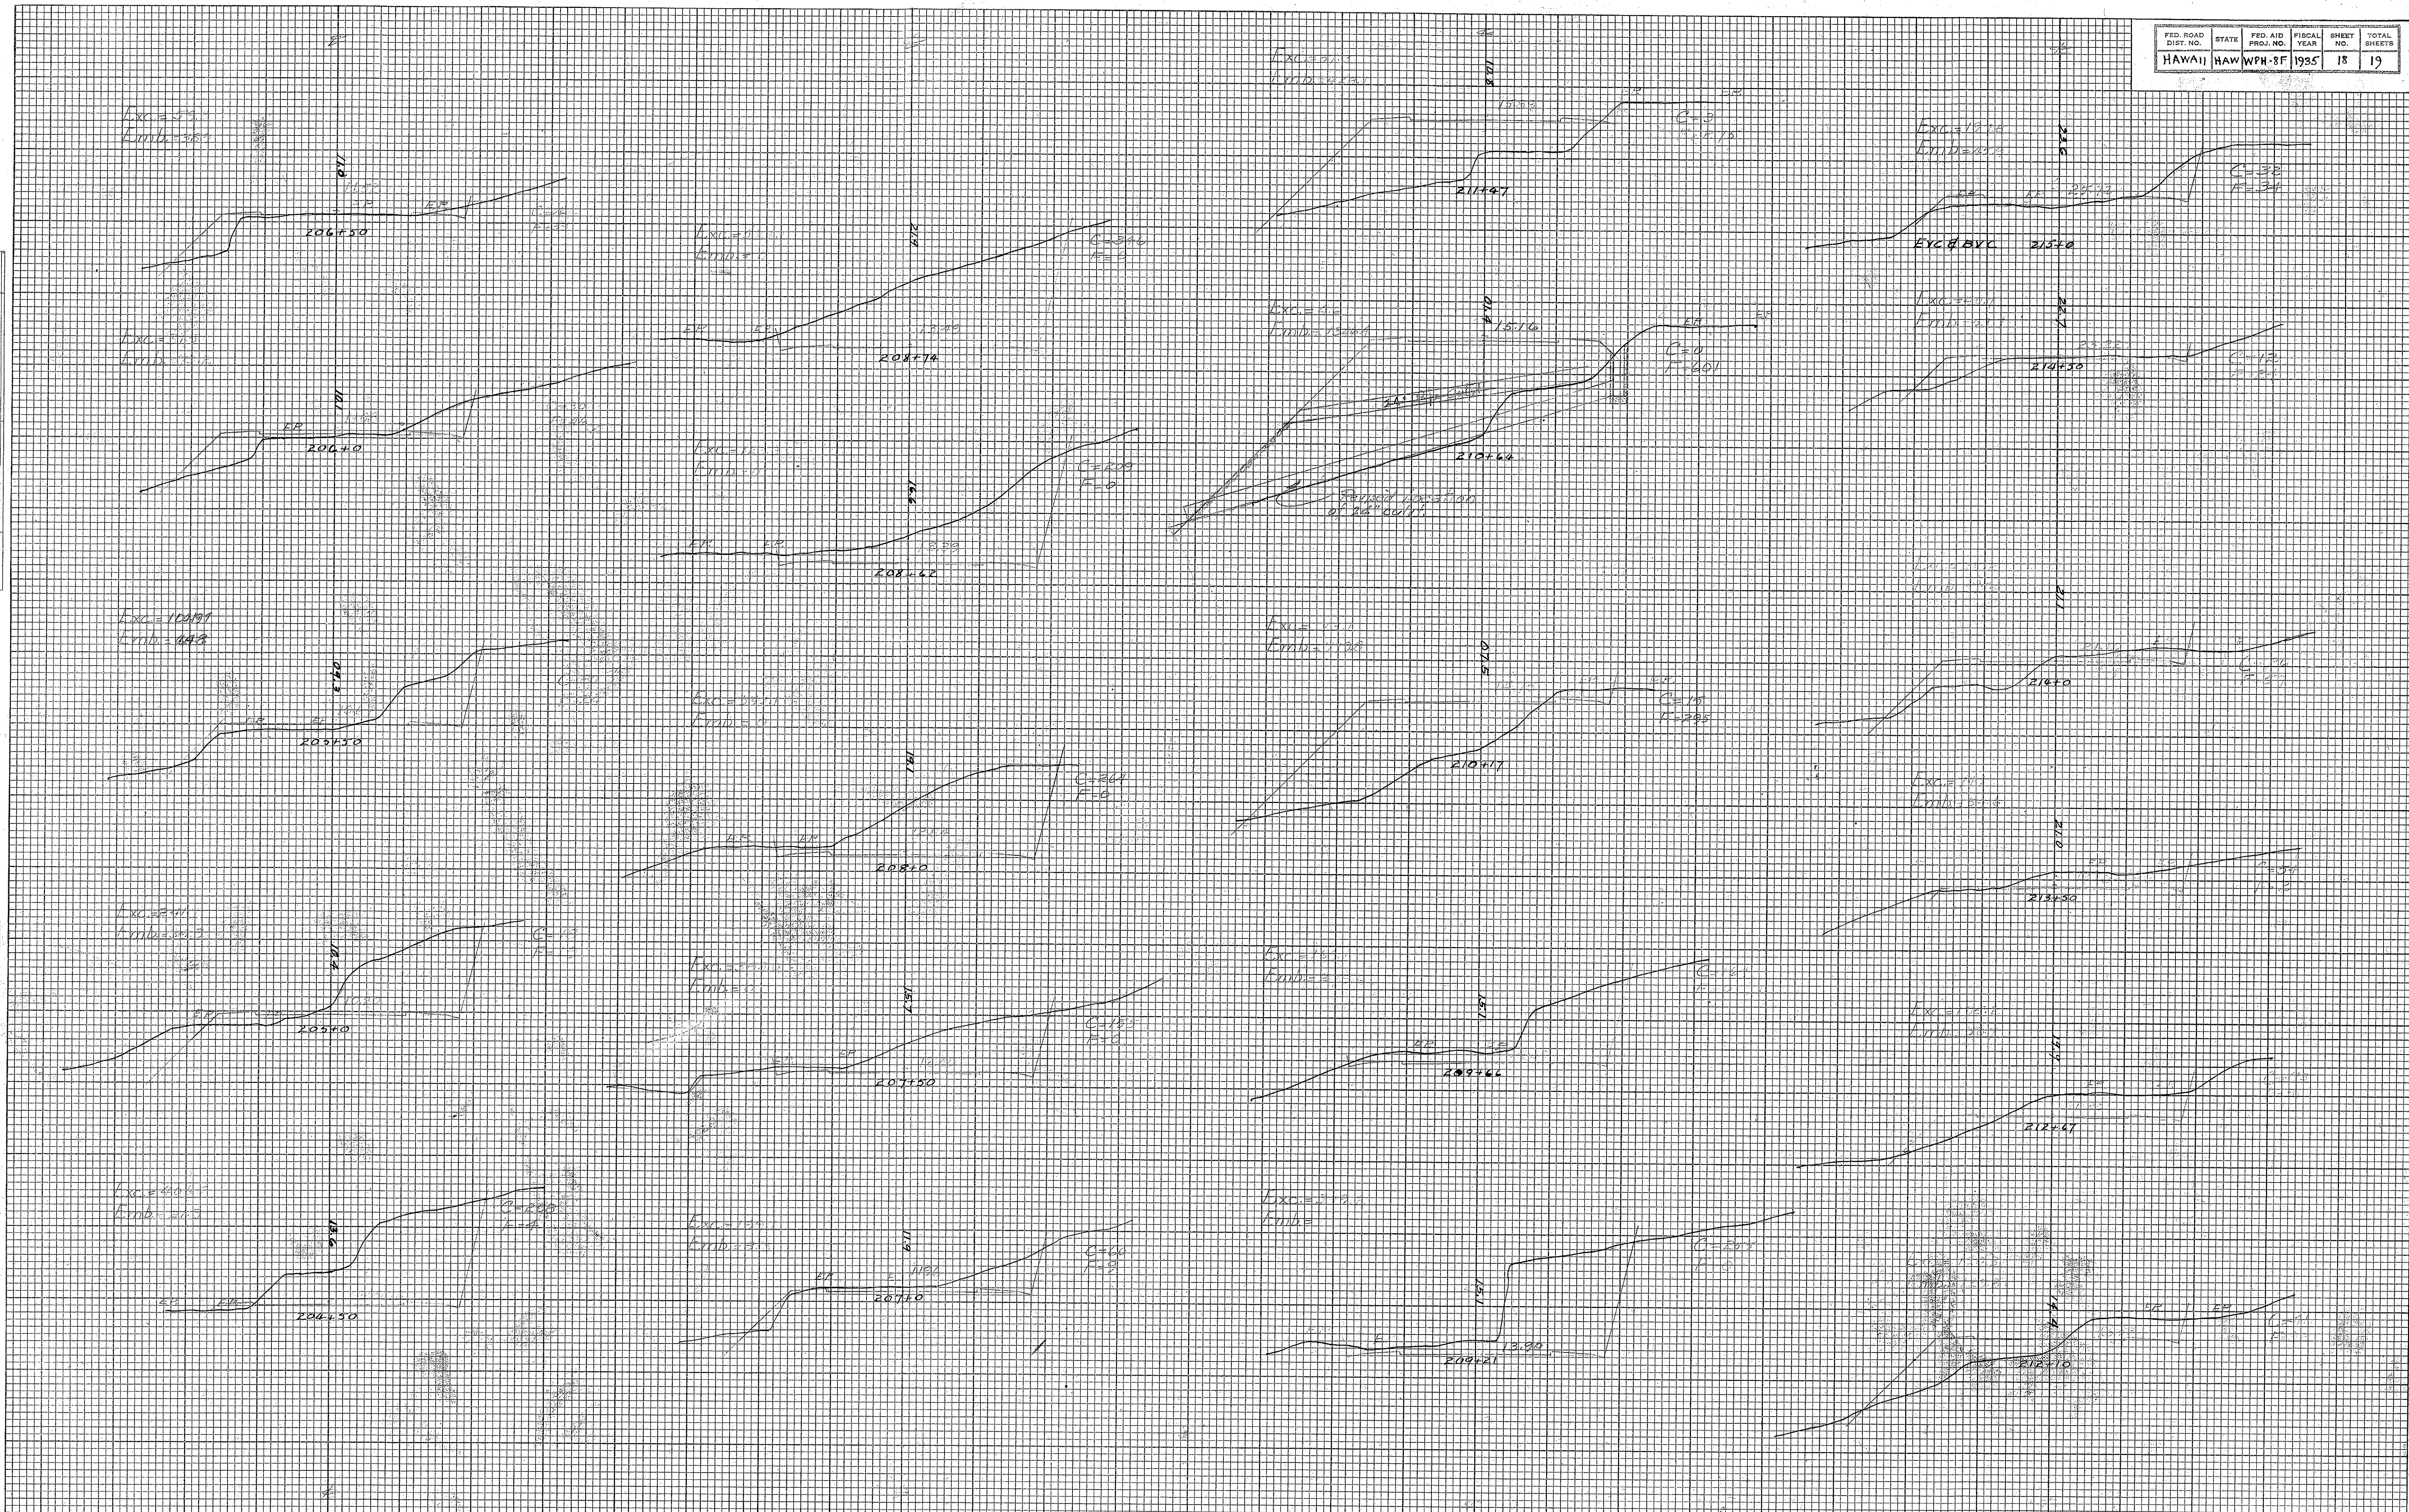

FINAL SURVEY
 BY: _____
 DATE: _____
 NO. _____

ORIGINAL SURVEY
 BY: _____
 DATE: _____
 NO. _____

