


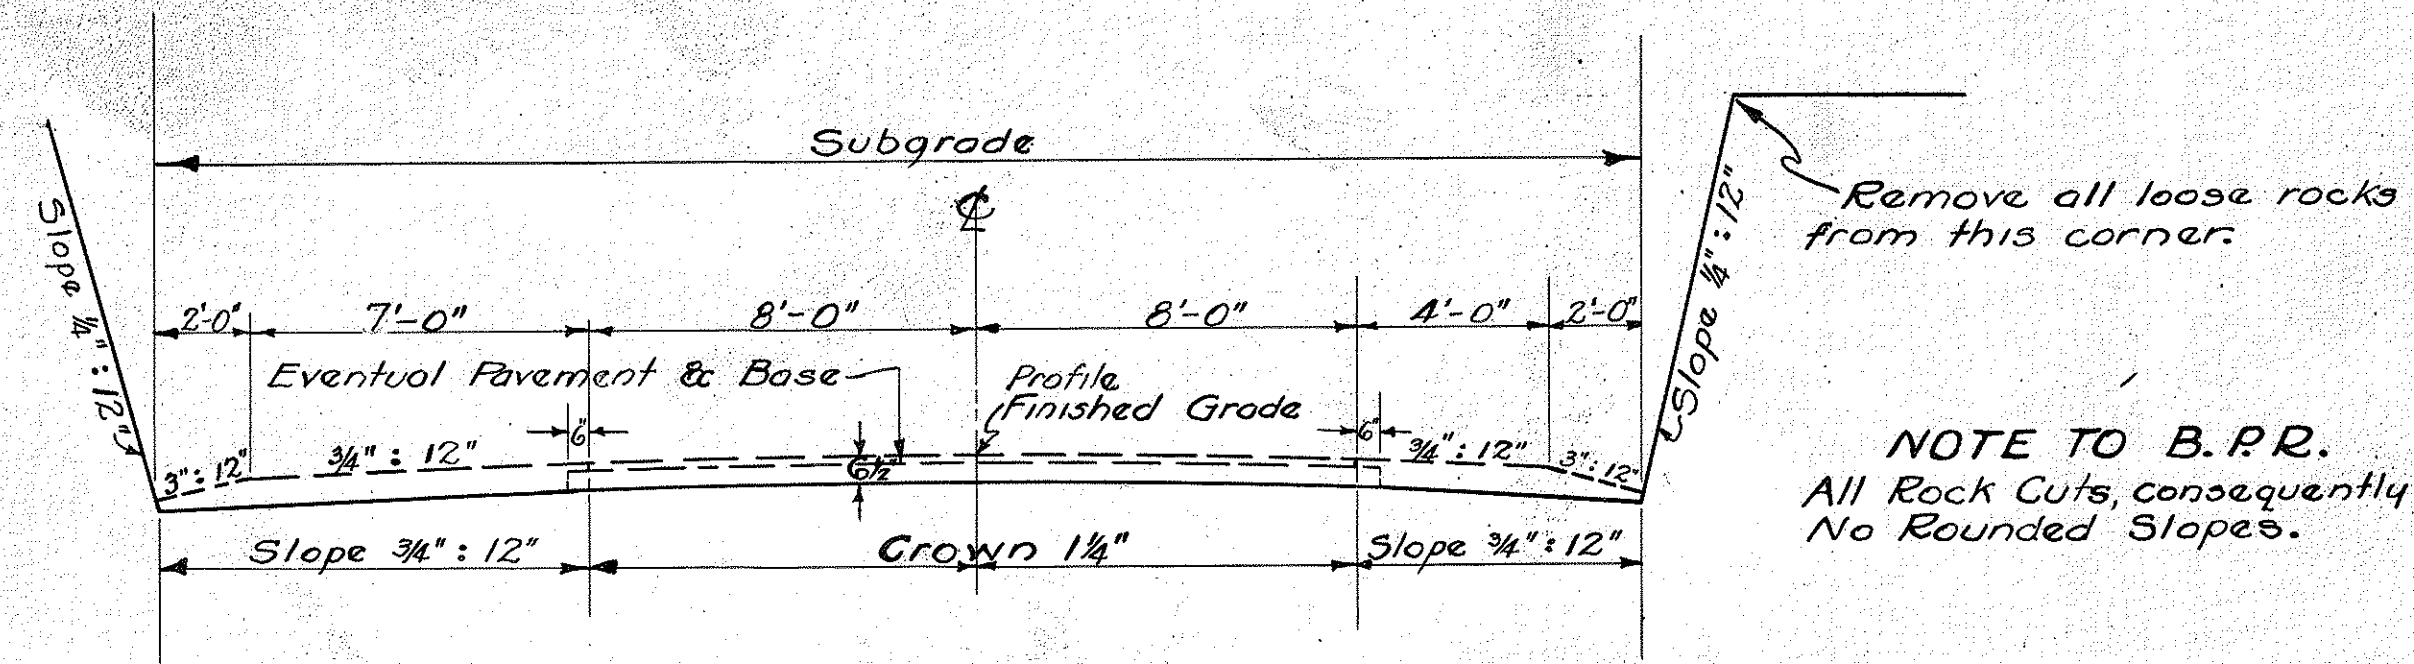
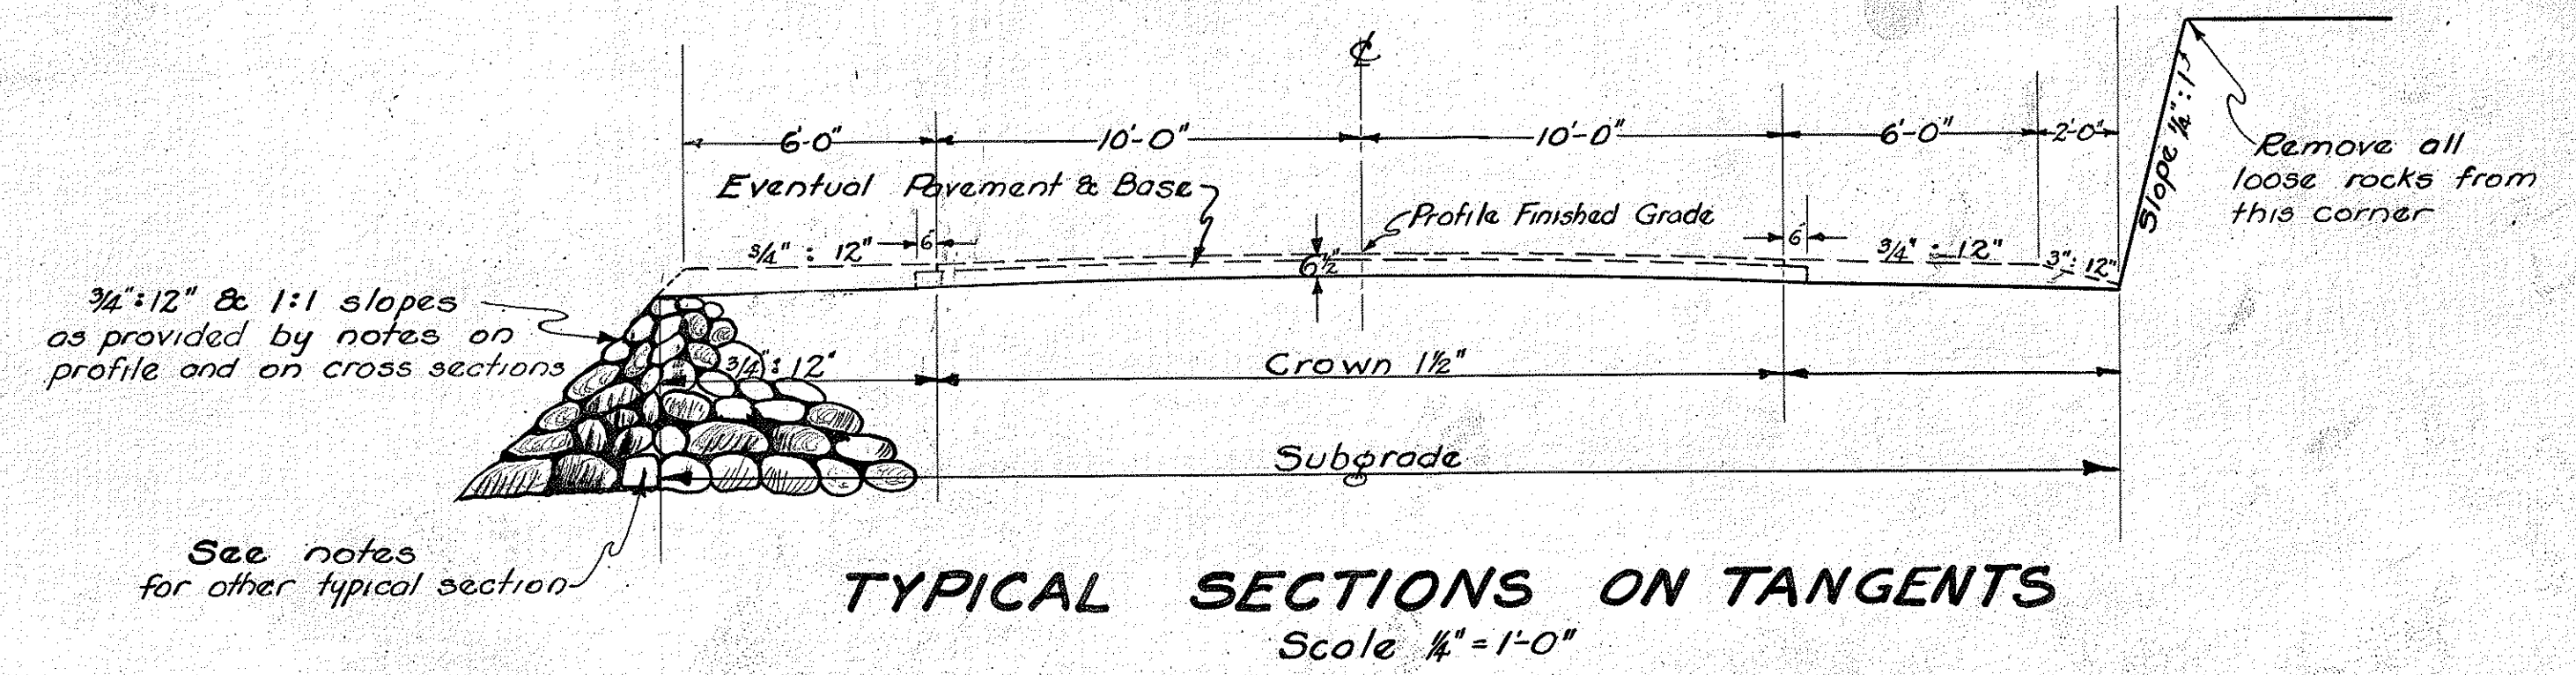


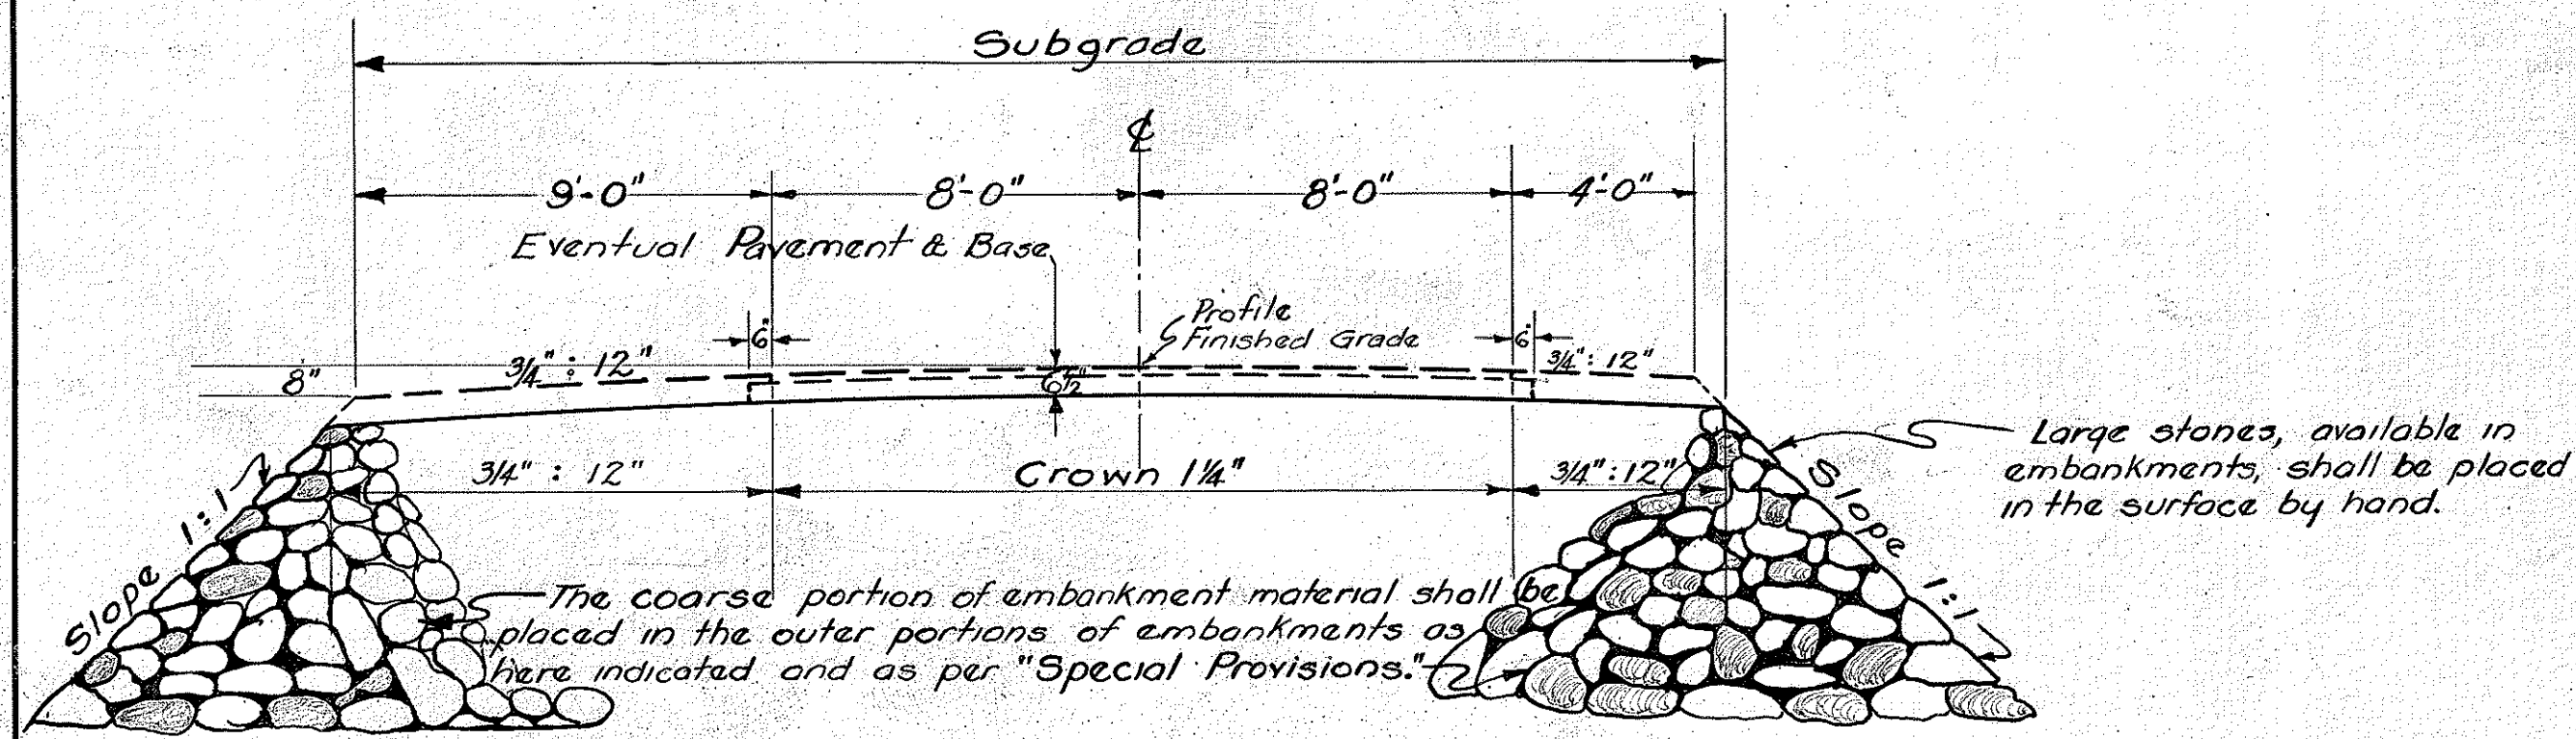

TYPICAL SECTIONS ON TANGENTS
Scale 1/4" = 1'-0"

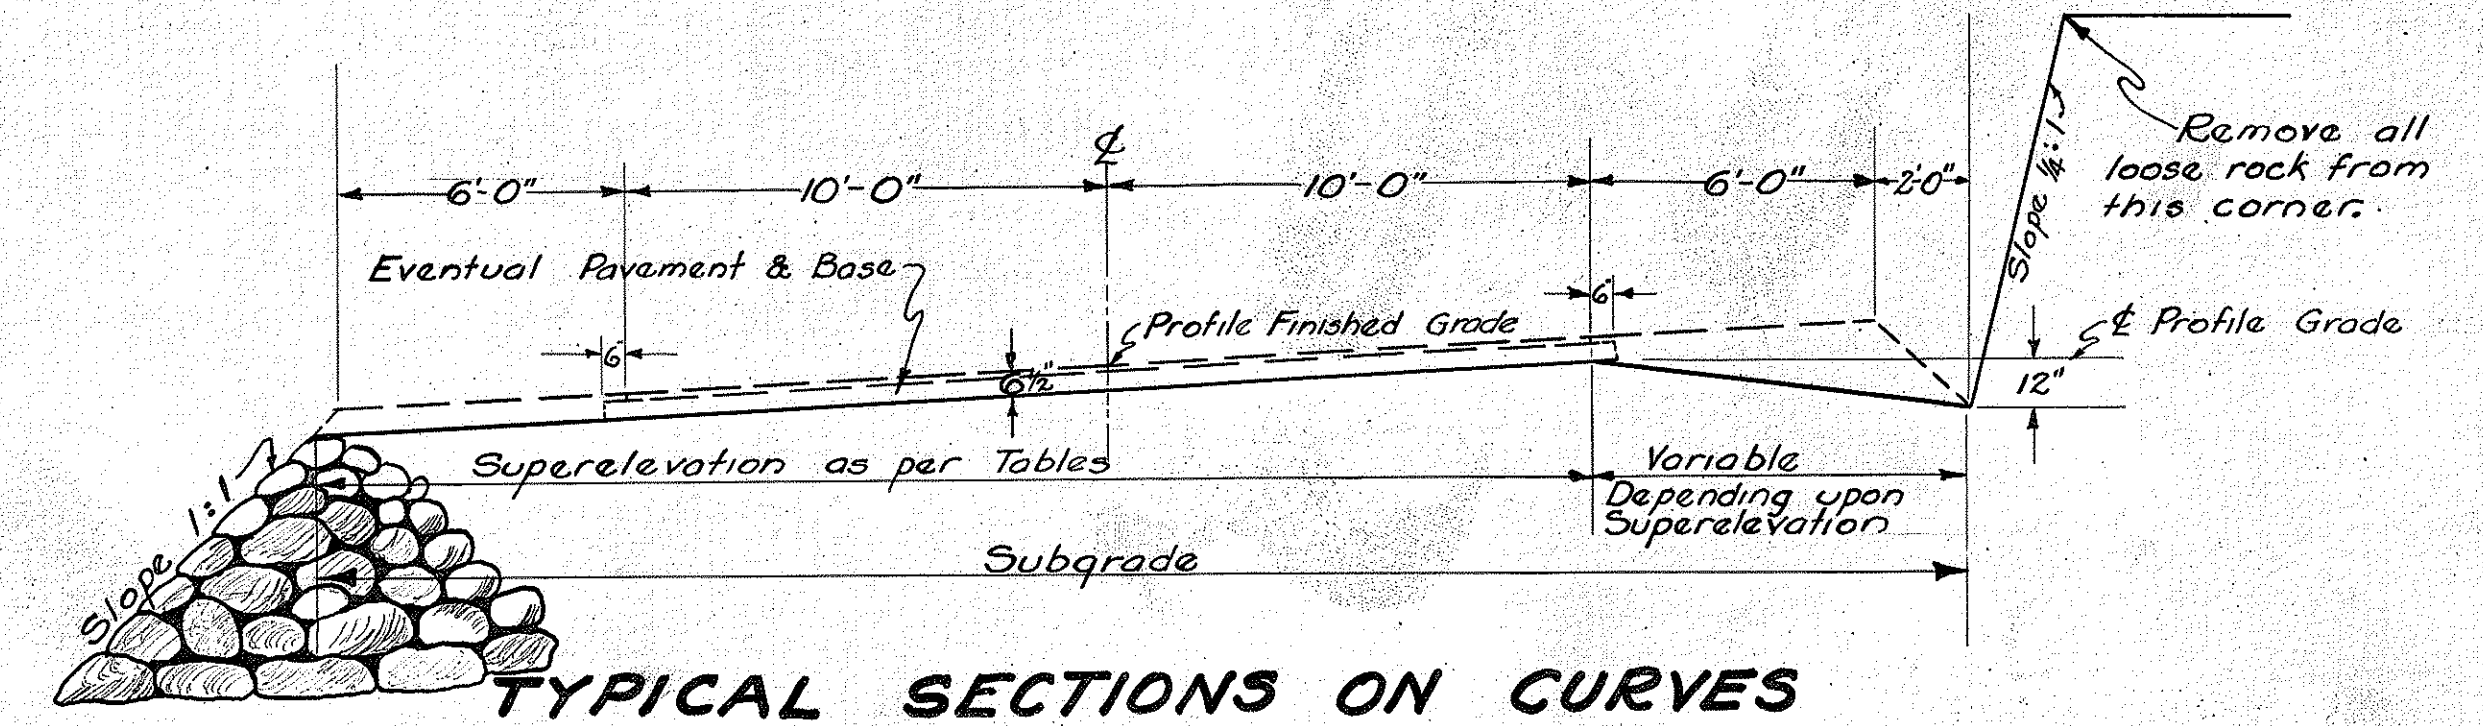

TYPICAL SECTIONS STA. 168+71^{1/2} to STA. 222+50

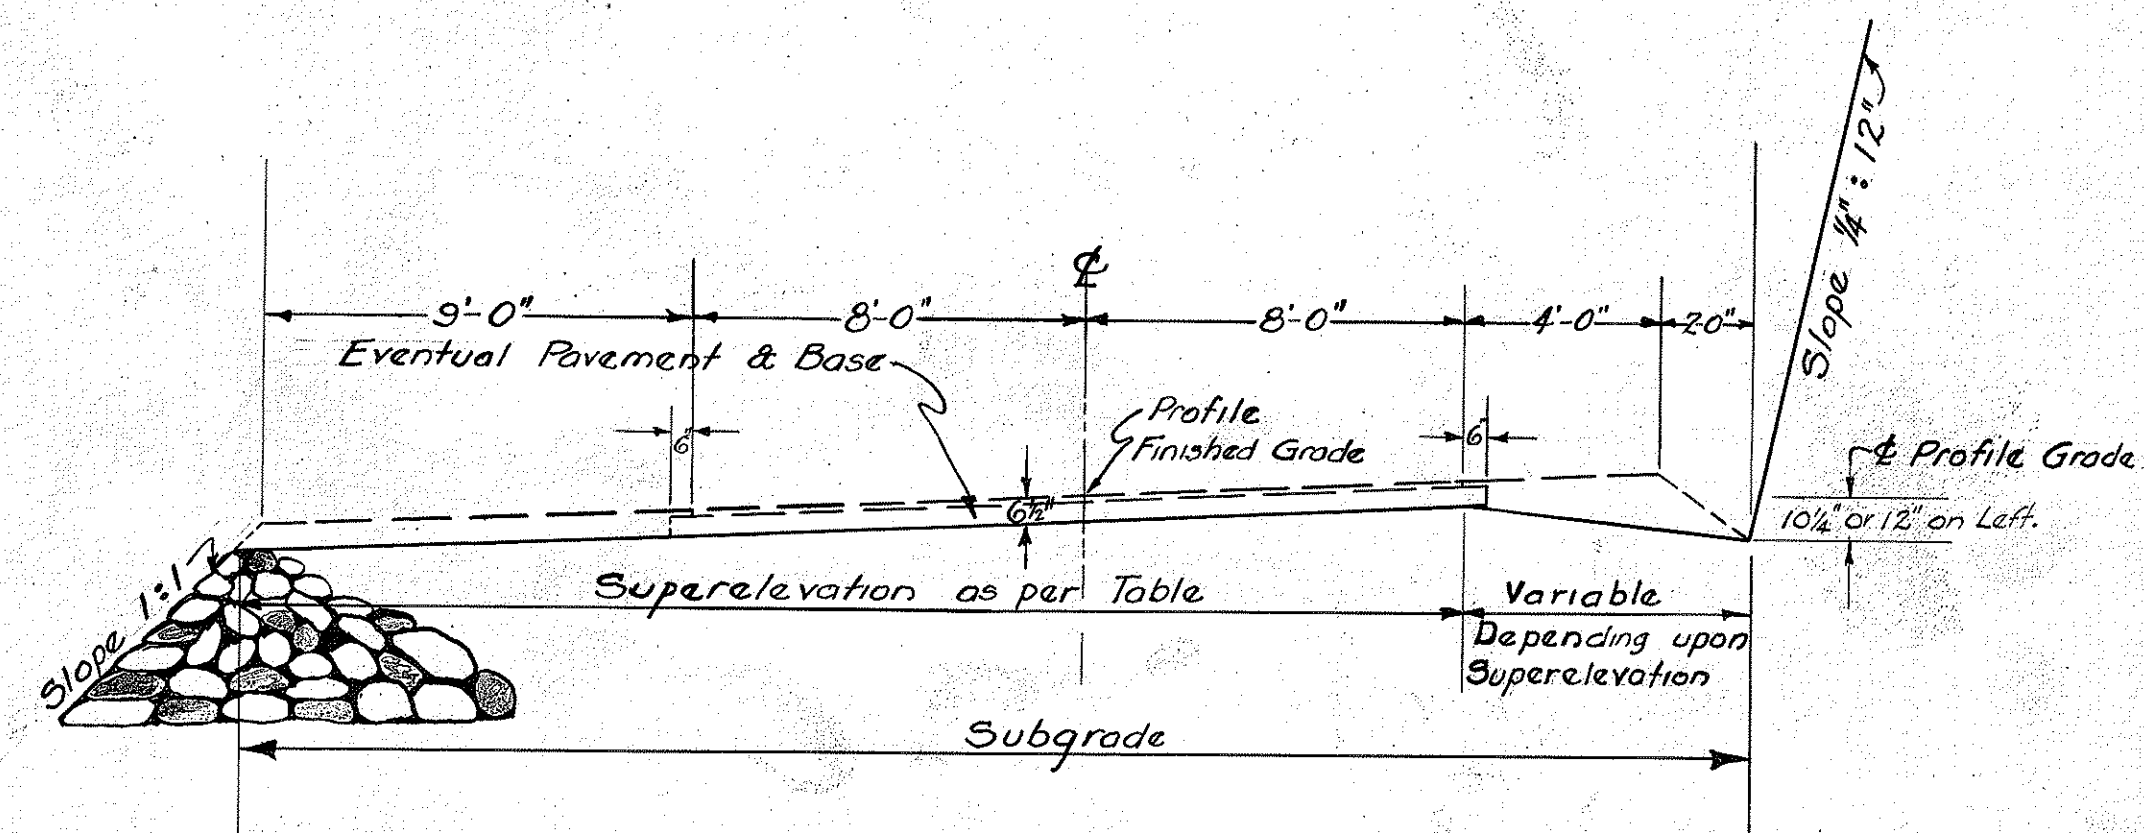

TYPICAL SECTIONS
STA. 46+50 to STA. 166+36^{1/2}
Scale 1/4" = 1'-0"

SURVEY PLOTTED BY	DATE
DESIGNED BY	11-30-35
DRAWN BY	11-30-35
QUANTITIES BY	11-30-35
CHECKED BY	

ORIGINAL PLAN	No.
NOTE BOOK	