

INDEX TO DRAWINGS	
SHEET	DESCRIPTION
1	TITLE SHEET
2	TYPICAL SECTIONS
3	PLANS

STATE OF HAWAII

DEPARTMENT OF TRANSPORTATION

HIGHWAYS DIVISION

"AS BUILT" PLANS OF

WIDENING AND RESURFACING

OF A PORTION OF


KEAAU TOWARDS HILO ROAD

(OLAA TO HILO ROAD)

PROJECT NO. N-II-01-63

DISTRICT OF PUNA

ISLAND OF HAWAII

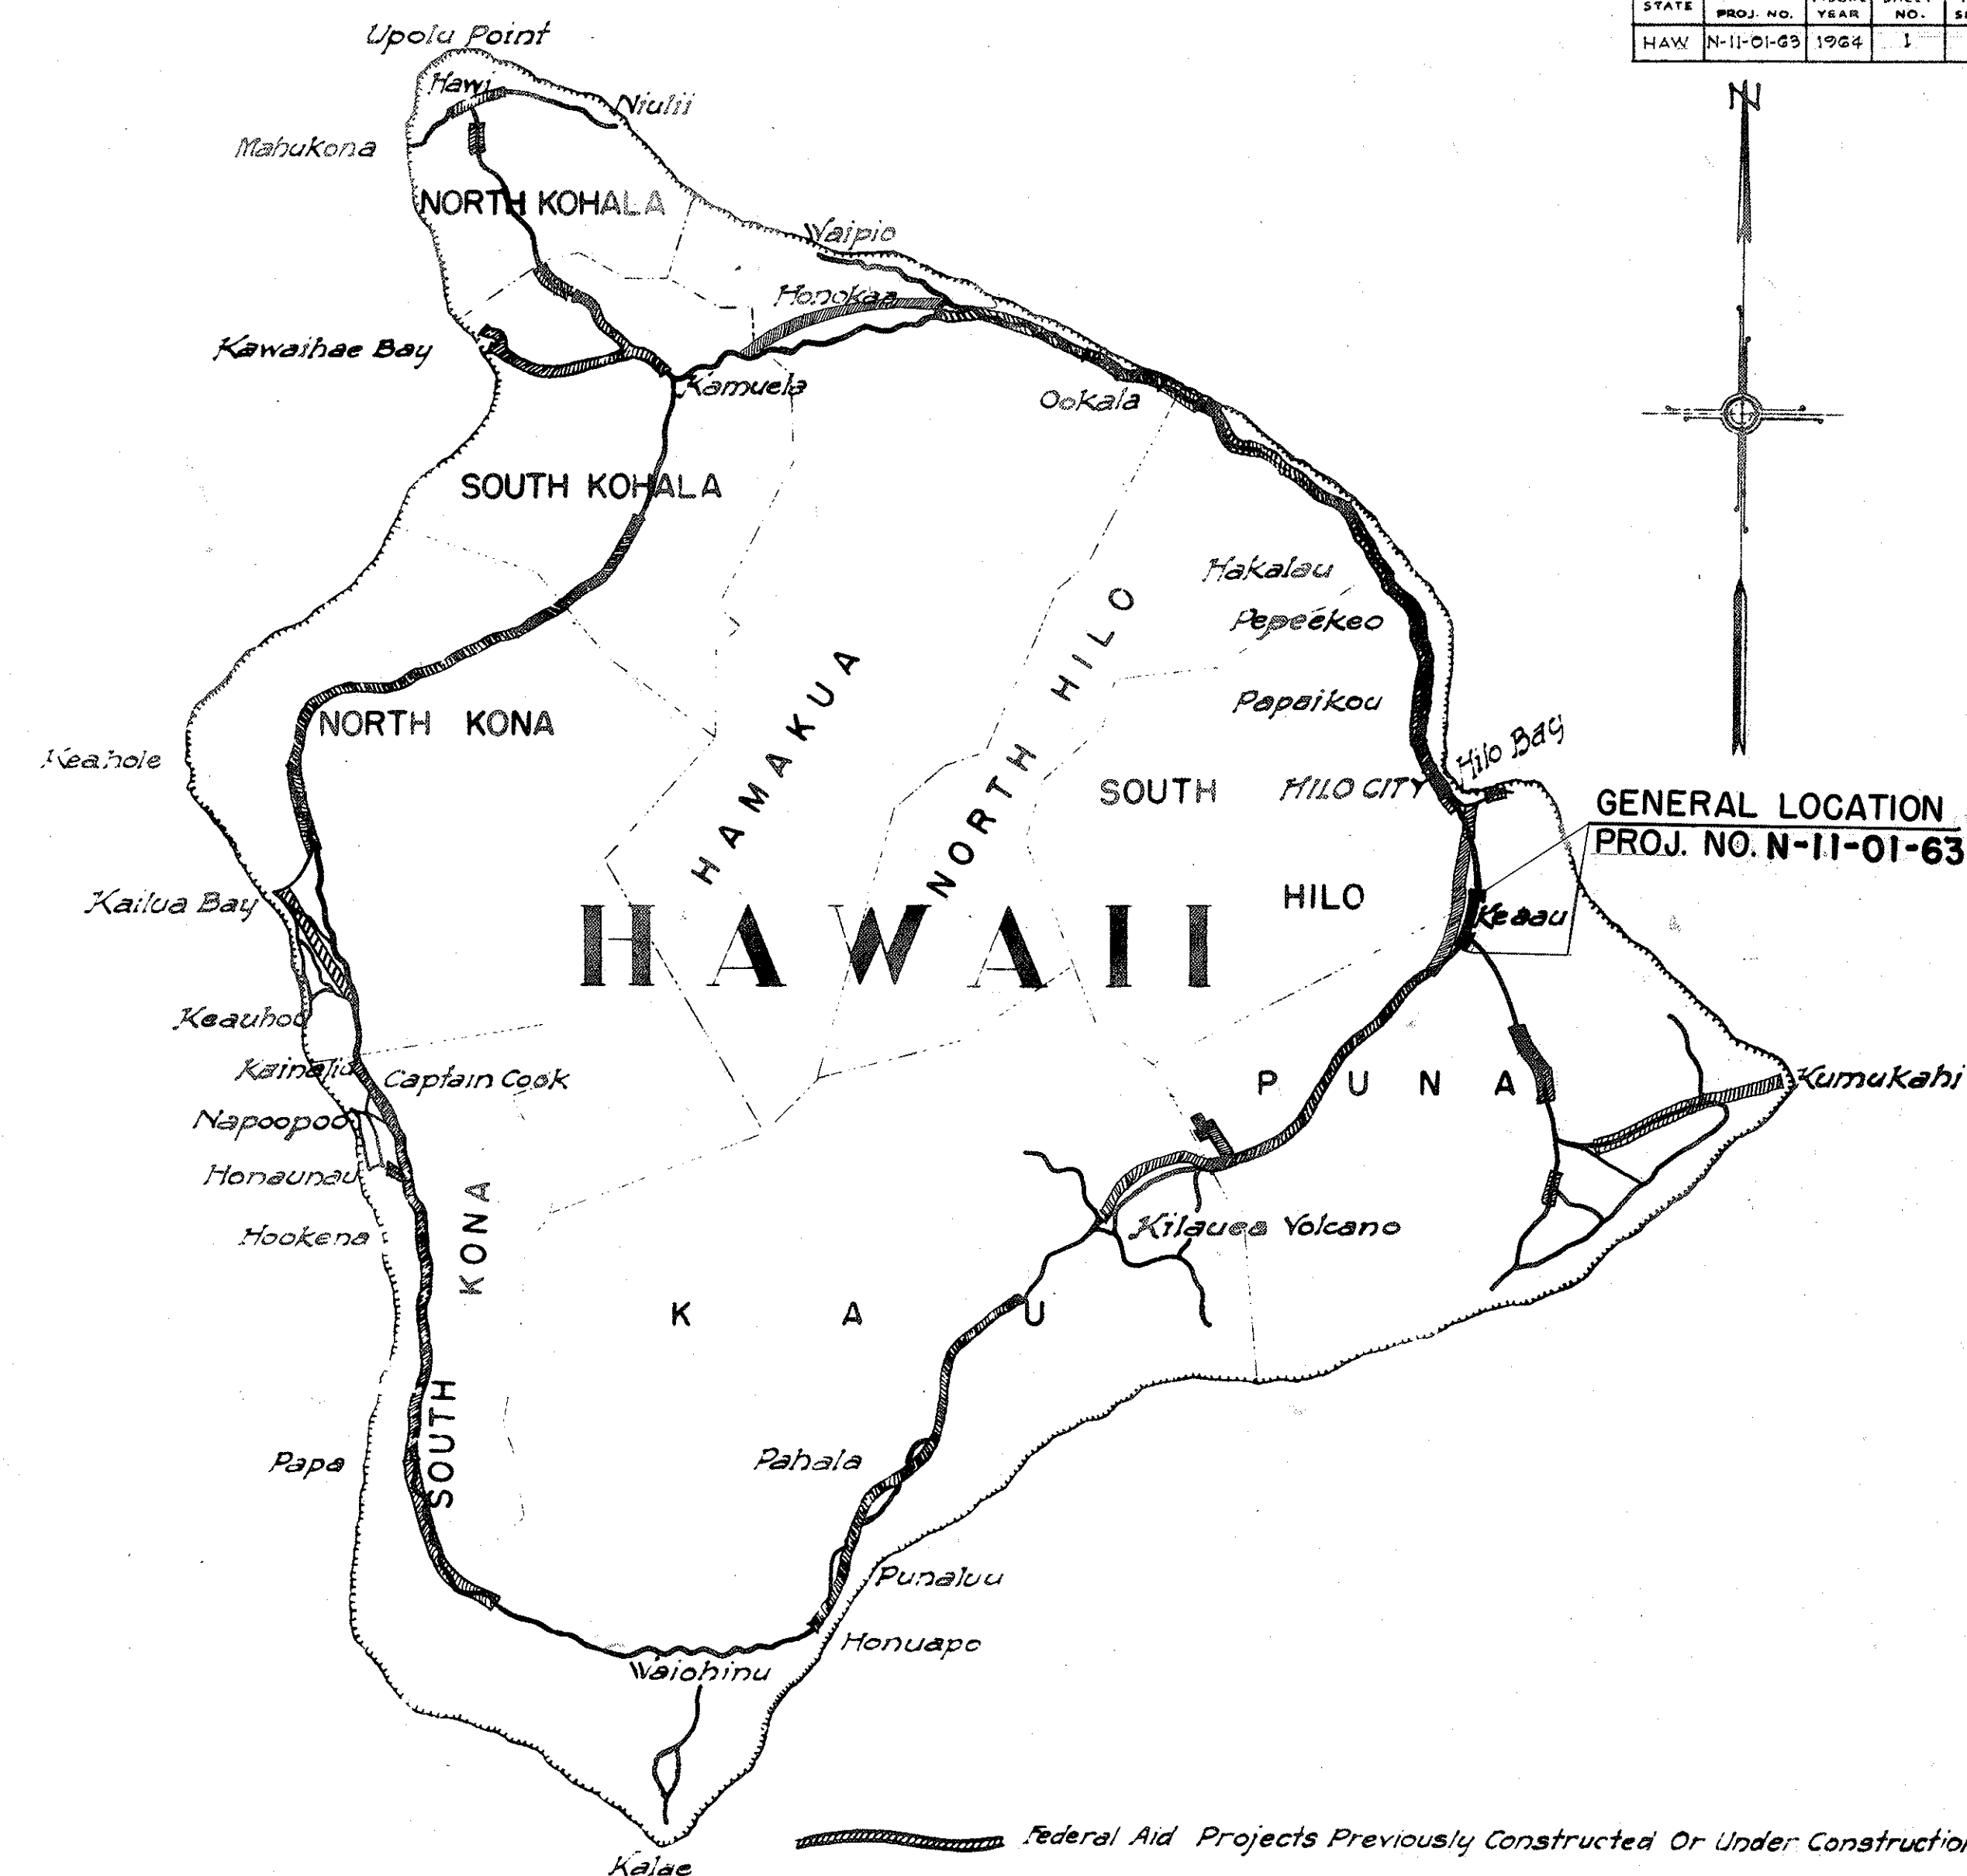


NOTE:
ALL CHANGES MADE DURING
CONSTRUCTION HAVE BEEN
NOTED IN RED ON THESE
SHEETS & CHECKED BY.

Genaro T. L. L. L.
 PROJECT ENGINEER
 2-38-68
 DATE

LAYOUT OF PROJECT
 GROSS LENGTH OF PROJECT 1.239 Miles
 EXCEPTION 0.028 Miles
 NET LENGTH OF PROJECT 0.981 Miles
 1.211

APPROVED: _____ DATE: 6 Aug 64
Trinidad M. M. M.
 DIRECTOR OF TRANSPORTATION

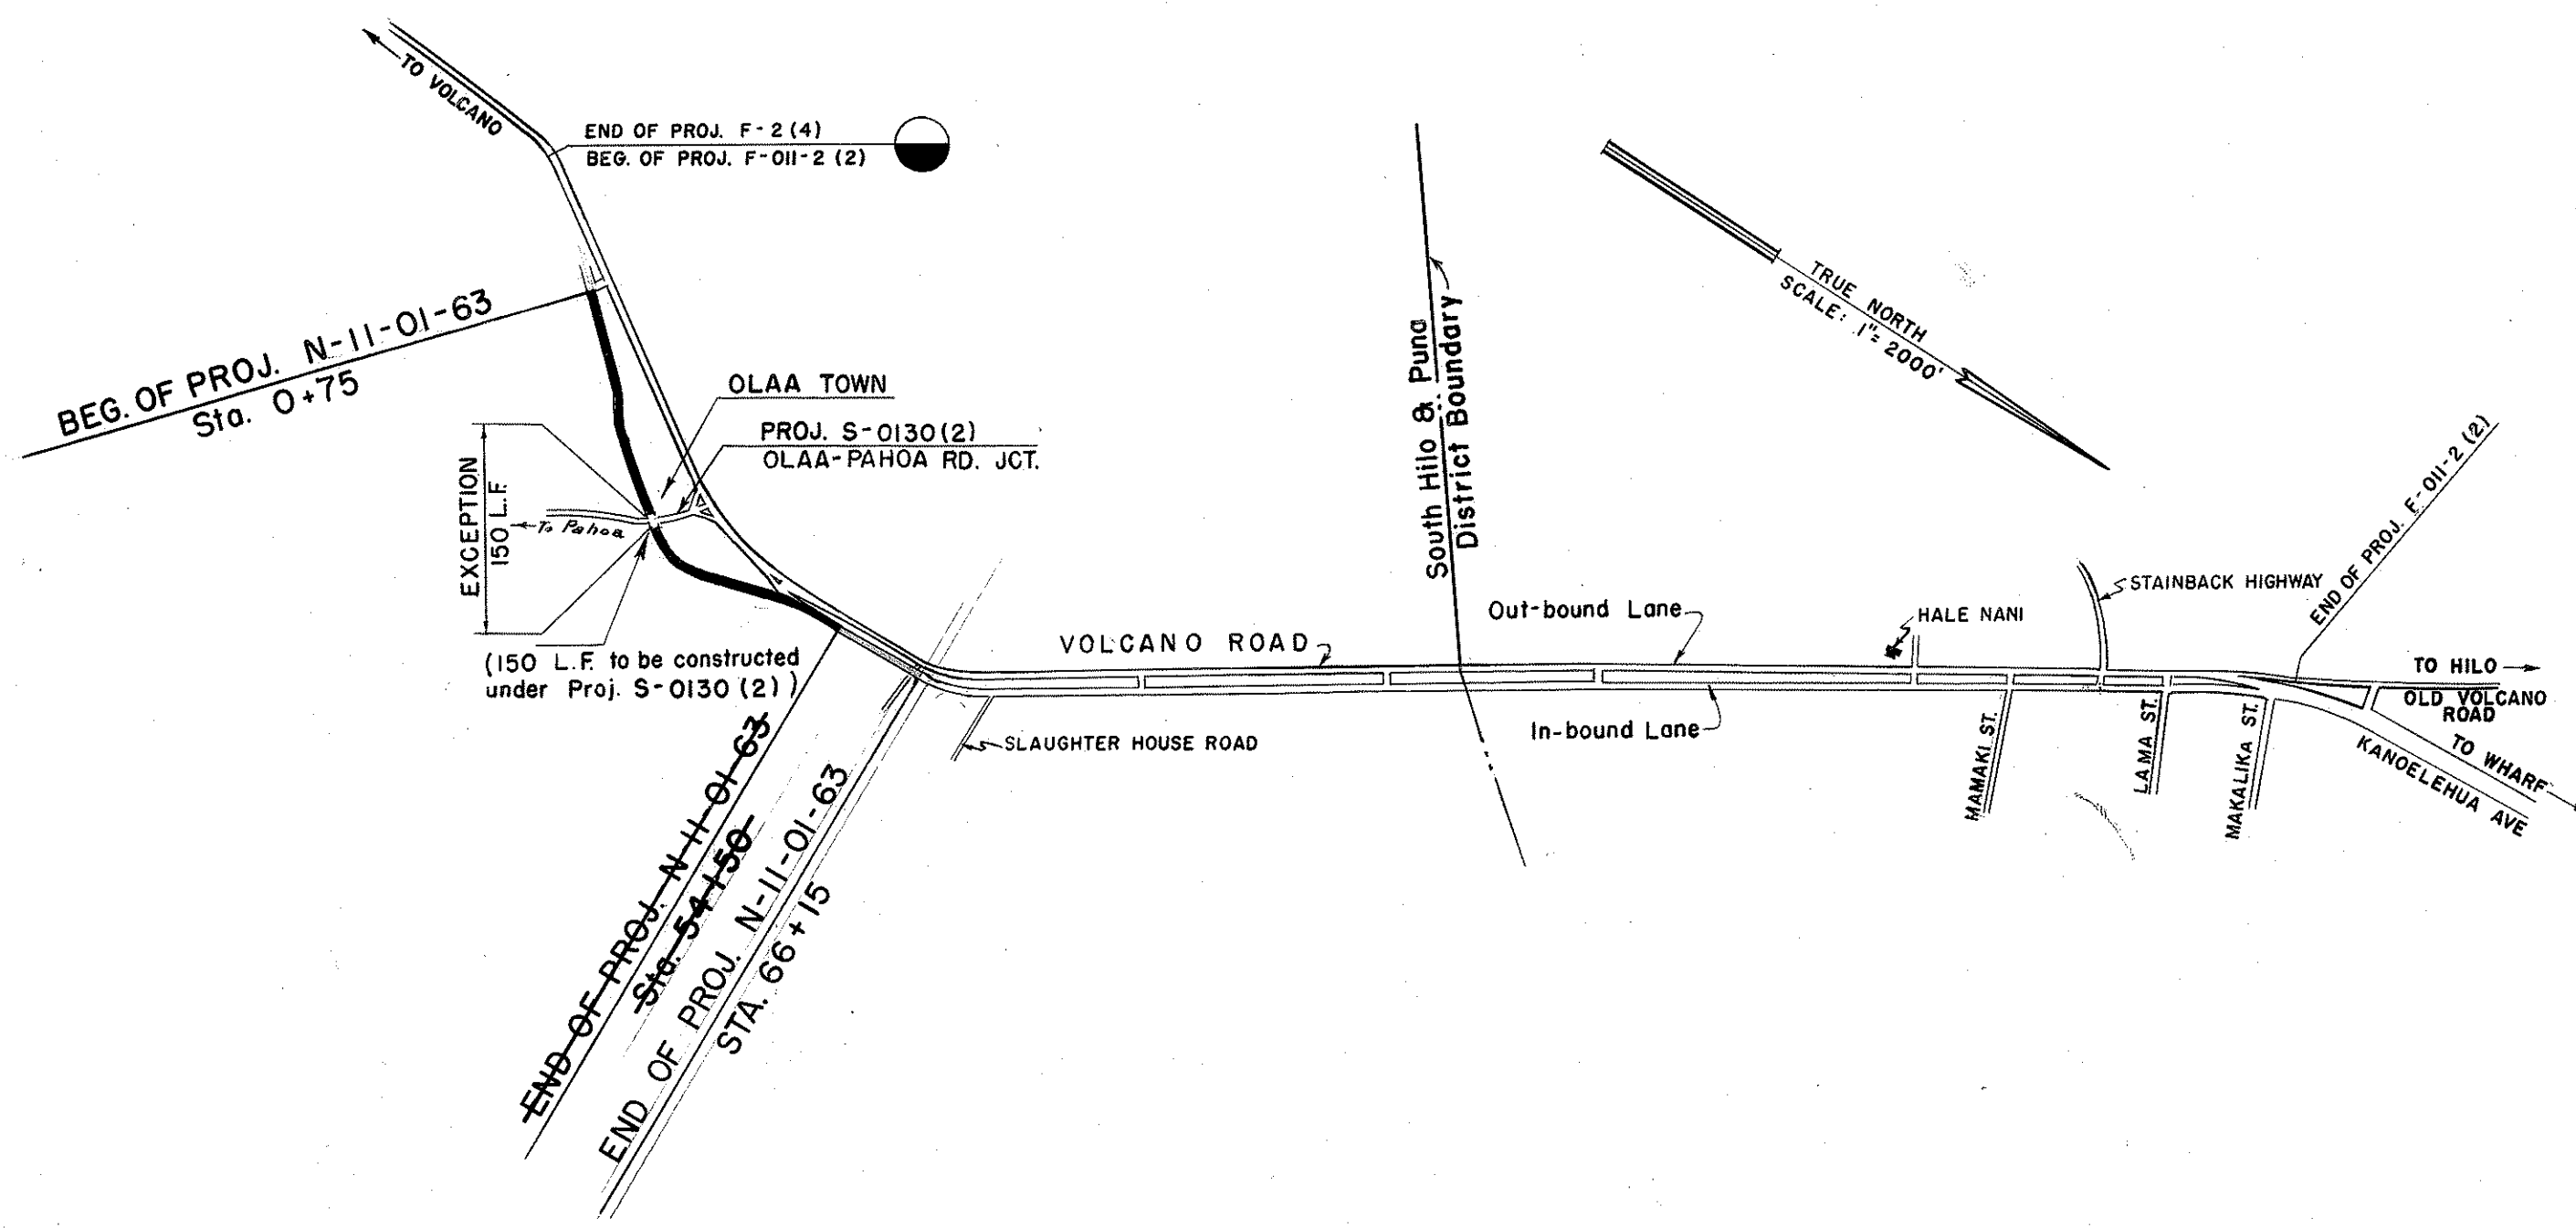

C-1-8
 SURVEY PLOTTED BY _____
 DESIGNED BY _____
 TRACED BY _____
 OF ANTIQUES BY _____
 CHECKED BY _____
 ORIGINAL PLAN _____
 NOTE BOOK _____