




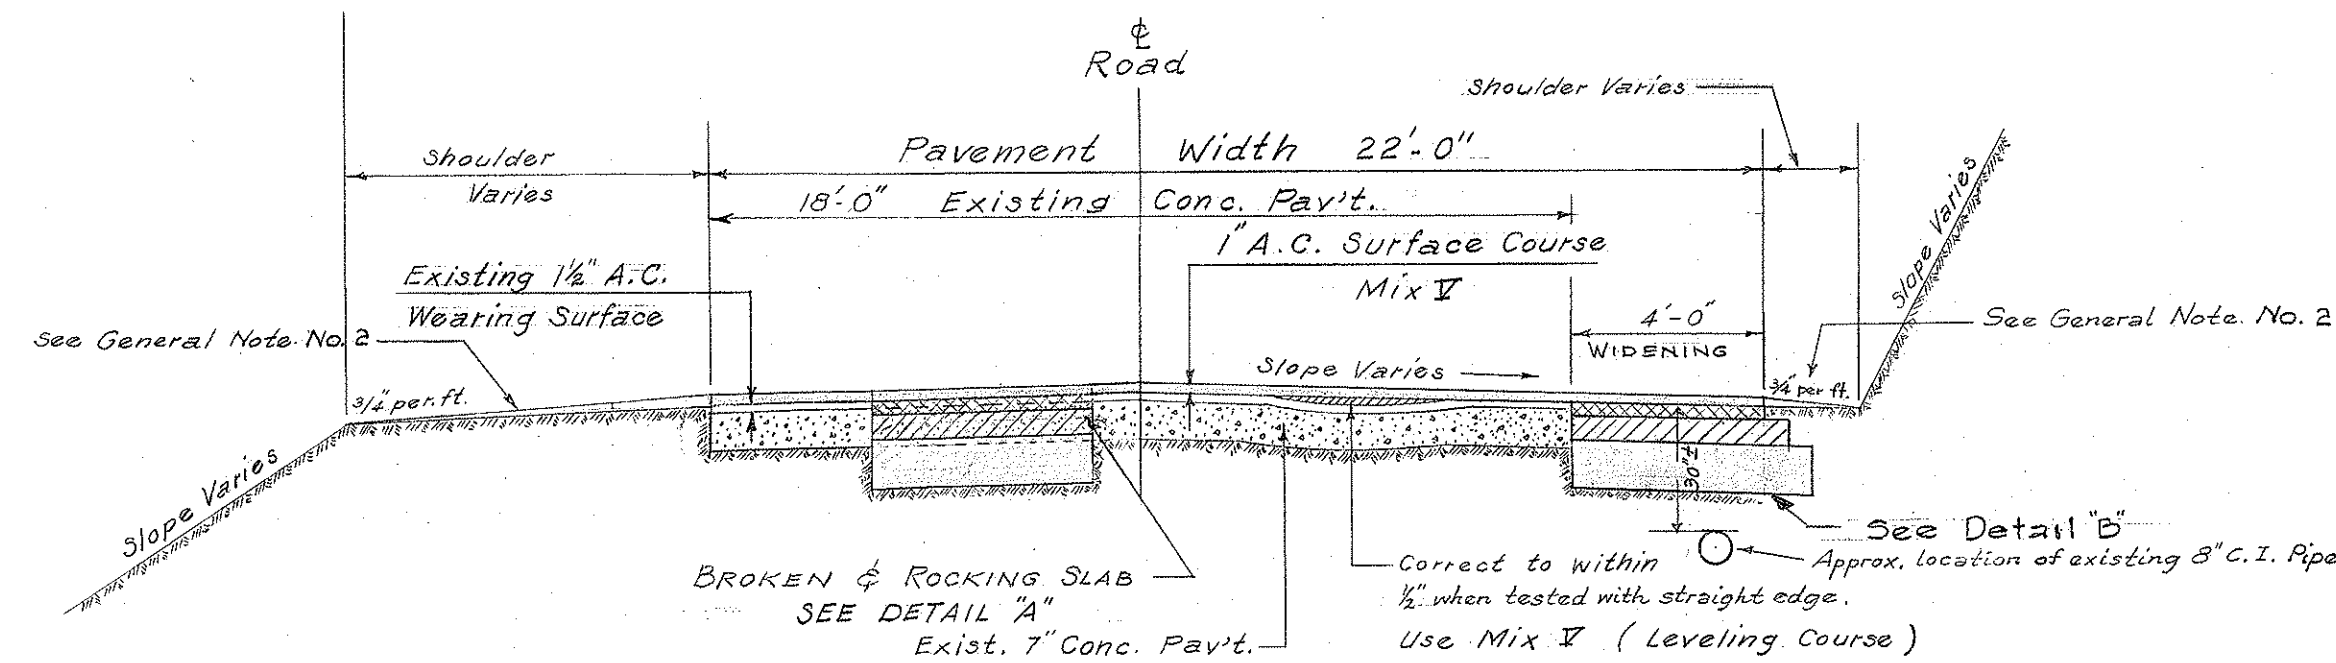


TYPICAL SECTION ~ STA. 0+75 TO 11+90
Not to Scale

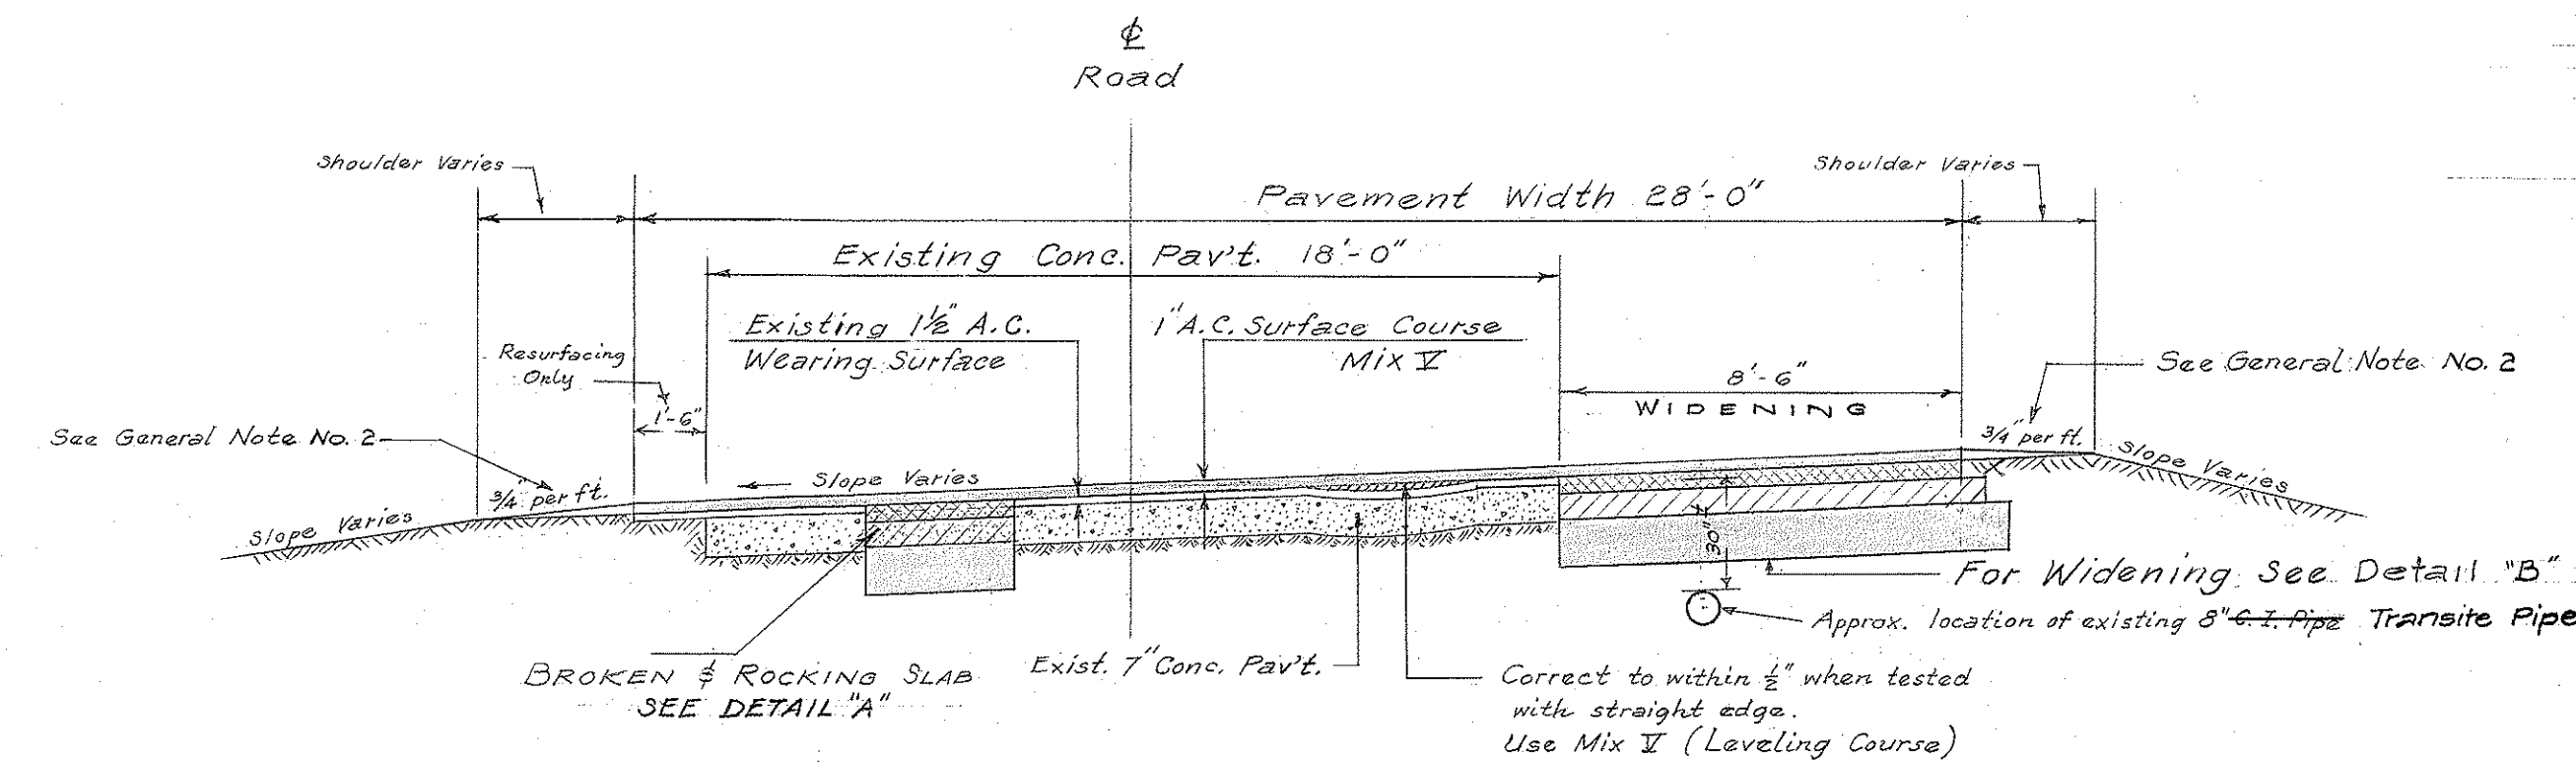


TYPICAL SECTION ON CURVE ~ STA. 12+75 TO 17+70
Not to Scale

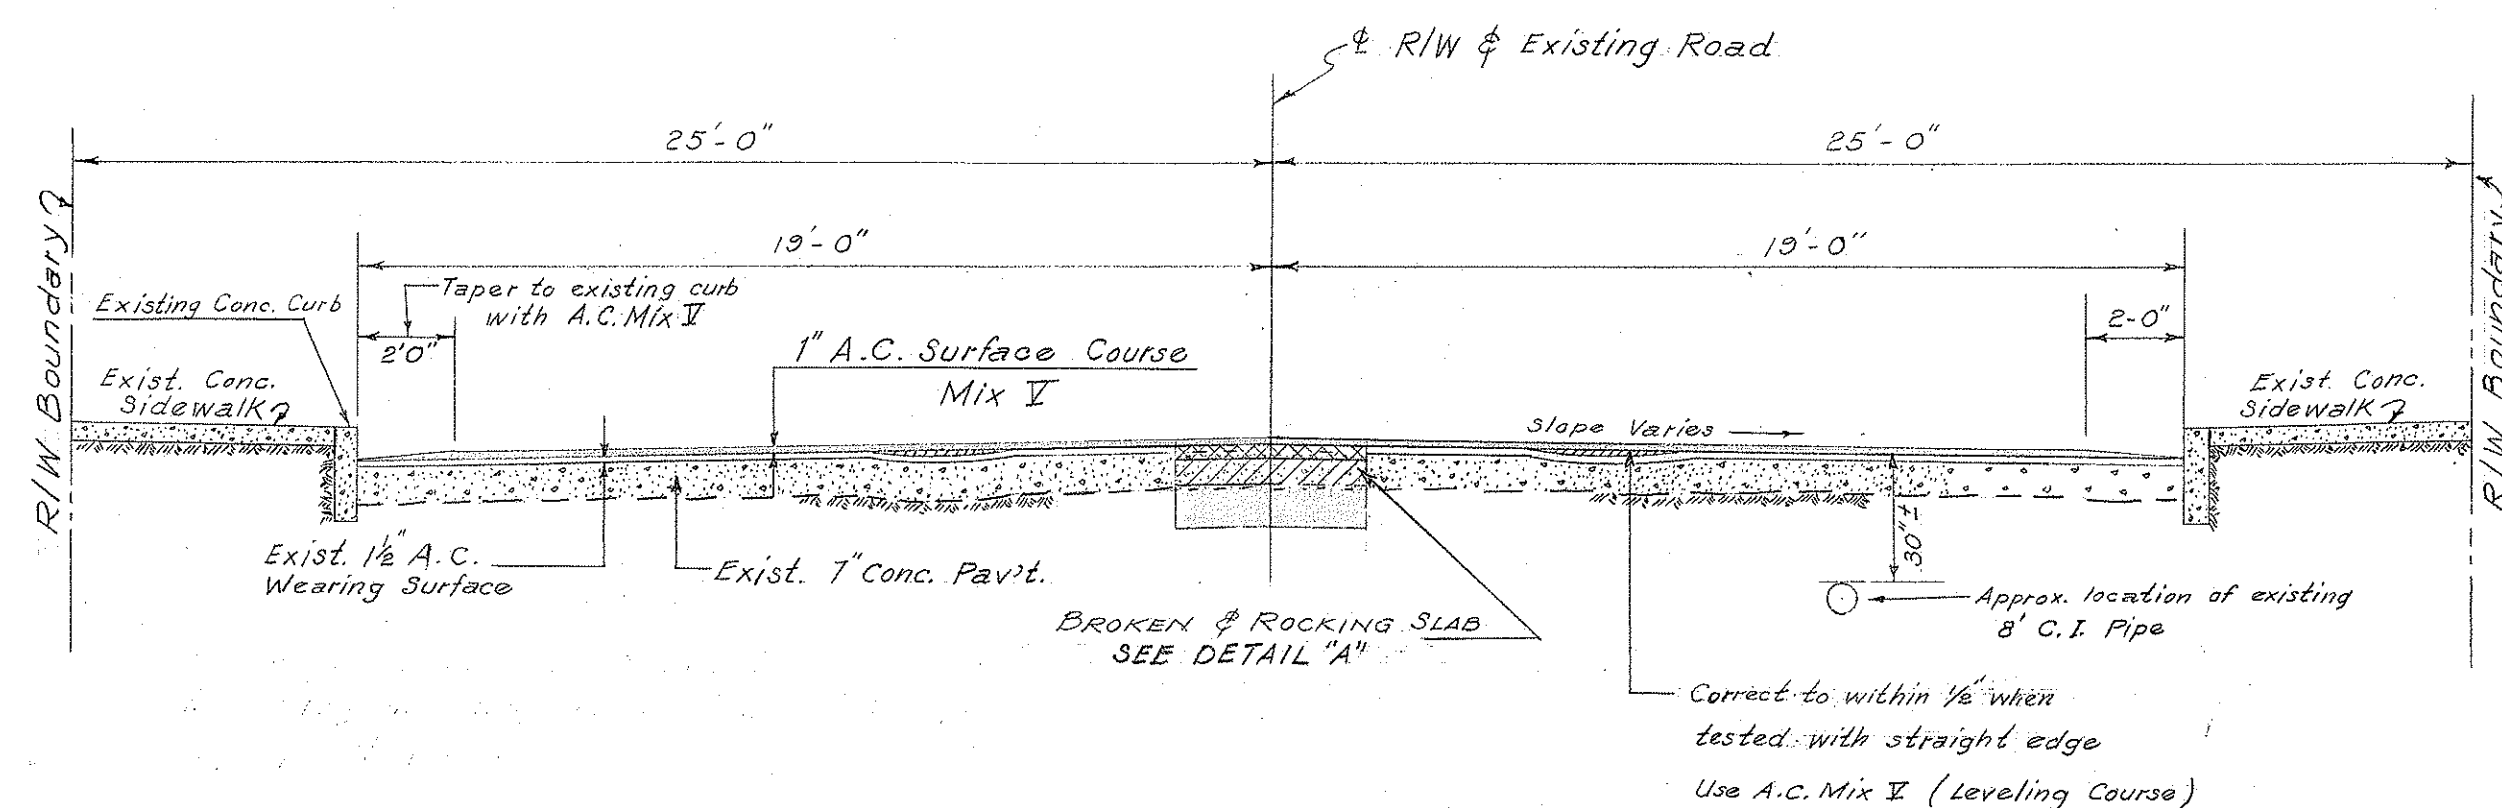


TYPICAL SECTION ~ STA. 18+33 TO 33+00
Scale: 1/4" = 1'-0"

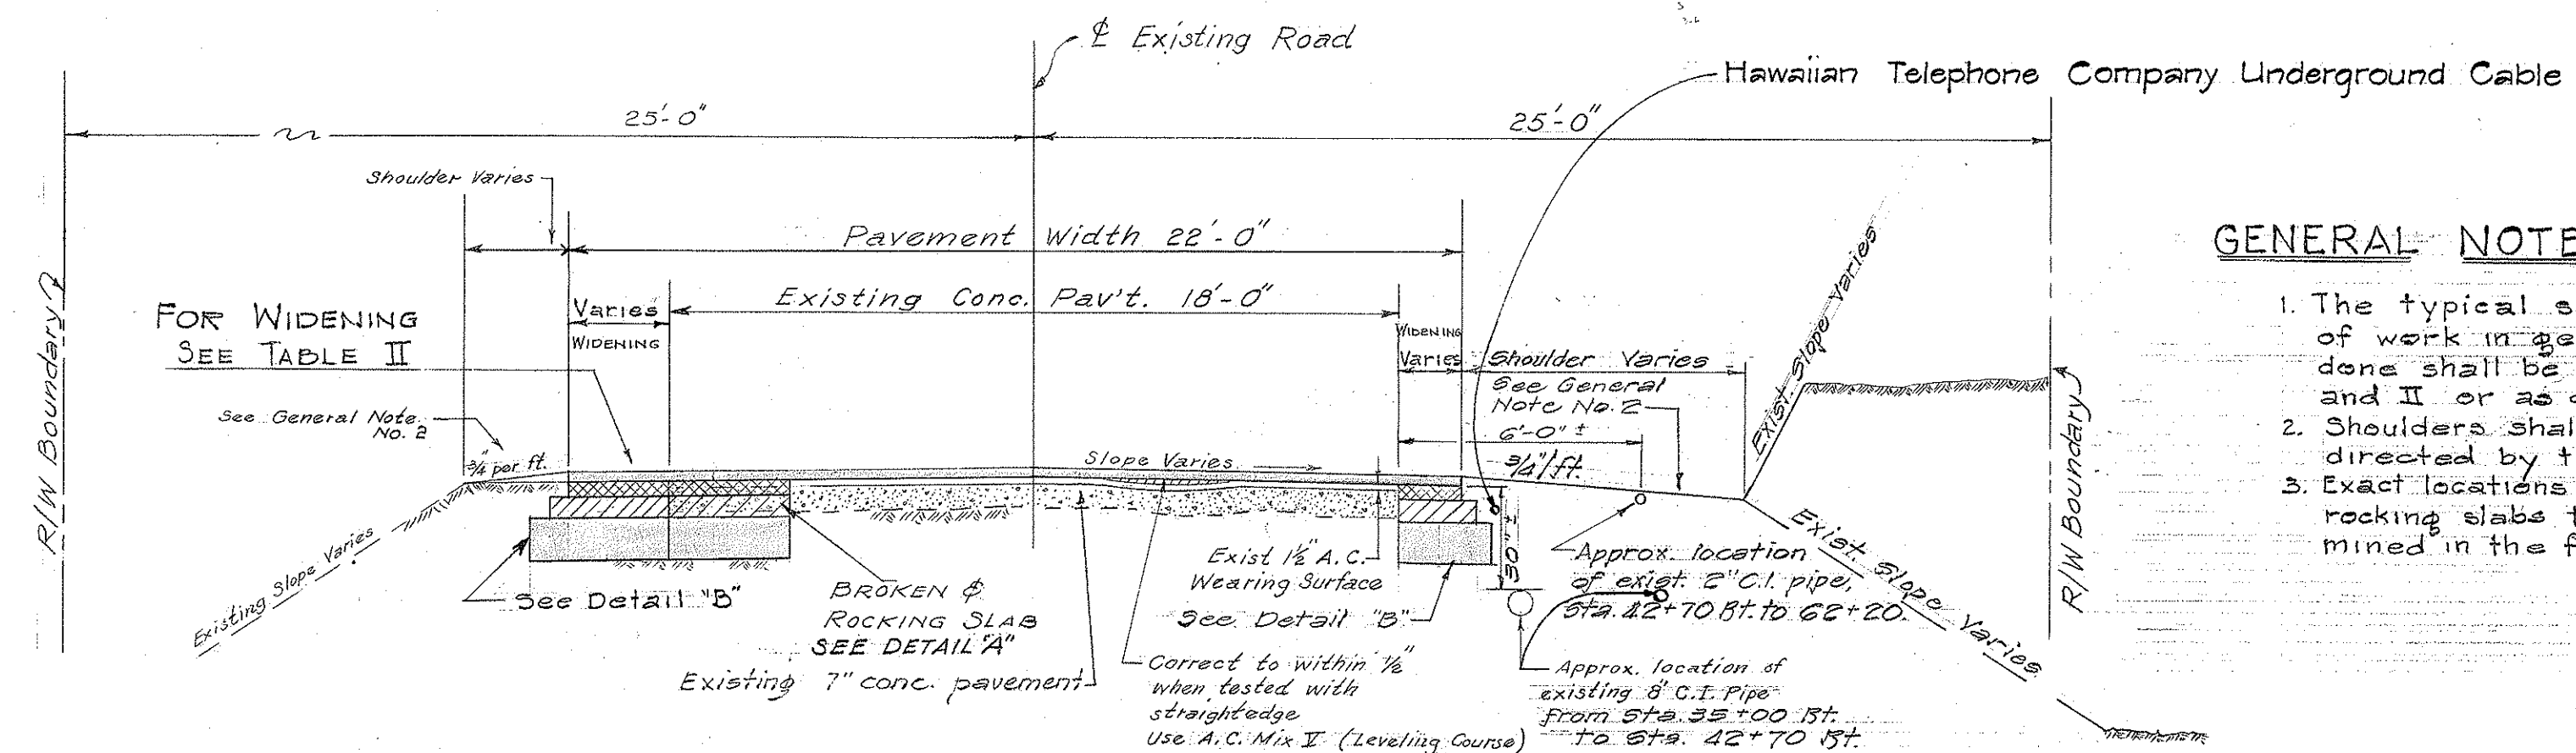

TYPICAL SECTION ~ STA. 35+00 TO 54+50
Not to Scale

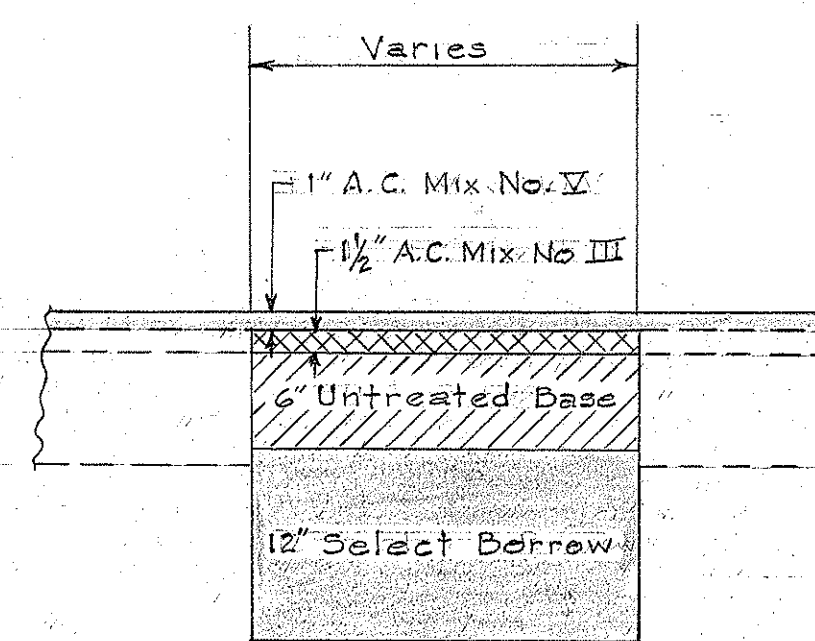


DETAIL "A"
Scale: 1" = 1'-0"

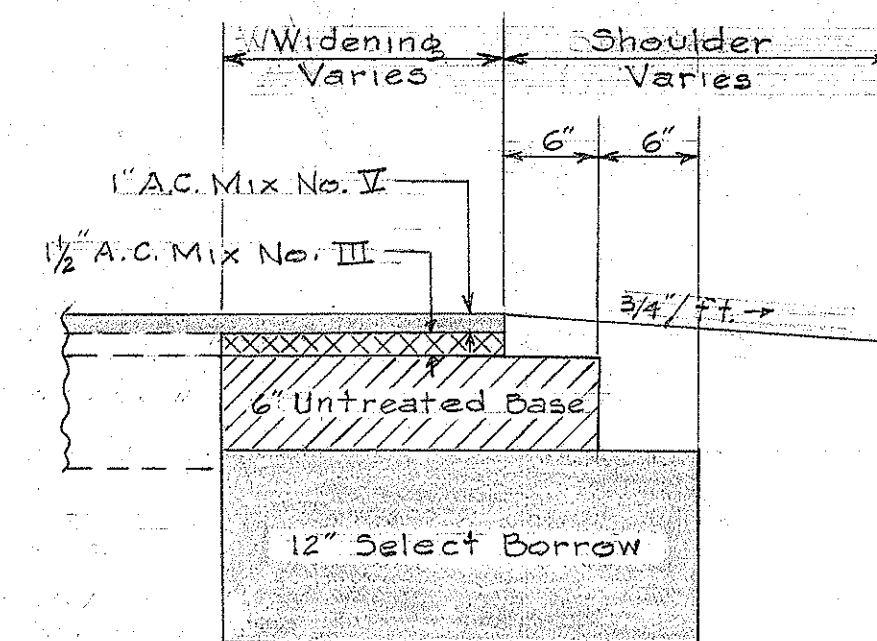


DETAIL "B"
Scale: 1" = 1'-0"

GENERAL NOTES:

1. The typical sections represent the scope of work in general. The exact work to be done shall be in accordance with Tables I and II or as directed by the Engineer.
2. Shoulders shall be shaped and dressed as directed by the Engineer.
3. Exact locations and dimensions of broken and rocking slabs to be removed shall be determined in the field by the Engineer.

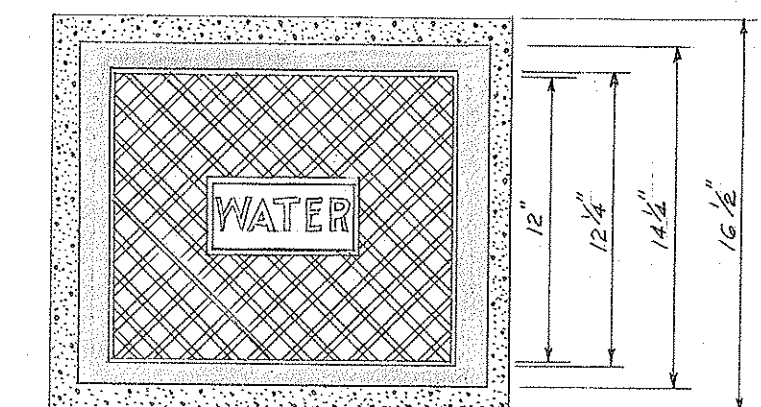

PLAN

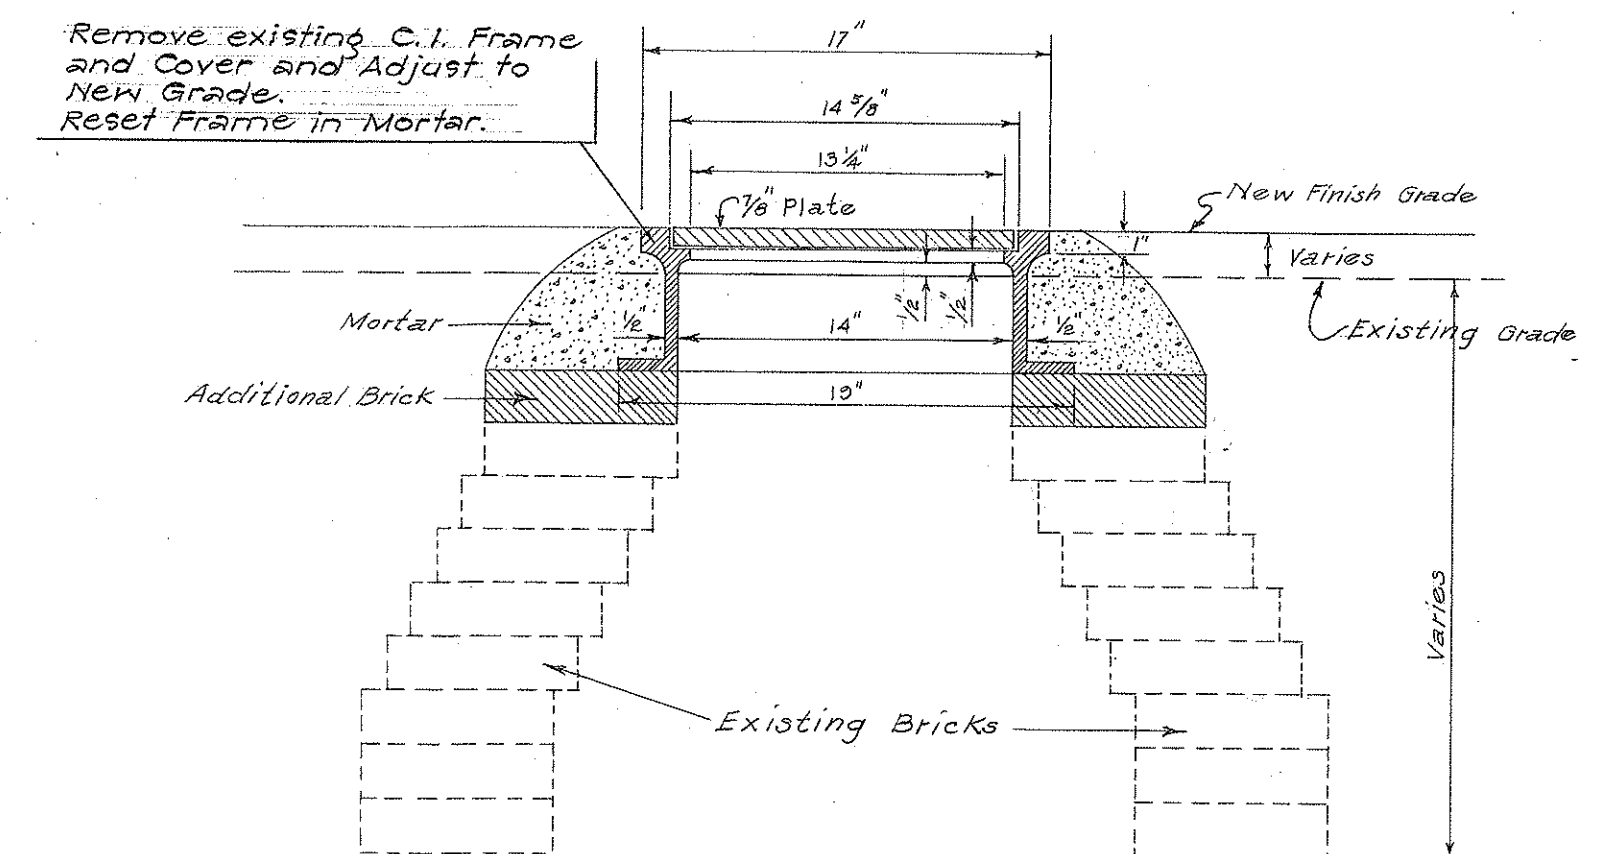

SECTION
WATER VALVE BOX DETAIL
Scale: 1 1/2" = 1'-0"

TABLE I NEW PAVEMENT AND EXISTING SHOULDER WIDTHS				
LOCATION		PAVEMENT WIDTH	EXISTING SHOULDER WIDTH	
FROM STA.	TO STA.	(FEET)	LEFT (FT.)	RIGHT (FT.)
0+75	11+90	22'	3' to 6'	0 to 3'
11+90	18+33	28'	1' to 4'	0 to 2'
18+33	26+26	38'	0 to 4'	0 to 3'
26+26	27+76	Exception	PROJECT 3-0130 (2)	
27+76	33+00	38'	0	0
33+00	35+00	38' to 28'	0	0
35+00	44+22	22'	1' to 4'	1' to 3'
44+22	47+49	22'	1' to 5'	1' to 3'
47+49	54+50	22'	3' to 6'	1 to 3'

STATE OF HAWAII
DEPARTMENT OF TRANSPORTATION
HIGHWAYS DIVISION
TYPICAL SECTIONS, A.C. TRAFFIC ROLL
AND WATER VALVE BOX DETAIL
KEAAU TOWARDS HILO RD.
PROJ. NO. N-11-01-63
DISTRICT OF PUNA
ISLAND OF HAWAII

June, 1963