


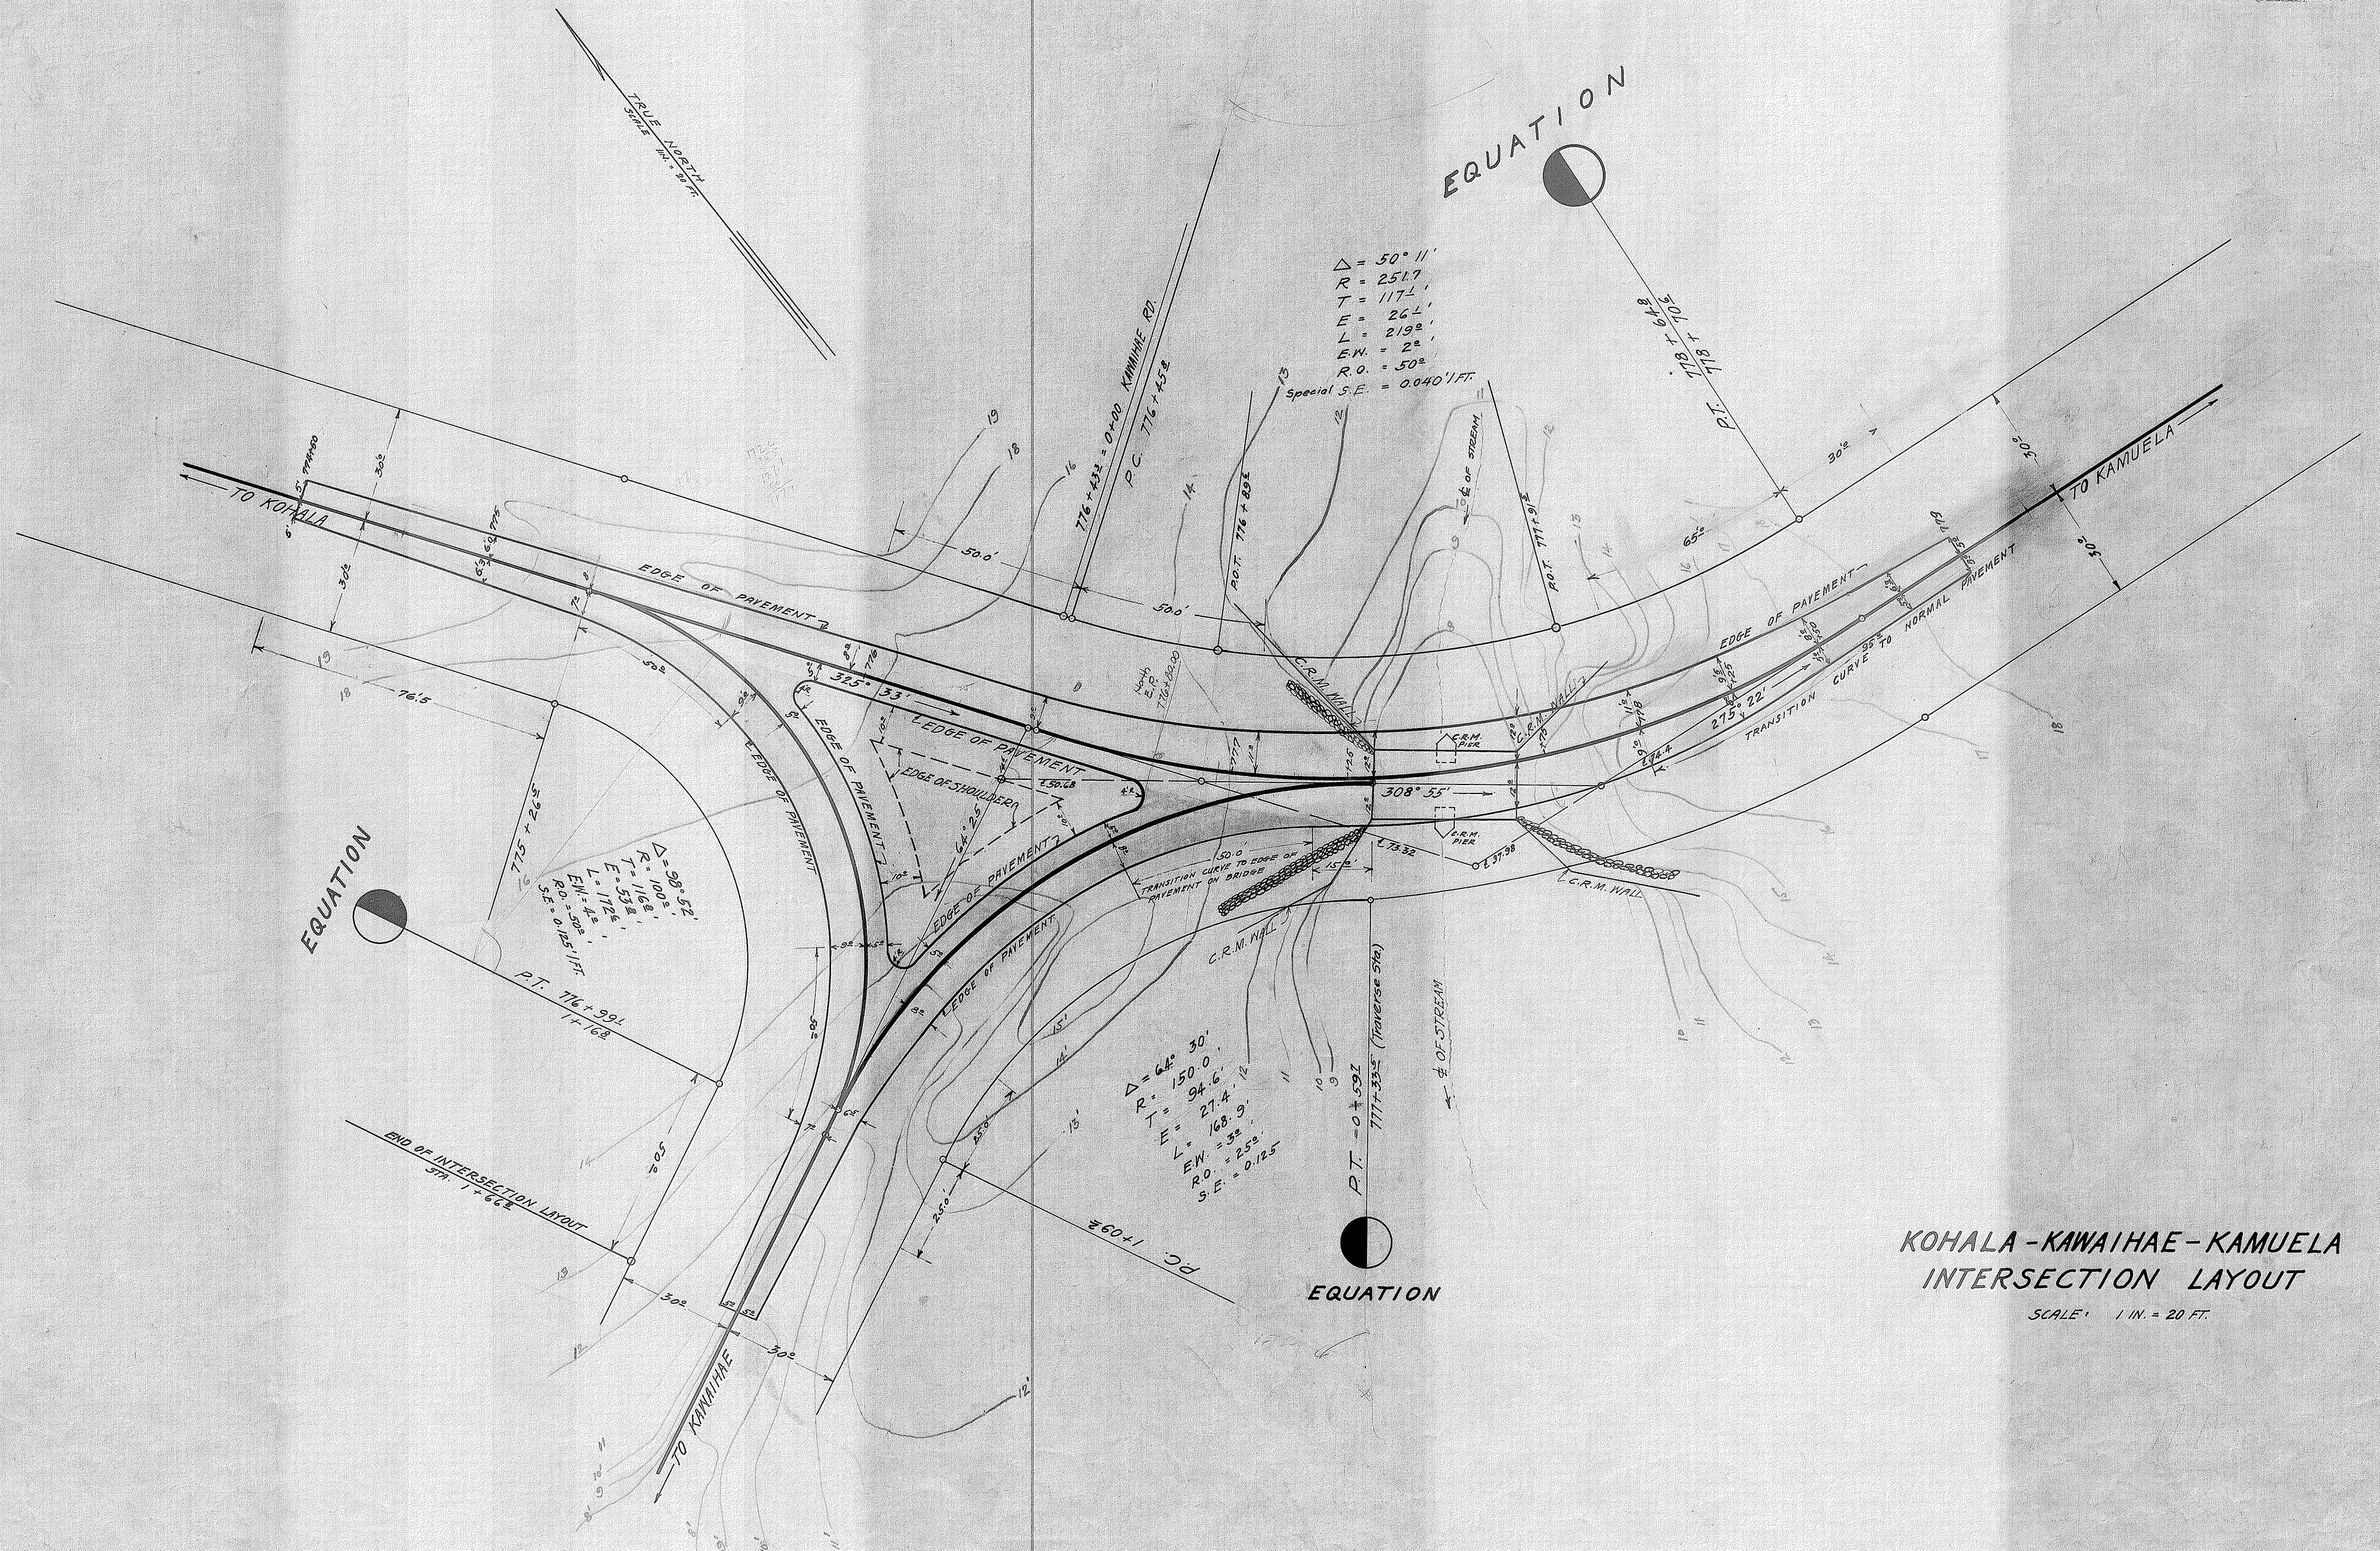

KOHALA - KAWAIIHAE - KAMUELA INTERSECTION LAYOUT

SCALE: 1 in. = 20 ft.