
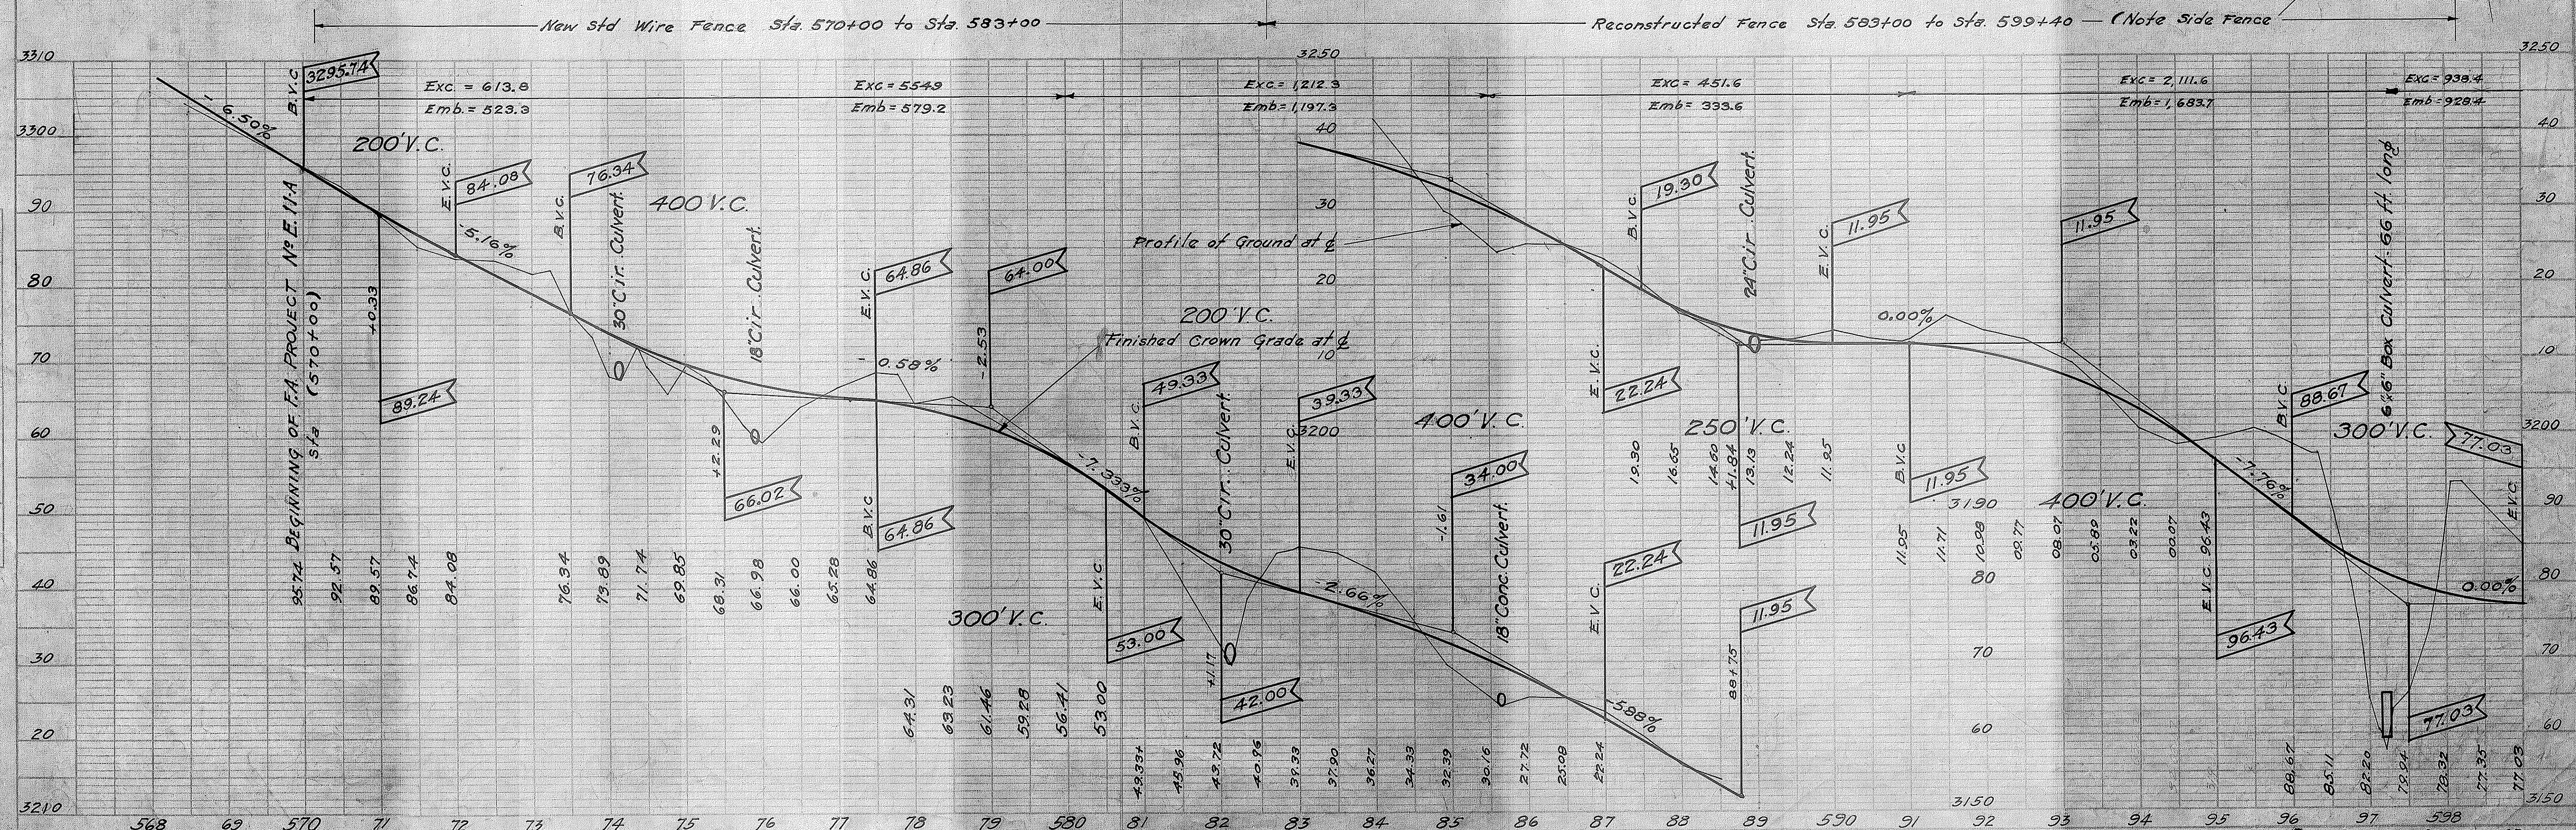


PLAN	DATE	BY	CHECKED

PROFILE	DATE	BY	CHECKED

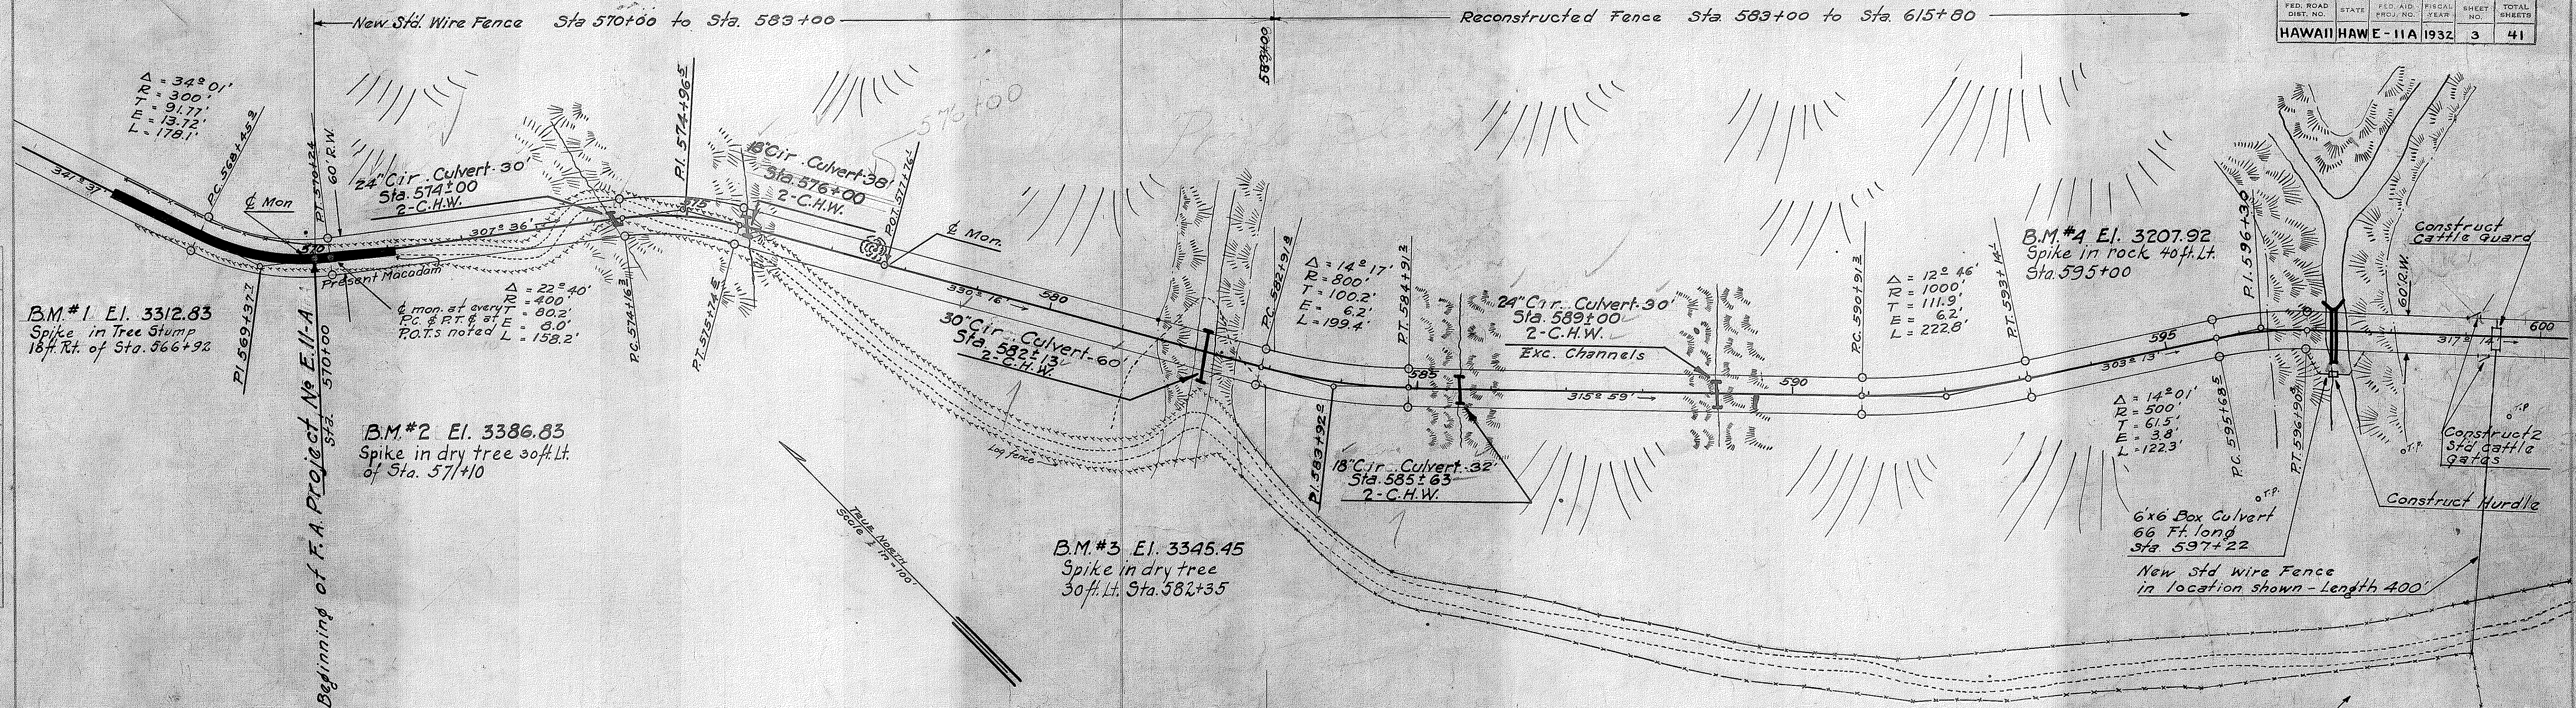



Plan File	Packet	Folder	Page
No. 1	No. 1	No. 1	No. 1

4267.3

FED. ROAD DIST. NO.	STATE	FISCAL YEAR	SHEET NO.	TOTAL SHEETS
HAWAII	HAW E-11A	1932	4	41

PLAN	DATE	BY	REVISION
NO.			

PROFILE	DATE	BY	REVISION
NO.			

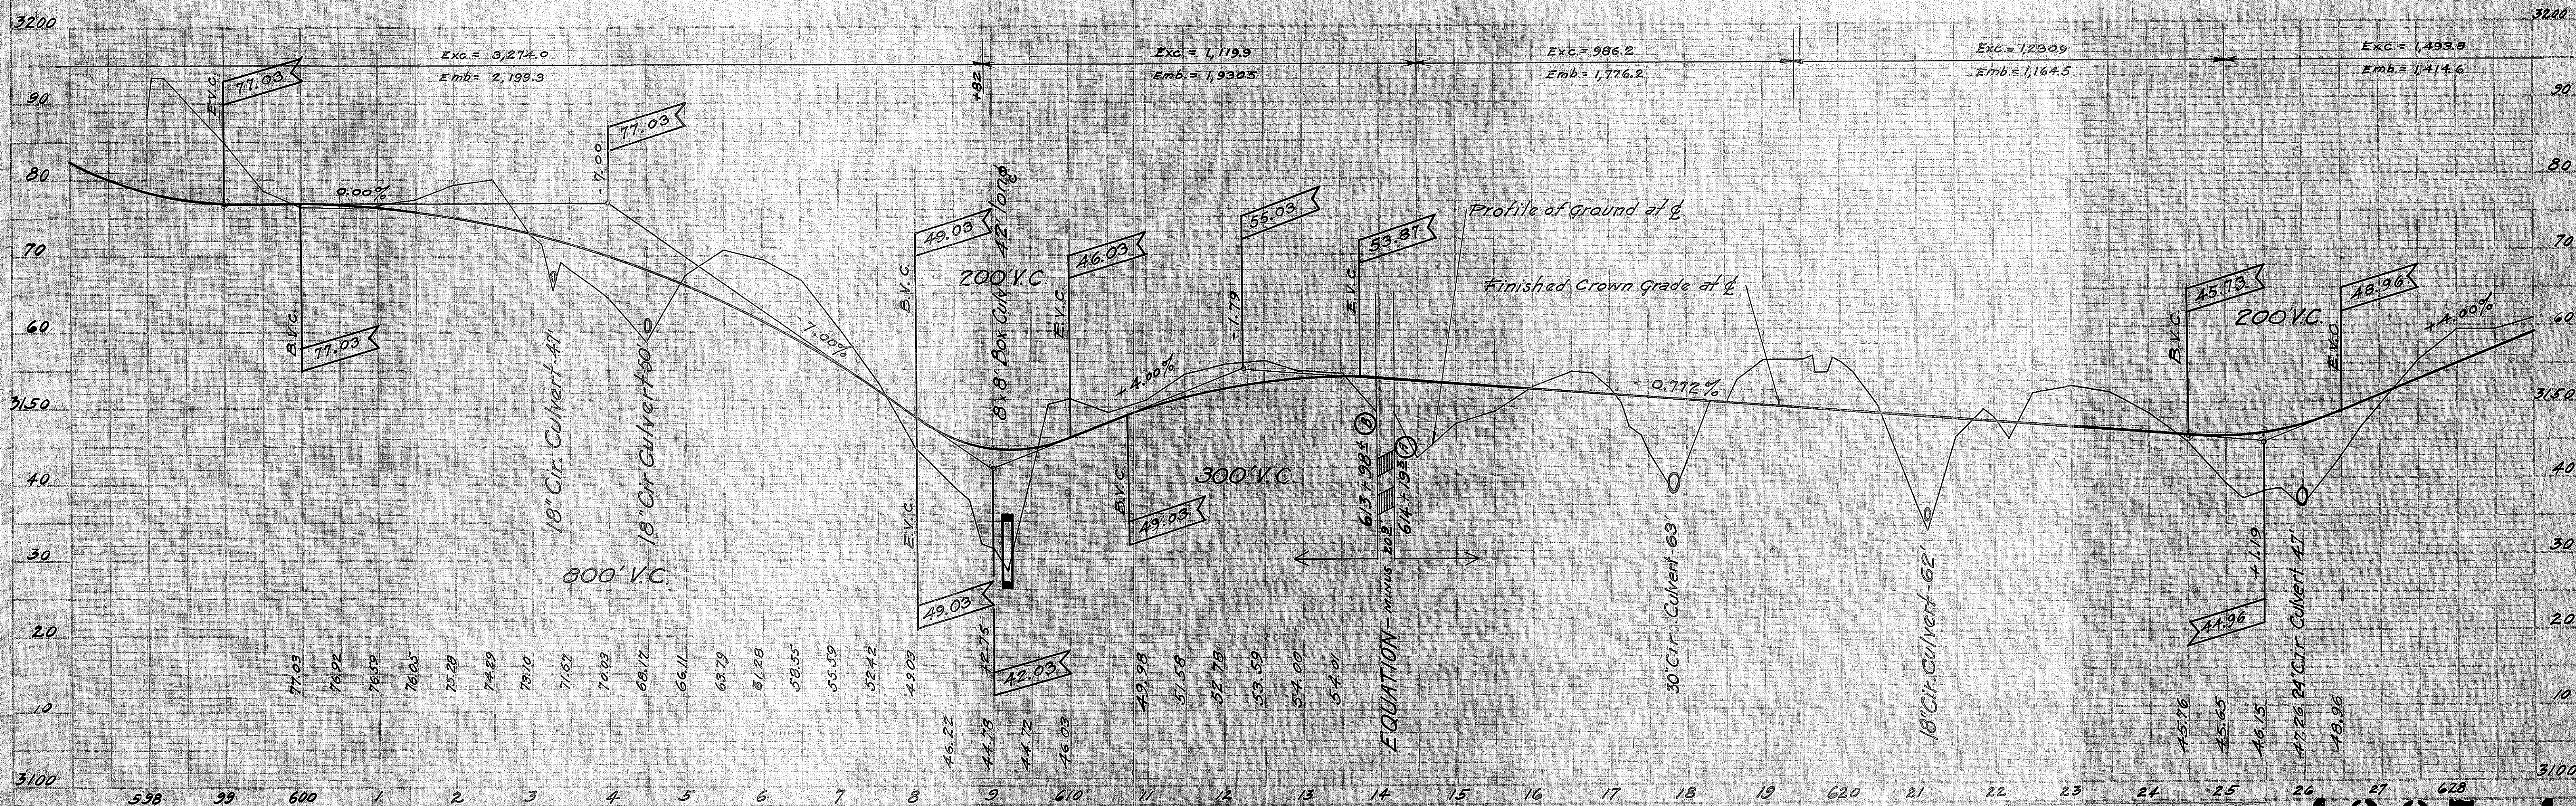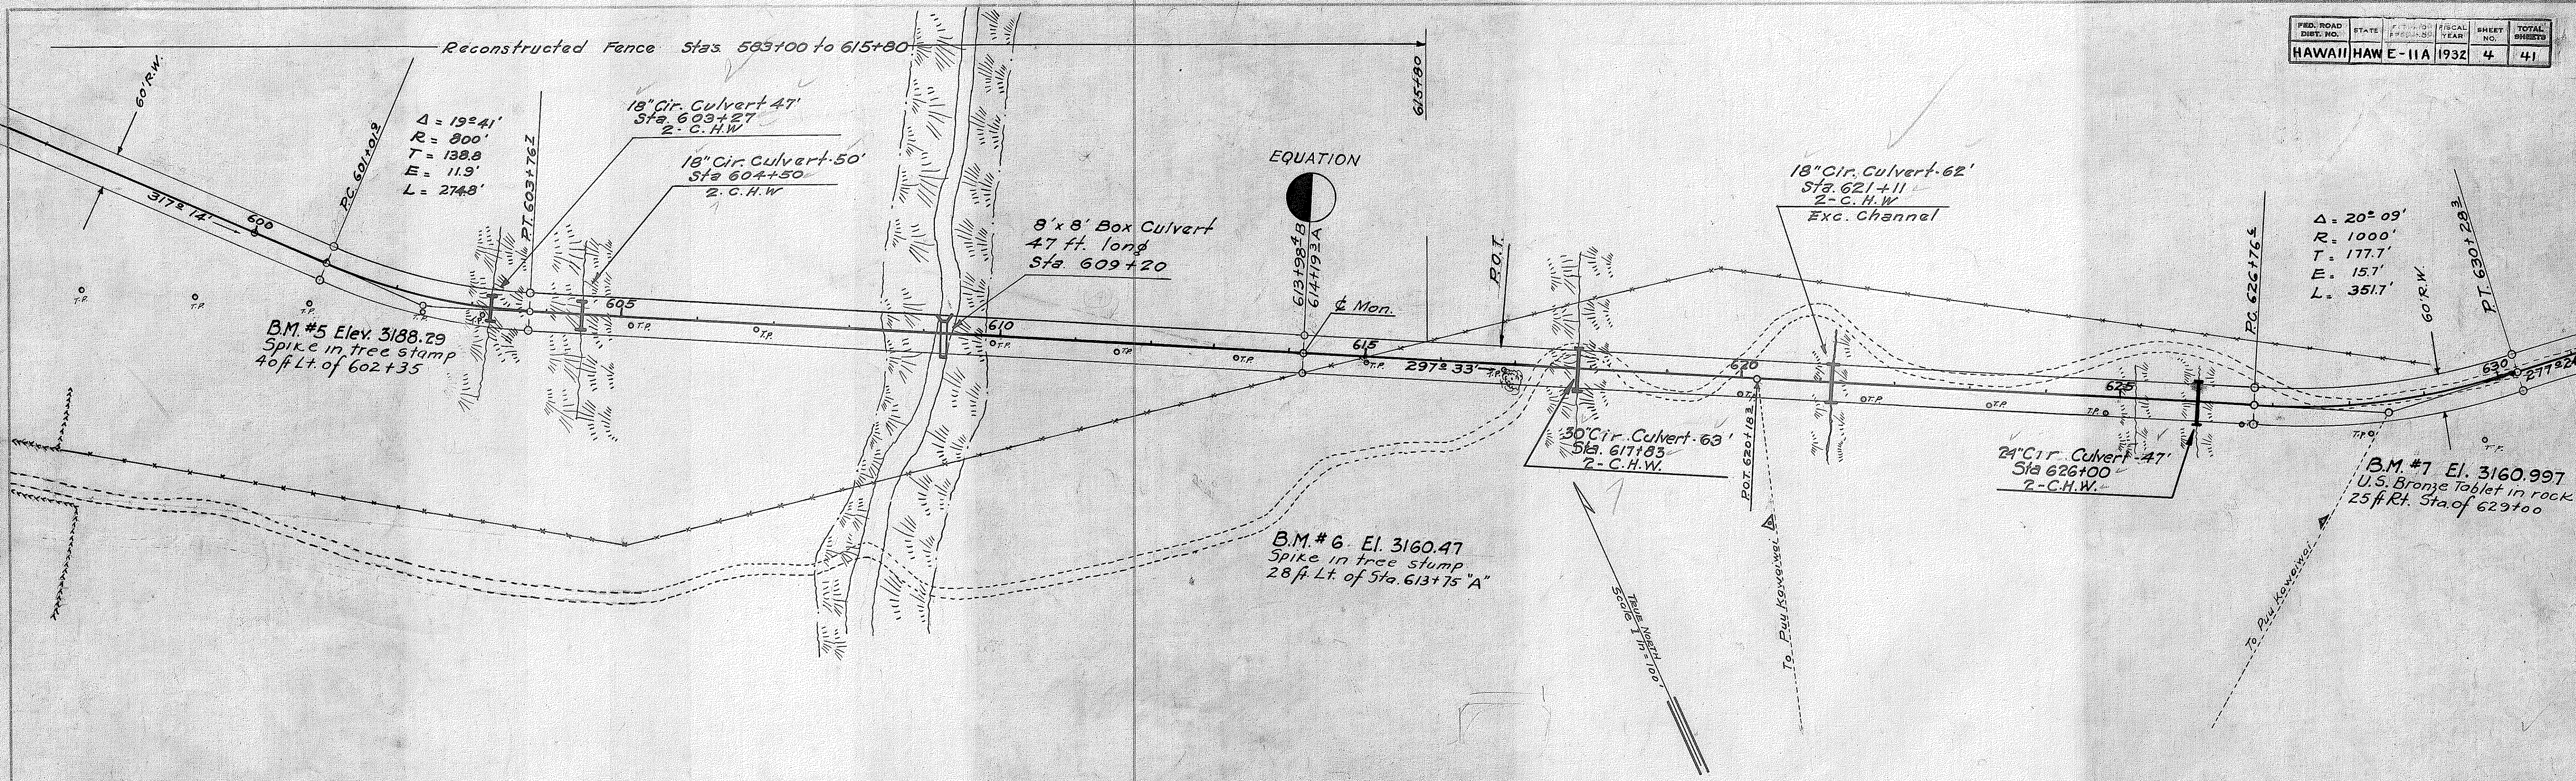

Plan File	Sheet	Folder	Plan
No.	No.	No.	No.

4267.4

PLAN	DATE
DESIGNED	
PLOTTED	
CHECKED	
NOTED	
NO.	

PROFILE	DATE
DESIGNED	
PLOTTED	
CHECKED	
NOTED	
NO.	

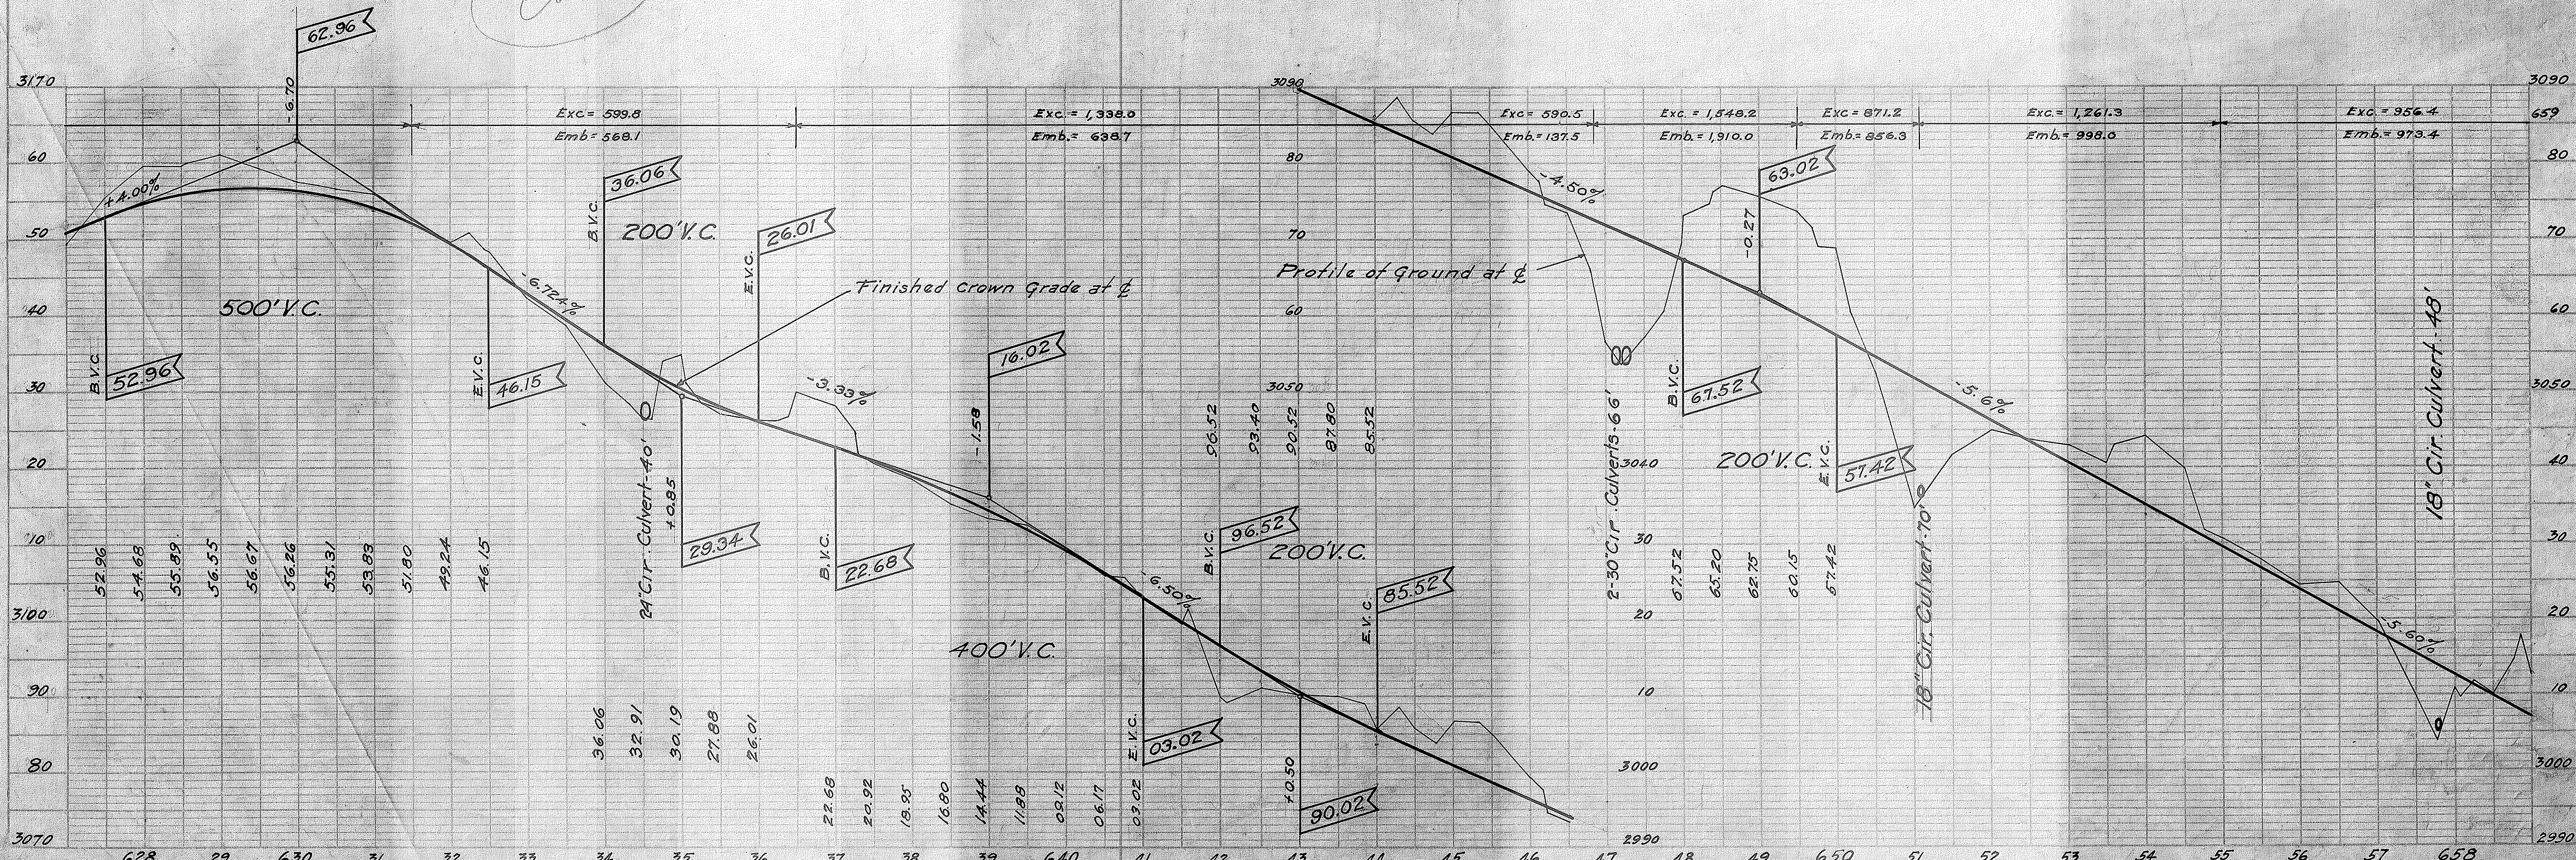
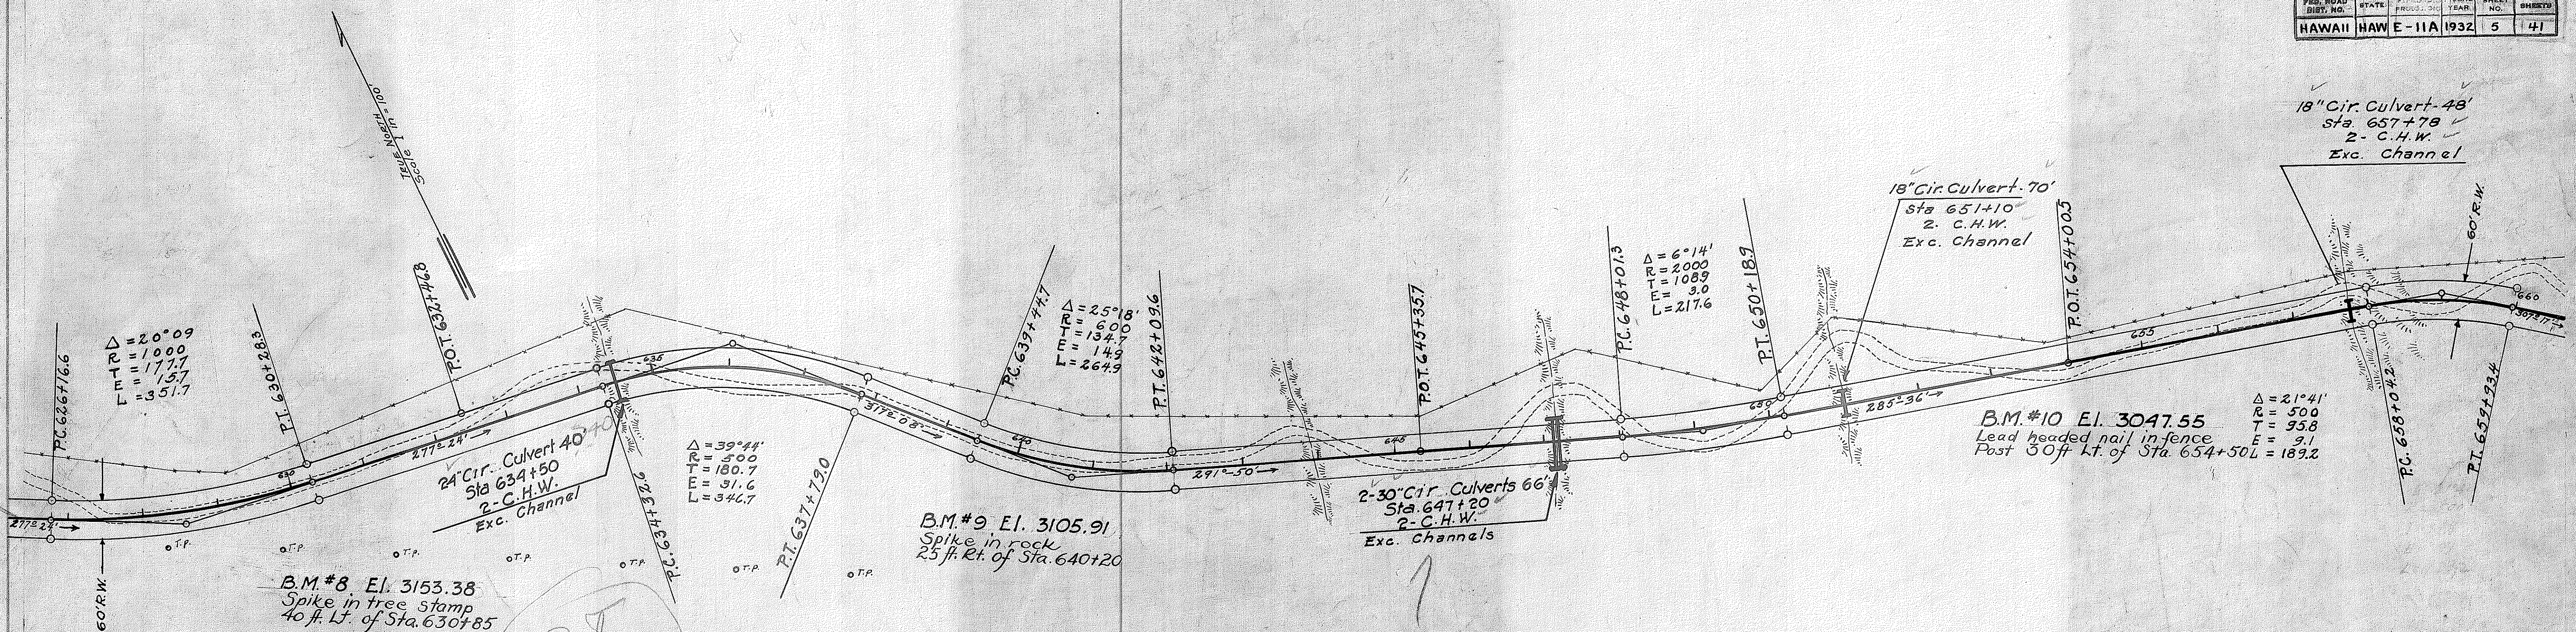


PLATE (PLAN-PROFILE) S. P. R. STANDARD


Plan File	Packet	Folder	Plan
No. 6	No. 9	No. 1	No.

4267.5

FED. ROAD DIST. NO.	STATE	FED. AID PROJ. NO.	FISCAL YEAR	SHEET NO.	TOTAL SHEETS
HAWAII	HAW	E-11-A	1932	6A	41

Supercedes Sheet 4267.6

PLAN	DATE
BY	
CHECKED	
NOTE BOOK	
NO.	

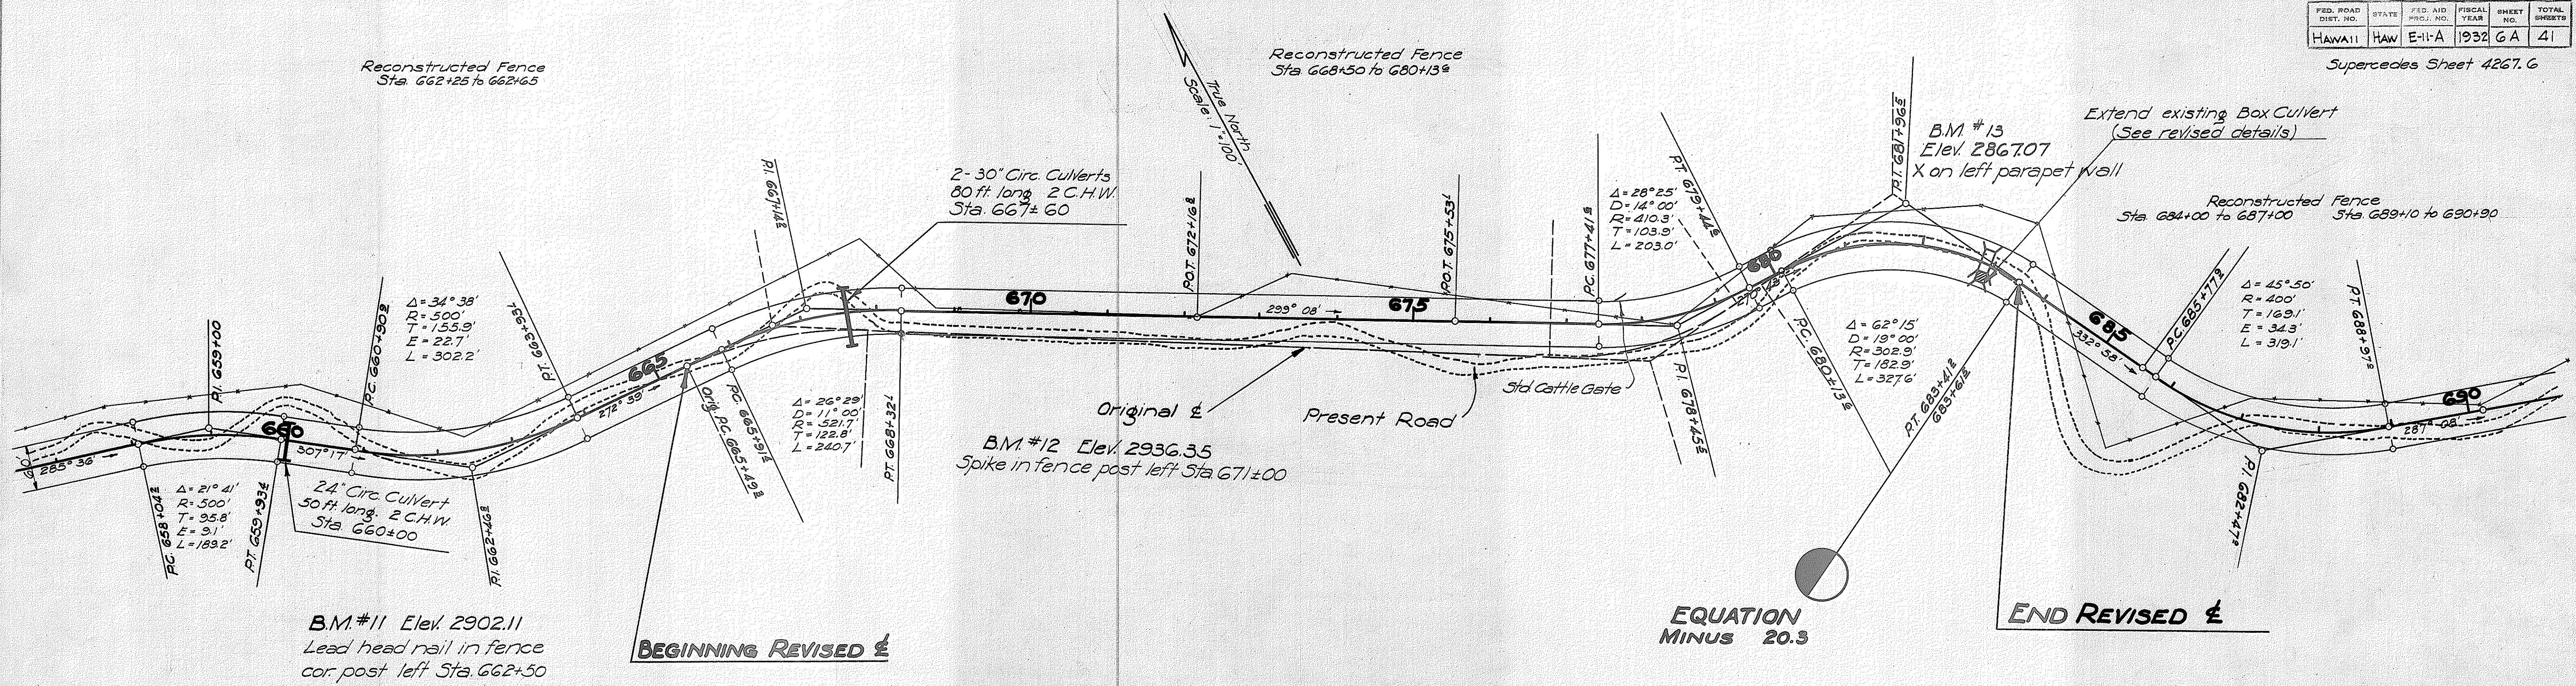

REVISED ALIGNMENT
F.A.P. No. E-11-A
Oct. 1932

PROFILE	DATE
BY	
CHECKED	
NOTE BOOK	
NO.	


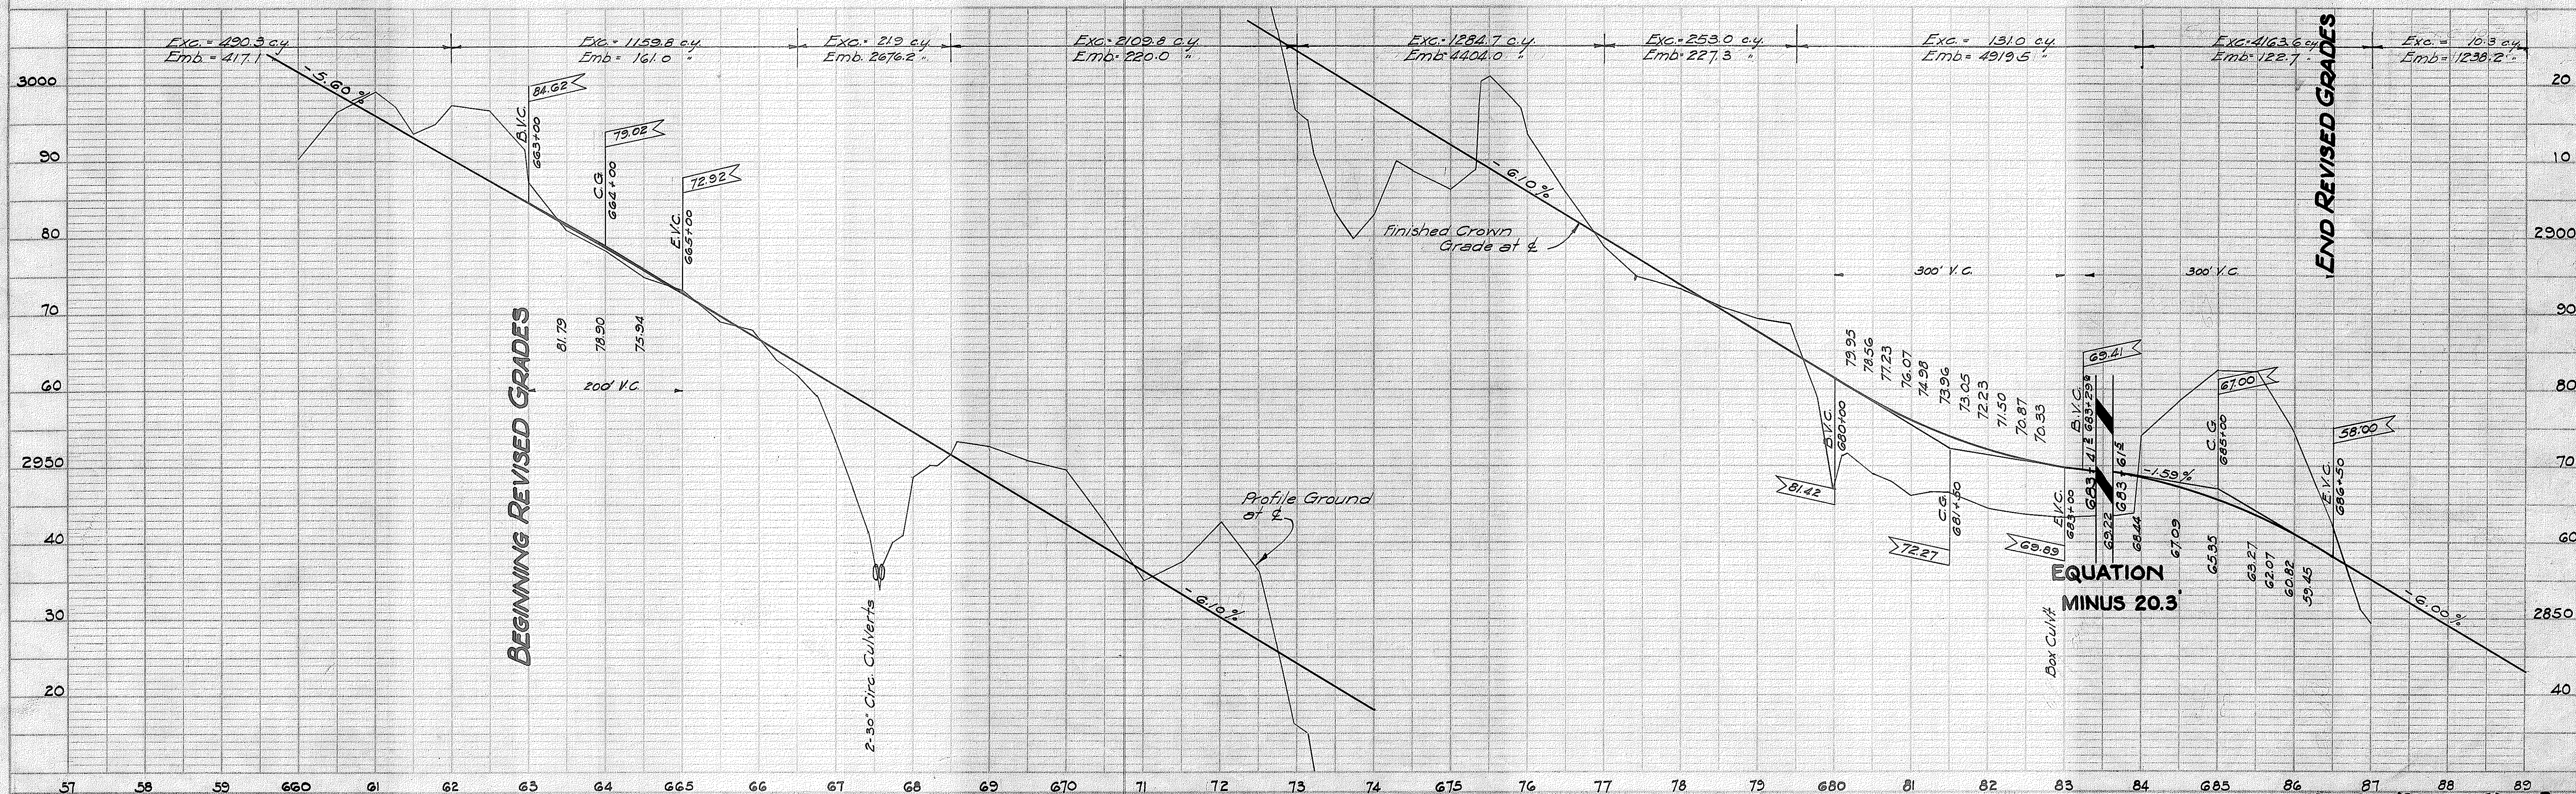


PLATE 1 - PLAN-PROFILE O. S. R. & R. STANDARD
REVISED & REPAIRED CO. NEW YORK

4267.6A

PLAN	DATE	BY
DESIGNED		
CHECKED		
NOTE BOOK		
ALIGNMENT CHECKED		
RT. OF WAY CHECKED		
NO.		

PROFILE	DATE	BY
DESIGNED		
CHECKED		
NOTE BOOK		
GRADES CHECKED		
BY M.A. NOTED		
STRUCTURE NOTATIONS CHD.		
NO.		

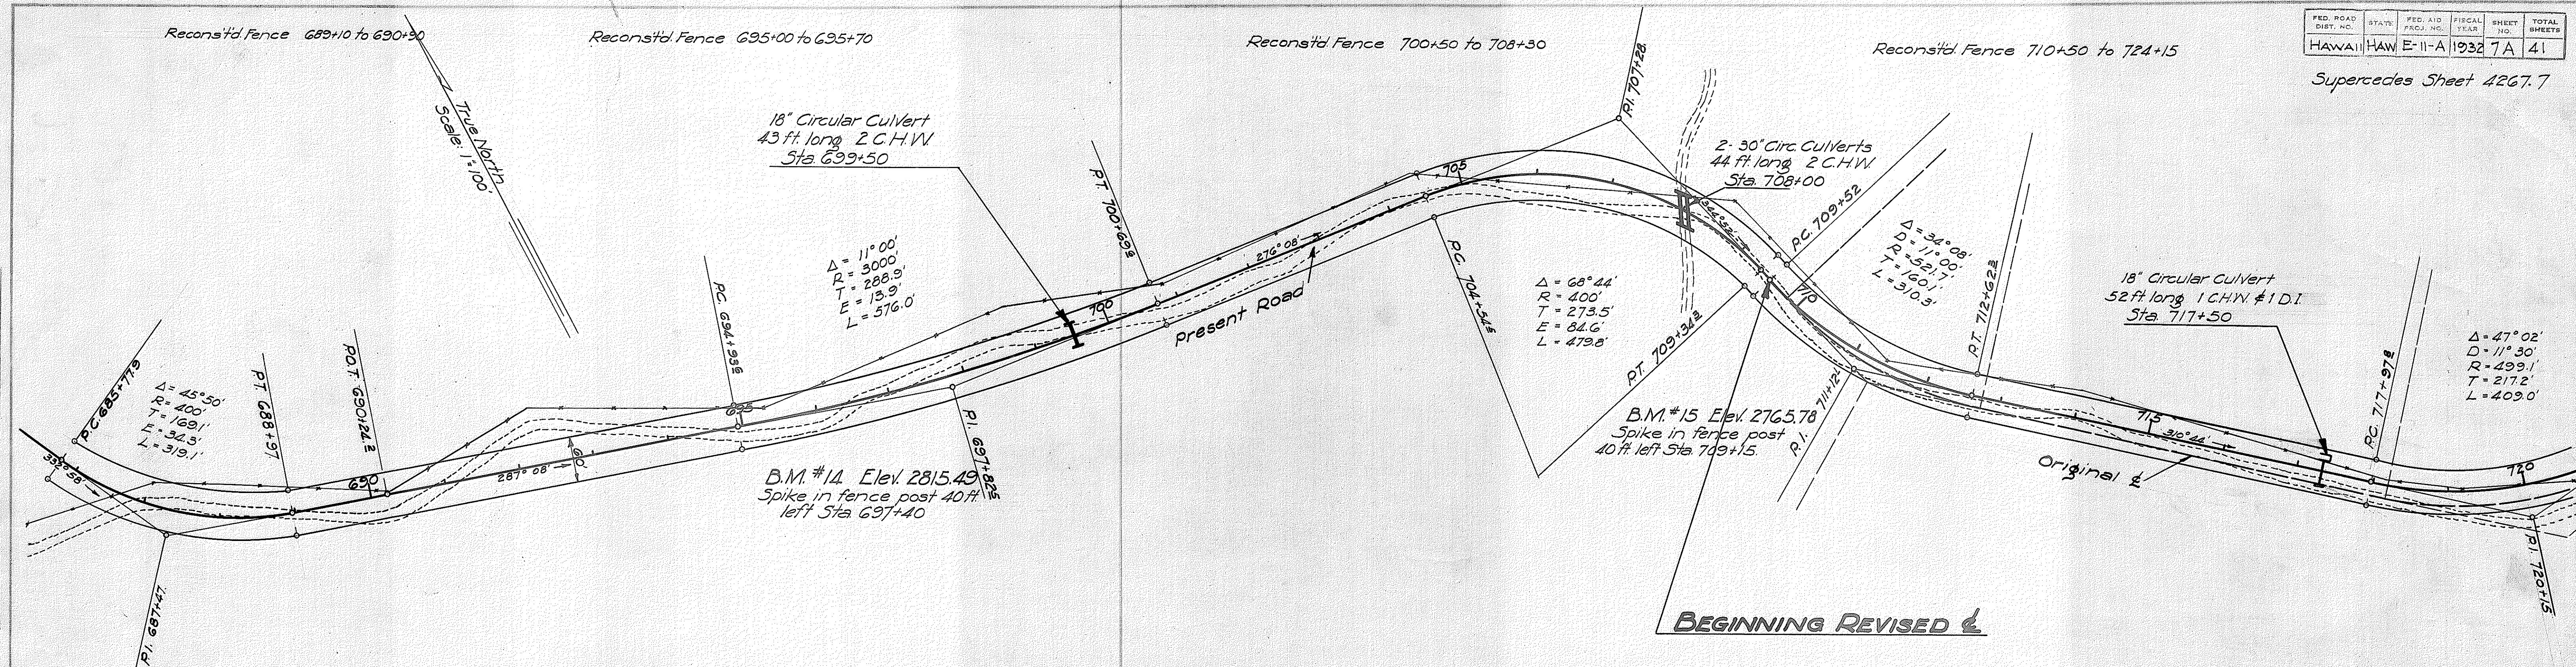

REVISED ALIGNMENT
F.A.P. No. E-11-A
OCT. 1932

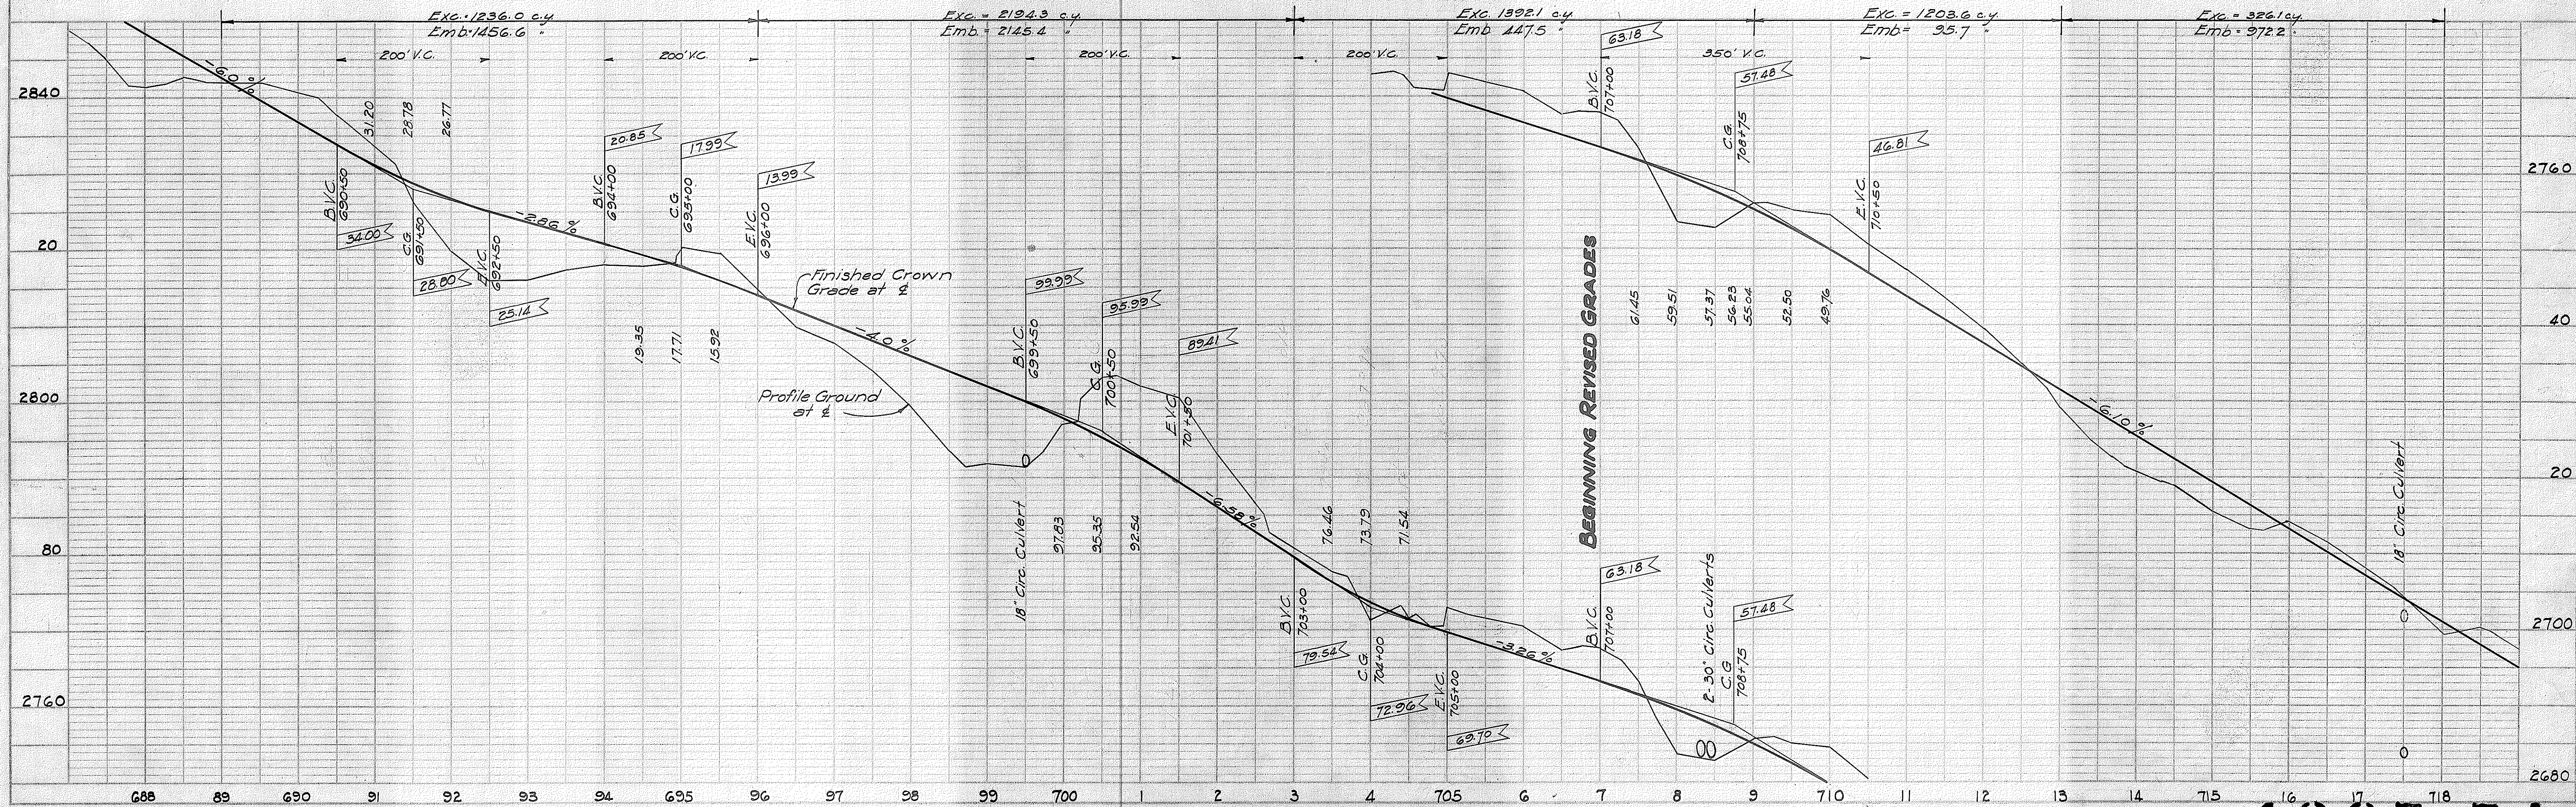



PLATE 1 - PLAN-PROFILE OF ROAD STANDARD
HEITZEL & ZIEGLER CO., NEW YORK

4267.7A


FED. ROAD DIST. NO.	STATE	FED. AID FISCAL YEAR	SHEET NO.	TOTAL SHEETS
HAWAII	HAW.	E-11-A	1932 8 A	41



Supersedes Sheet 4267.8

Reconst'd Fence Sta 725+75 to 766+70

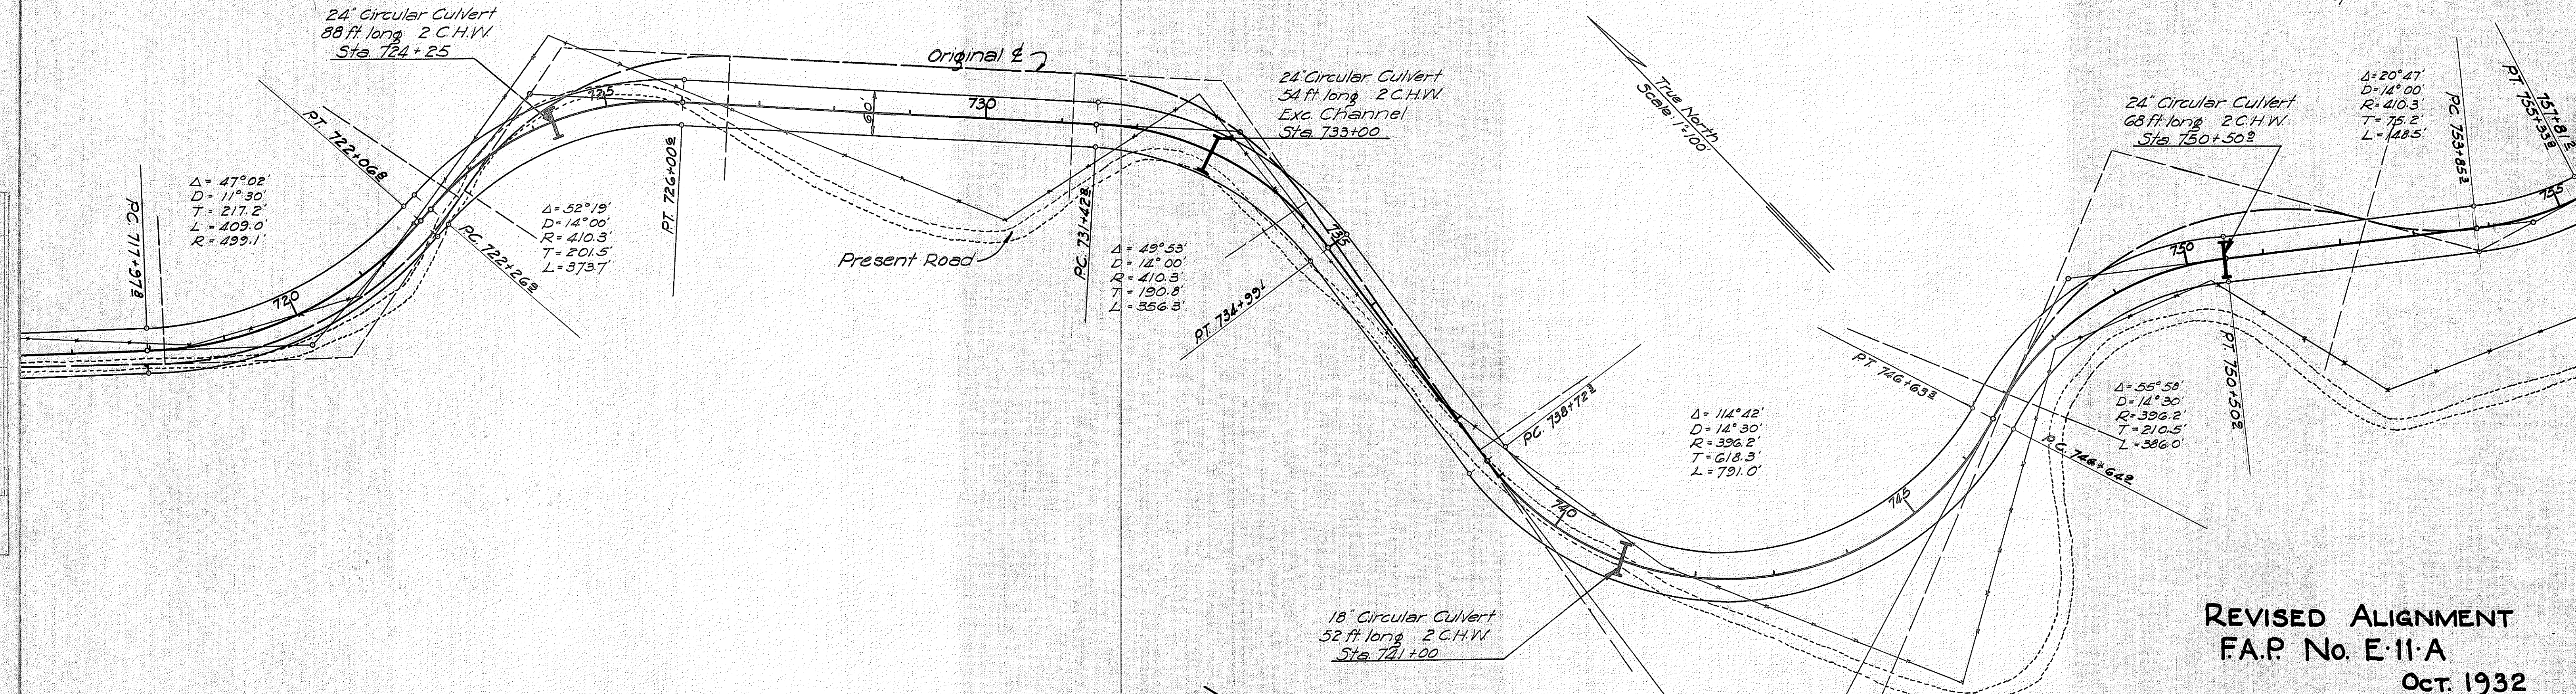

REVISED ALIGNMENT
F.A.P. No. E-11-A
Oct. 1932

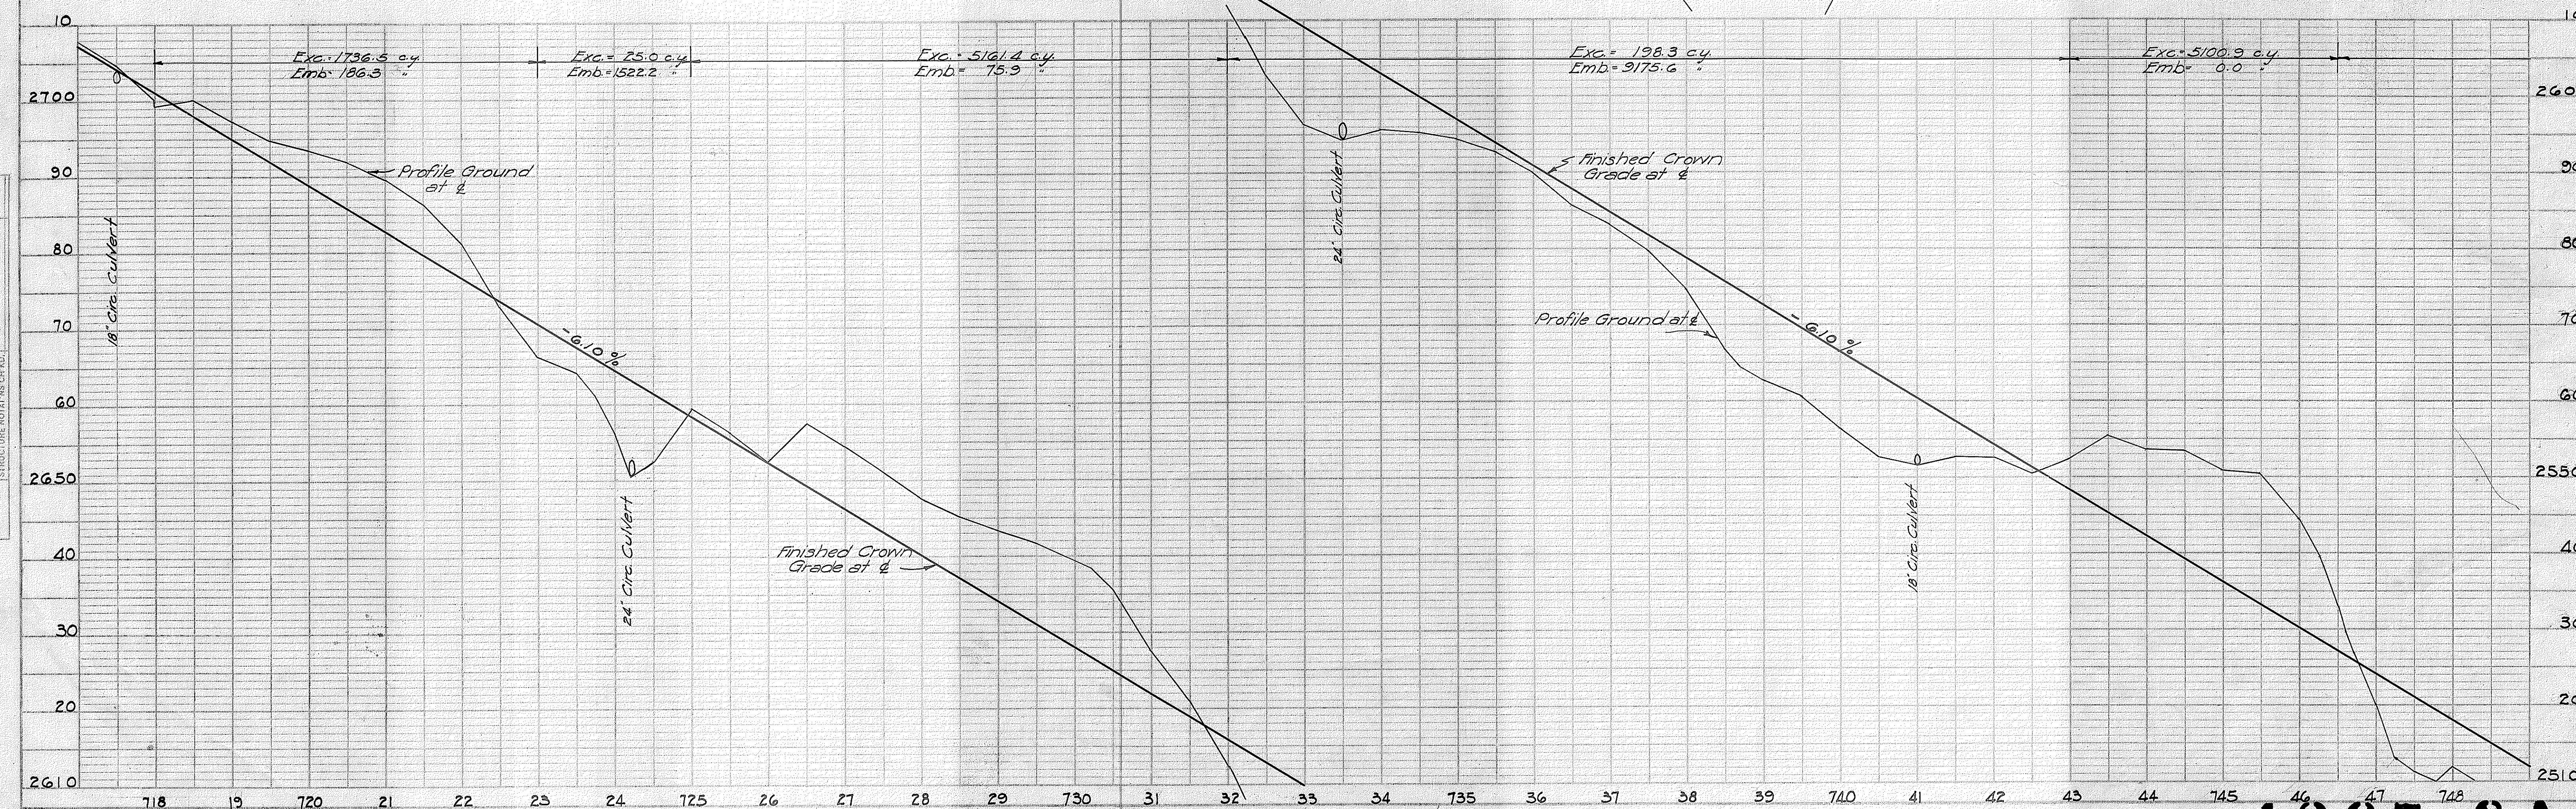

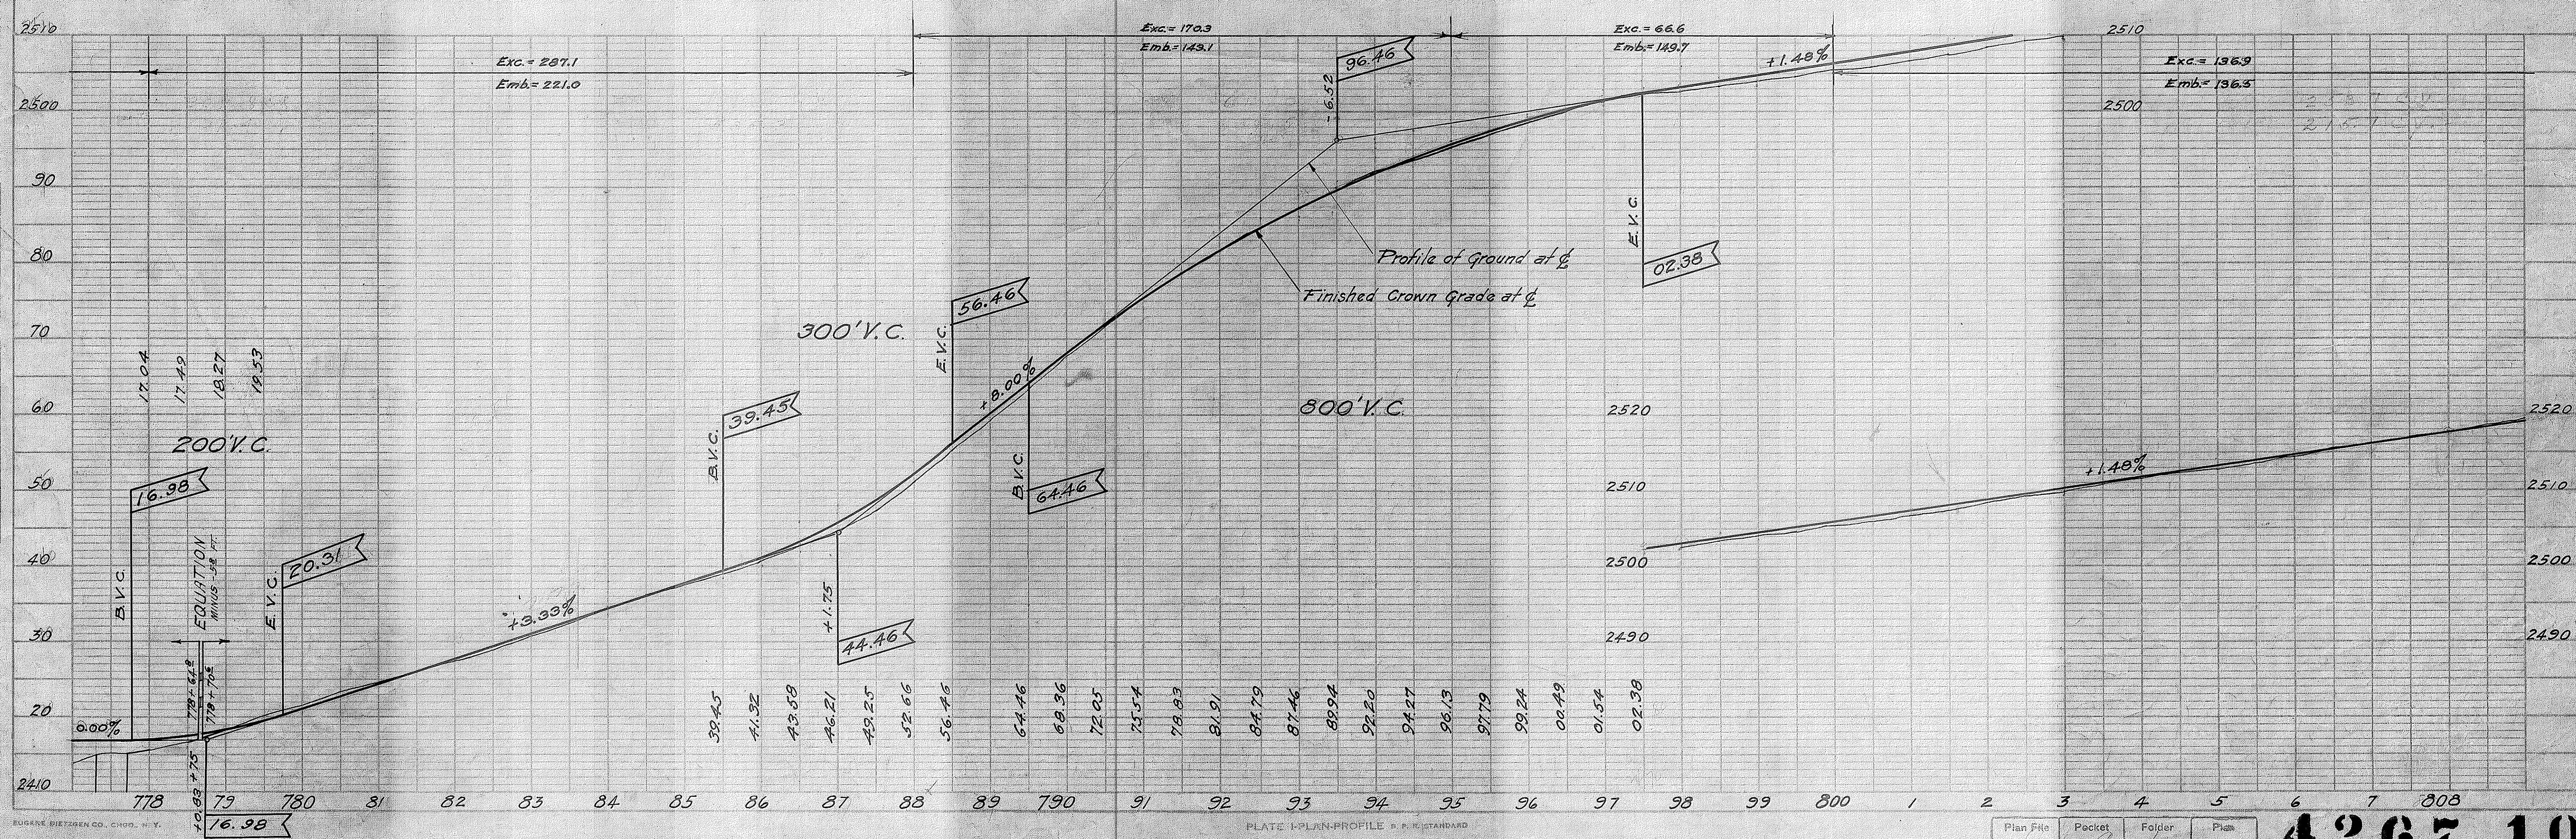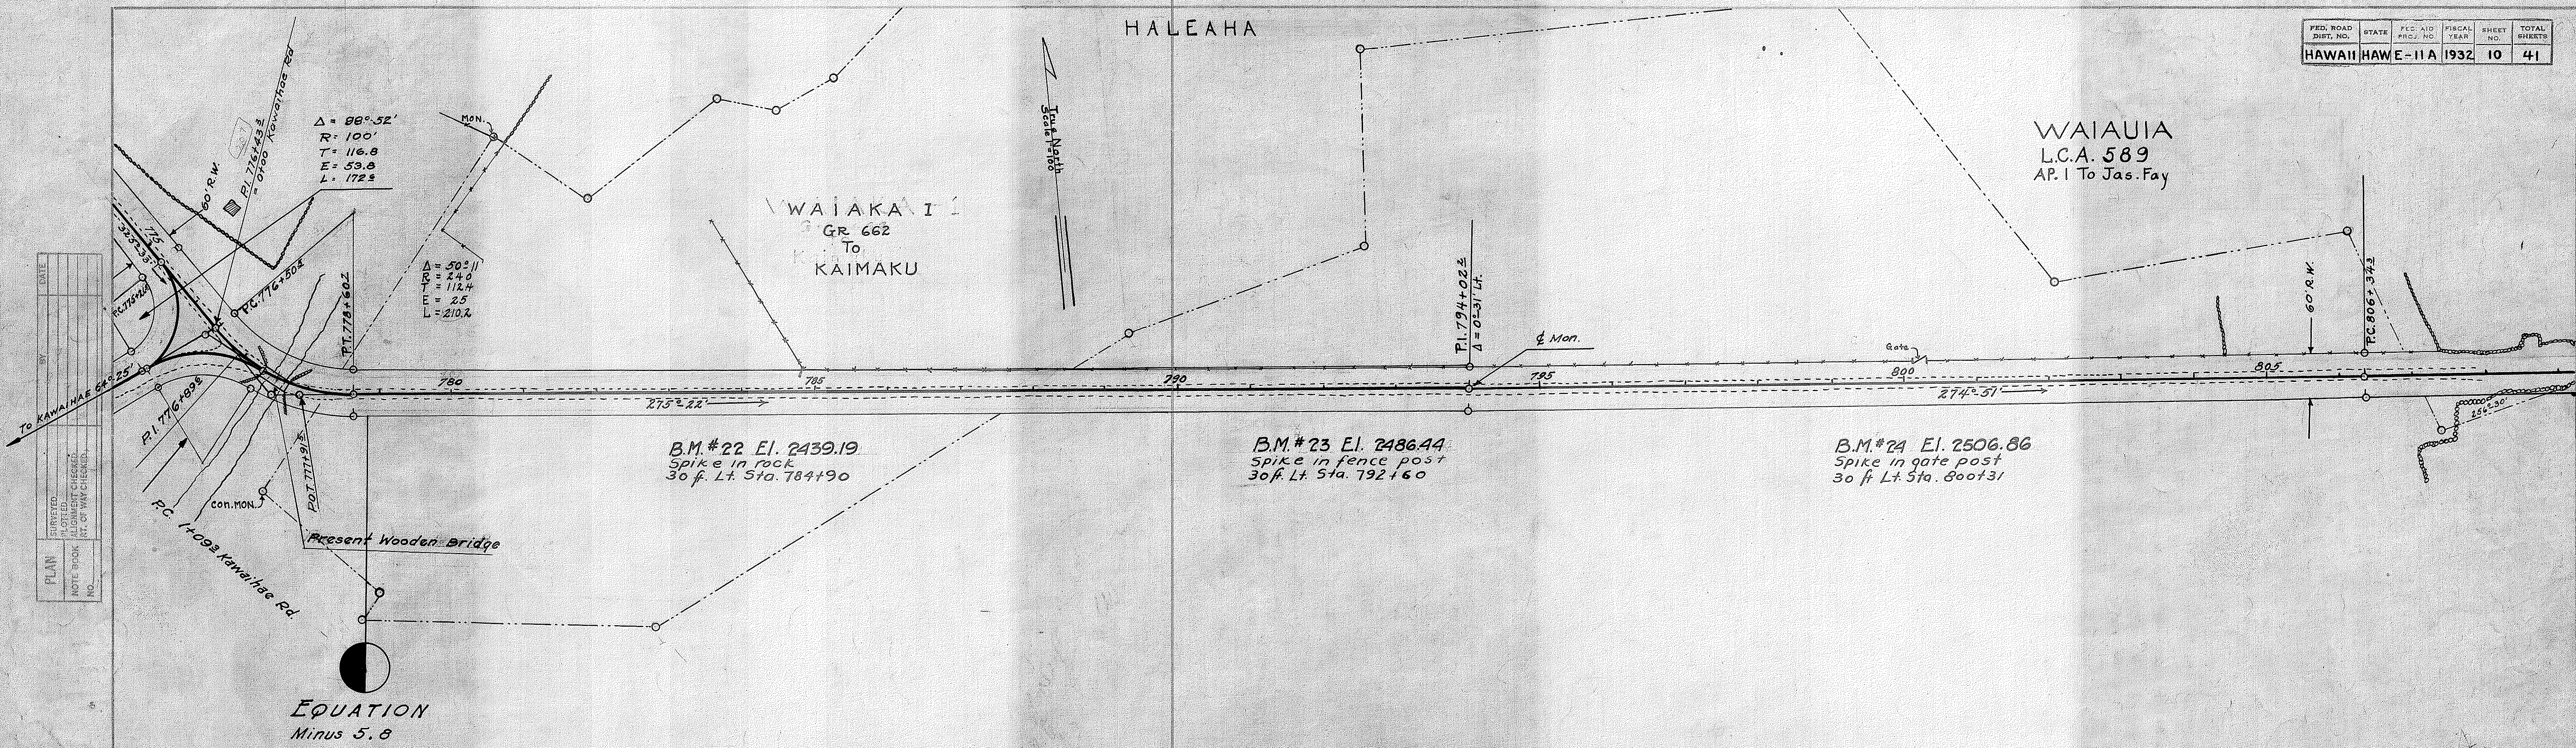

FED. ROAD DIST. NO.	STATE	FISCAL YEAR	SHEET NO.	TOTAL SHEETS
HAWAII	HAW	E-11A	11	41

PLAN	DATE
NO.	

PROFILE	DATE
NO.	

