


PUB. ROAD DIST. NO.	STATE	FED. AID PROJ. NO.	FISCAL YEAR	SHEET NO.	TOTAL SHEETS
HAWAII	HAW	11-B	1933	12	50
PUB. ROAD DIST. NO.	STATE	FED. AID PROJ. NO.	FISCAL YEAR	SHEET NO.	TOTAL SHEETS
HAWAII	HAW	NDH IIC	1933	3	28

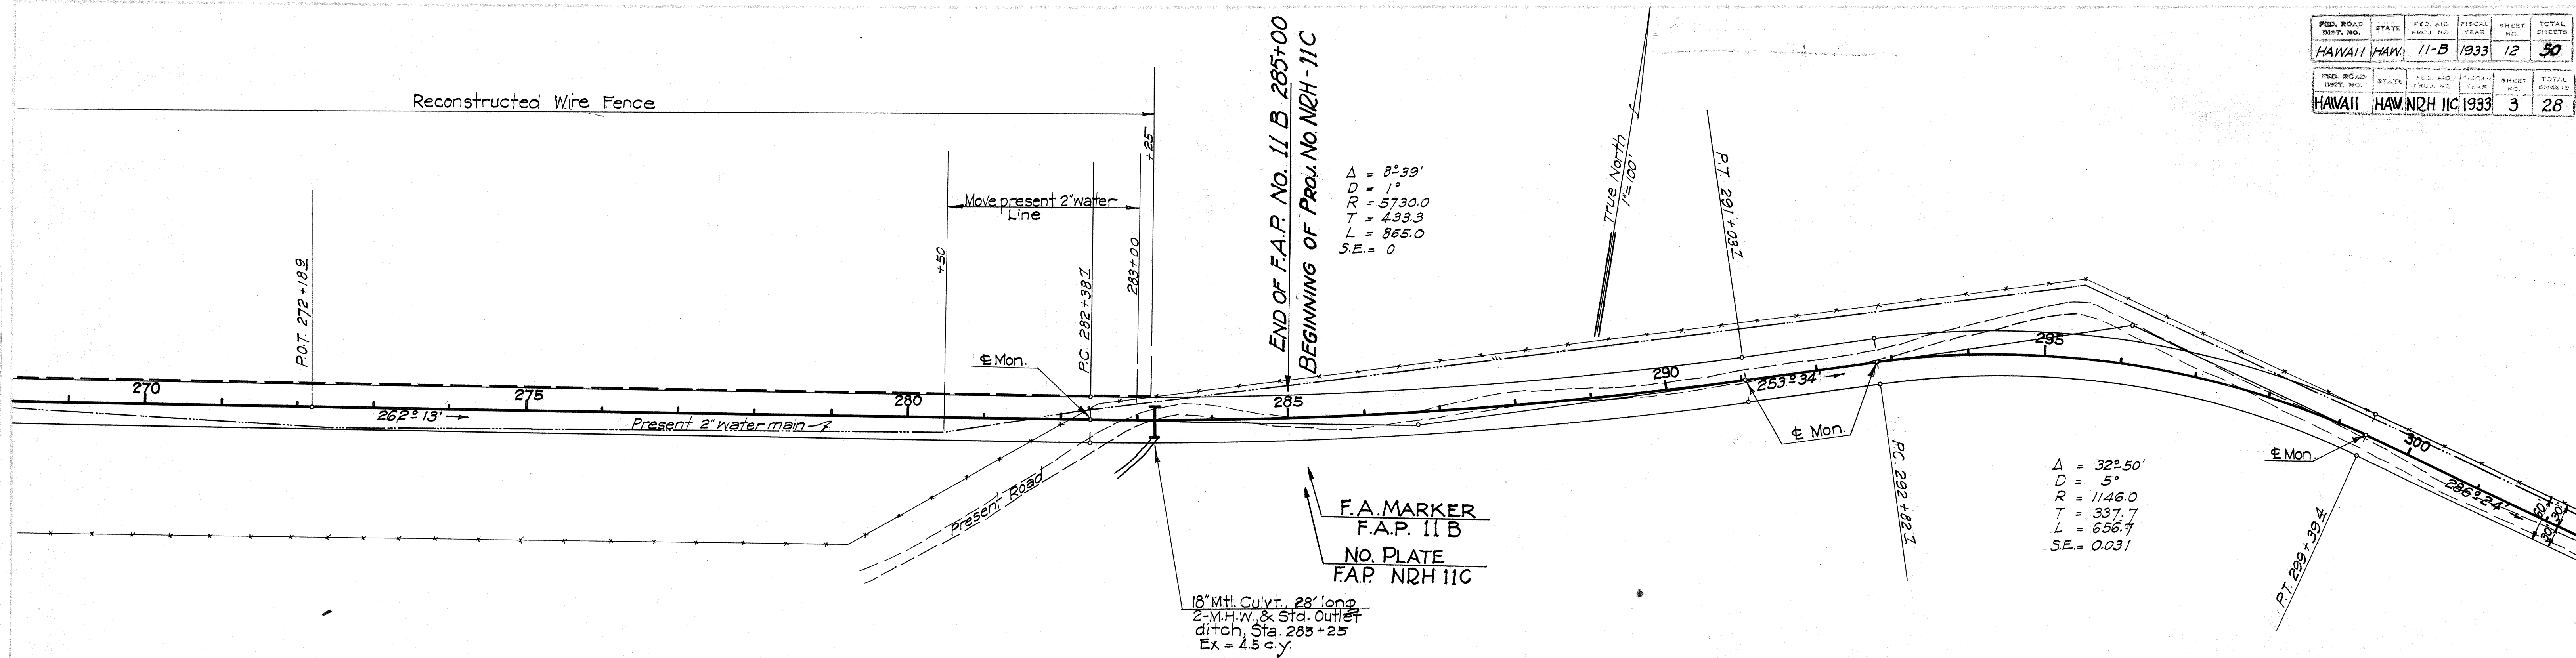


B.M. #46, Spike in rock
46' left, Sta. 270+00
Elev. 1401.74

B.M. #47, Spike in rock
52' Right, Sta. 275+80
Elev. 1433.68

B.M. #48, Spike in rock
39' left, Sta. 283+00
Elev. 1478.73


B.M. #49, Spike in fence post
60' left, Sta. 288+35
Elev. 1513.41

B.M. #50, U.S.G.S. Bronze Tablet
60' Right, Sta. 295+25
Elev. 1562.01

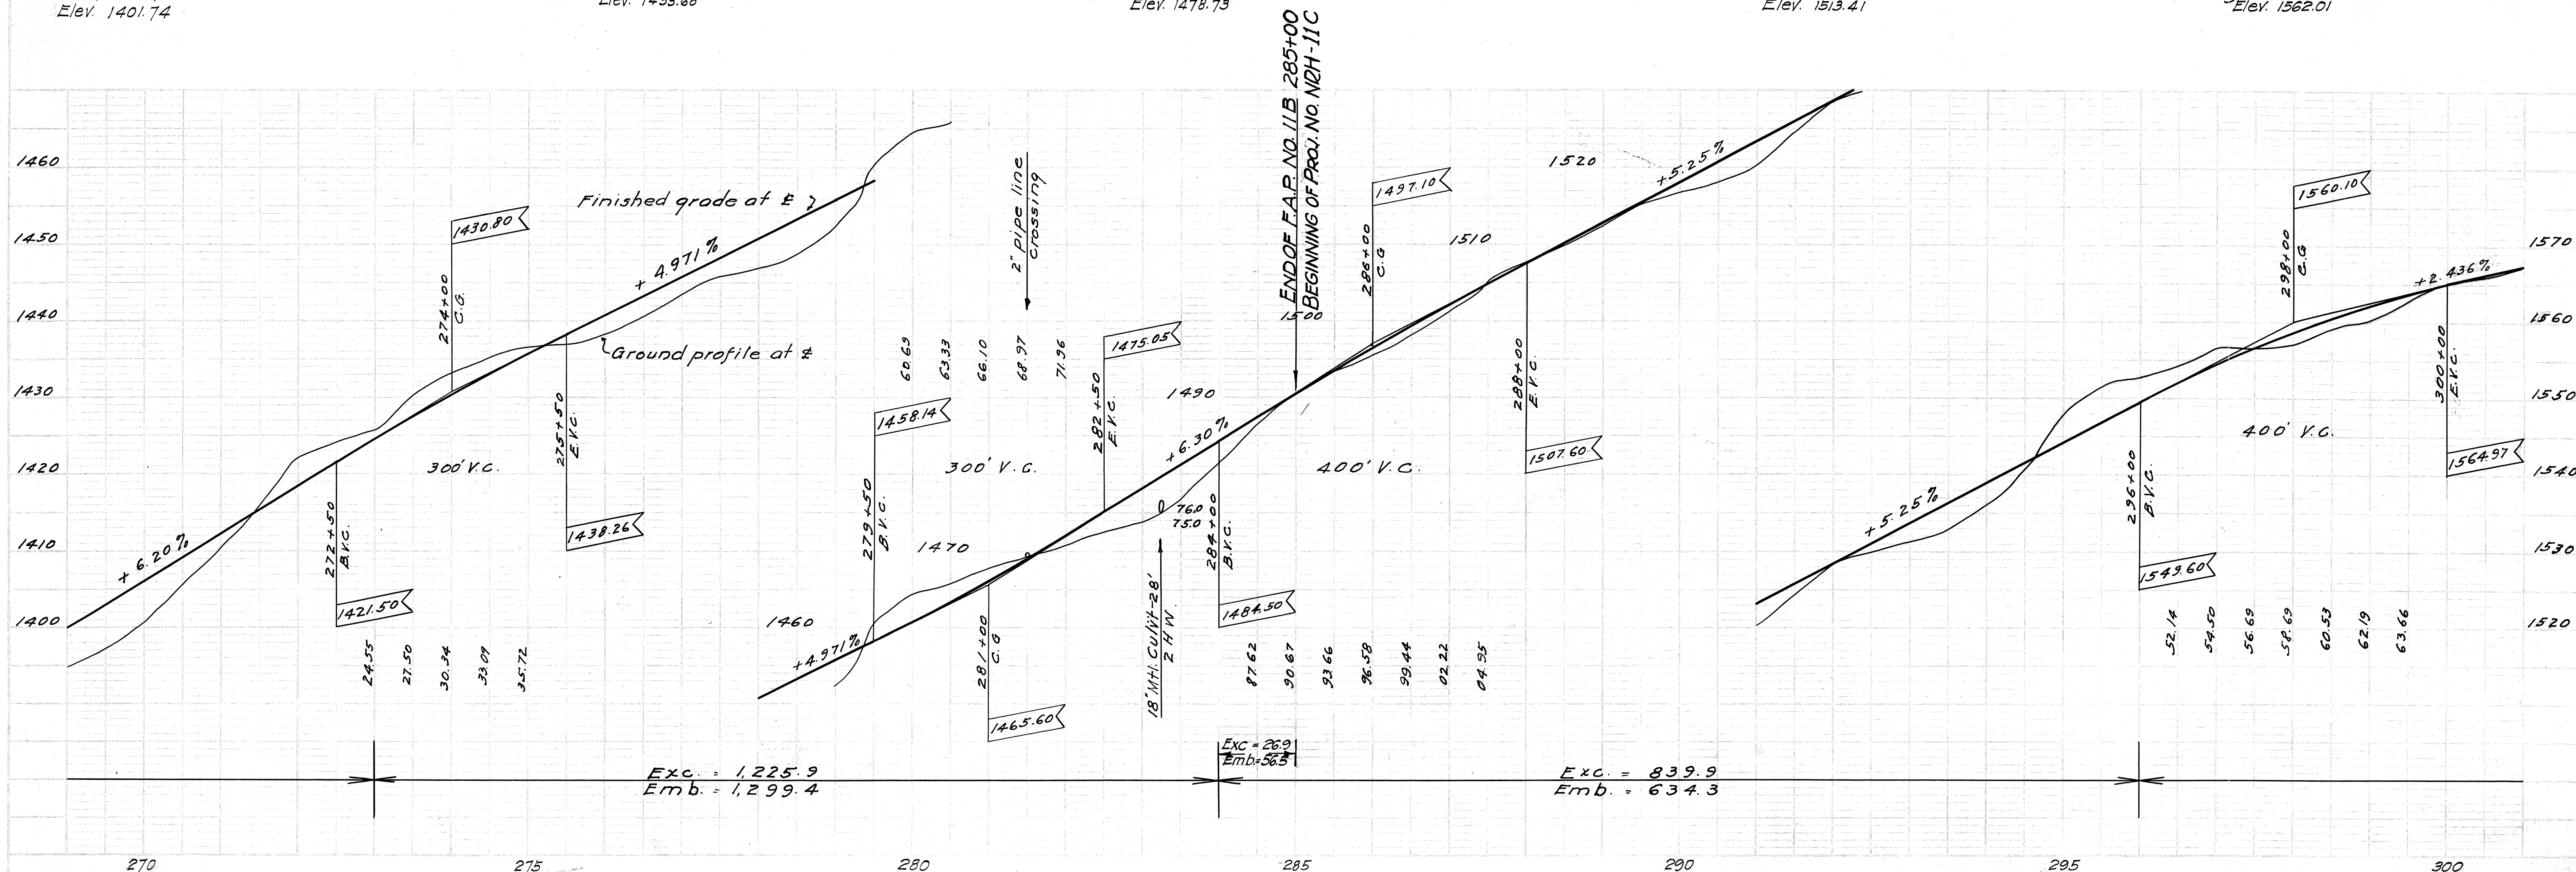

4293.3 4287.12

PLAN
 DATE
 BY
 CHECKED
 NOTE BOOK
 NO.

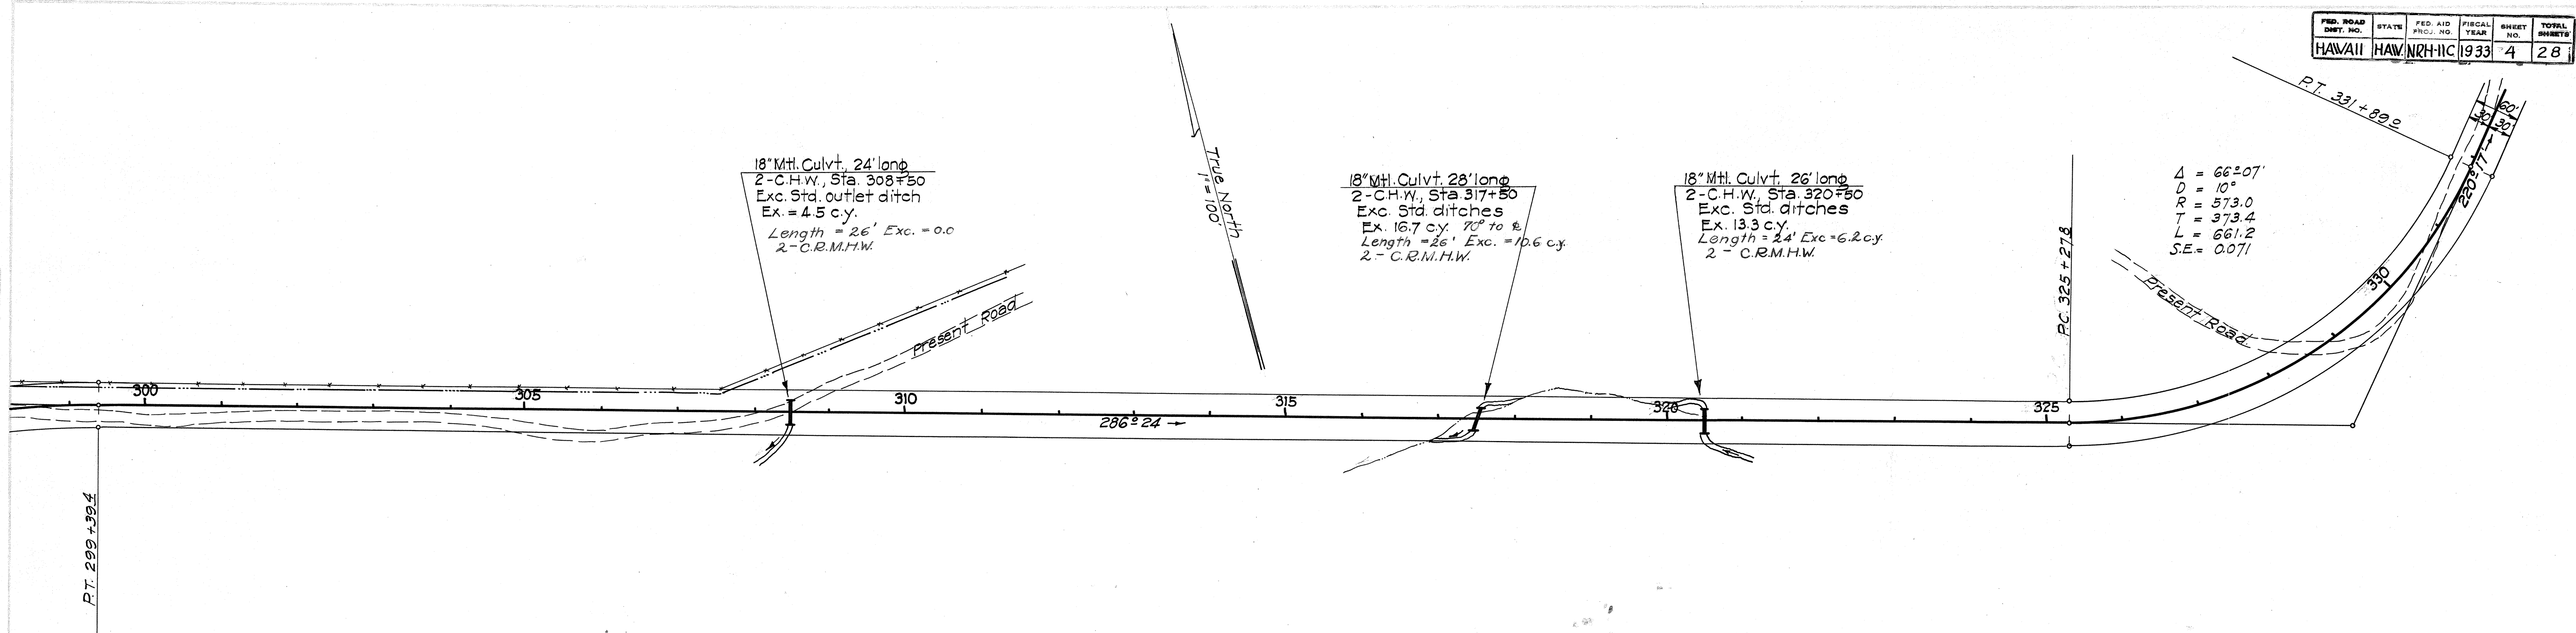


B.M. #51, Spike in rock
 40' left, Sta. 301+25
 Elev. 1567.76

B.M. #52, Spike in cor-fence post
 30' left, Sta. 307+50
 Elev. 1582.05



B.M. #53, Spike in rock
 60' left, Sta. 315+25
 Elev. 1611.22

B.M. #54, Spike in rock
 59' left, Sta. 321+00
 Elev. 1647.51


PROFILE
 DATE
 BY
 CHECKED
 NOTE BOOK
 NO.

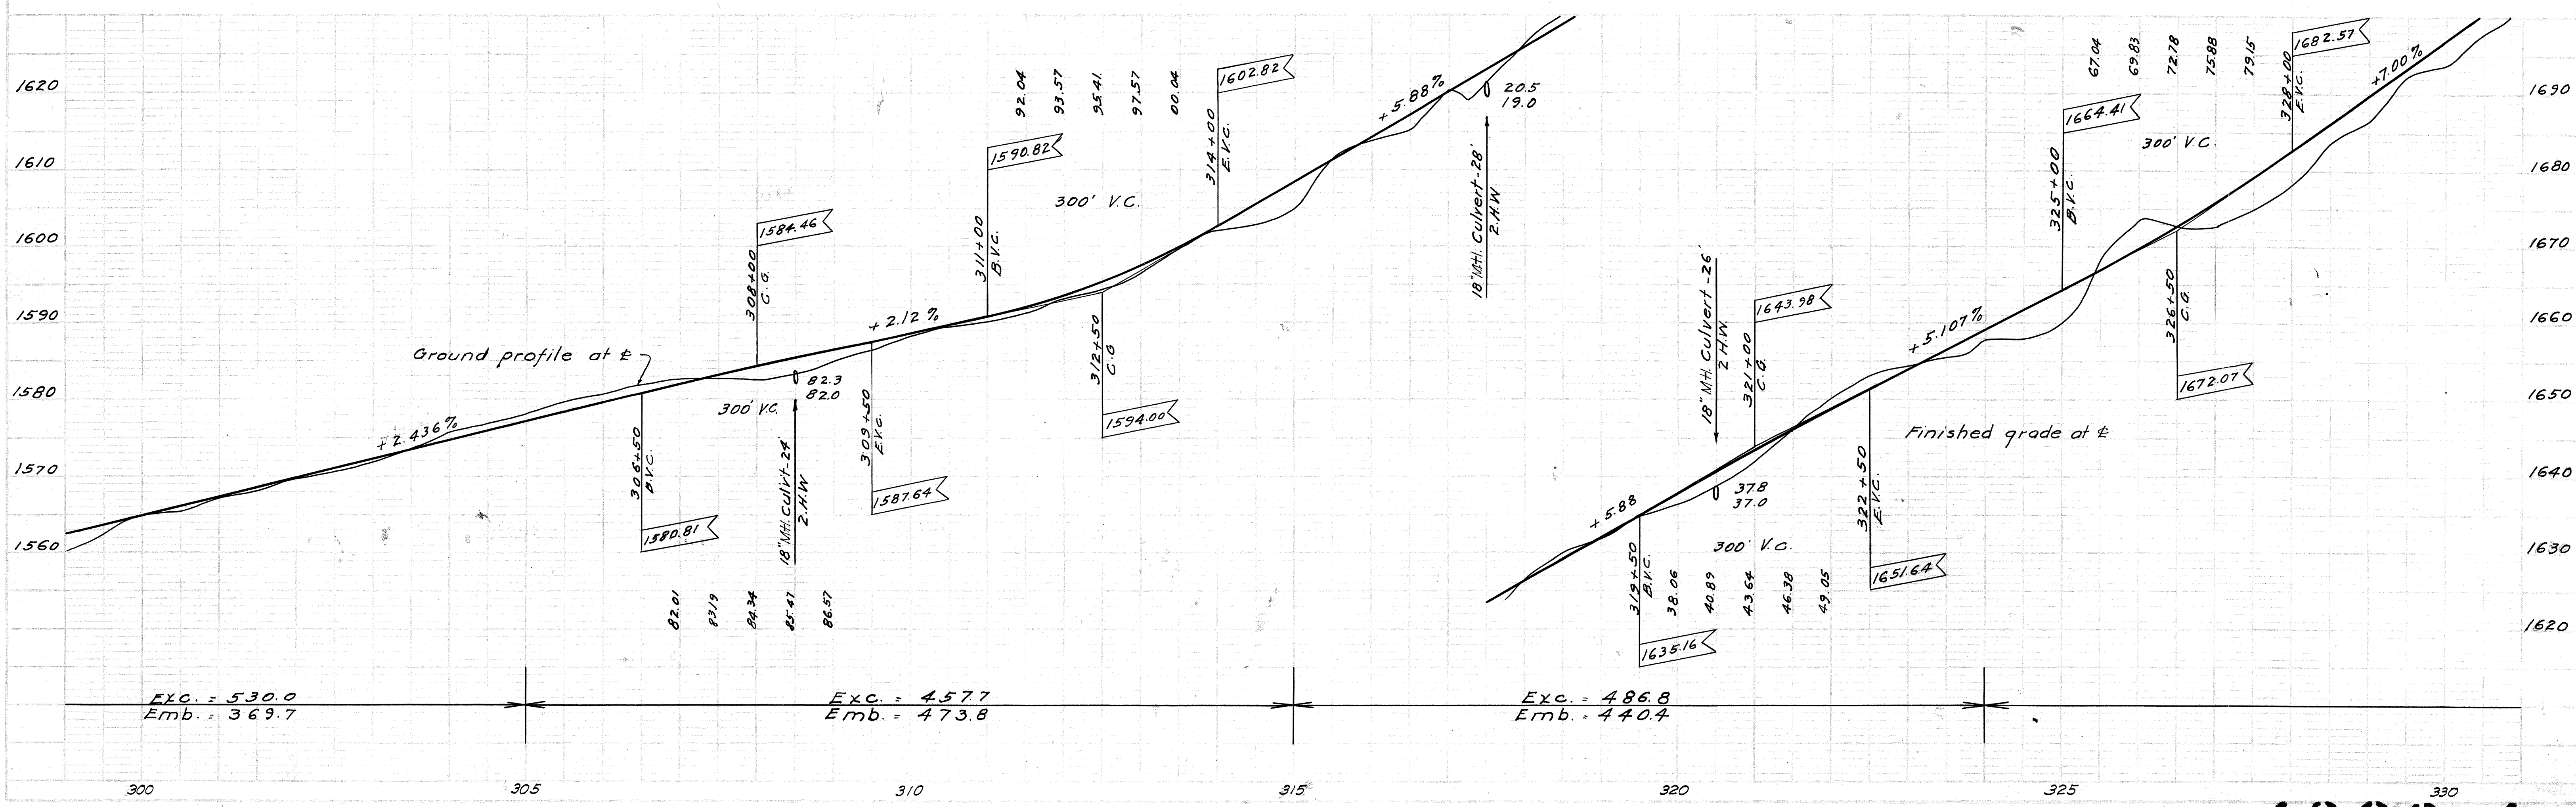

PLAN
 DRAWN BY
 CHECKED BY
 DATE
 NOTE: ROAD GRADES CHECKED
 BY
 DATE
 DATE: 10/1/33

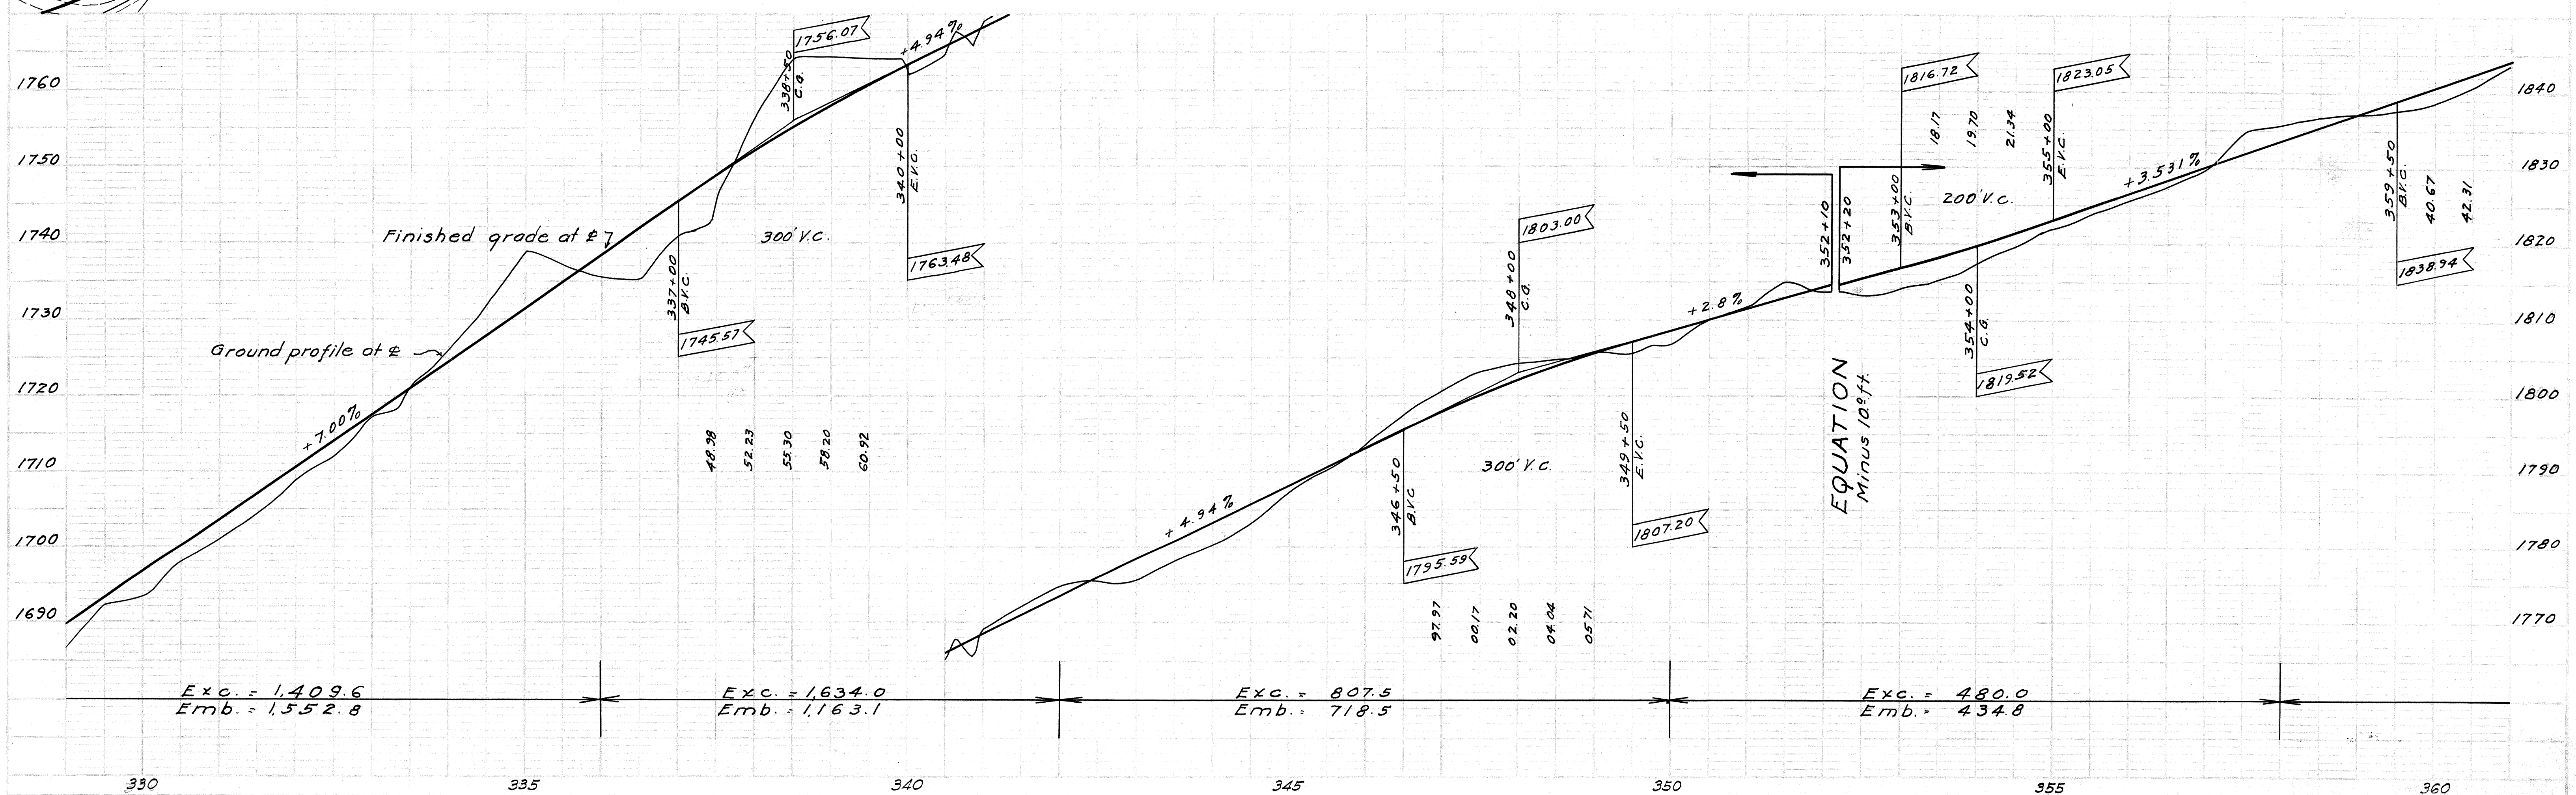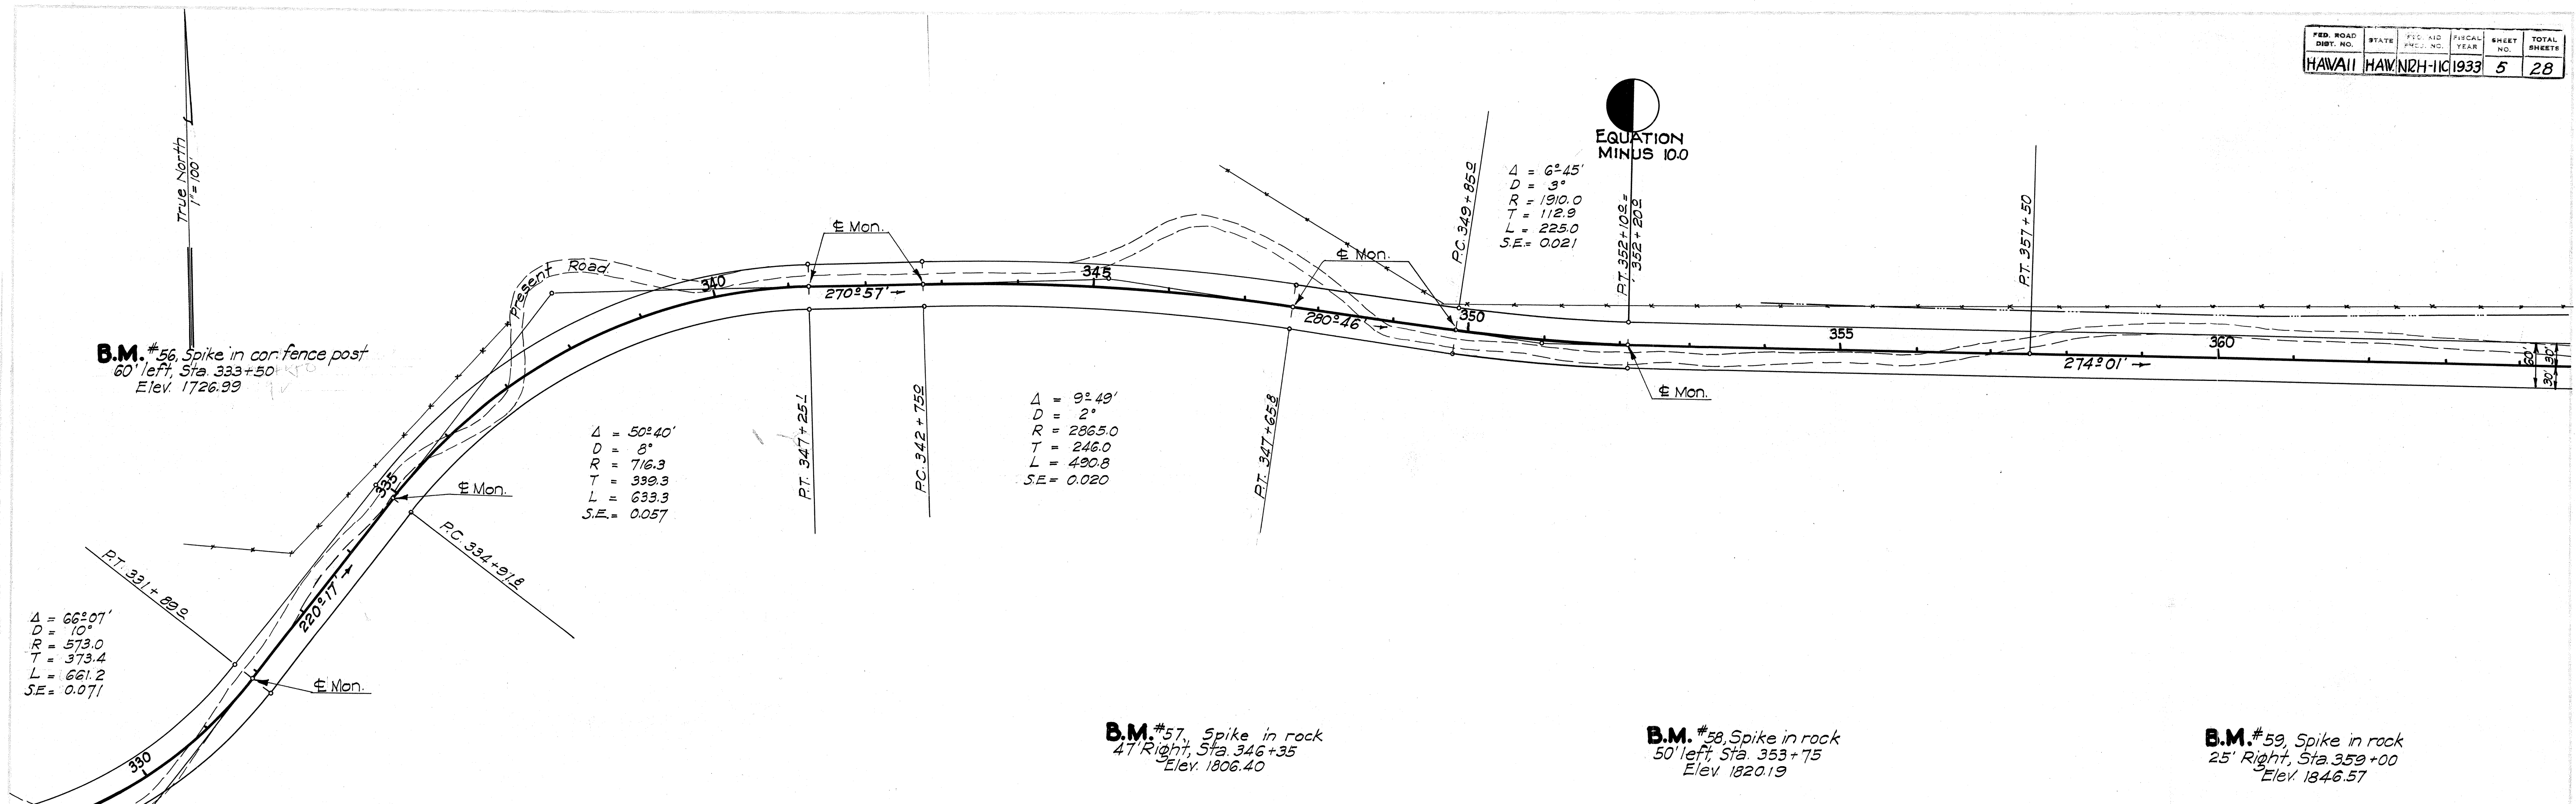

PLAN
 DATE
 BY
 CHECKED
 NOTE BOOK
 NO.

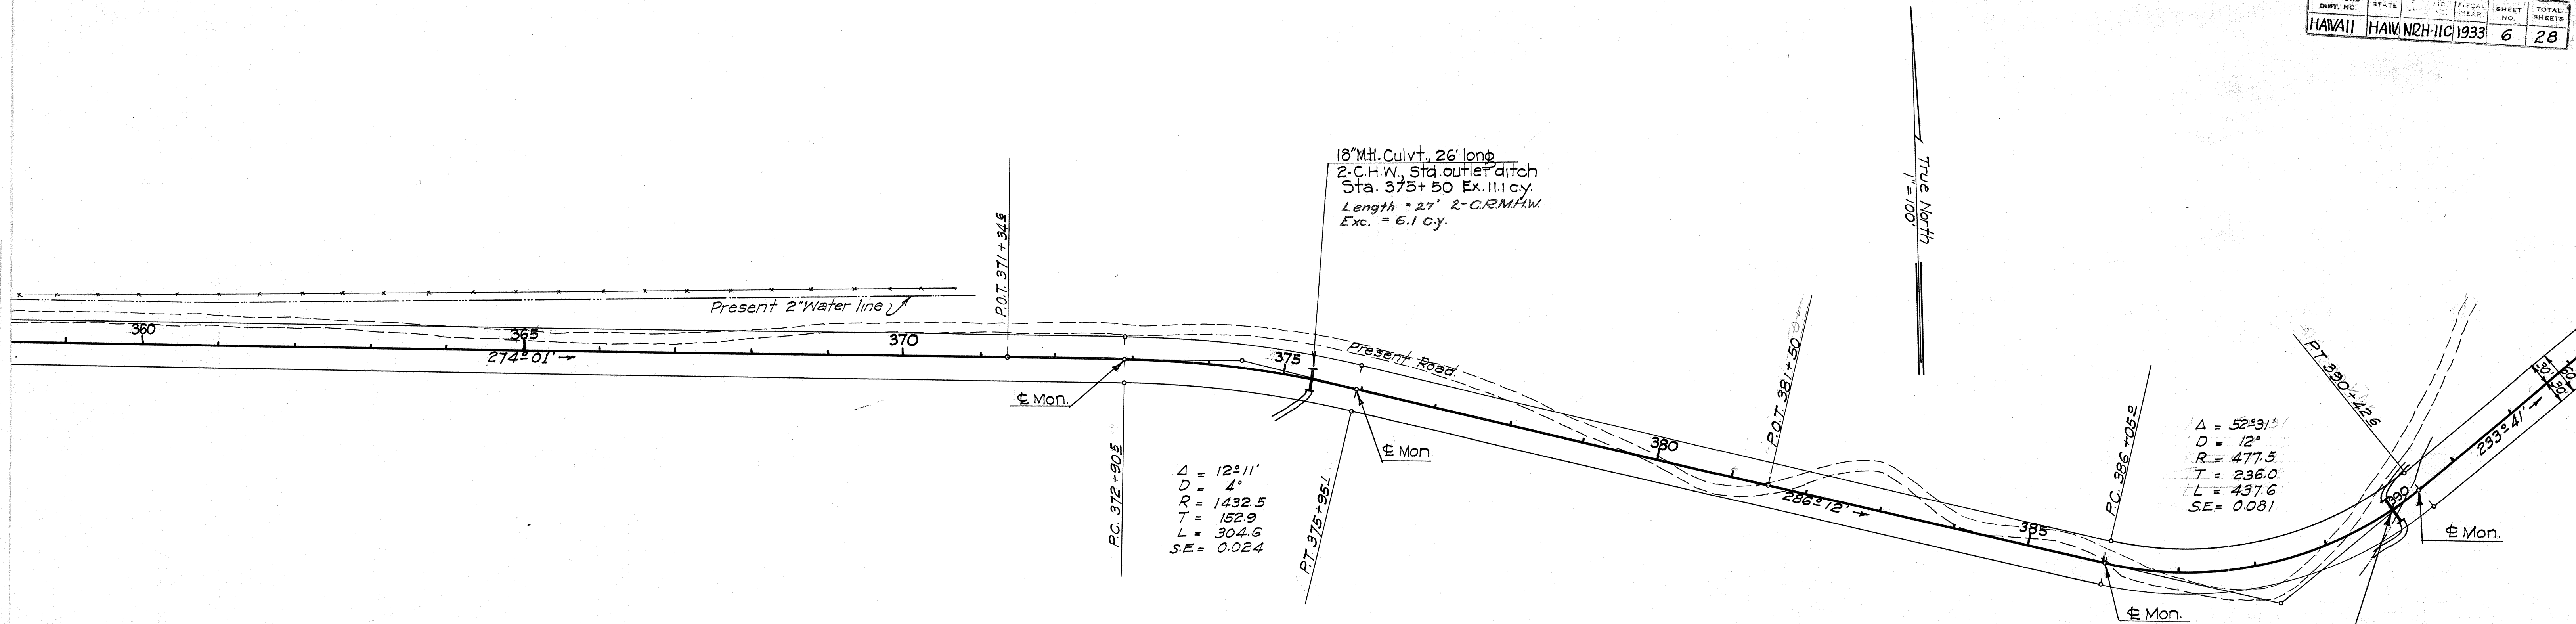

B.M. #60, Spike in fence post
 70' left, Sta. 366+25
 Elev. 1858.96


B.M. #61, Spike in rock
 35' Right, Sta. 373+00
 Elev. 1894.42

B.M. #62, Spike in rock
 28' Right, Sta. 379+50
 Elev. 1913.76


B.M. #63, Spike in rock
 29' left, Sta. 386+00
 Elev. 1950.98

18' M.H. Culvert, 36' long
 2-C.H.W., Std. outlet ditch
 Sta. 390+00 Ex. 22.2 cy.
 Length = 30 ft 2-C.R.M.H.W.
 Exc. = 2.0 cy.

PROFILE
 DATE
 BY
 CHECKED
 NOTE BOOK
 NO.

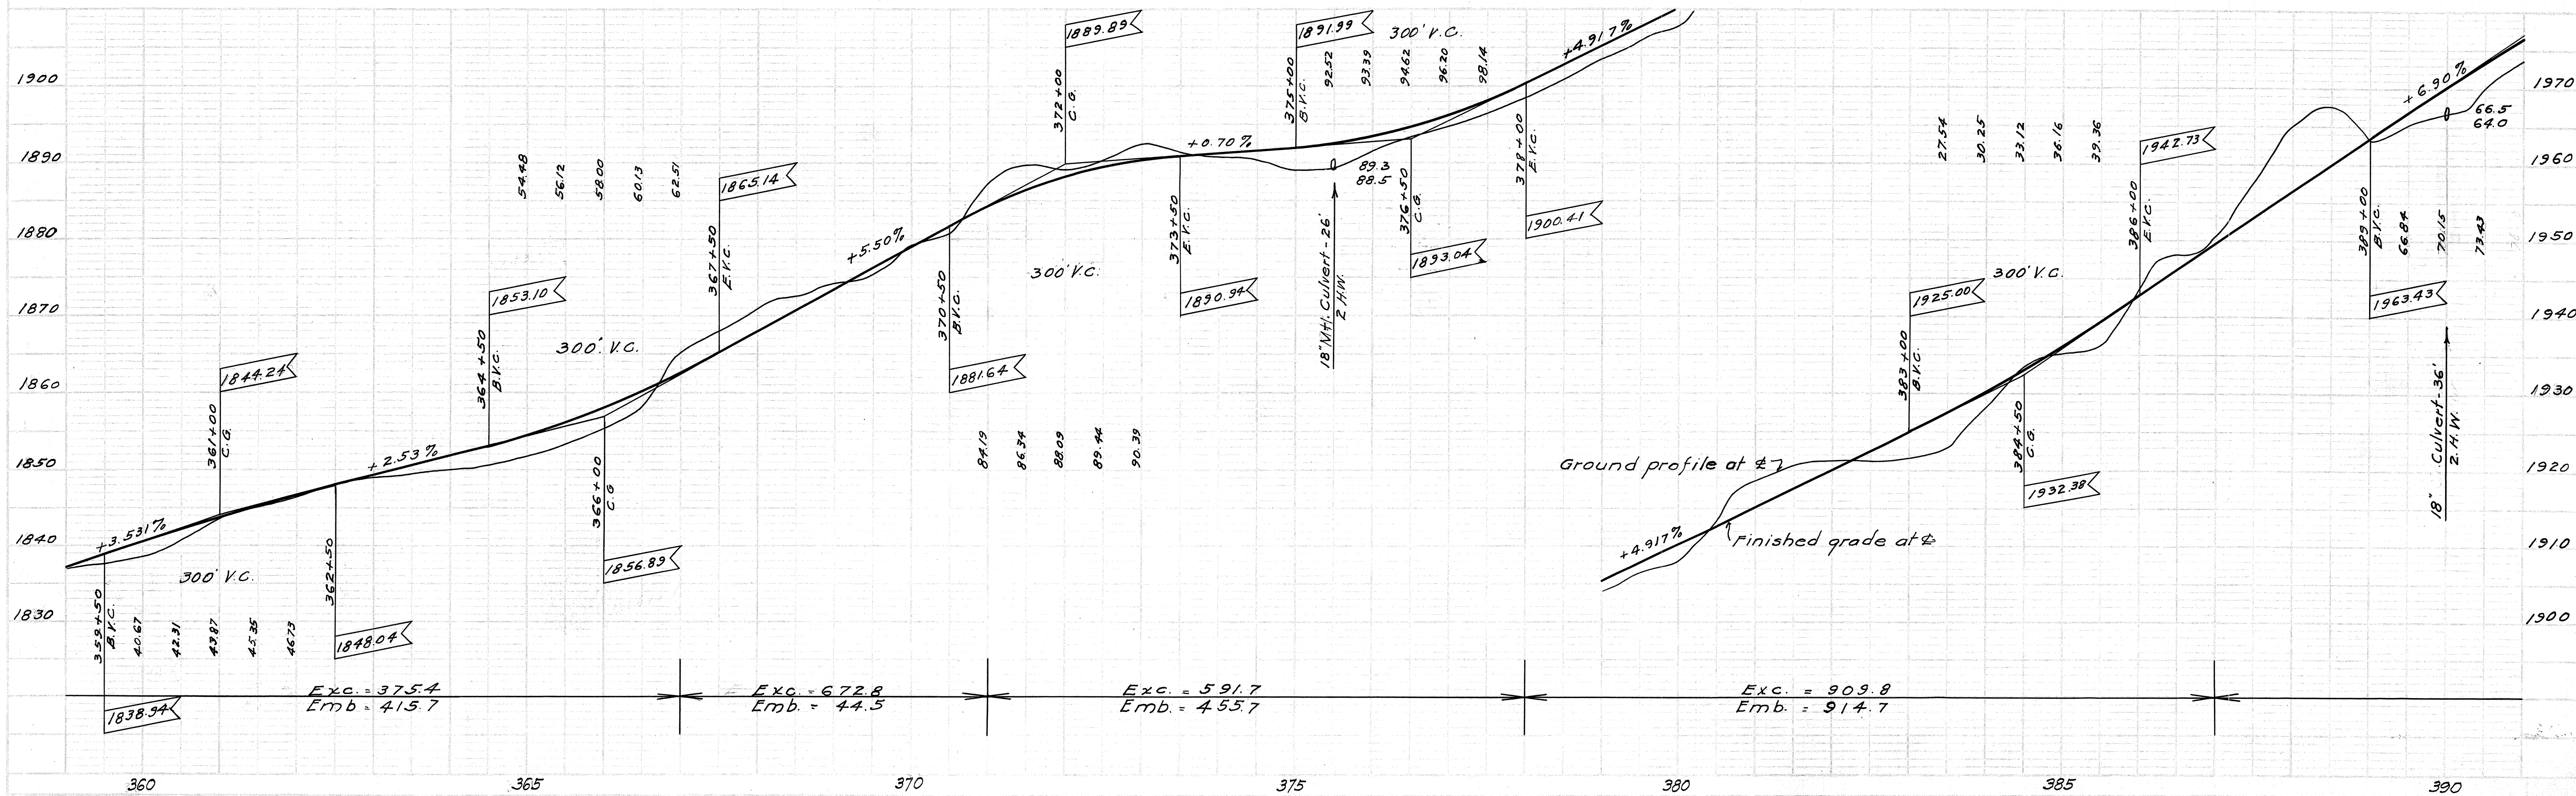

PLAN
DATE
BY
CHECKED
NOTED
REVISIONS

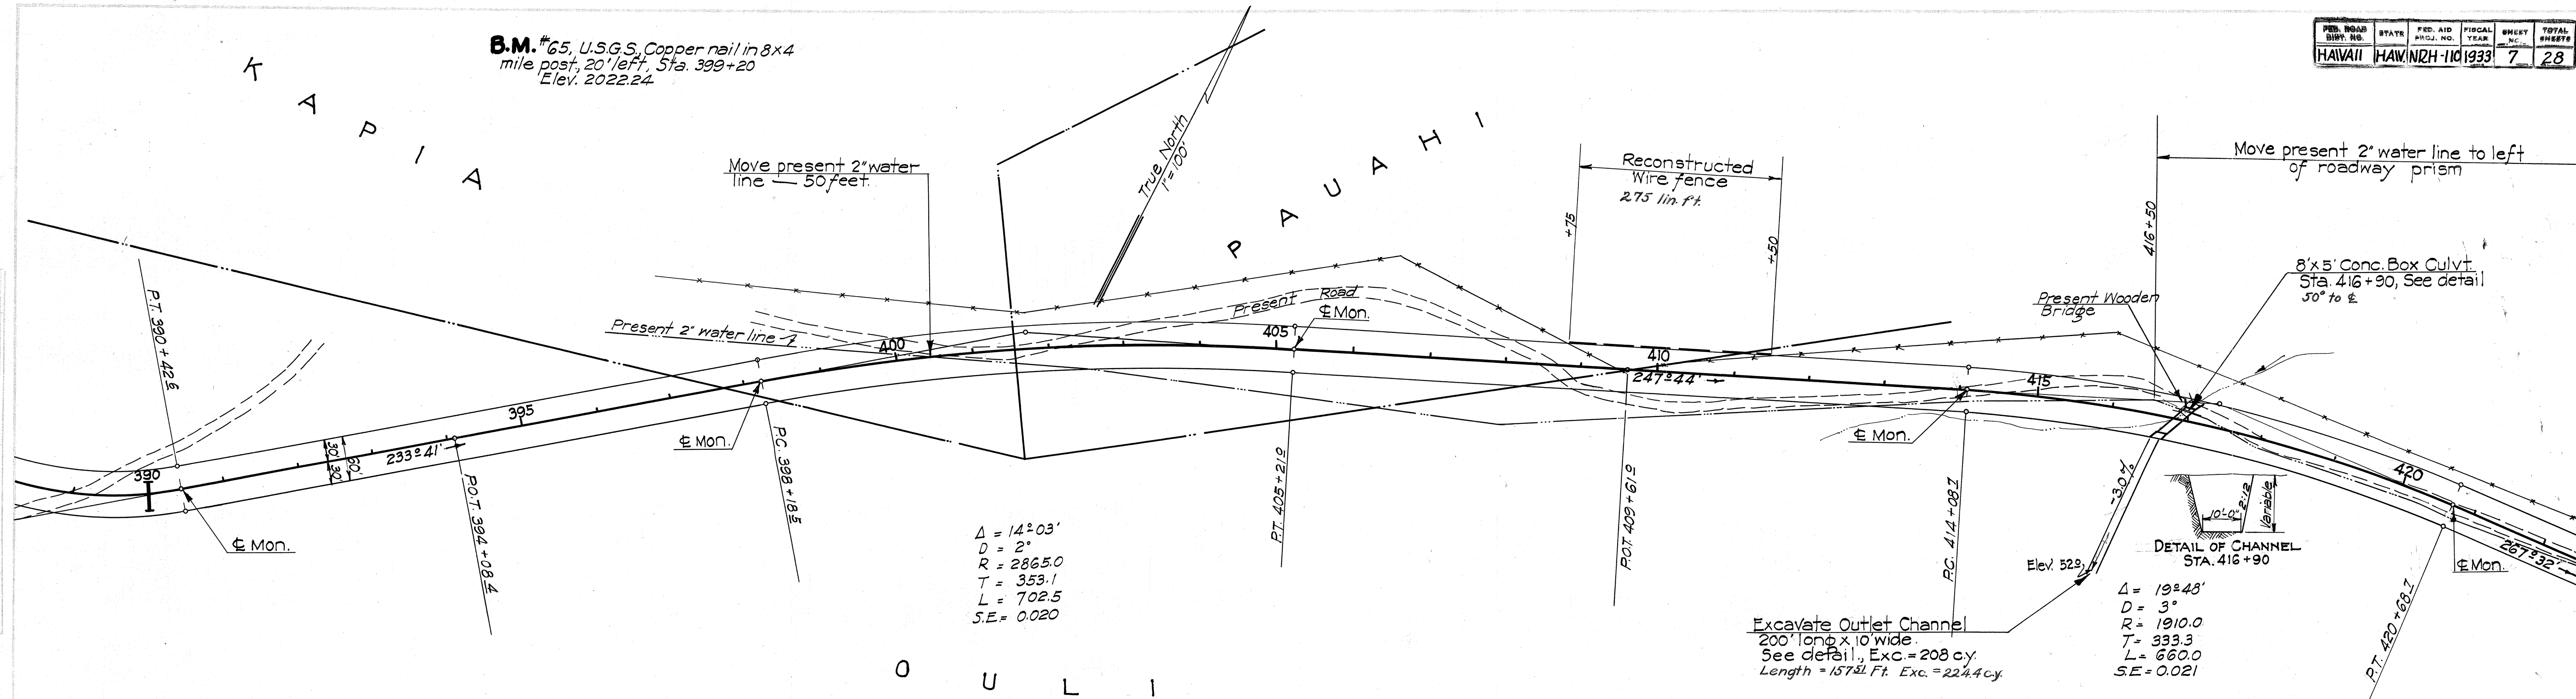

B.M. #64, Spike in rock
60' left, Sta. 391+70
Elev. 1981.23


B.M. #66, Chiseled point on rock.
25' right, Sta. 399+00.
Elev. 2023.83


B.M. #67, Spike in rock
41' right, Sta. 405+00
Elev. 2033.49

B.M. #68, Spike in rock
41' right, Sta. 411+50
Elev. 2059.05

B.M. #70, Spike in Tel. Pole
31' Right, 423+50
Elev. 2098.52

PROFILE
DATE
BY
CHECKED
NOTED
REVISIONS

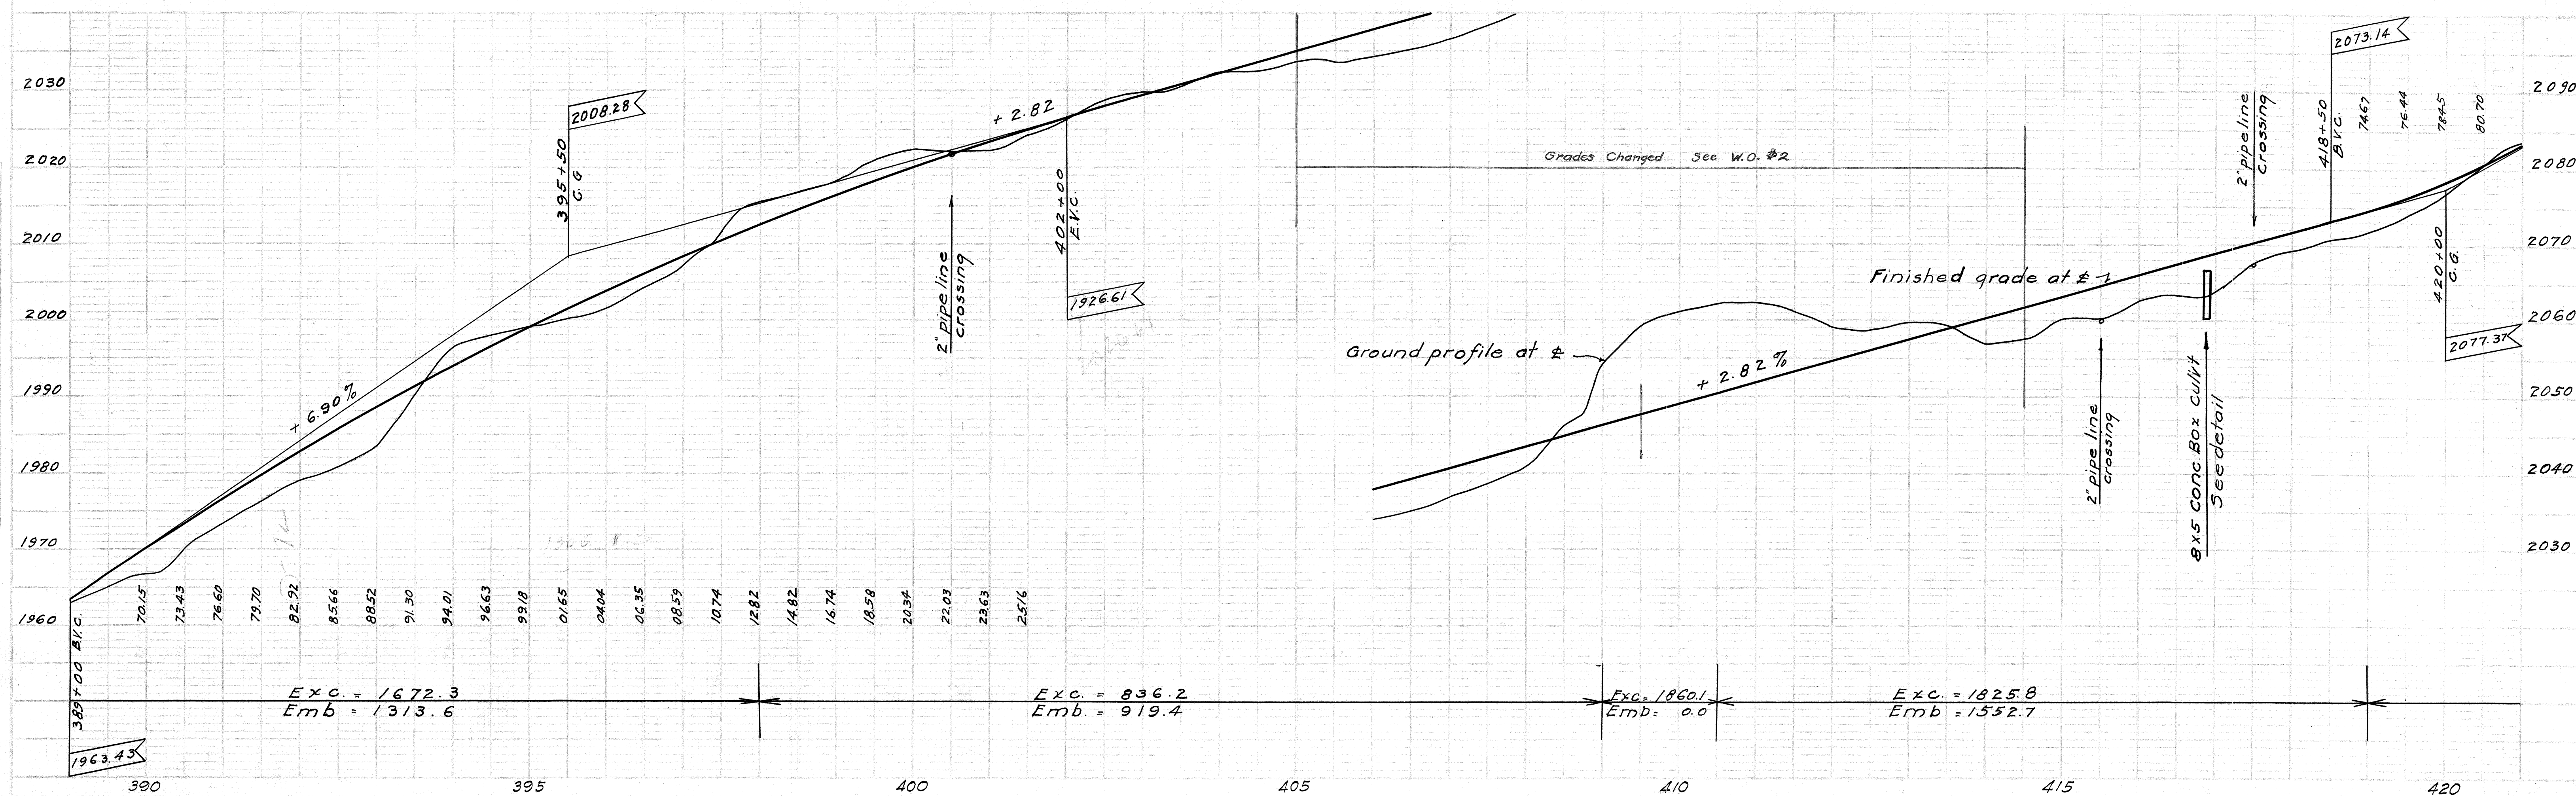

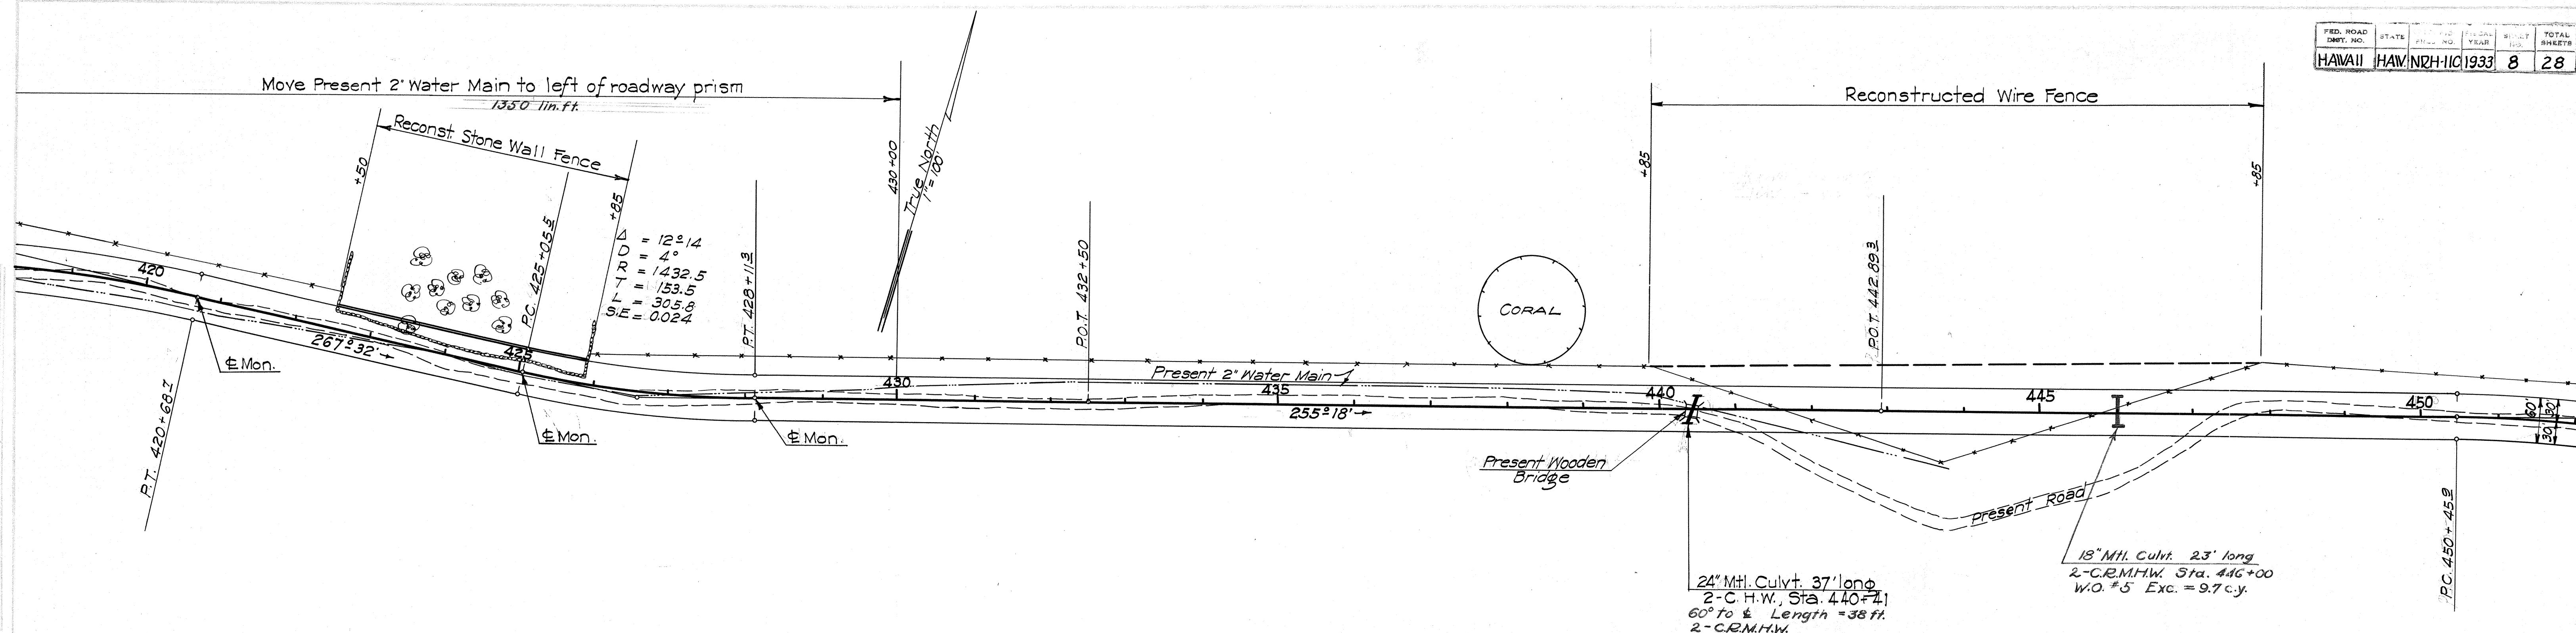

B.M. #70, Spike in Tel. Pole
31' Right, Sta. 423+50
Elev. 2098.52

B.M. #71, Spike in rock
25' Right, Sta. 429+00
Elev. 2130.68

B.M. #72, Spike in rock
28' Right, Sta. 435+95
Elev. 2149.78

B.M. #73, Spike in rock
50' left, Sta. 442+00
Elev. 2184.09

B.M. #74, Spike in Cor. Fence
Post 65' left, Sta. 447+85
Elev. 2206.43

