



REVISIONS
 NO. 1
 DATE 8-33
 BY J.O.V.
 SURVEYED BY J.O.V.
 PLOTTED BY J.O.V.
 NOTE BOOK NO. 10-33
 AREAS CHECKED BY J.O.V.
 DESIGNED BY J.O.V.
 DRAWN BY J.O.V.
 CHECKED BY J.O.V.
 FINAL SURVEY NO. 10-33
 NOTE BOOK NO. 10-33
 AREAS CHECKED BY J.O.V.

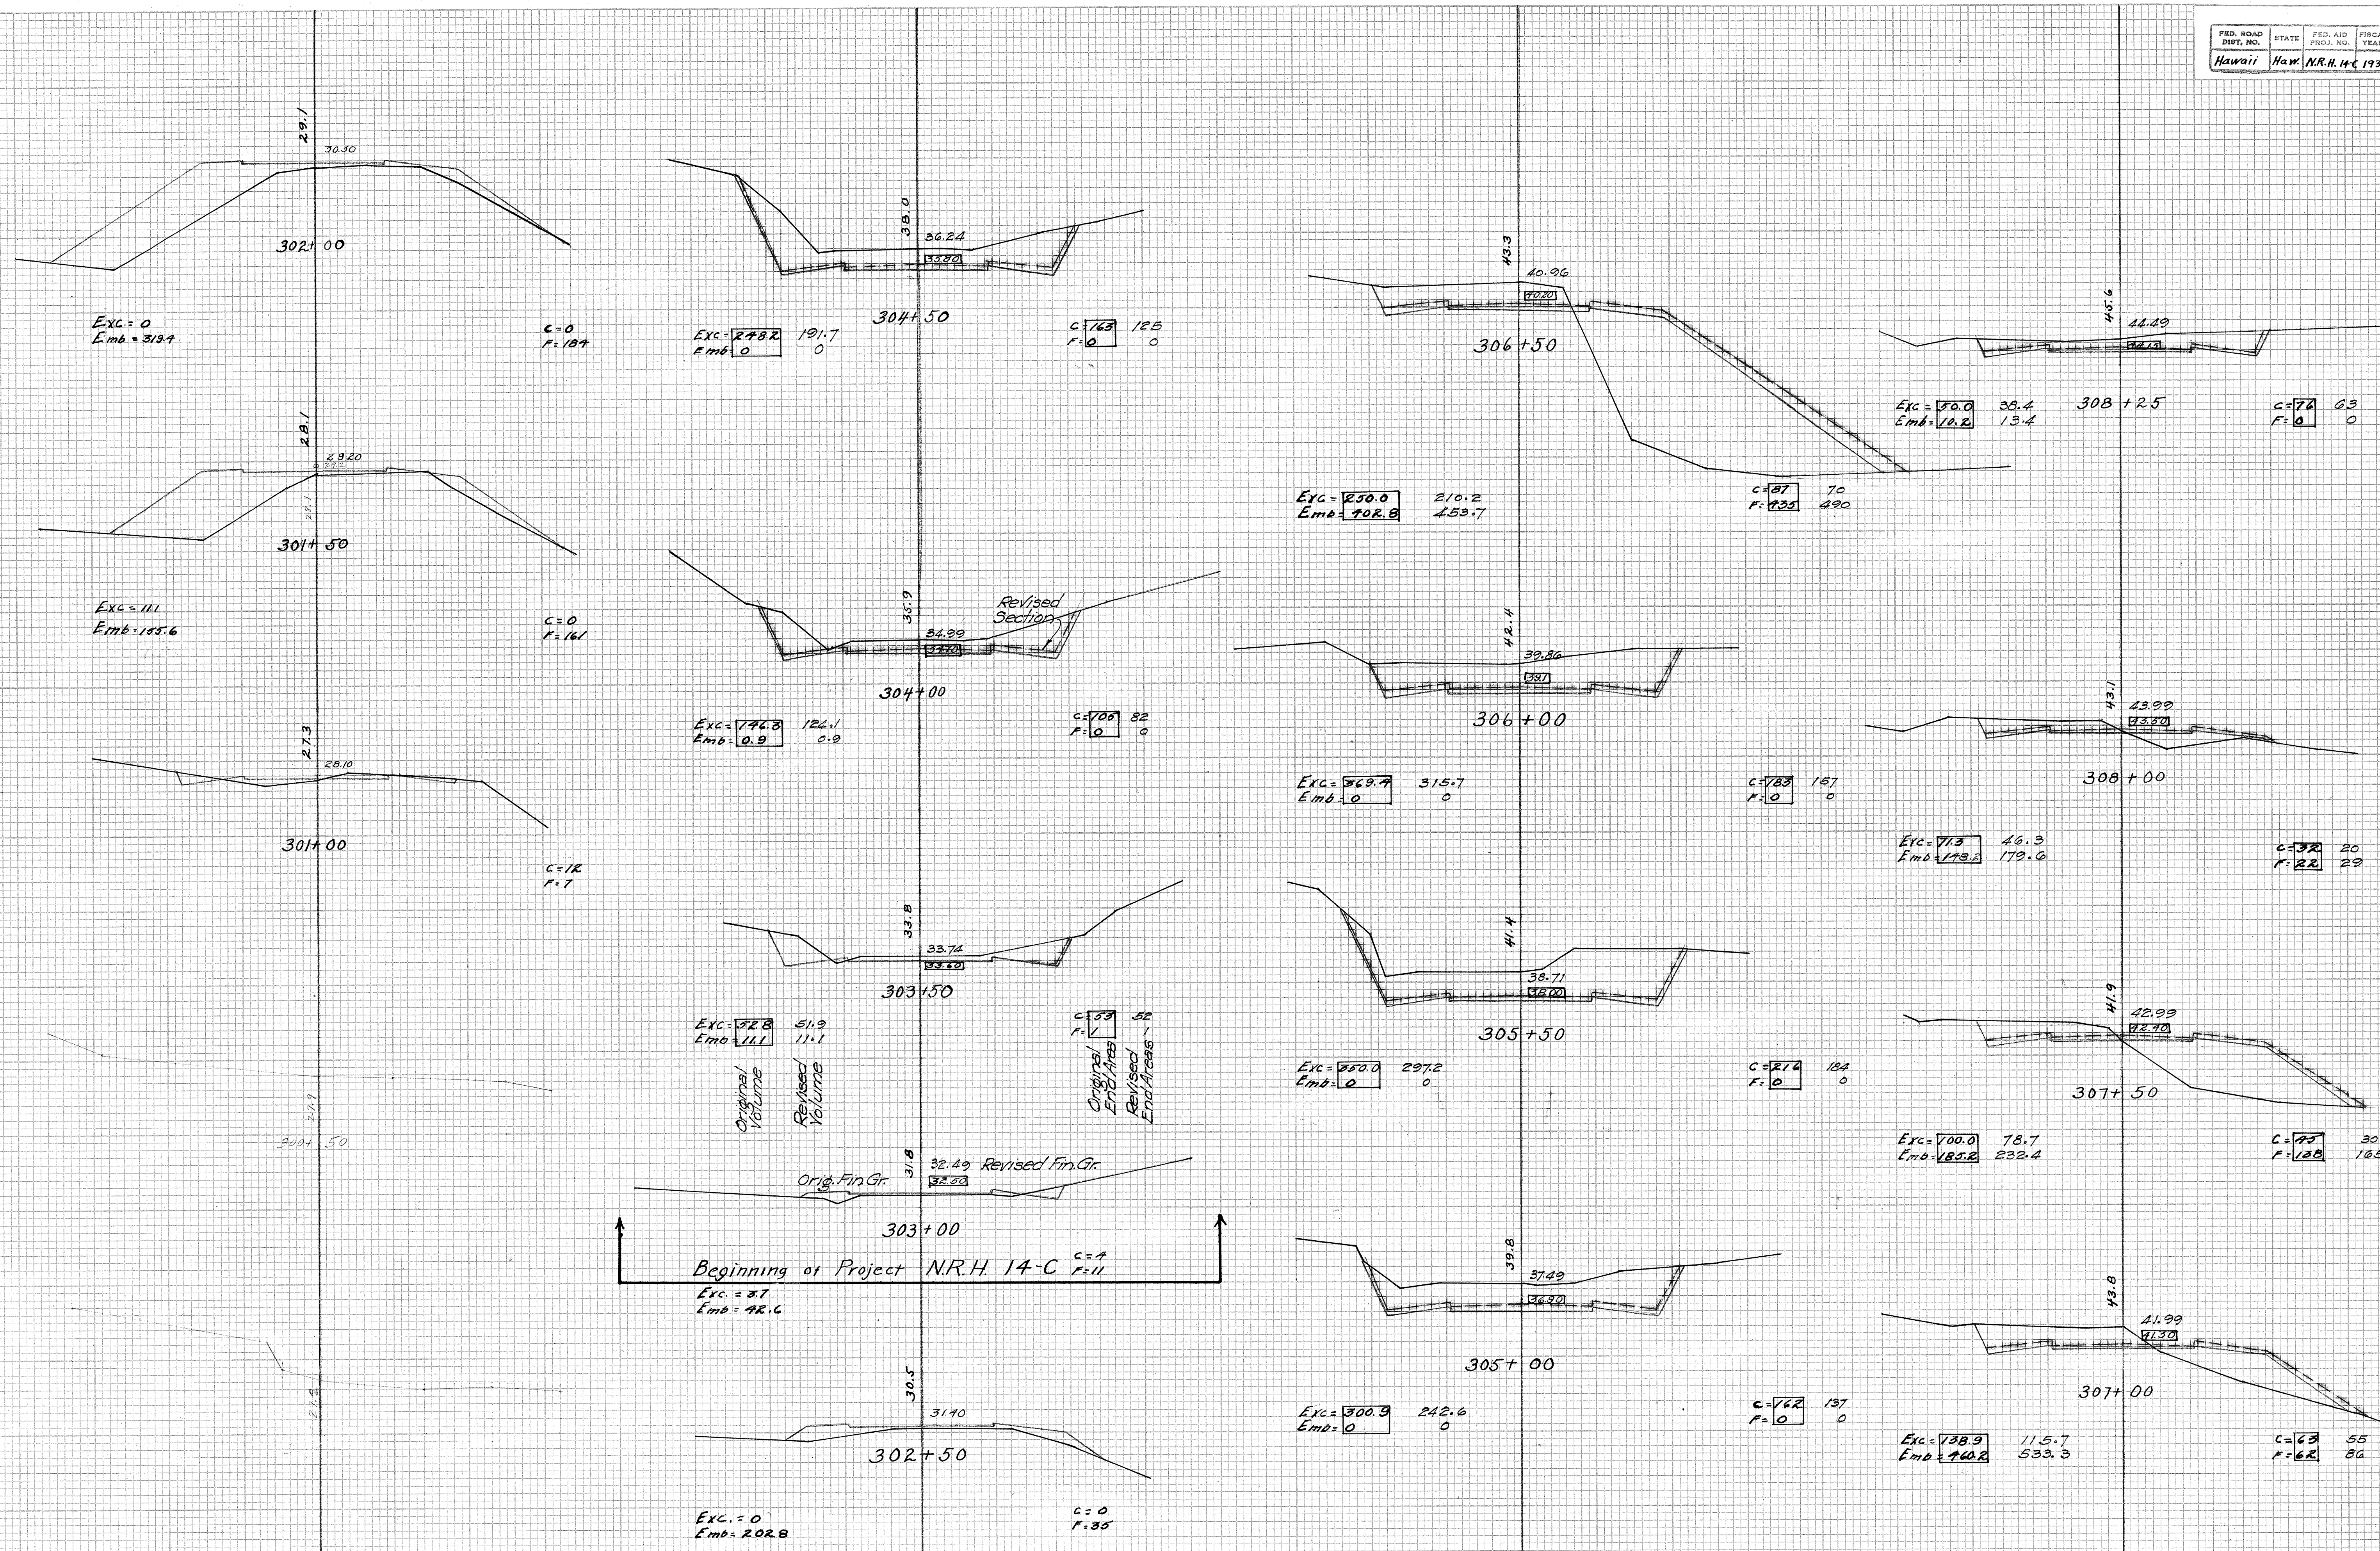


REVISIONS		DATE		BY	
1	ORIGINAL	8-33	BY	DATE	BY
2	PLAN	8-33	BY	DATE	BY
3	NOTE BOOK	8-33	BY	DATE	BY
4	NOTE BOOK	8-33	BY	DATE	BY
5	NOTE BOOK	8-33	BY	DATE	BY
6	NOTE BOOK	8-33	BY	DATE	BY
7	NOTE BOOK	8-33	BY	DATE	BY
8	NOTE BOOK	8-33	BY	DATE	BY
9	NOTE BOOK	8-33	BY	DATE	BY
10	NOTE BOOK	8-33	BY	DATE	BY

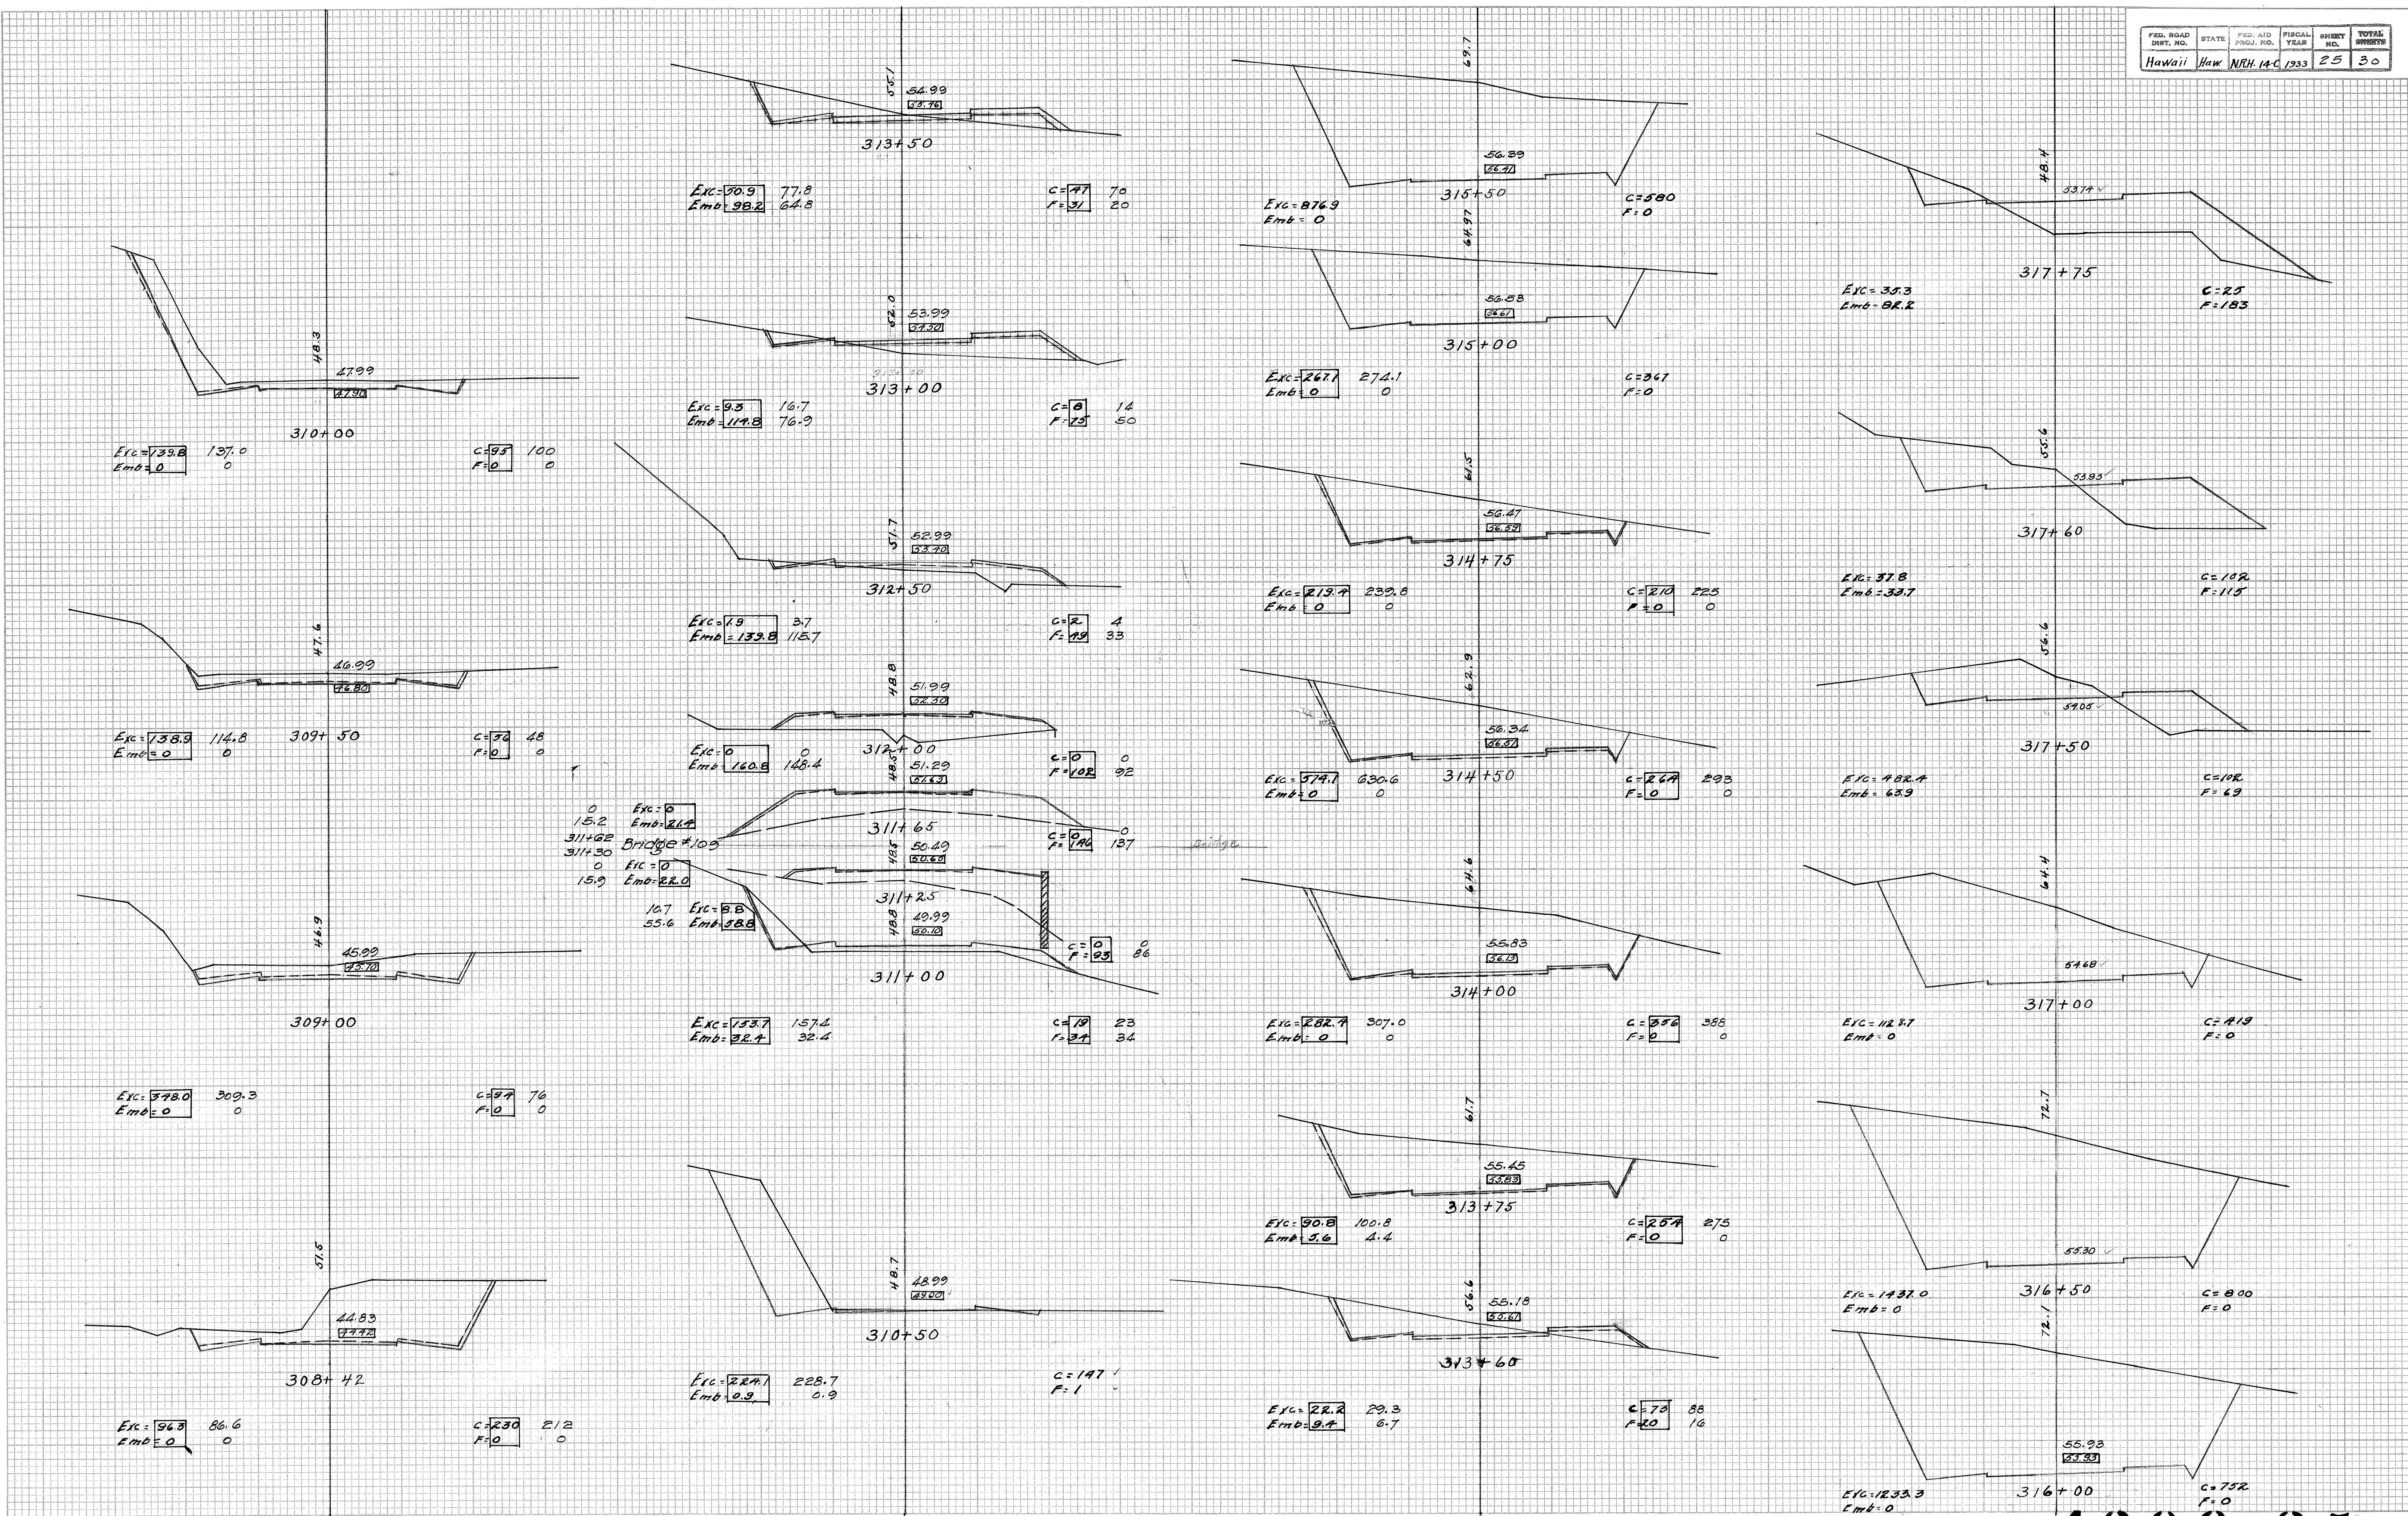

FINAL SURVEY
NO. 1
DATE 8-33
BY J. J. J.
SURVEYED BY J. J. J.
PLOTTER J. J. J.
NOTE BOOK J. J. J.
AREAS CHECKED J. J. J.

ORIGINAL SURVEY
NO. 1
DATE 8-33
BY J. J. J.
SURVEYED BY J. J. J.
PLOTTER J. J. J.
NOTE BOOK J. J. J.
AREAS CHECKED J. J. J.

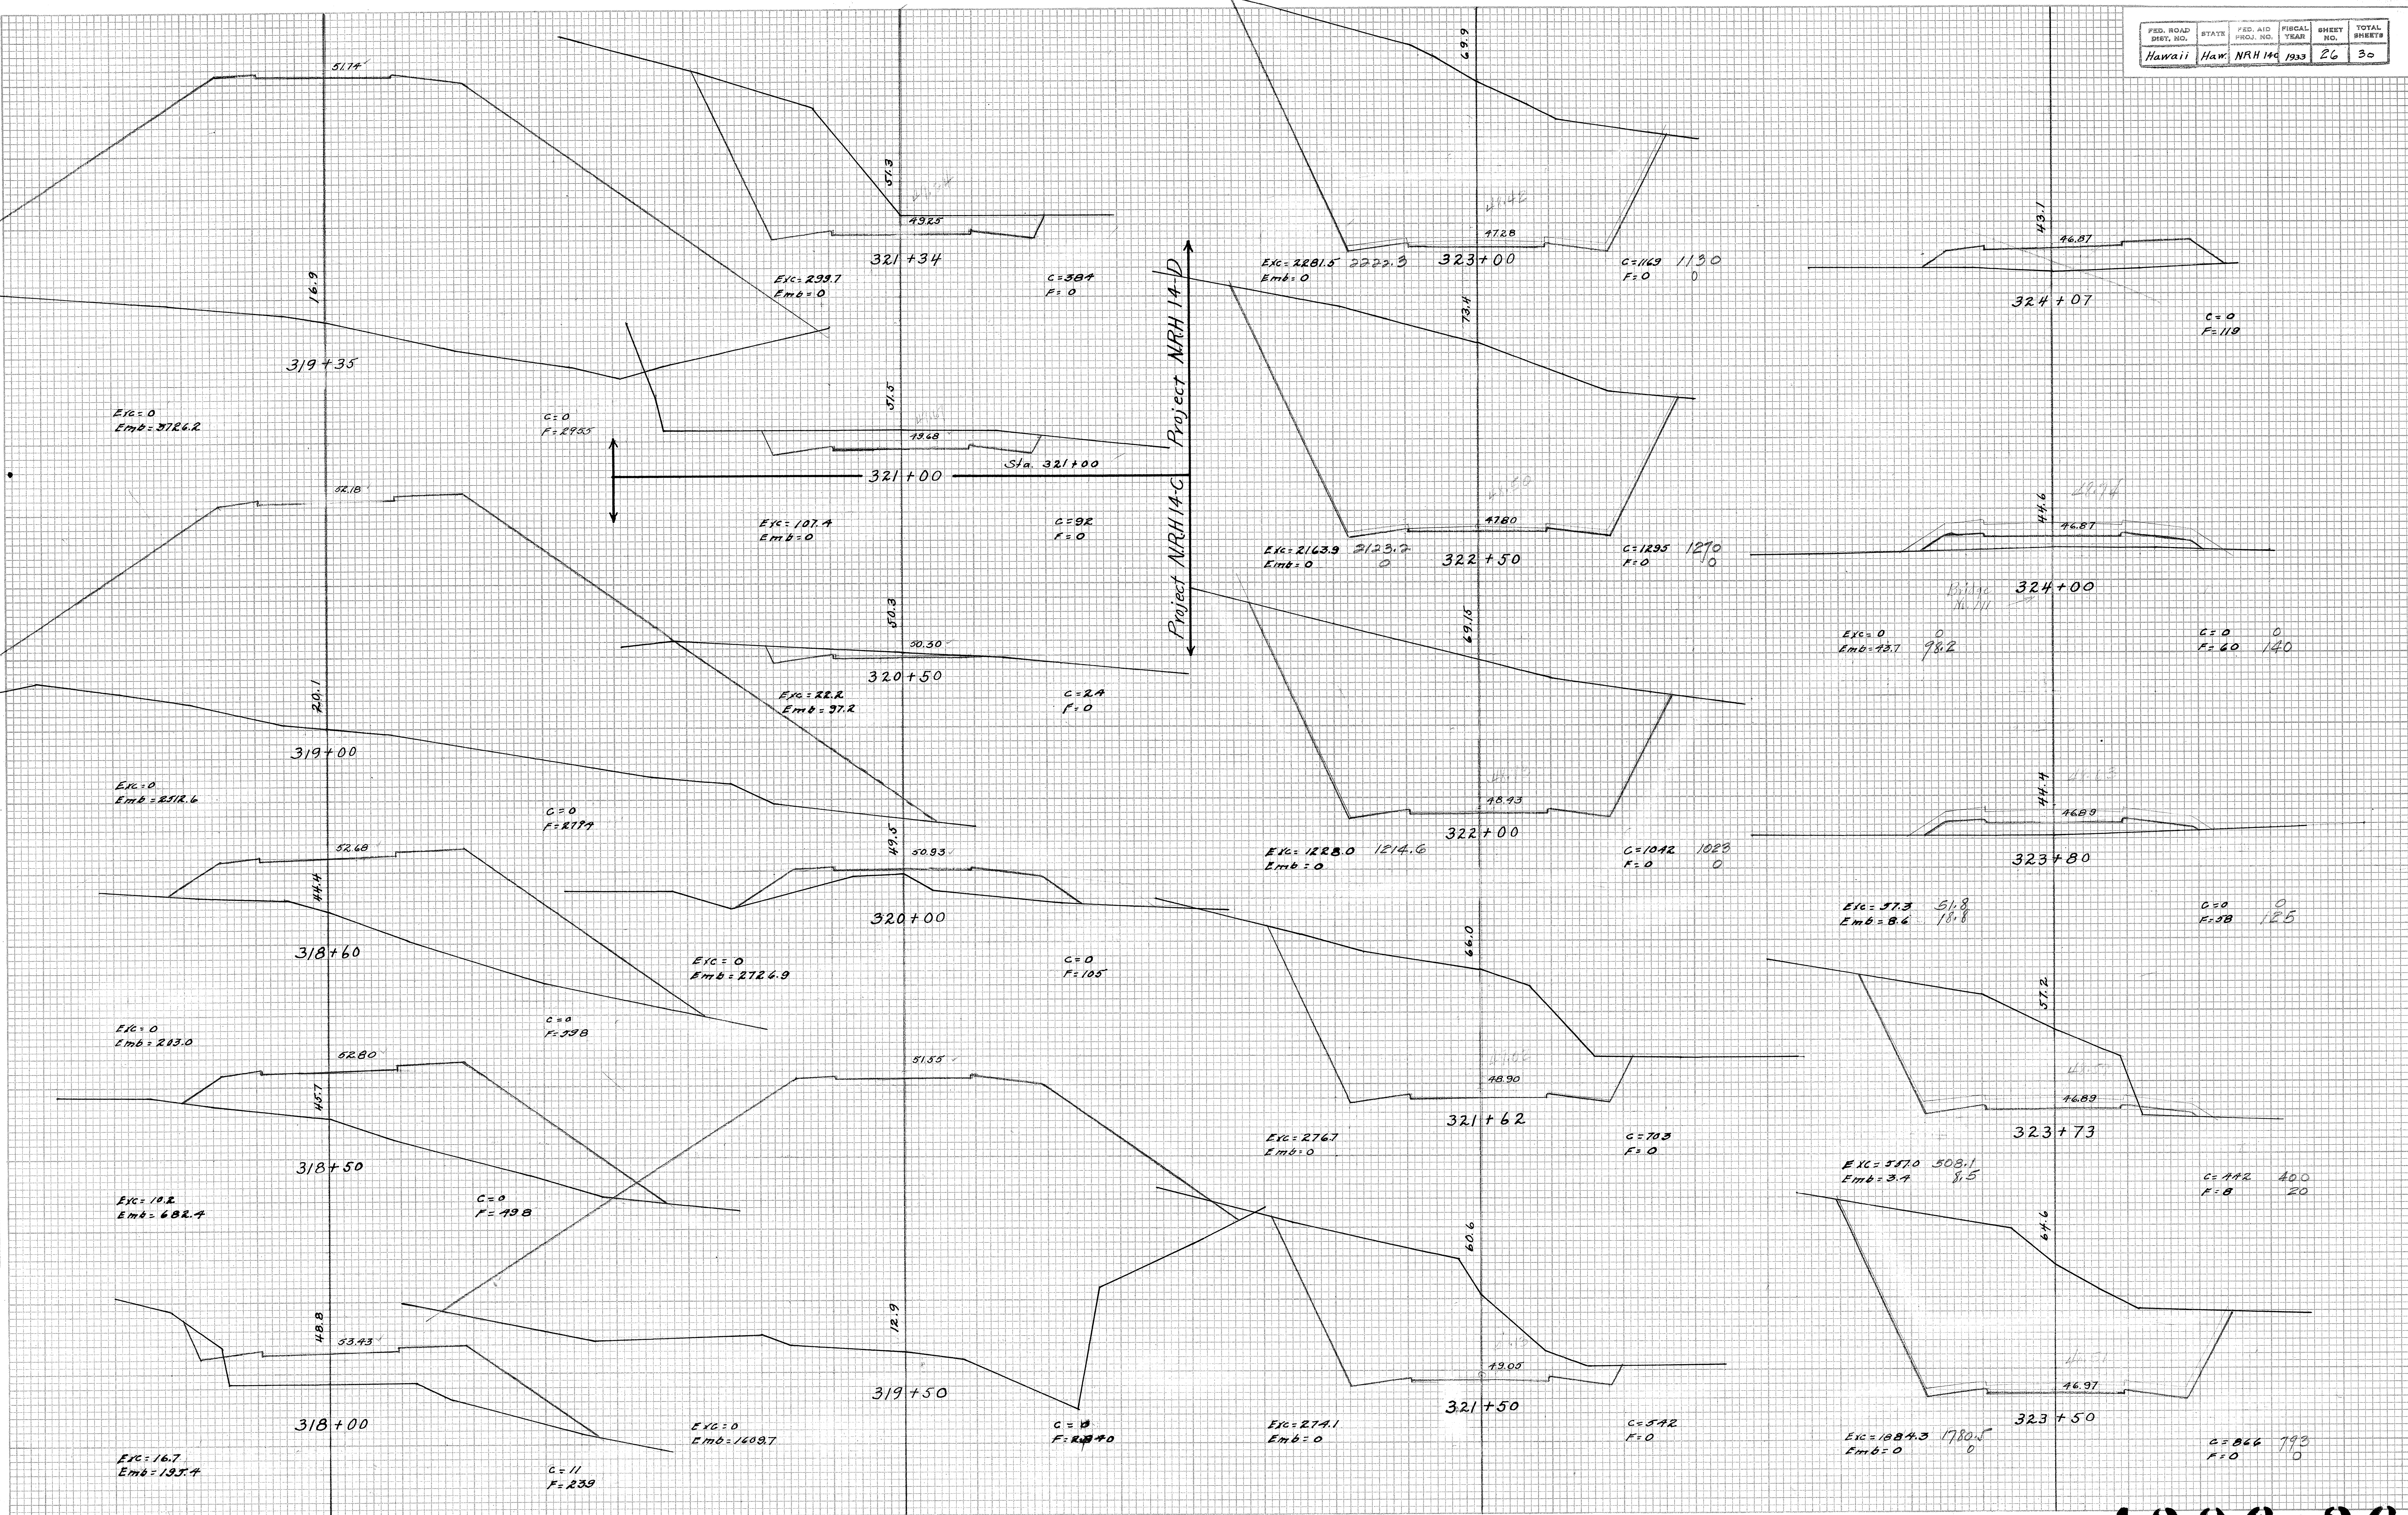

FED. ROAD DIST. NO.	STATE	FED. AID PROJ. NO.	FISCAL YEAR	SHEET NO.	TOTAL SHEETS
Hawaii	Haw.	N.R.H. 14-C	1933	27	30

ORIGINAL	SURVEYED	DATE	SURVEYED _____ PLOTTED _____ TEMPLATE _____ NOTE BOOK _____ AREAS CHECKED _____	DATE _____ OF _____
SURVEY	BY	FINAL		
PLOTTED	<i>J.O.Y</i>	SURVEY		
TEMPLATE	<i>J.O.Y</i>	PLOTTED		
NOTE BOOK	<i>J.W.</i>	TEMPLATE		
AREAS CHECKED	<i>W.</i>	<i>10-33</i>	NO.	AREAS CHECKED
		<i>8-33</i>		
		<i>8-33</i>		
		<i>8-33</i>		
		<i>10-33</i>		

REVISED

CONTAINER: SURVEY PLOTTED BY _____ DATE _____

PLAN _____ DESIGNED BY _____


DRAWN BY *J.C.M.*

NOTE BOOK _____


TEACED BY _____

CHECKED BY *R.M.*


No. _____

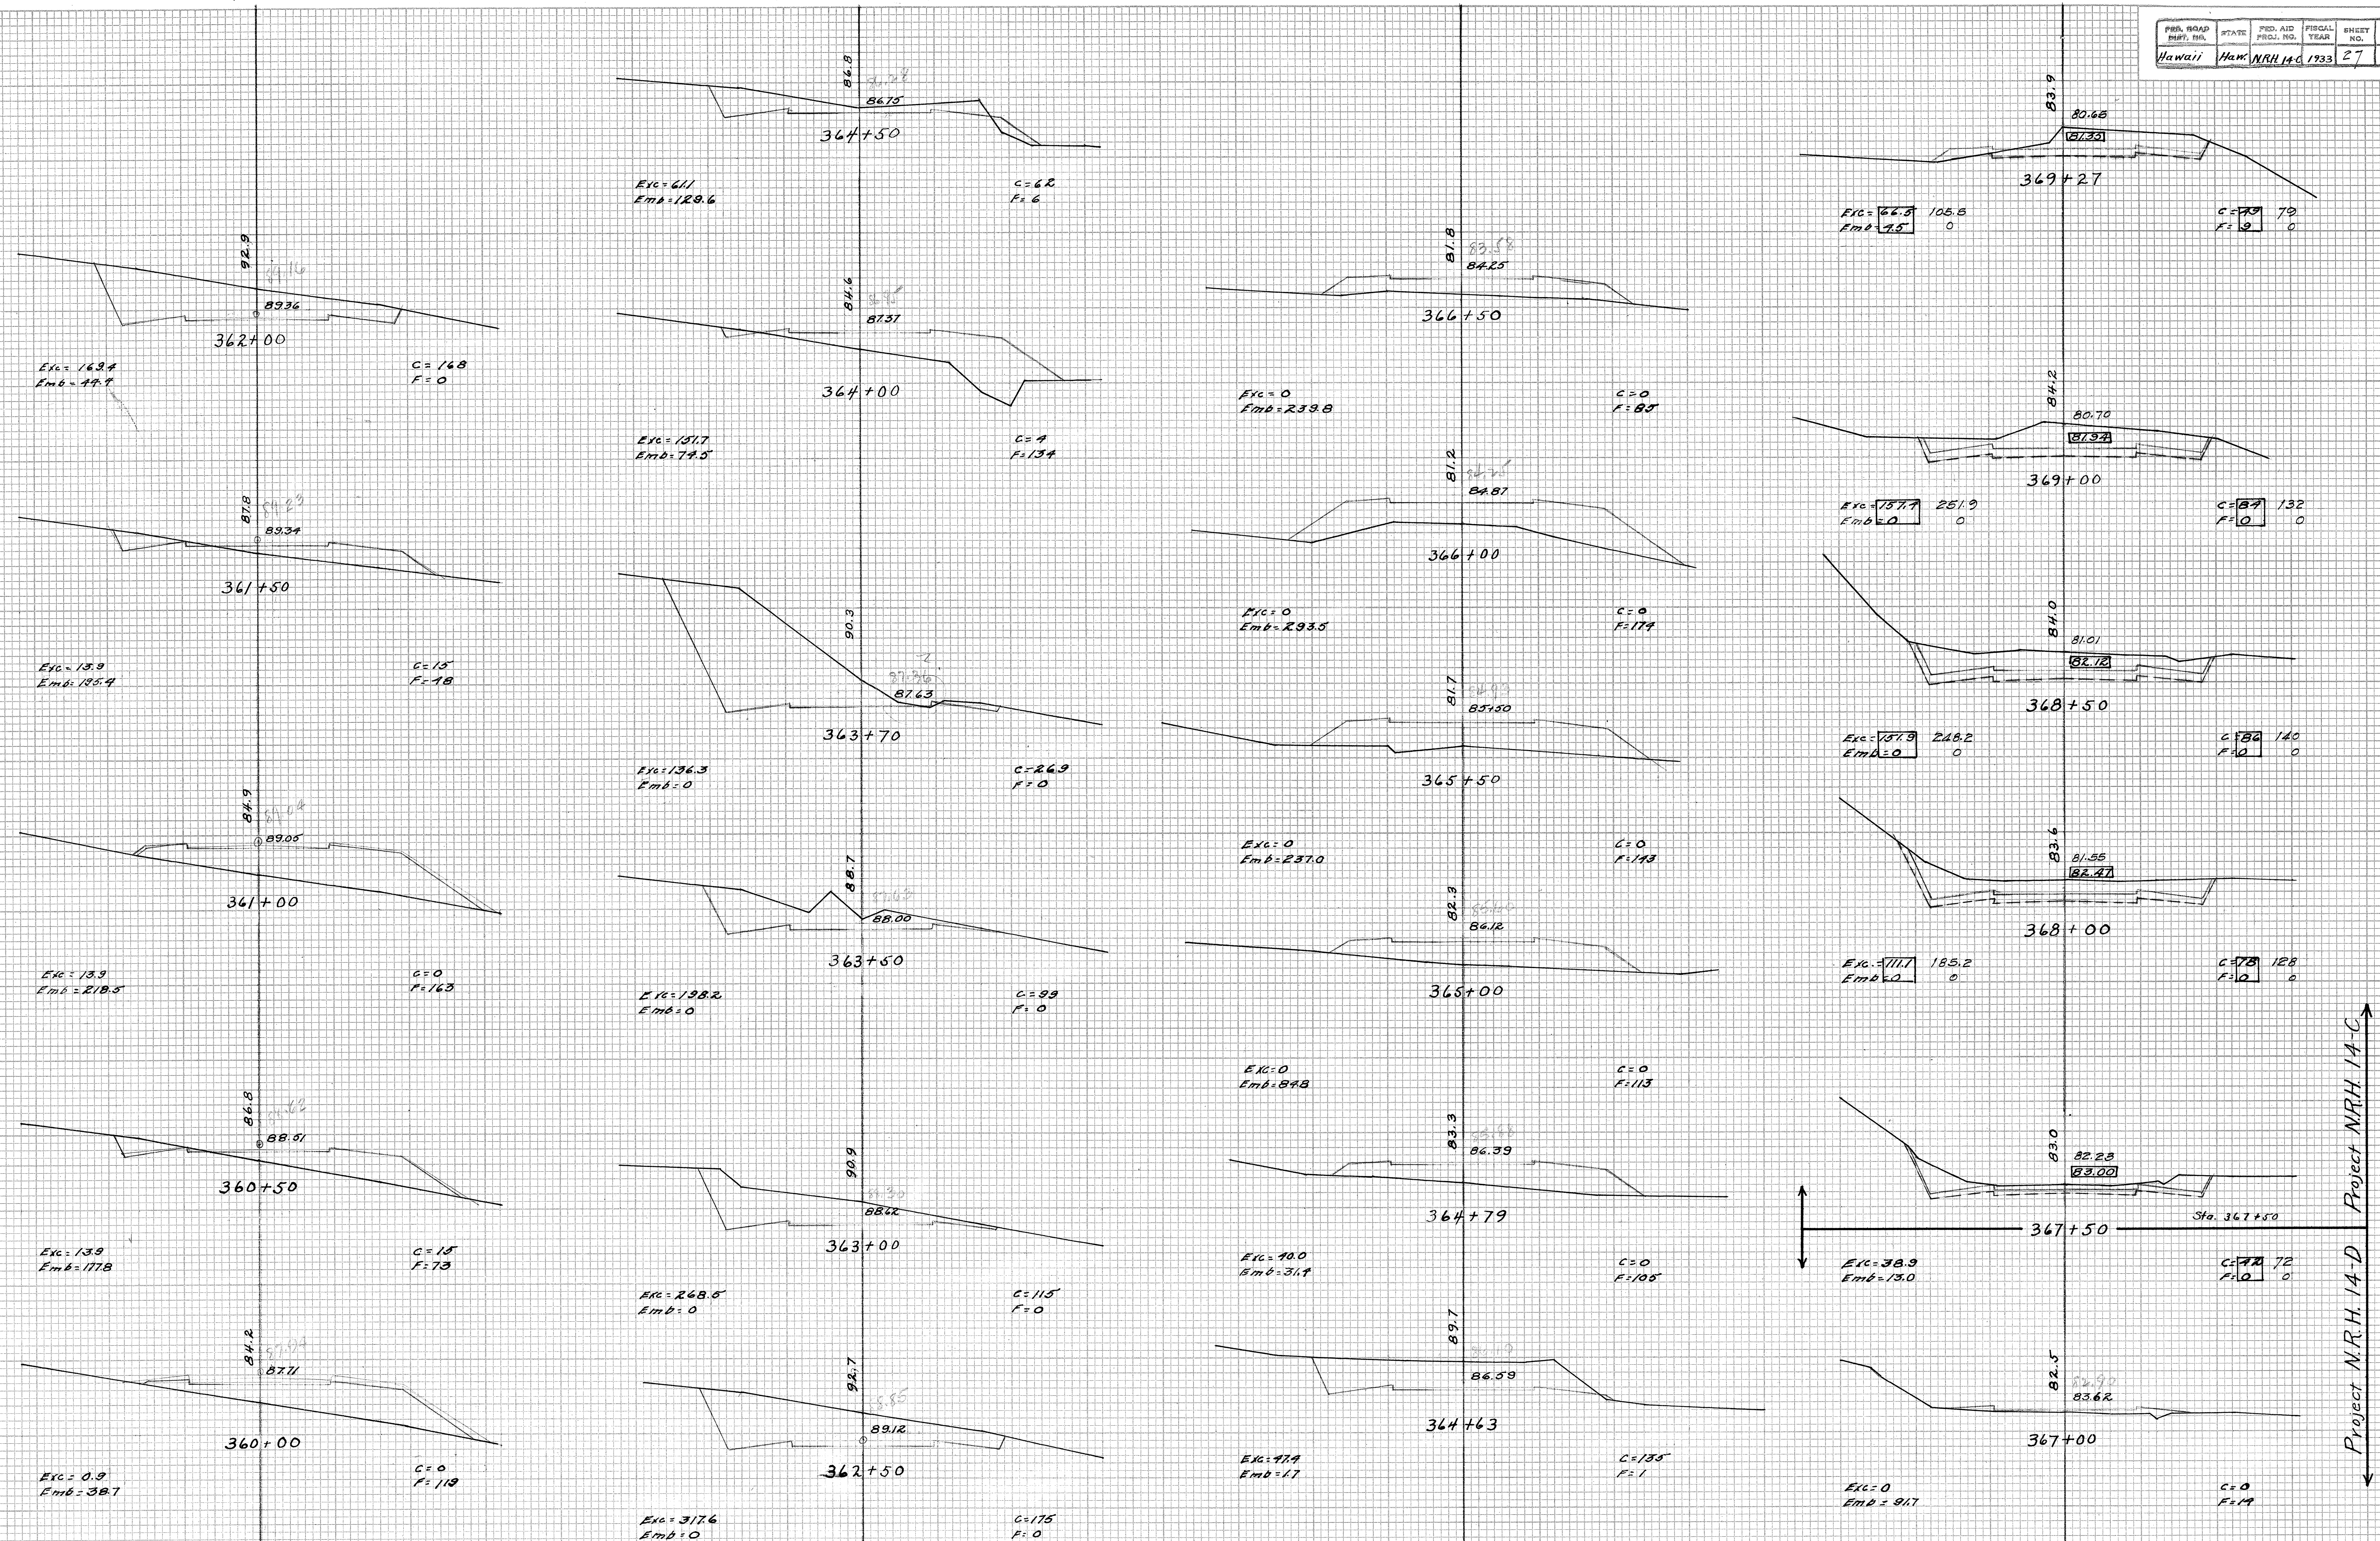


FED. ROAD DIST. NO.	STATE	FED. AID PROJ. NO.	FISCAL YEAR	SHEET NO.	TOTAL SHEETS
Hawaii	Haw.	N.R.H. 14-C	1933	28	30

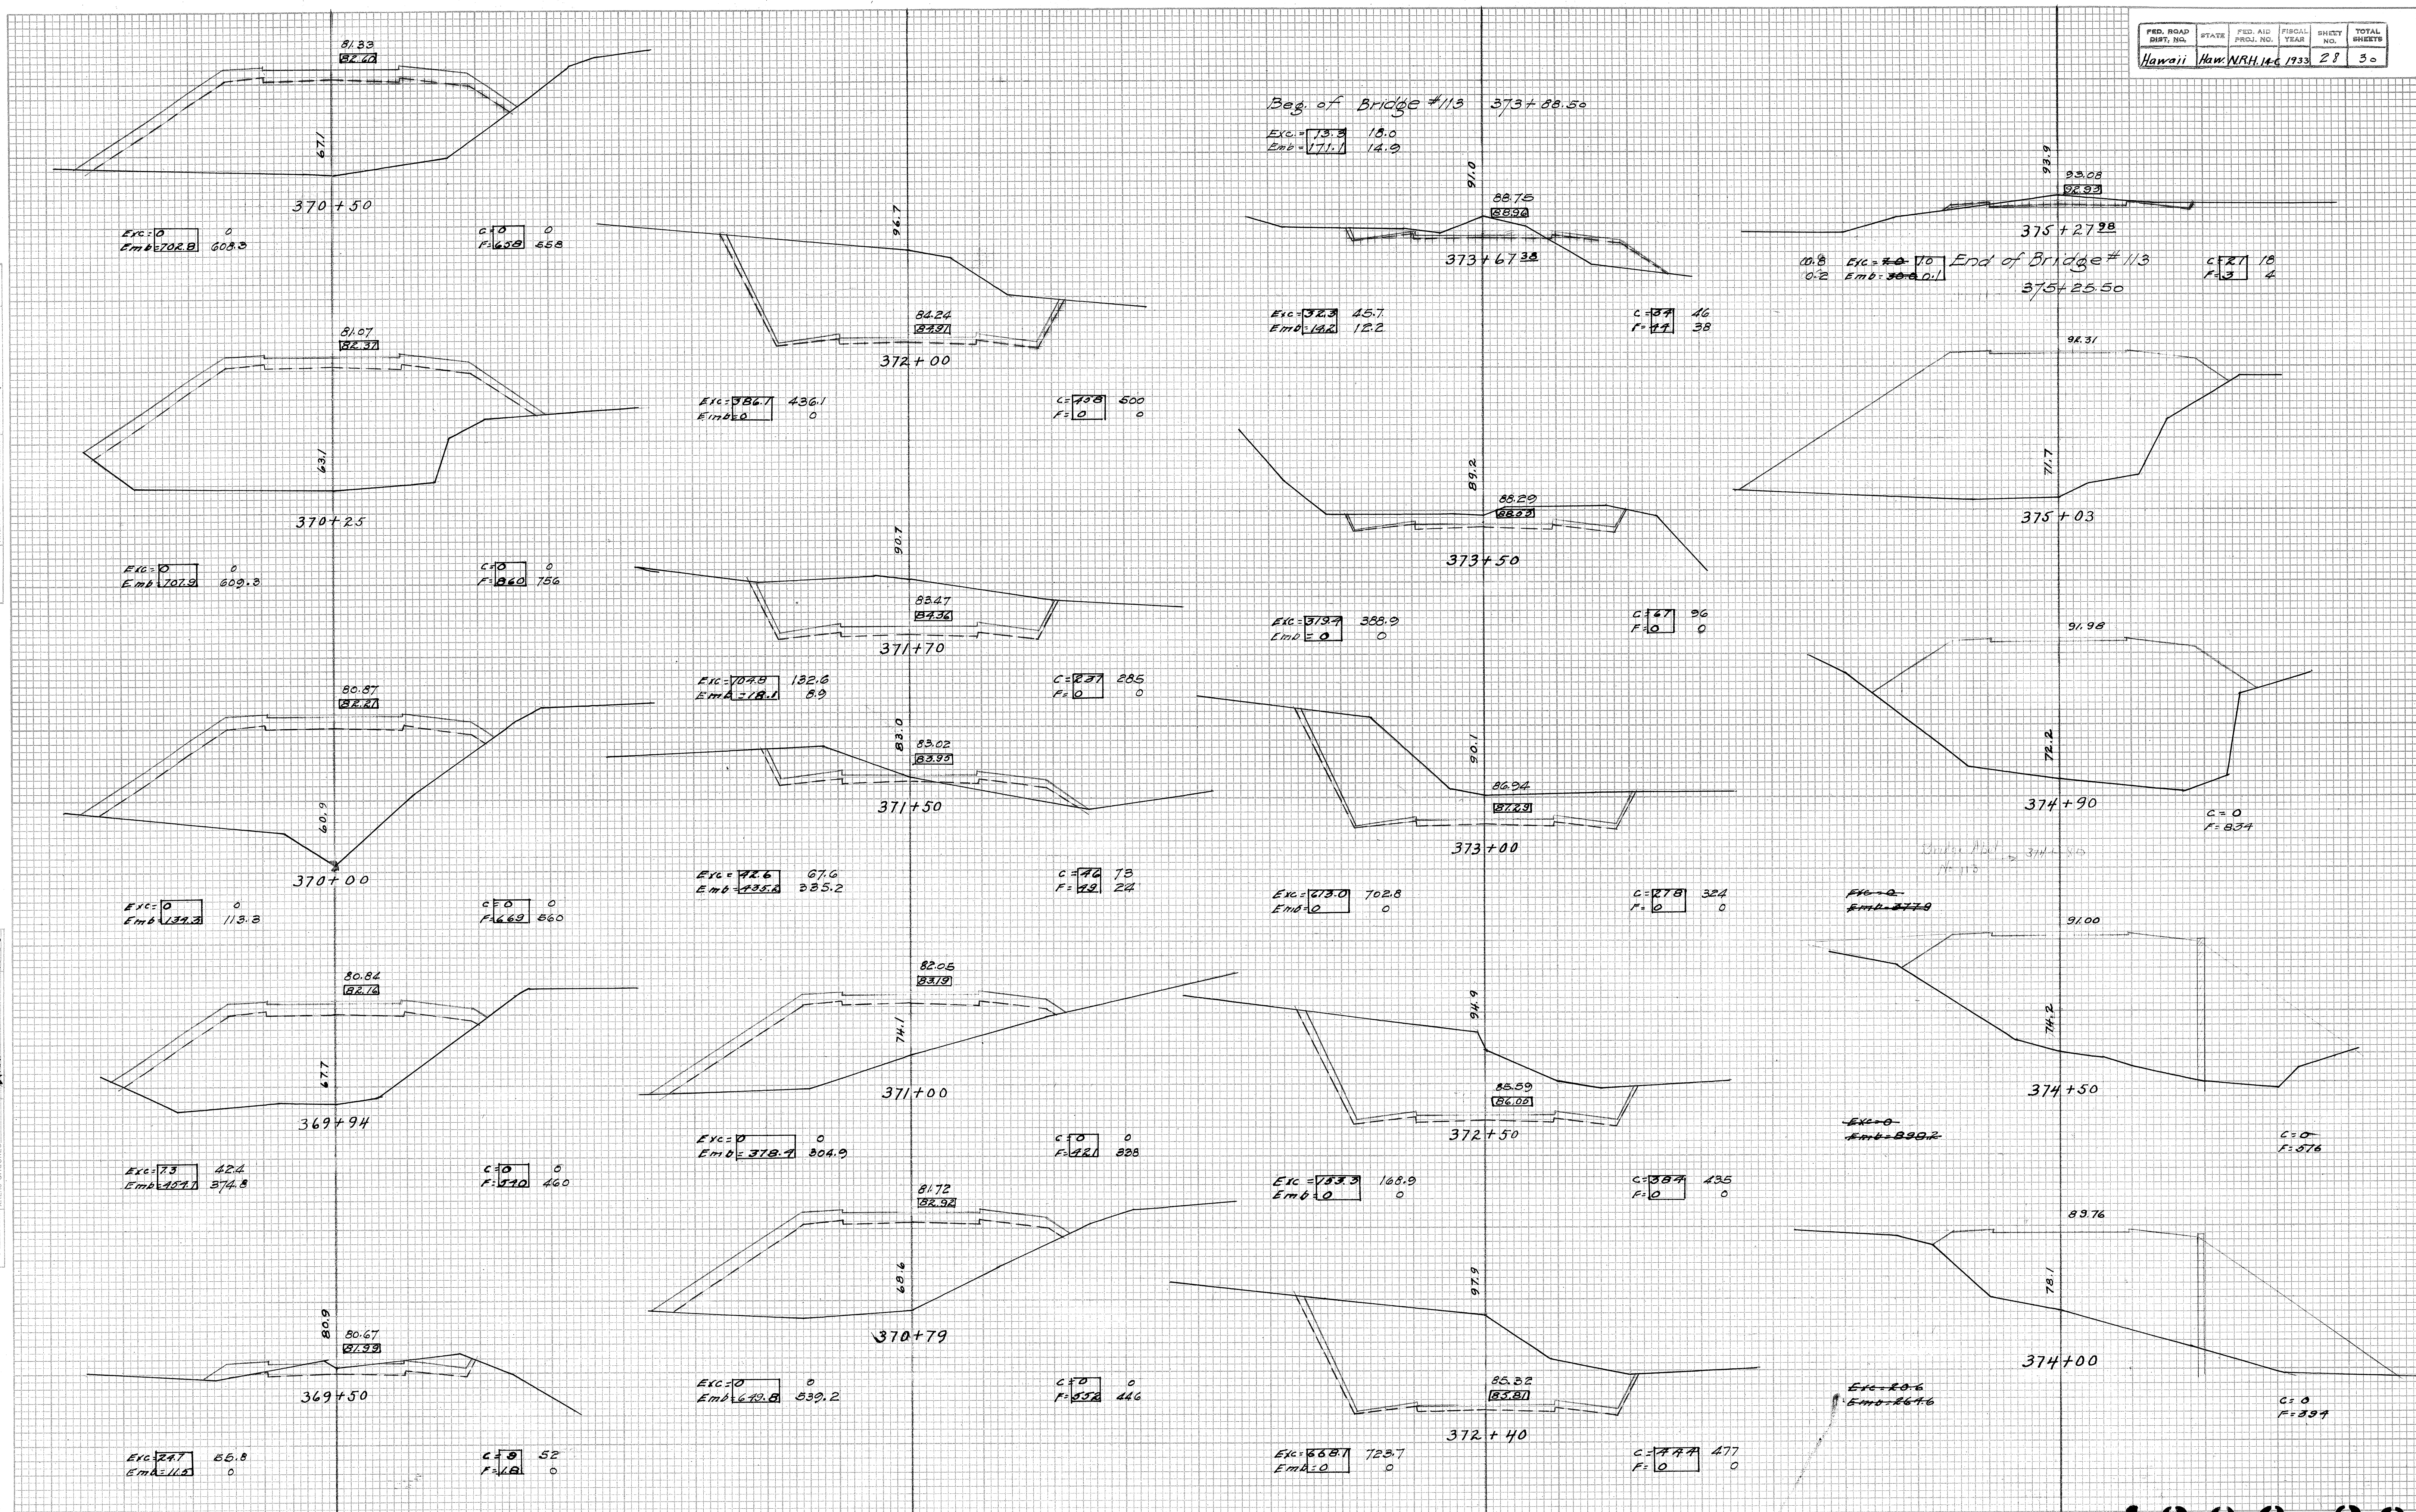

FED. ROAD DIST. NO.	STATE	FED. AID PROJ. NO.	FISCAL YEAR	SHEET NO.	TOTAL SHEETS
Hawaii	Haw.	N.R.H. 14-C	1933	29	30

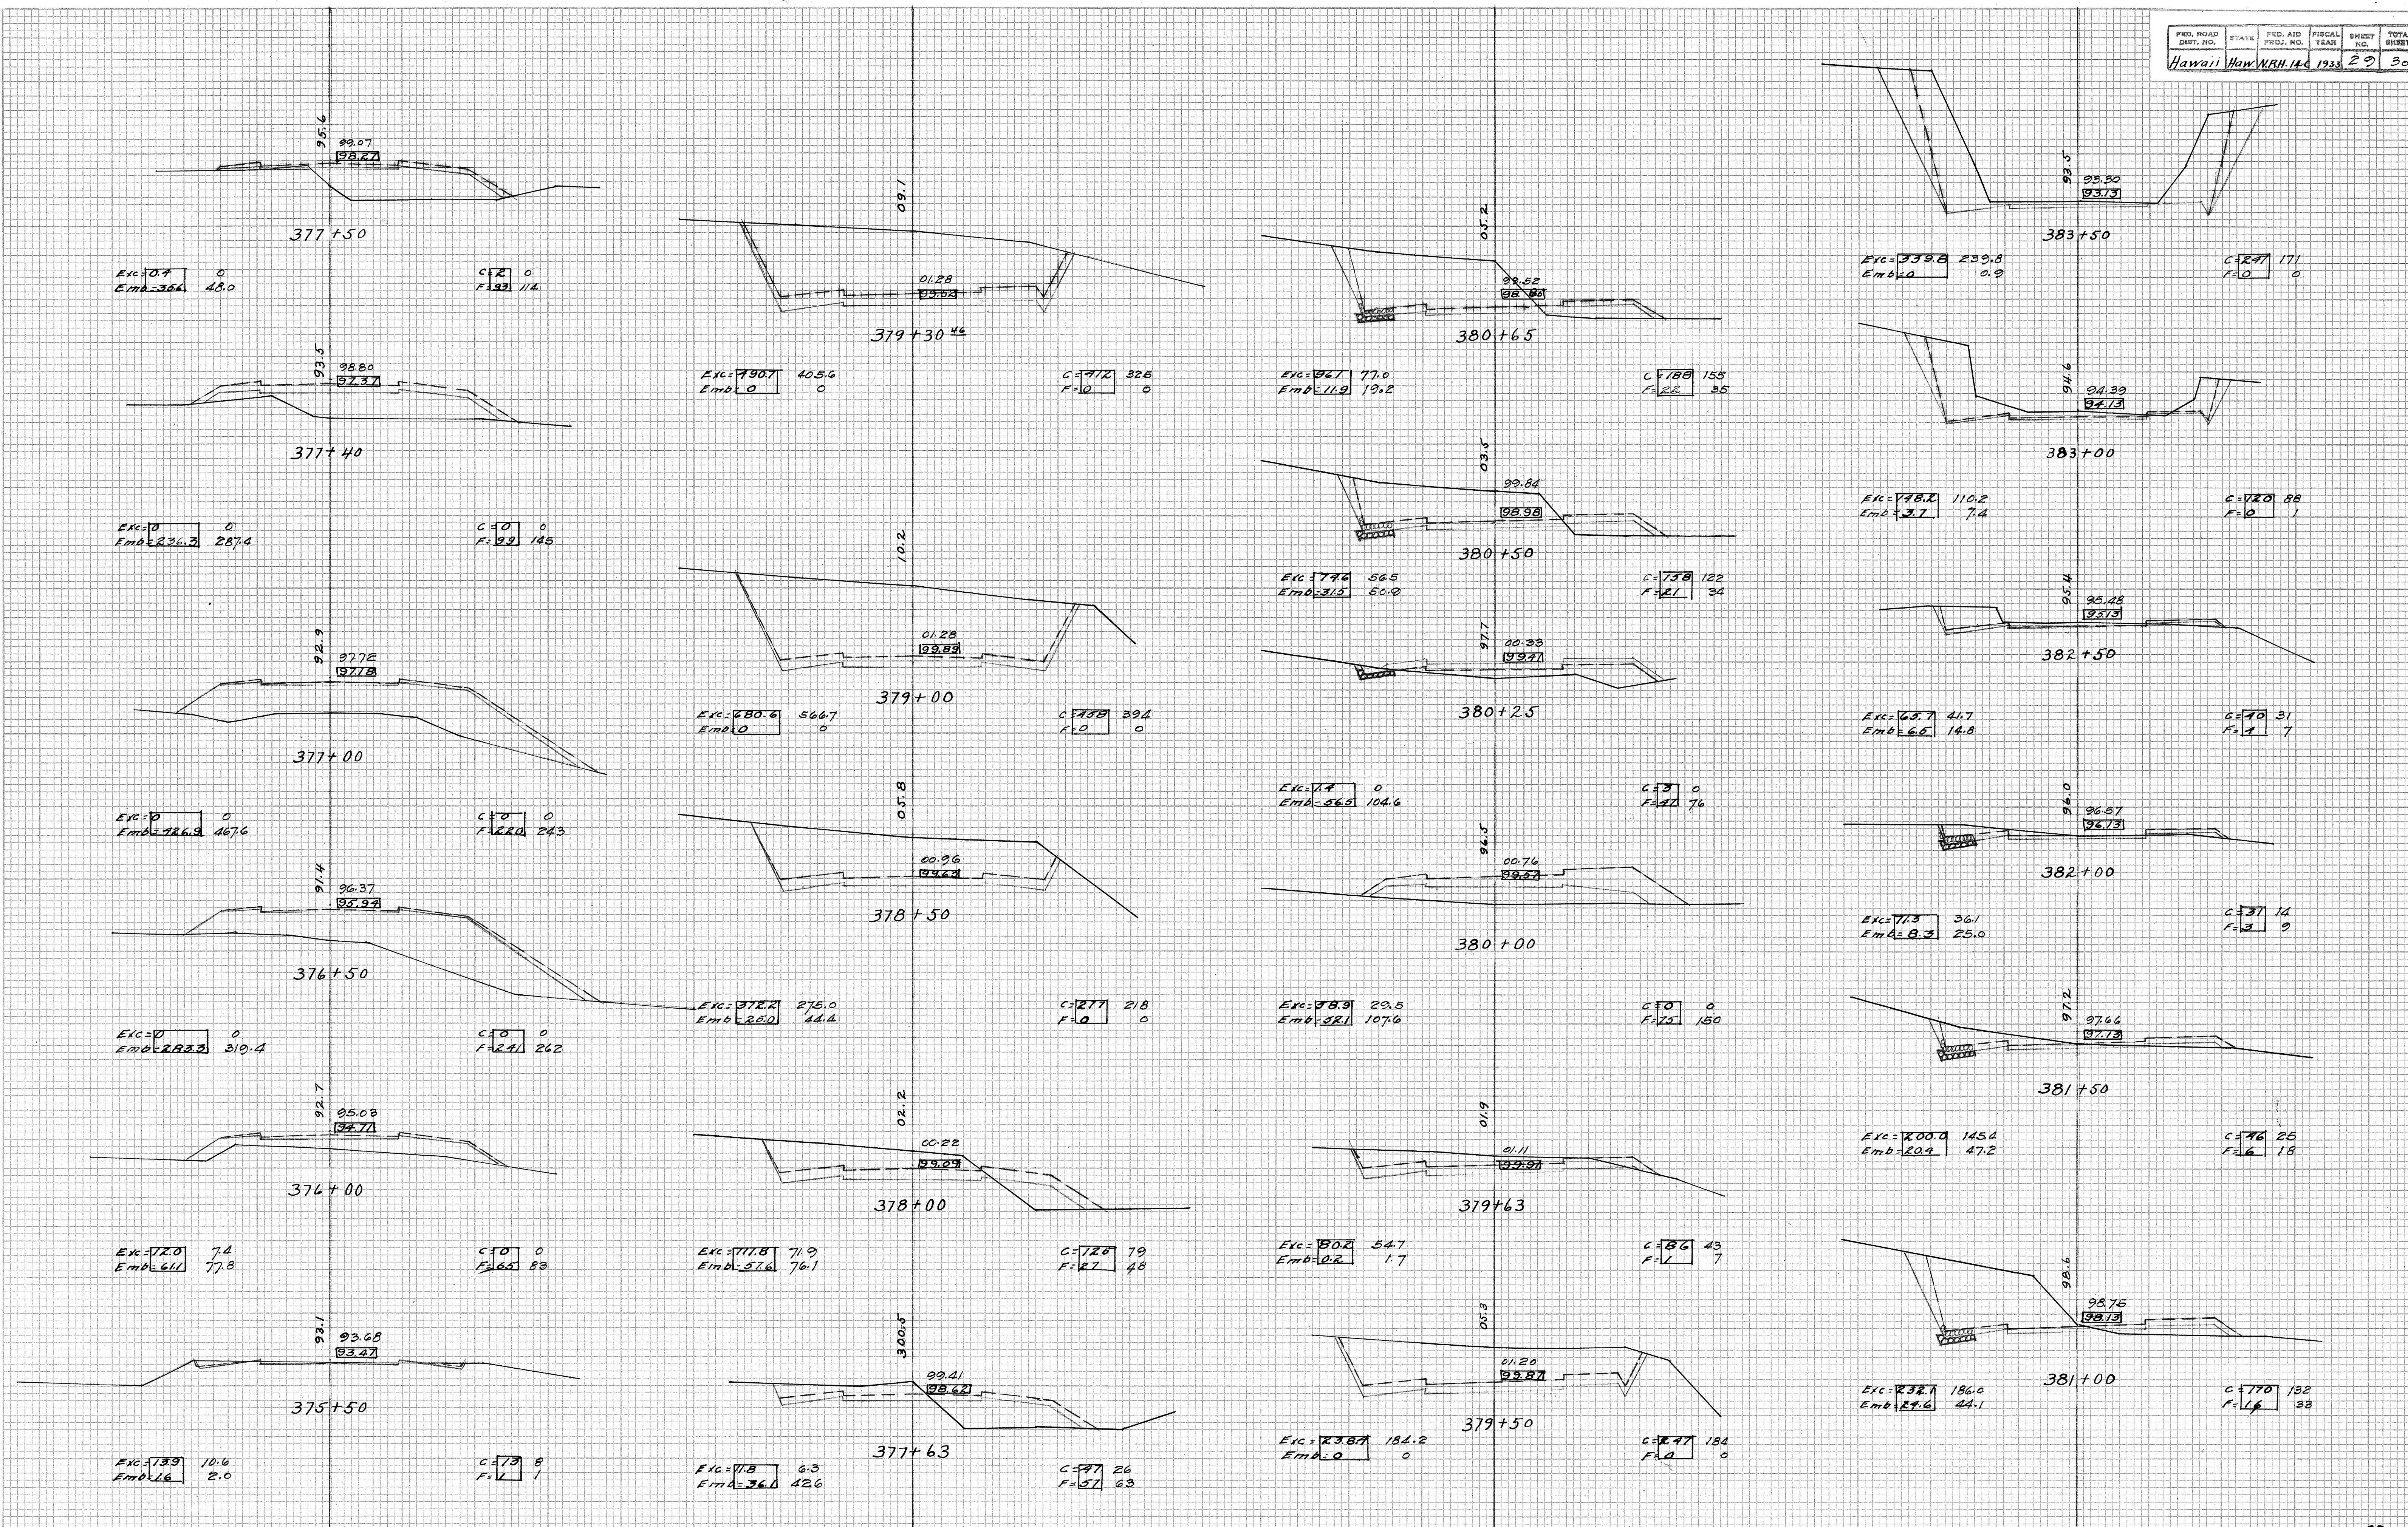


FED. ROAD DIST. NO.	STATE	FED. AID PROJ. NO.	FISCAL YEAR	SHEET NO.	TOTAL SHEETS
Hawaii	Haw.	NRH. 14-C	1933	30	30

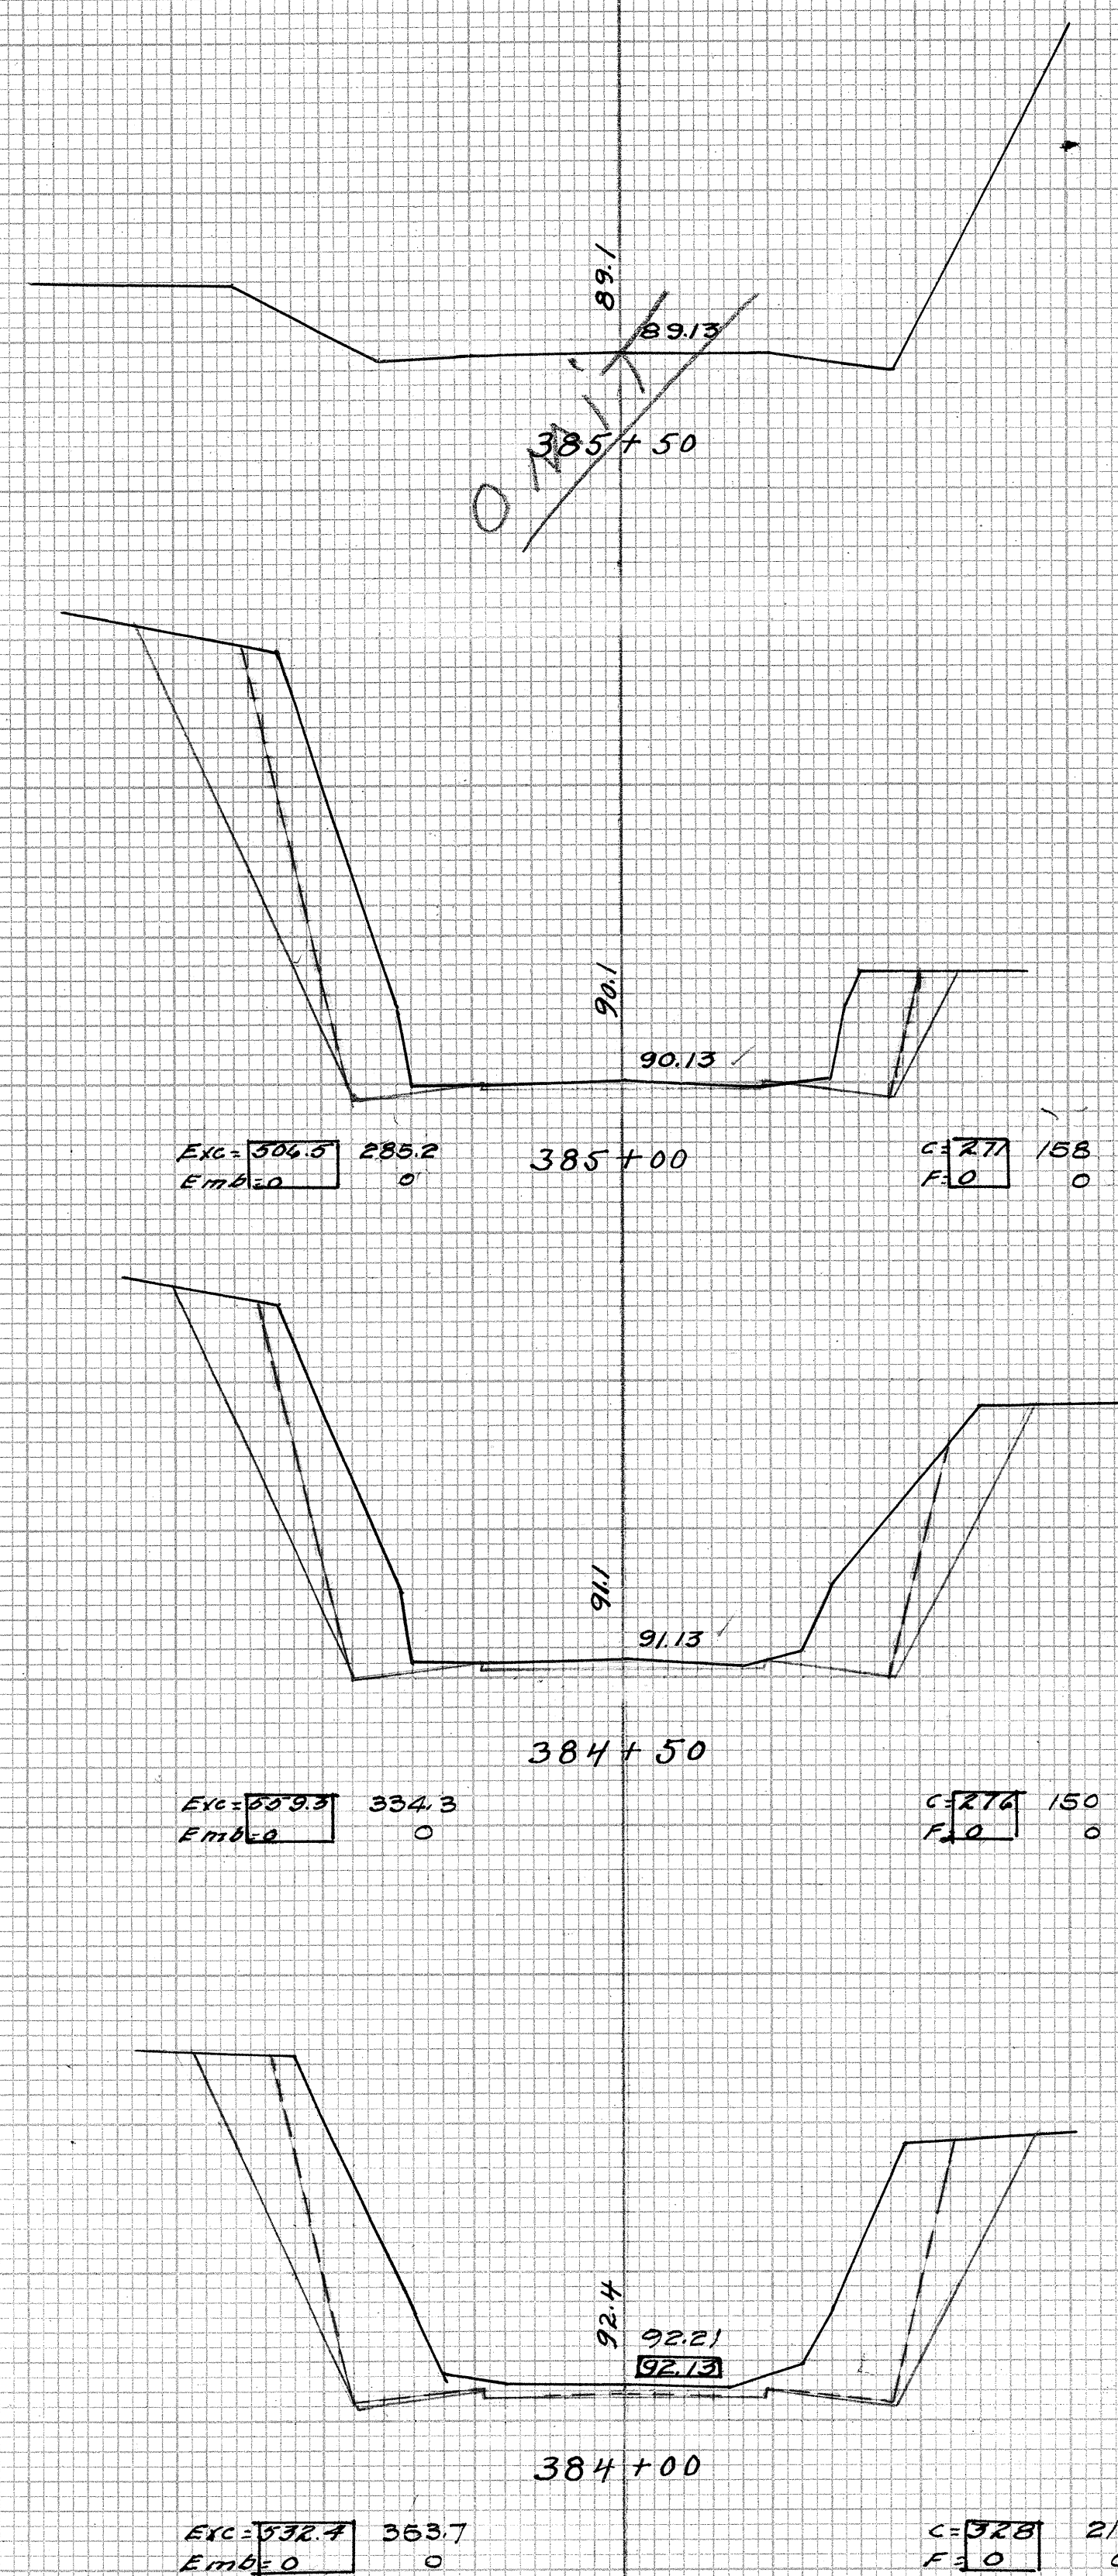[illegible]

Bridge No 114
Pohakupuka.

End of Project N.R.H. 14-C

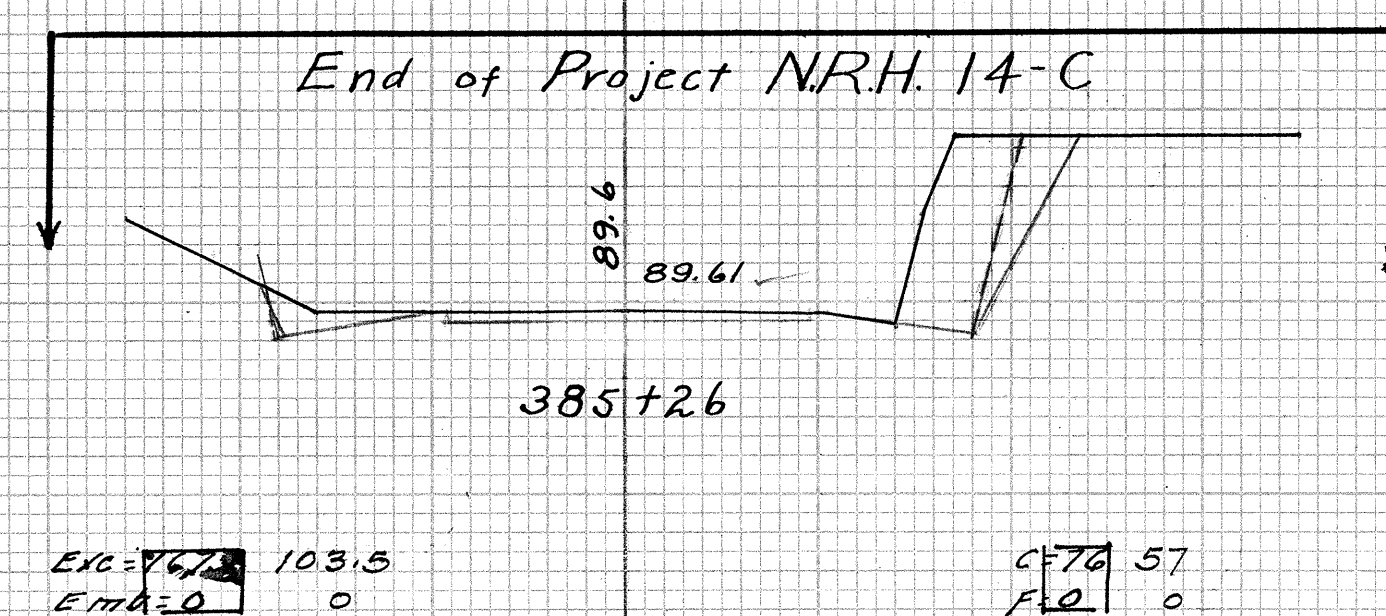

4306.30