

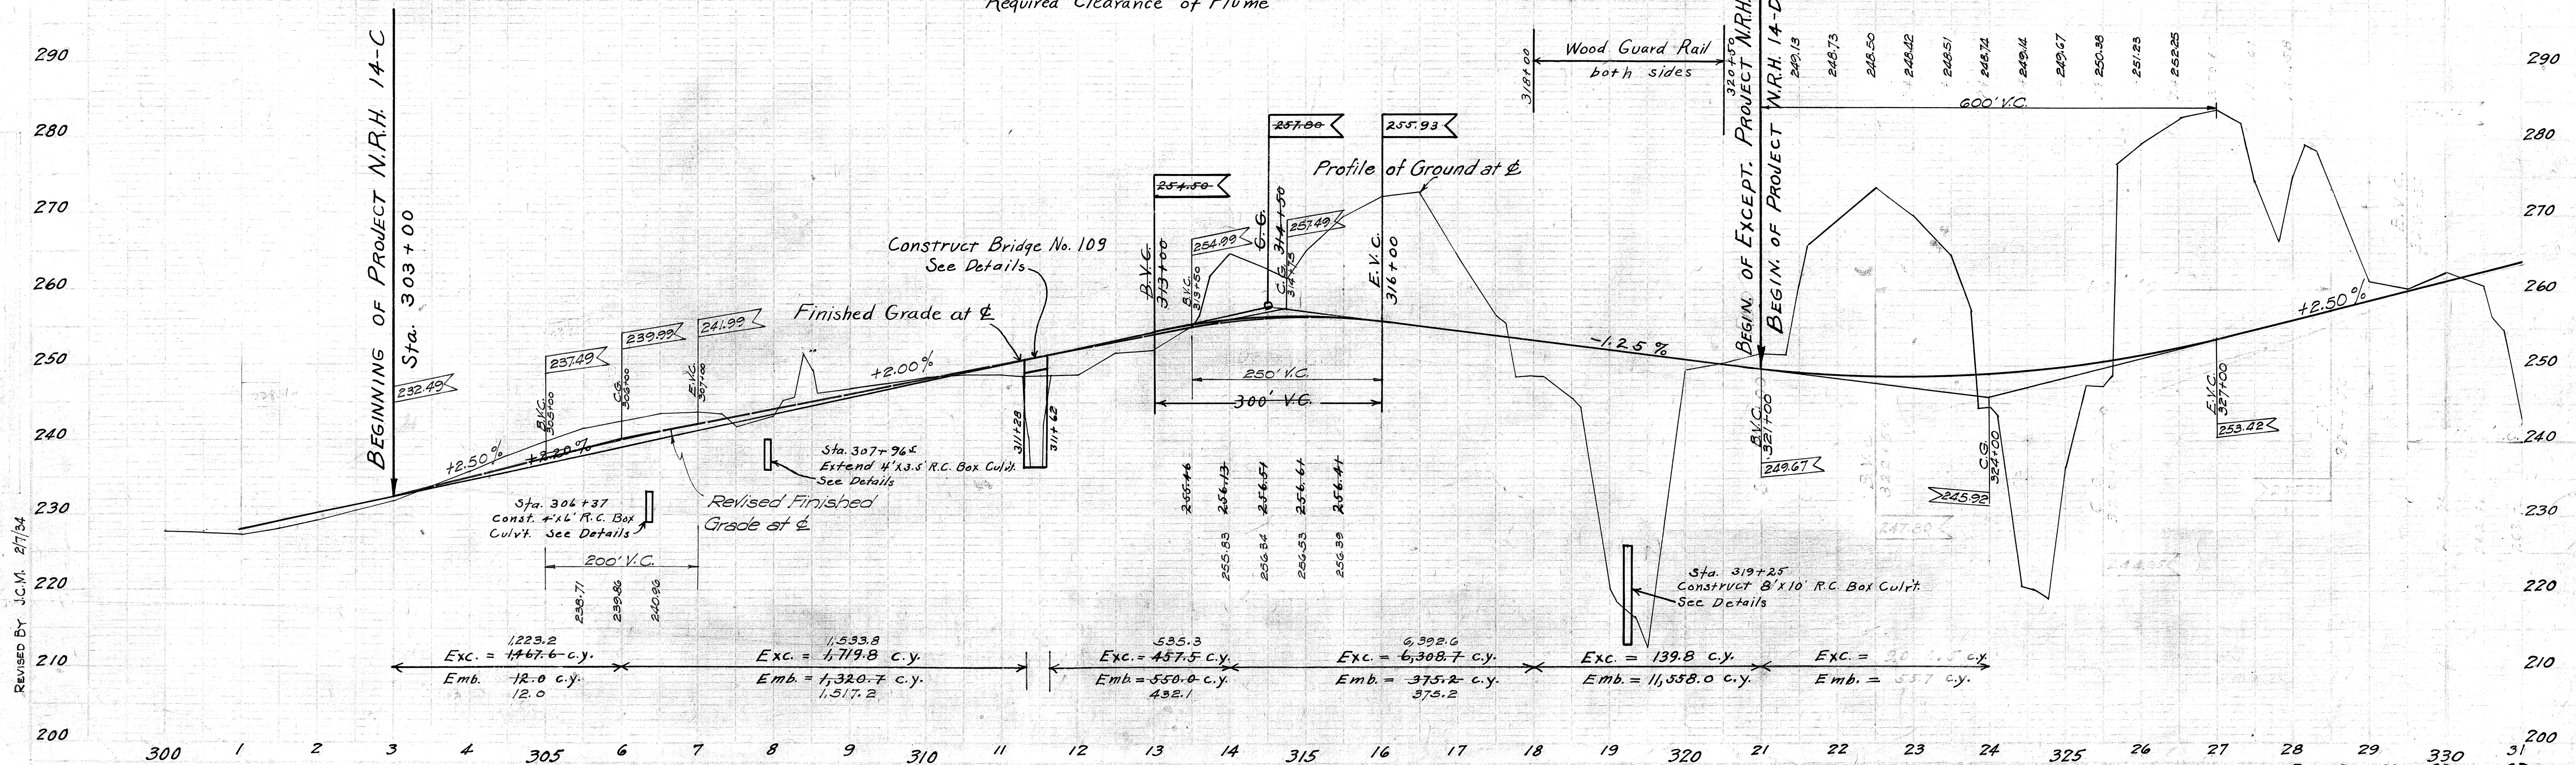
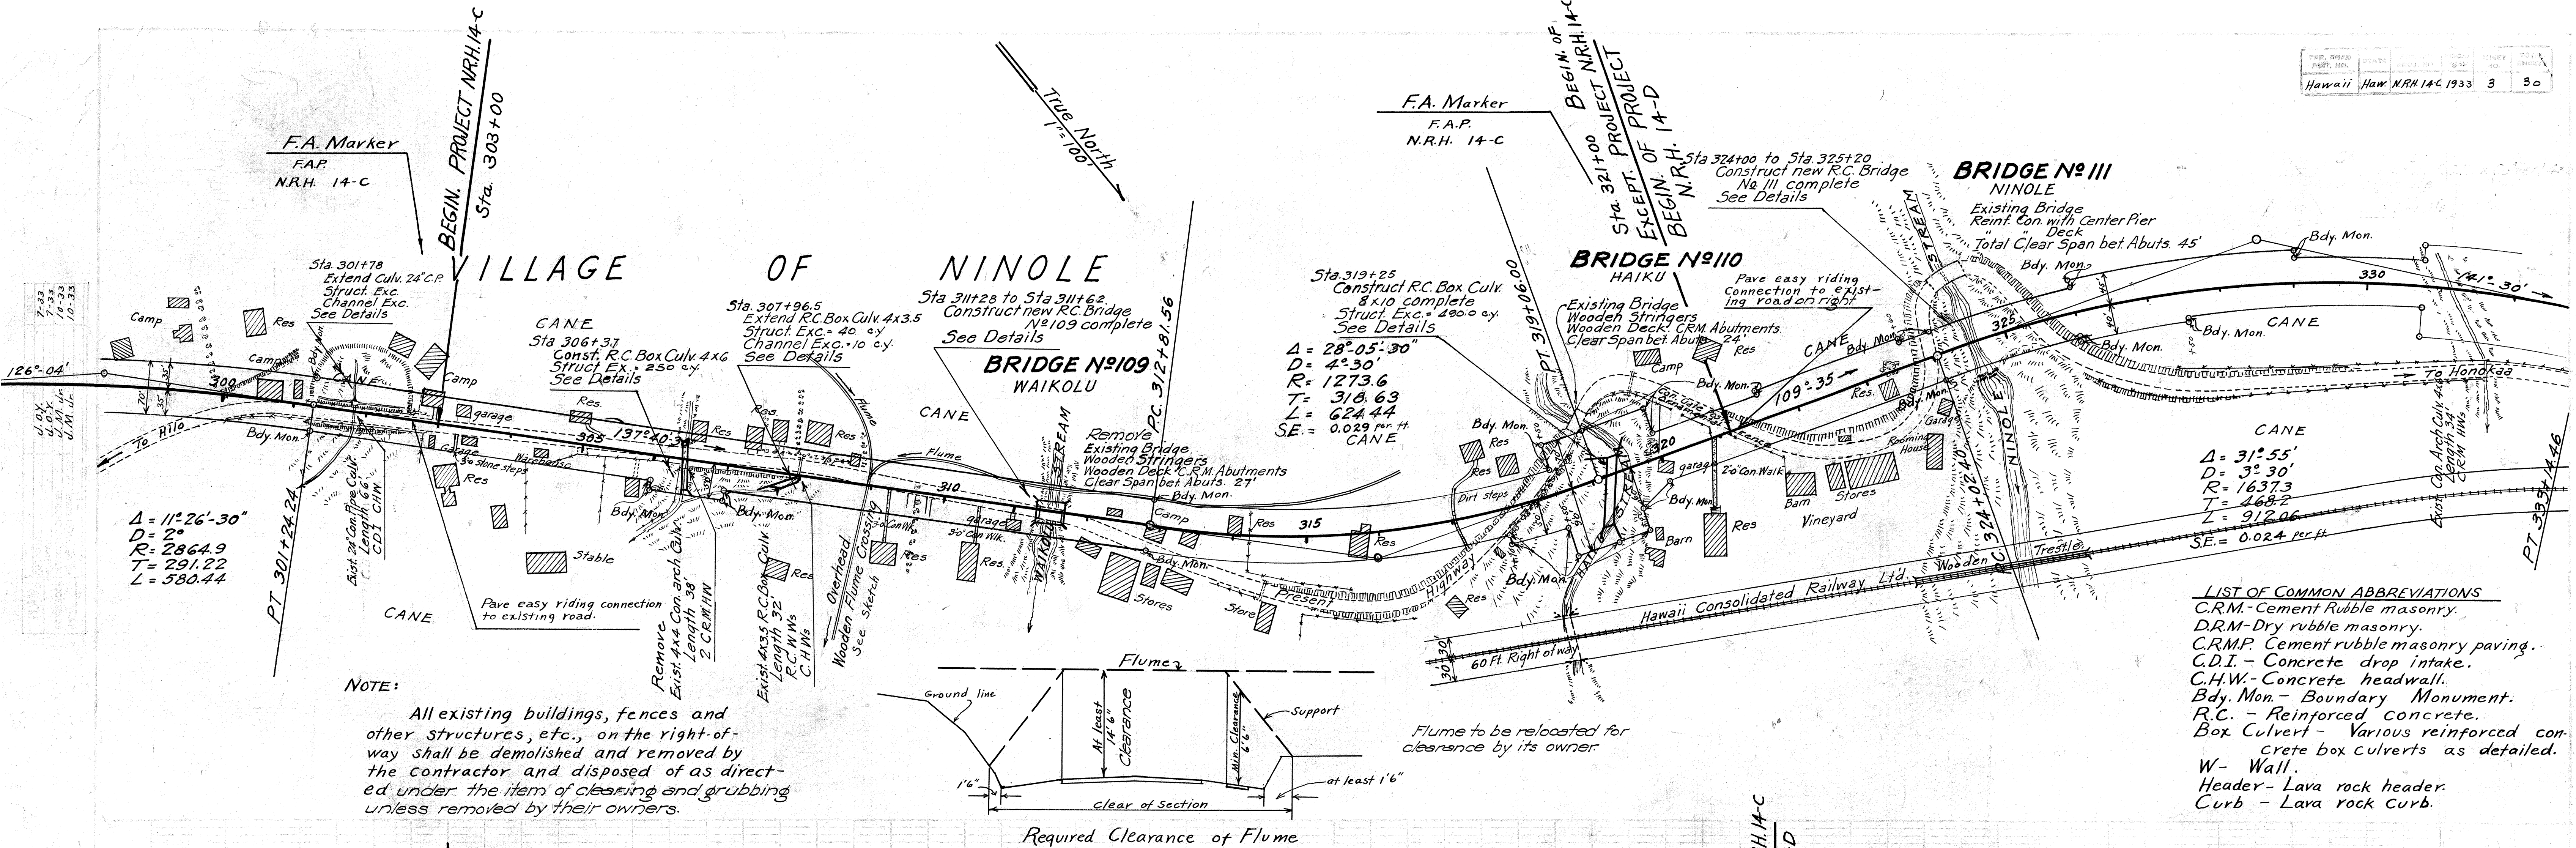


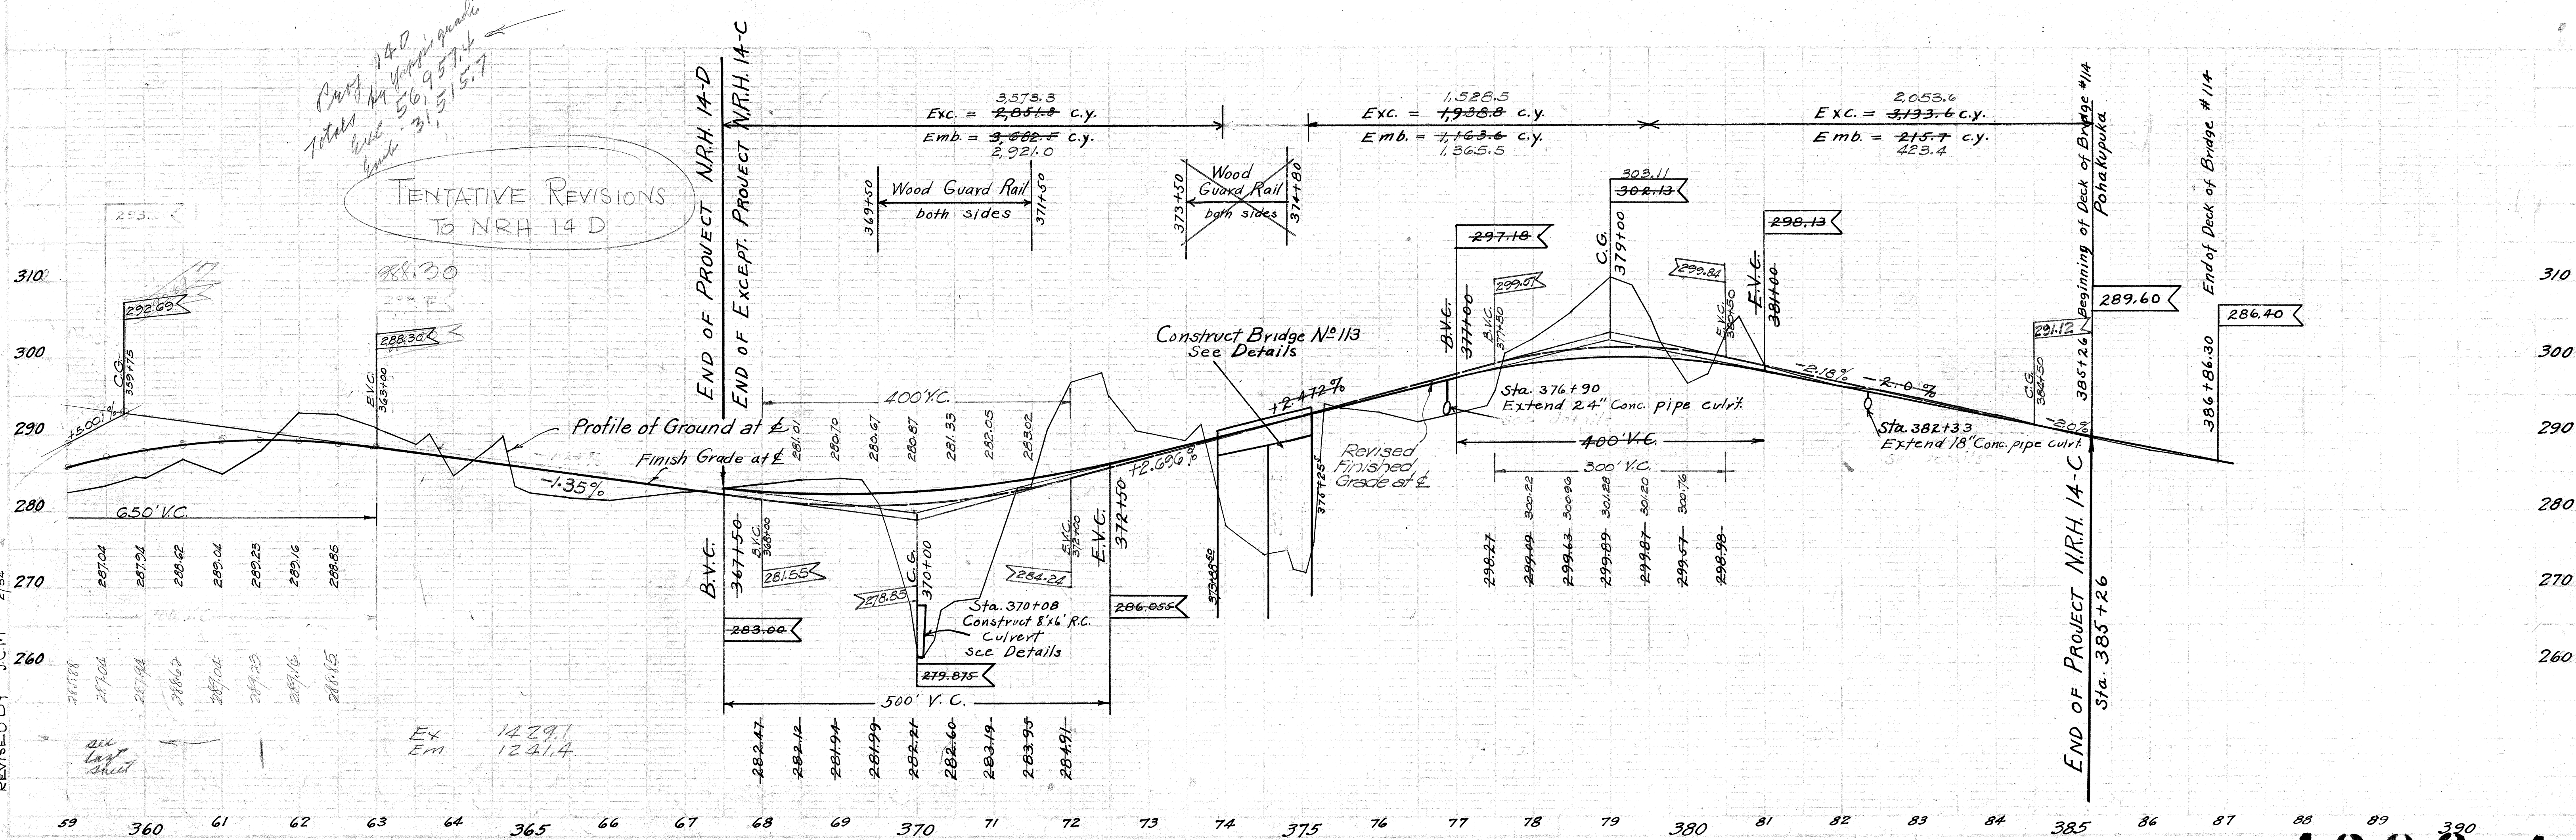

U.O.Y.
7-33
U.M.V.
10-33

U.O.Y.
7-33
U.M.V.
9-33

REVISED BY J.C.M. 2/34

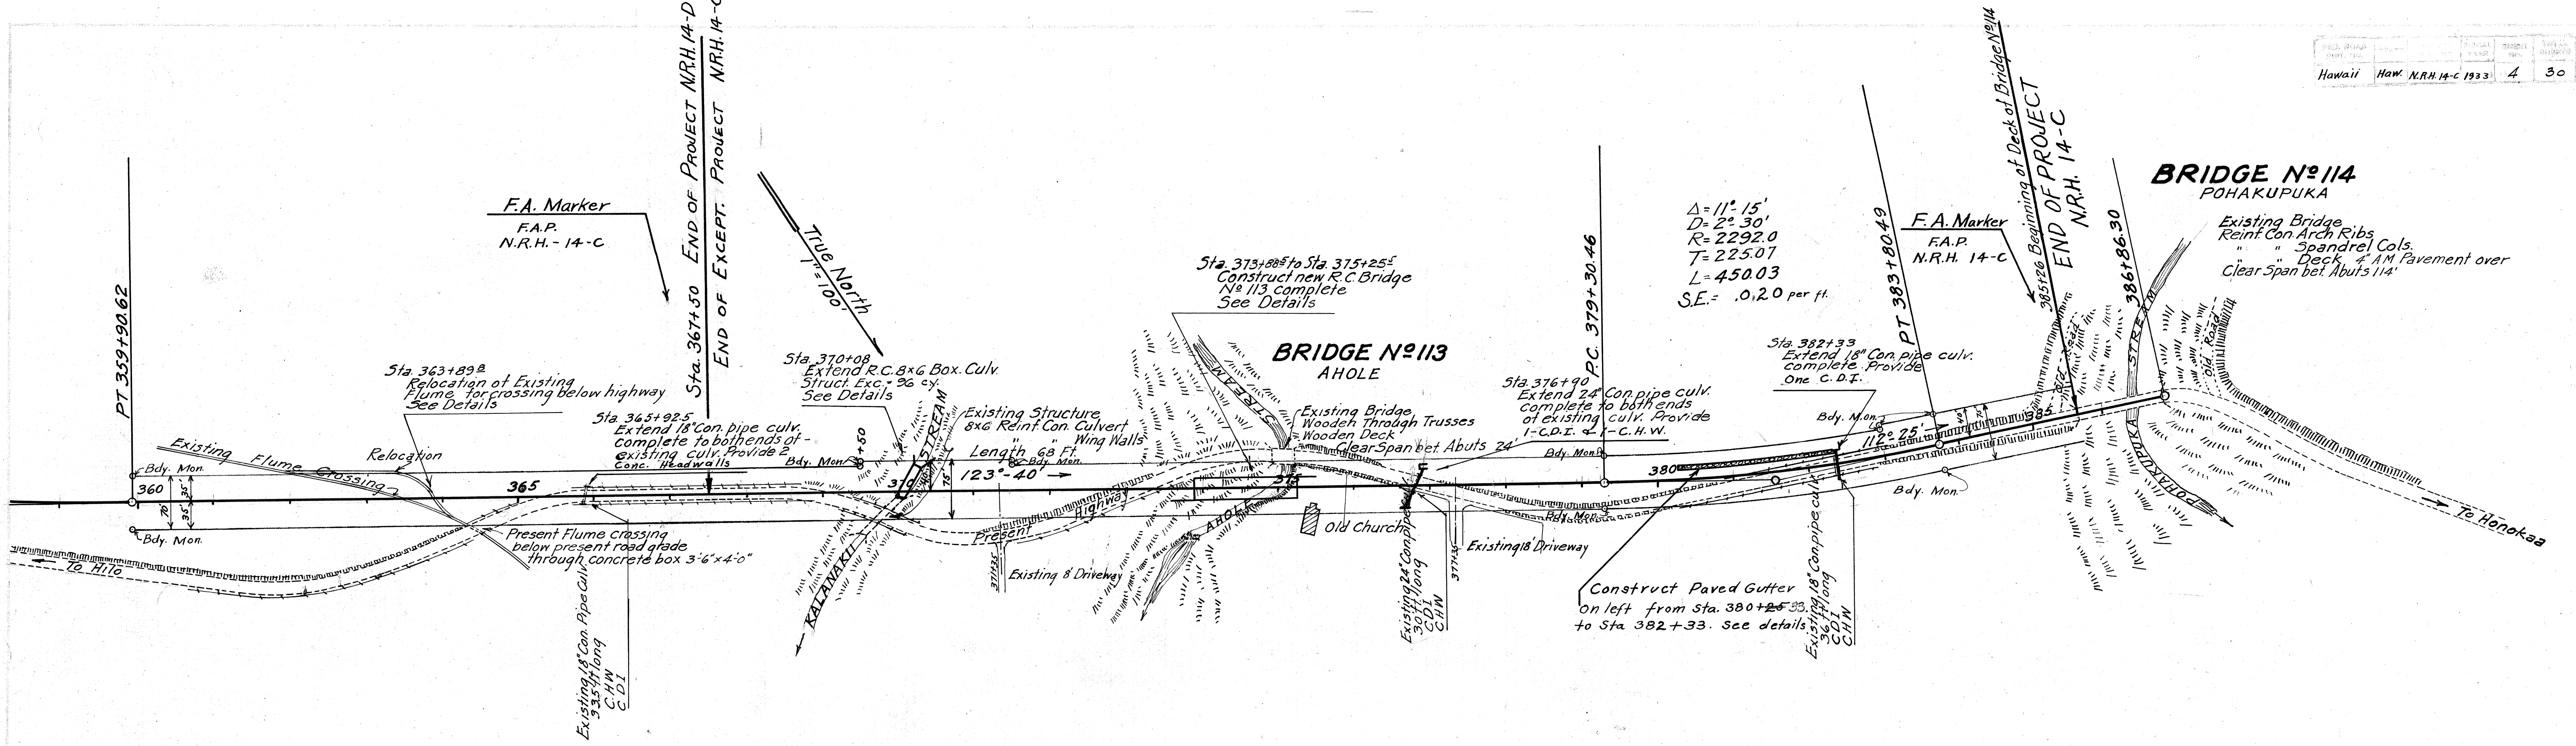

Handwritten notes: "Totals by stationing 14.0", "Exc. 56,957.4", "Emb. 31,515.7".

TENTATIVE REVISIONS TO N.R.H. 14 D