


INDEX TO DRAWINGS	
SHEET NO.	DESCRIPTIONS
1	TITLE SHEET
2	TYPICAL ROAD SECTIONS
3-4	PLAN & PROFILE
5-6	STANDARD DETAIL SHEETS
7-11	CULVERT DETAILS
12-23	BRIDGE DETAILS
24-30	CROSS SECTIONS

CONVENTIONAL SIGNS	
Existing Fence	
Existing Stone Wall Fence	
Edge of Existing Road	
Right of Way Line	
Center Line	
Boundary Line	
Culverts	
Dry Rubble Masonry Walls	

TERRITORY OF HAWAII
TERRITORIAL HIGHWAY DEPARTMENT
HONOLULU T. H.


PLANS OF
HAWAII BELT ROAD
U. S. PUBLIC WORKS PROJECT NO. NR.H.14C
DISTRICT OF NORTH HILO
ISLAND OF HAWAII.

SCALES	
PLANS	1 INCH = 100 FEET
PROFILE — HOR	1 INCH = 100 FEET
VERT	1 INCH = 10 FEET
CROSS SECTIONS	1 INCH = 10 FEET

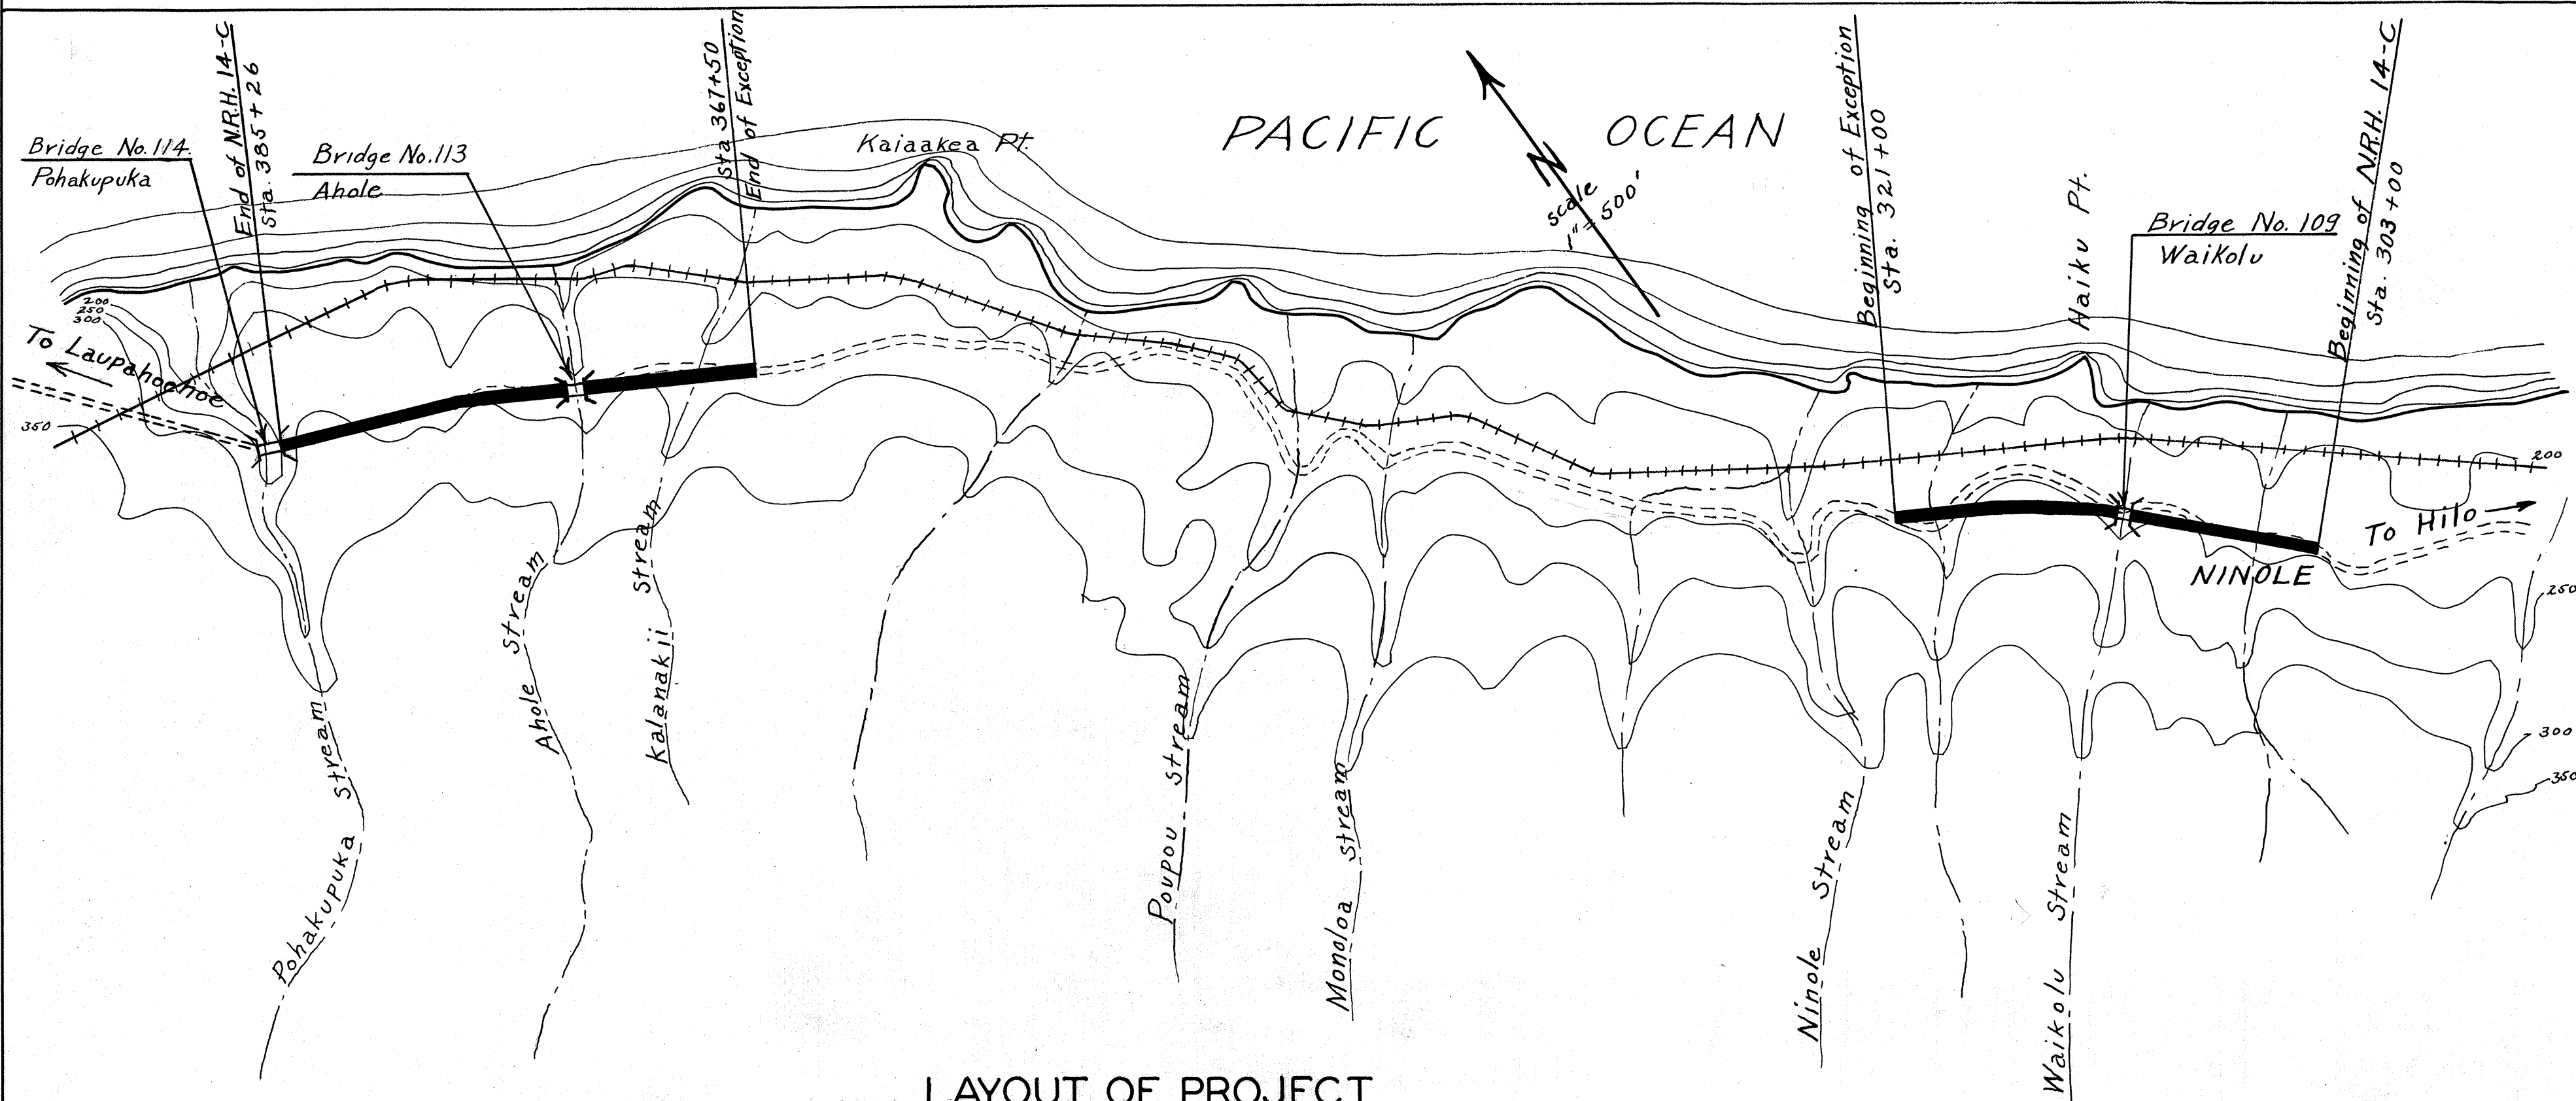

LAYOUT OF PROJECT

GROSS LENGTH	1.558 MI.
LENGTH OF EXCEPTION	0.881 MI.
LENGTH OF PROJECT	0.677 MI.
BRIDGES OVER 20 FT. SPAN	0.032 MI.
NET LENGTH	0.645 MI.

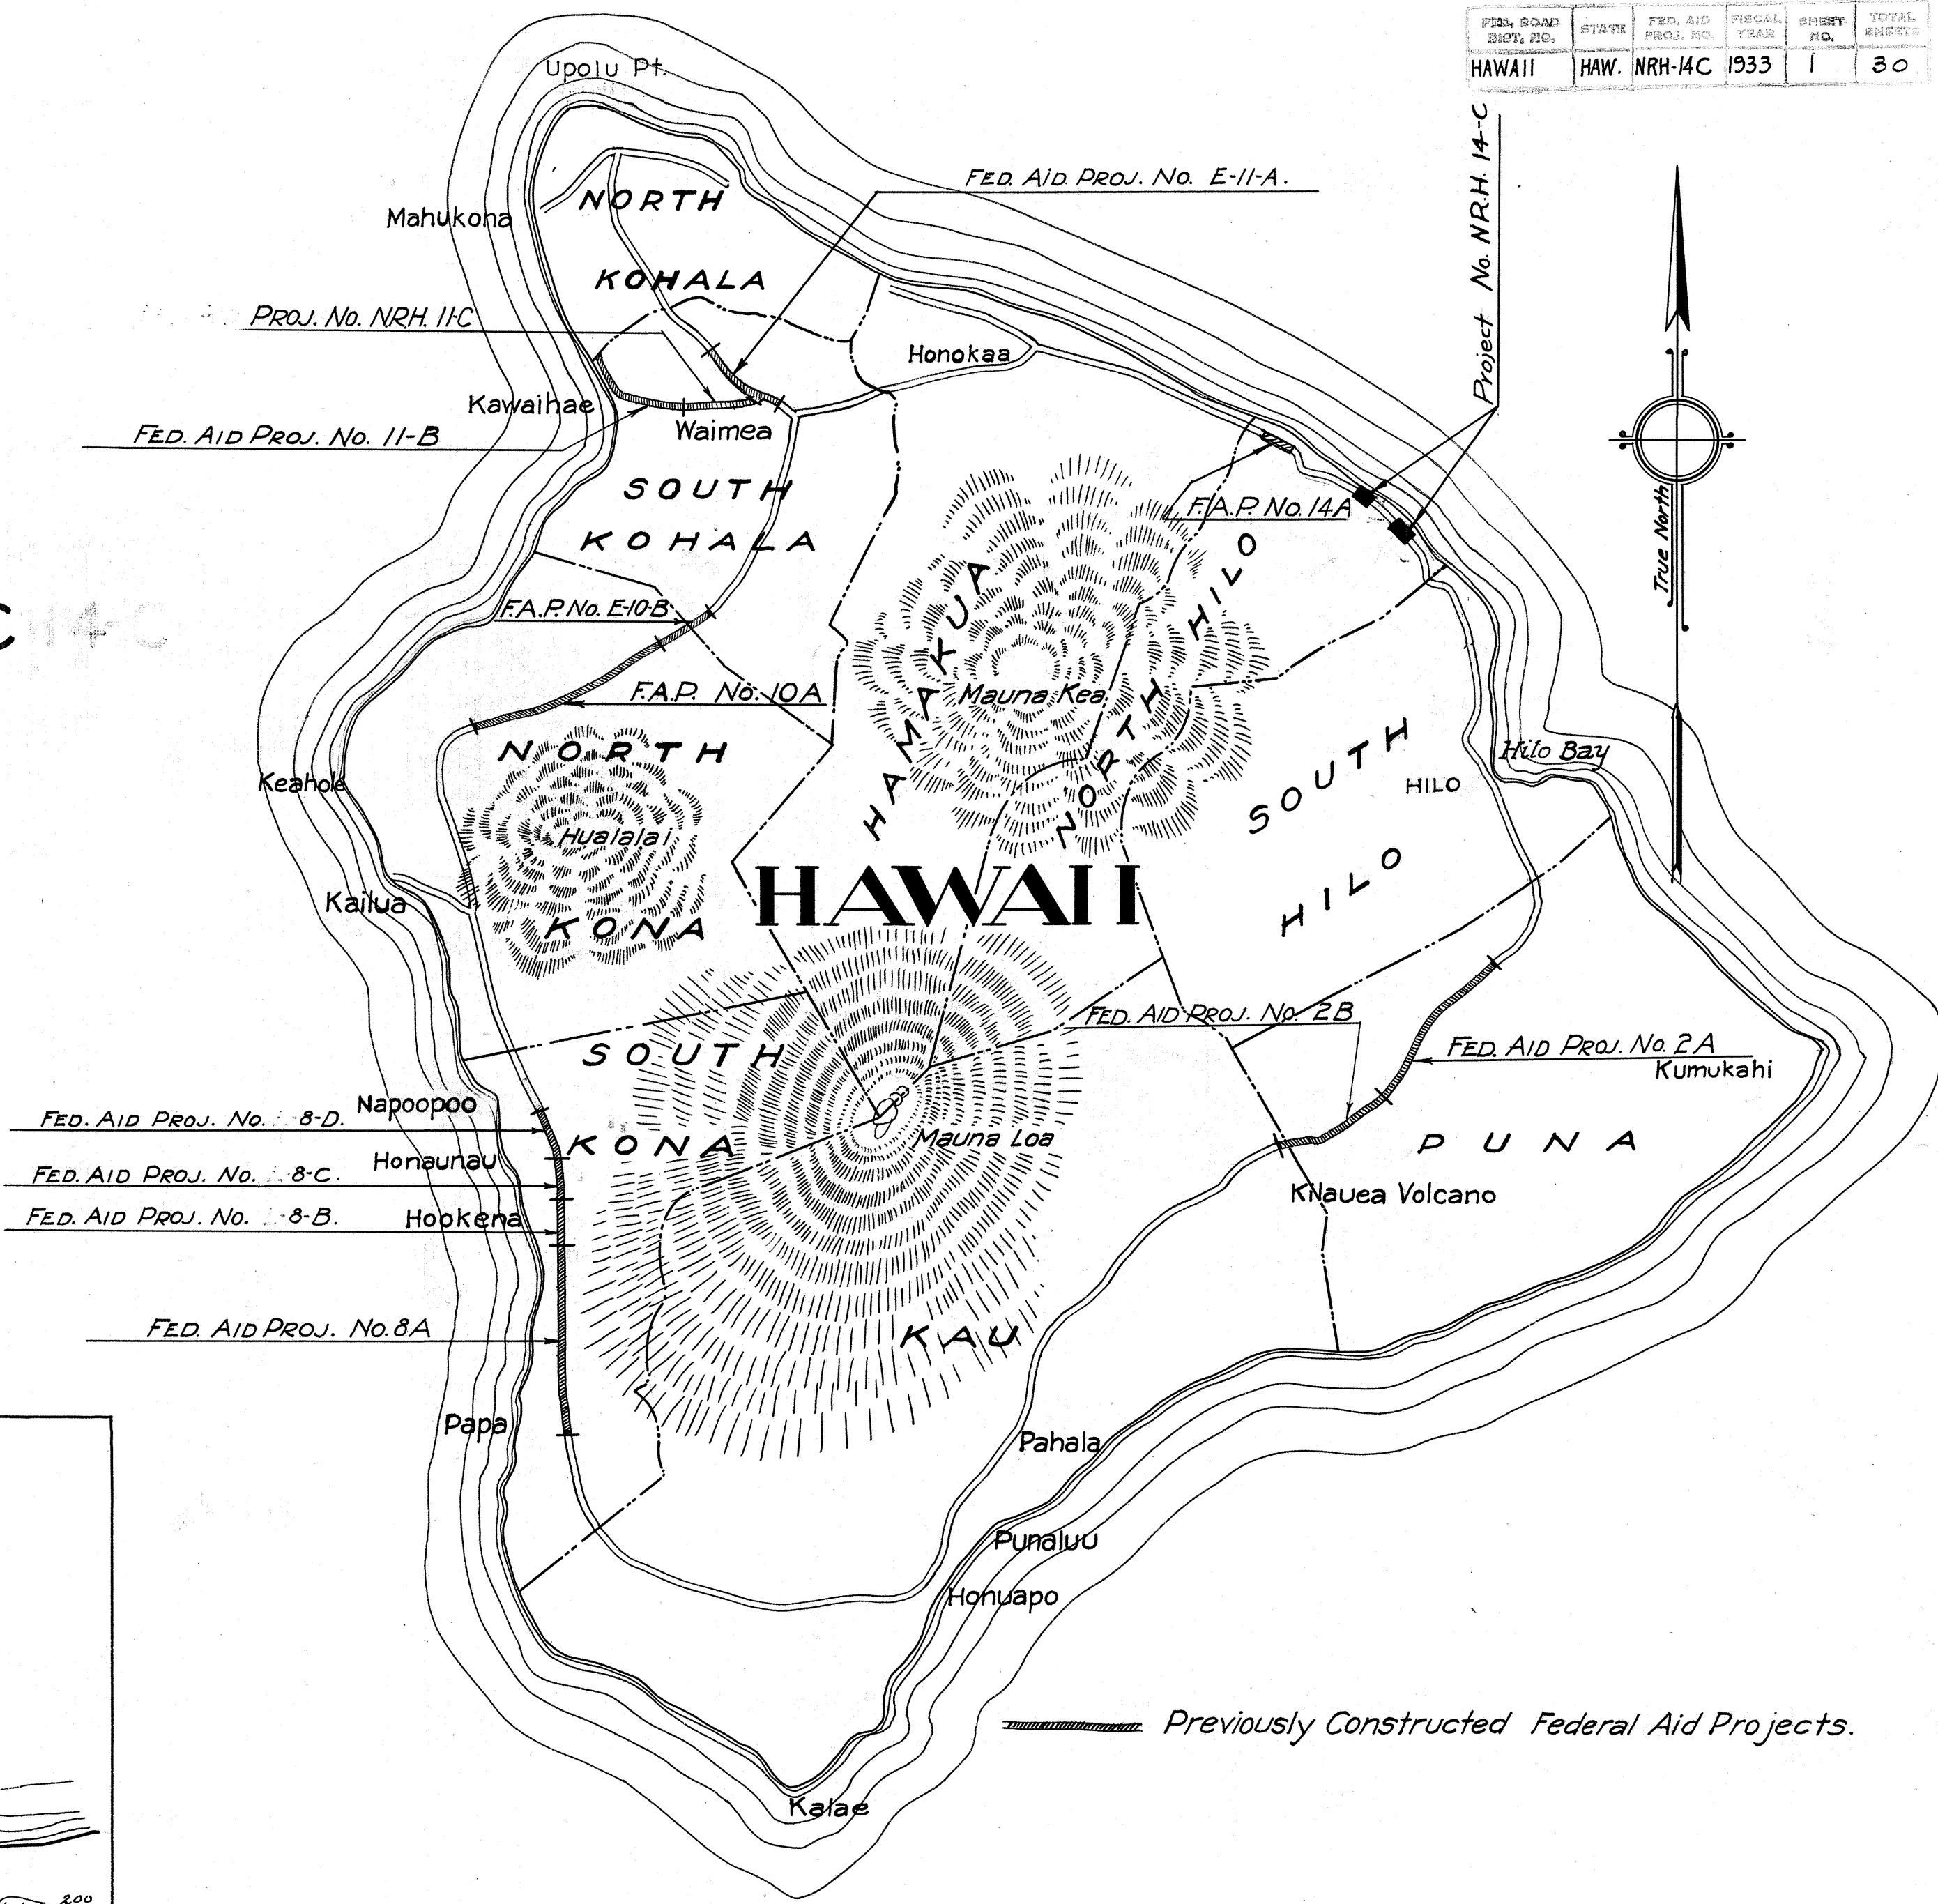

APPROVED
L. H. Bigelow
TERRITORIAL HIGHWAY ENGINEER

RECOMMENDED FOR APPROVAL

PRINCIPAL HIGHWAY ENGR.
Bureau of Public Roads
RECOMMENDED FOR APPROVAL

CHIEF ENGINEER, Bureau of Public Roads

APPROVED
CHIEF, Bureau of Public Roads.