


FIELD NO.	DATE	TIME AND DURATION	FISCAL YEAR	SHEET NO.	TOTAL SHEETS
HAWAII	HAW.	N.H. 14 G	1935	37	37

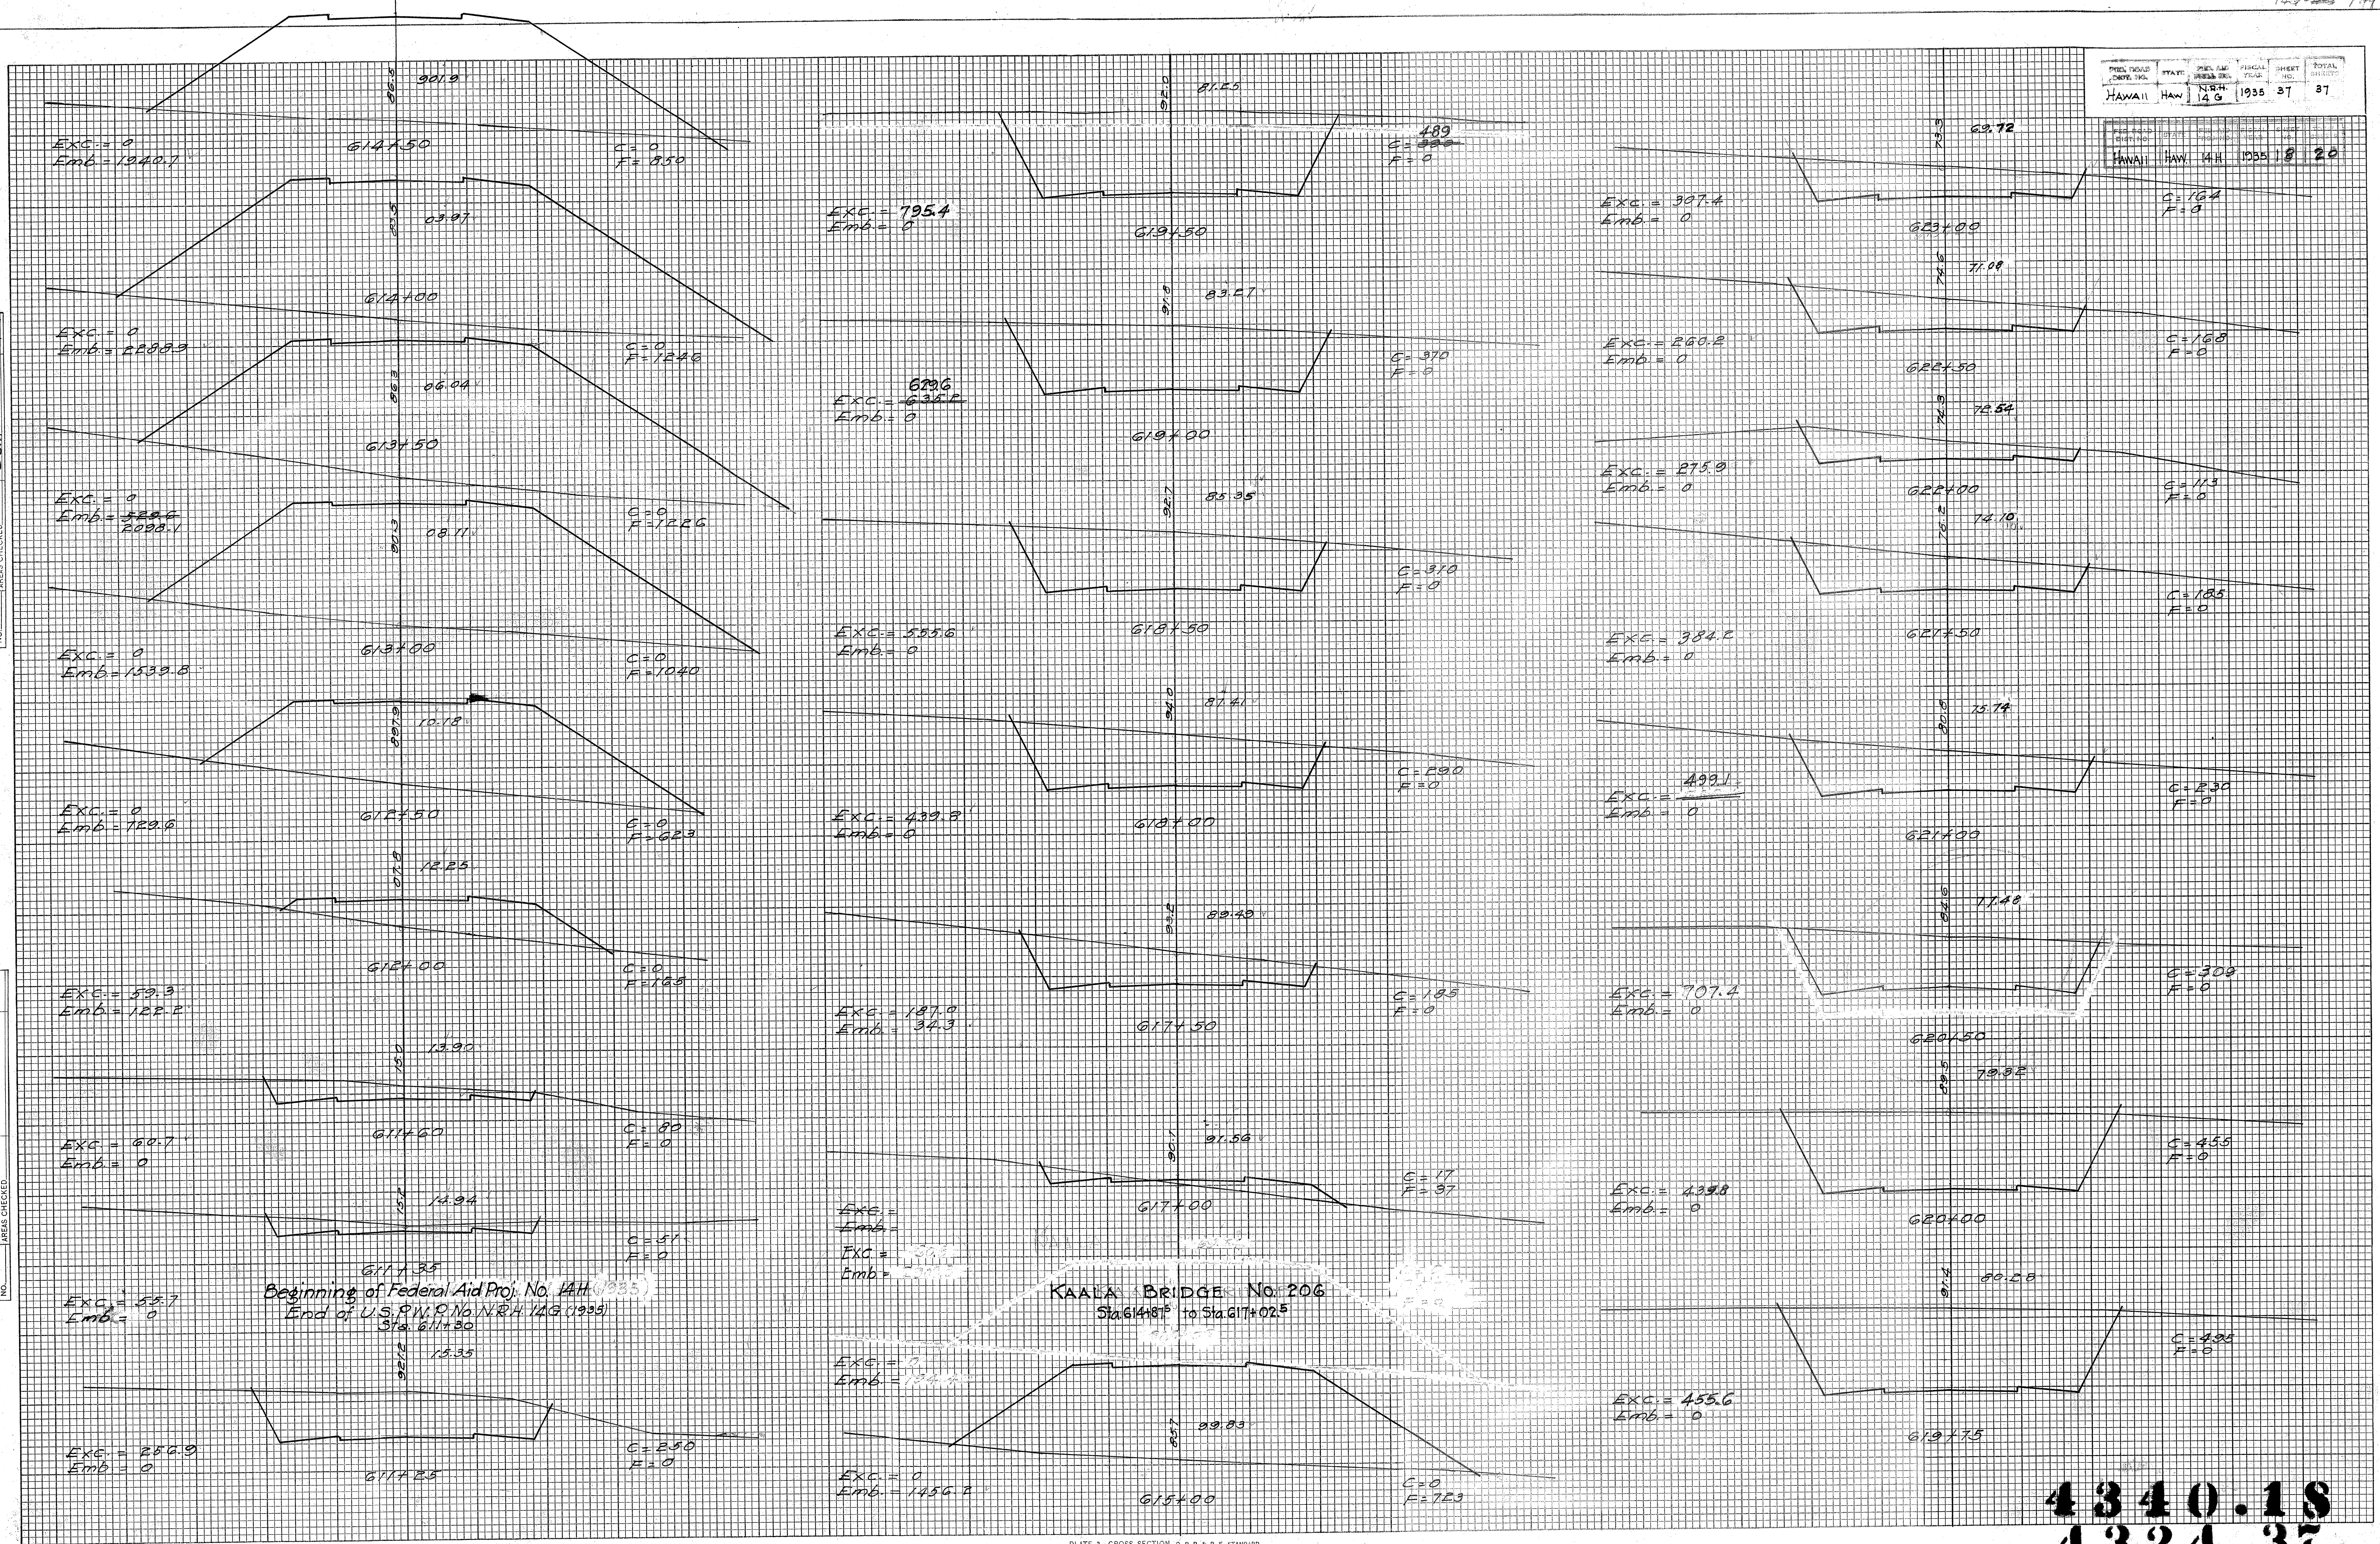


4340.18
4324.37

FINAL	DATE
SURVEY	BY
NO.	
SURVEY	DATE
NO.	
NOTE BOOK	DATE
NO.	
AREAS CHECKED	DATE
NO.	

ORIGINAL	DATE
SURVEY	BY
NO.	
SURVEY	DATE
NO.	
NOTE BOOK	DATE
NO.	
AREAS CHECKED	DATE
NO.	

FED. ROAD DIST. NO.	STATE	FED. AID PROJ. NO.	FISCAL YEAR	SHEET NO.	TOTAL SHEETS
HAWAII	HAW.	14H	1935	19	20


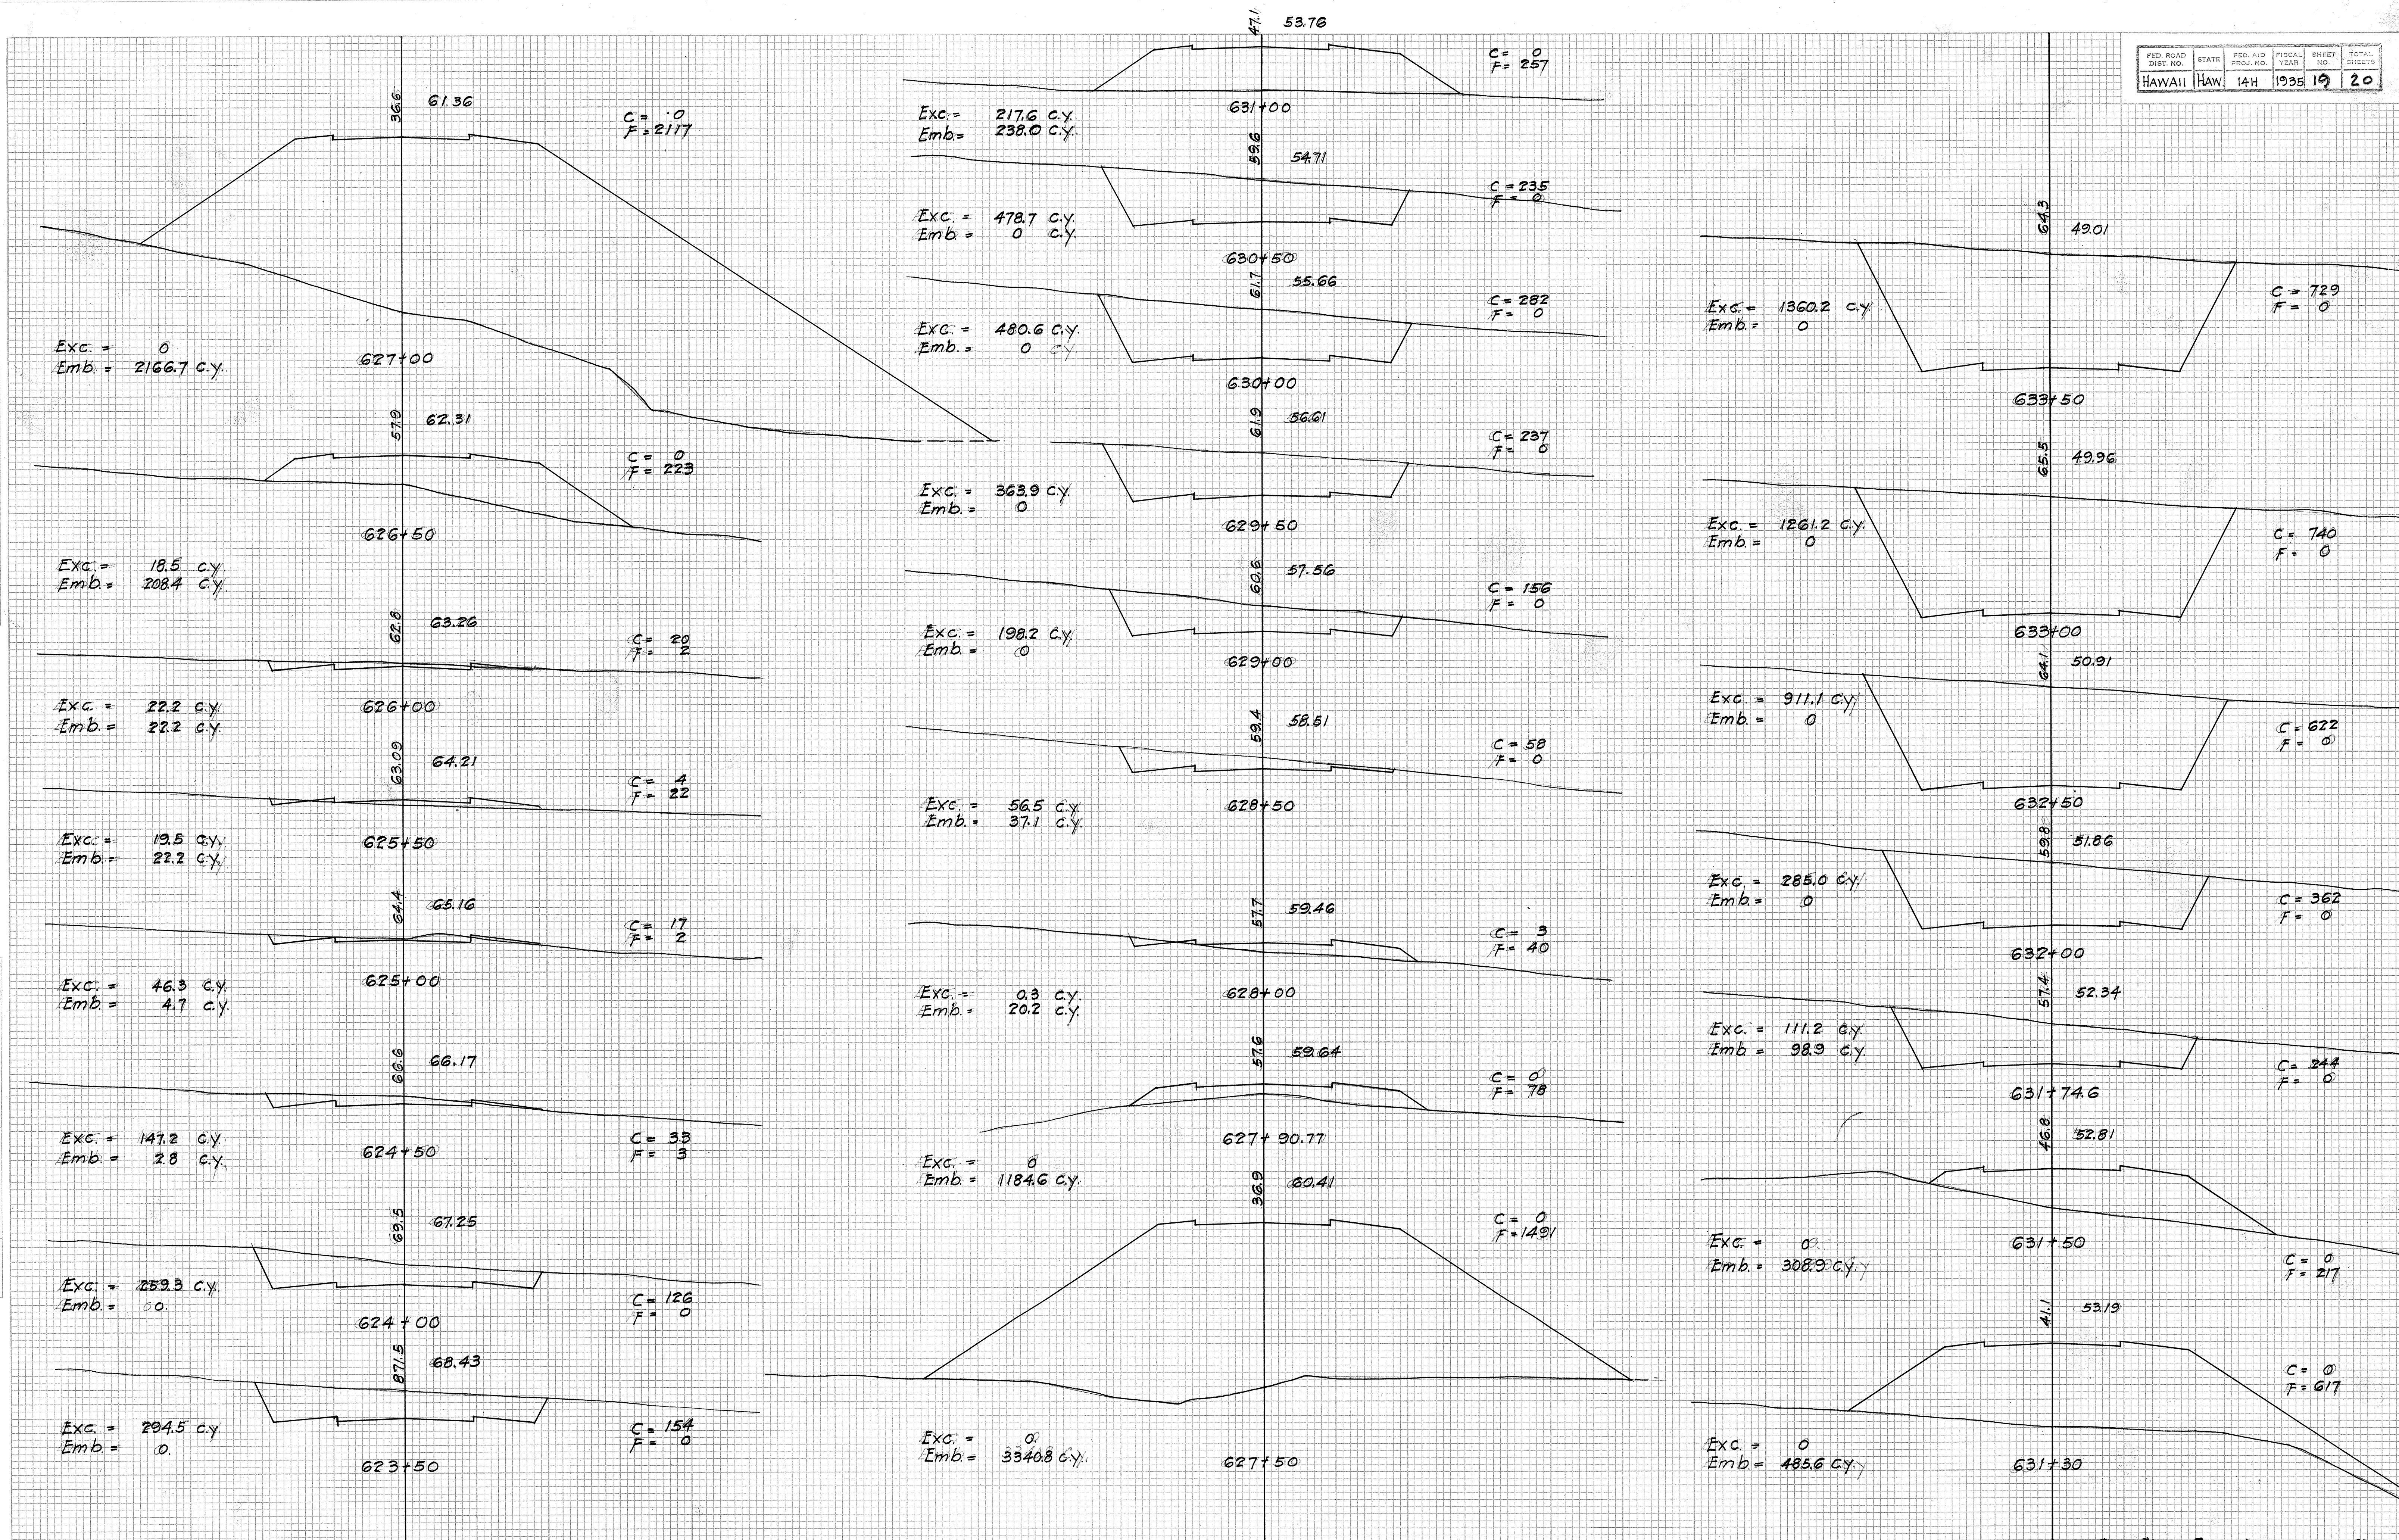


FED. ROAD DIST. NO.	STATE	FED. AID PROJ. NO.	FISCAL YEAR	SHEET NO.	TOTAL SHEETS
HAWAII	HAW.	H.R.H. 14-1	1934	11	11

FED. ROAD DIST. NO.	STATE	FED. AID PROJ. NO.	FISCAL YEAR	SHEET NO.	TOTAL SHEETS
HAWAII	HAW.	14-1	1935	20	20

DATE	BY	NO.
FINAL SURVEY	SURVEY	PLOTTED
NOTE BOOK	TEMPLATE	AREAS CHECKED

DATE	BY	NO.
ORIGINAL SURVEY	SURVEY	PLOTTED
NOTE BOOK	TEMPLATE	AREAS CHECKED

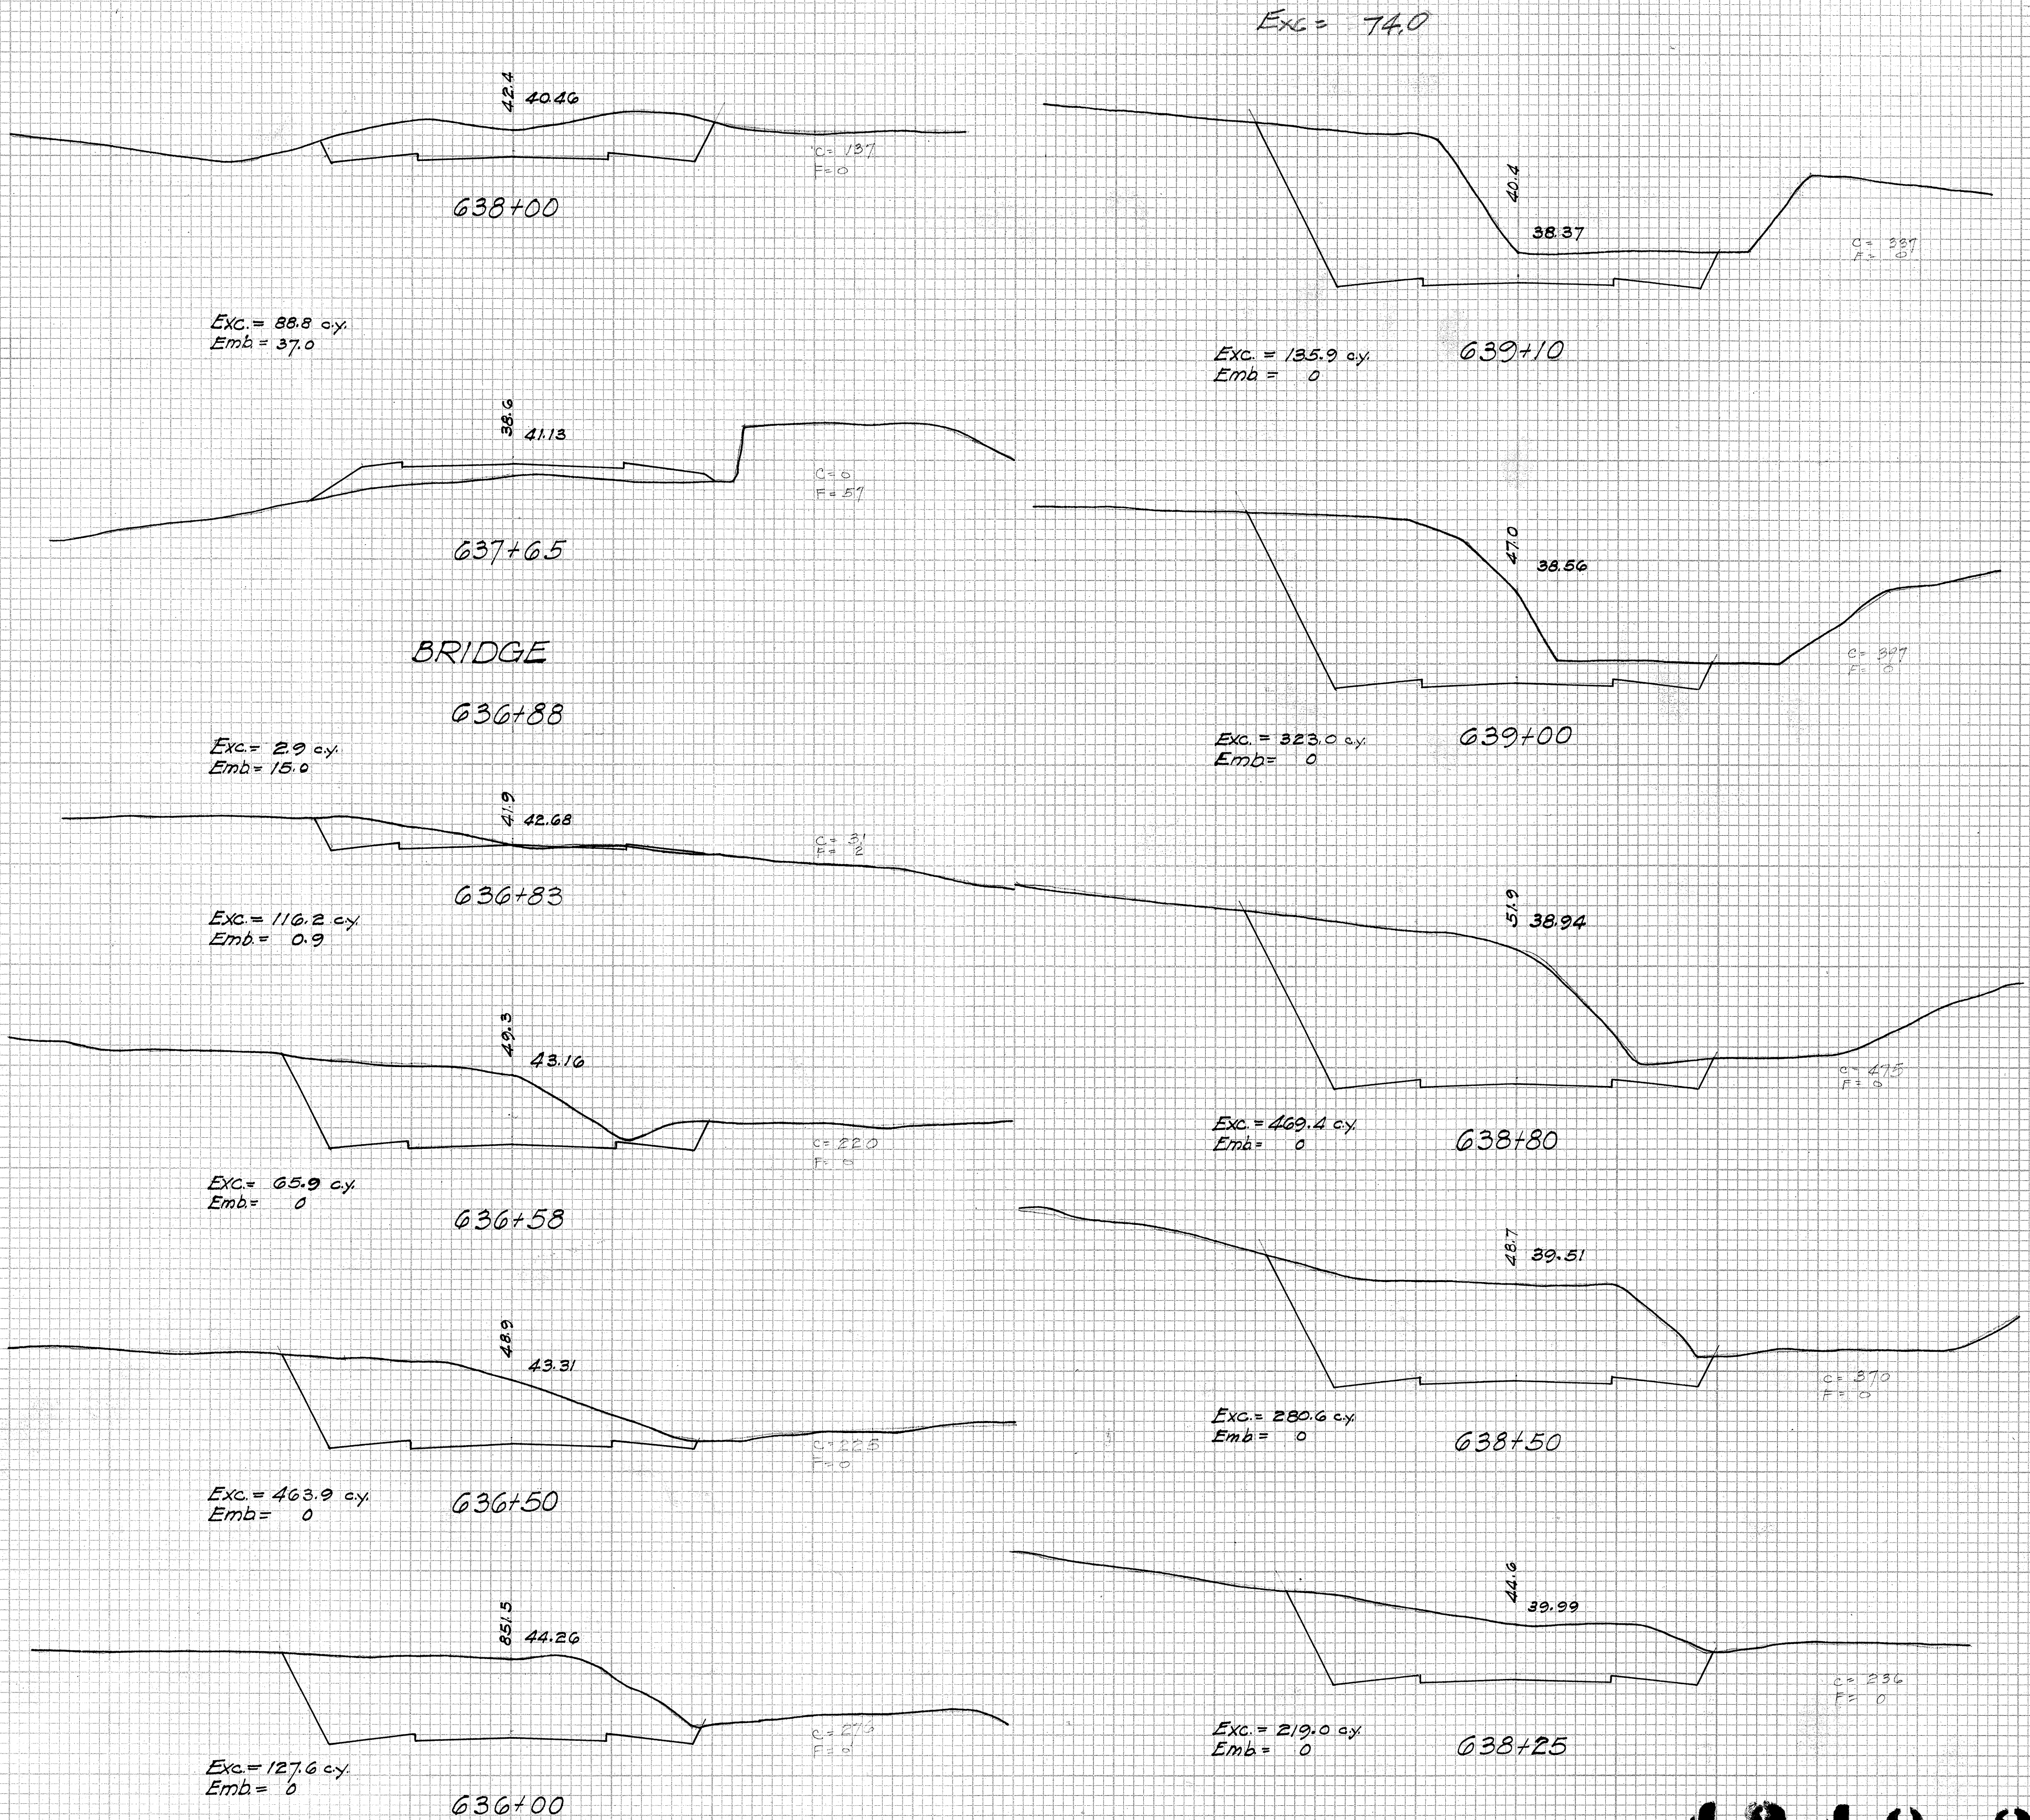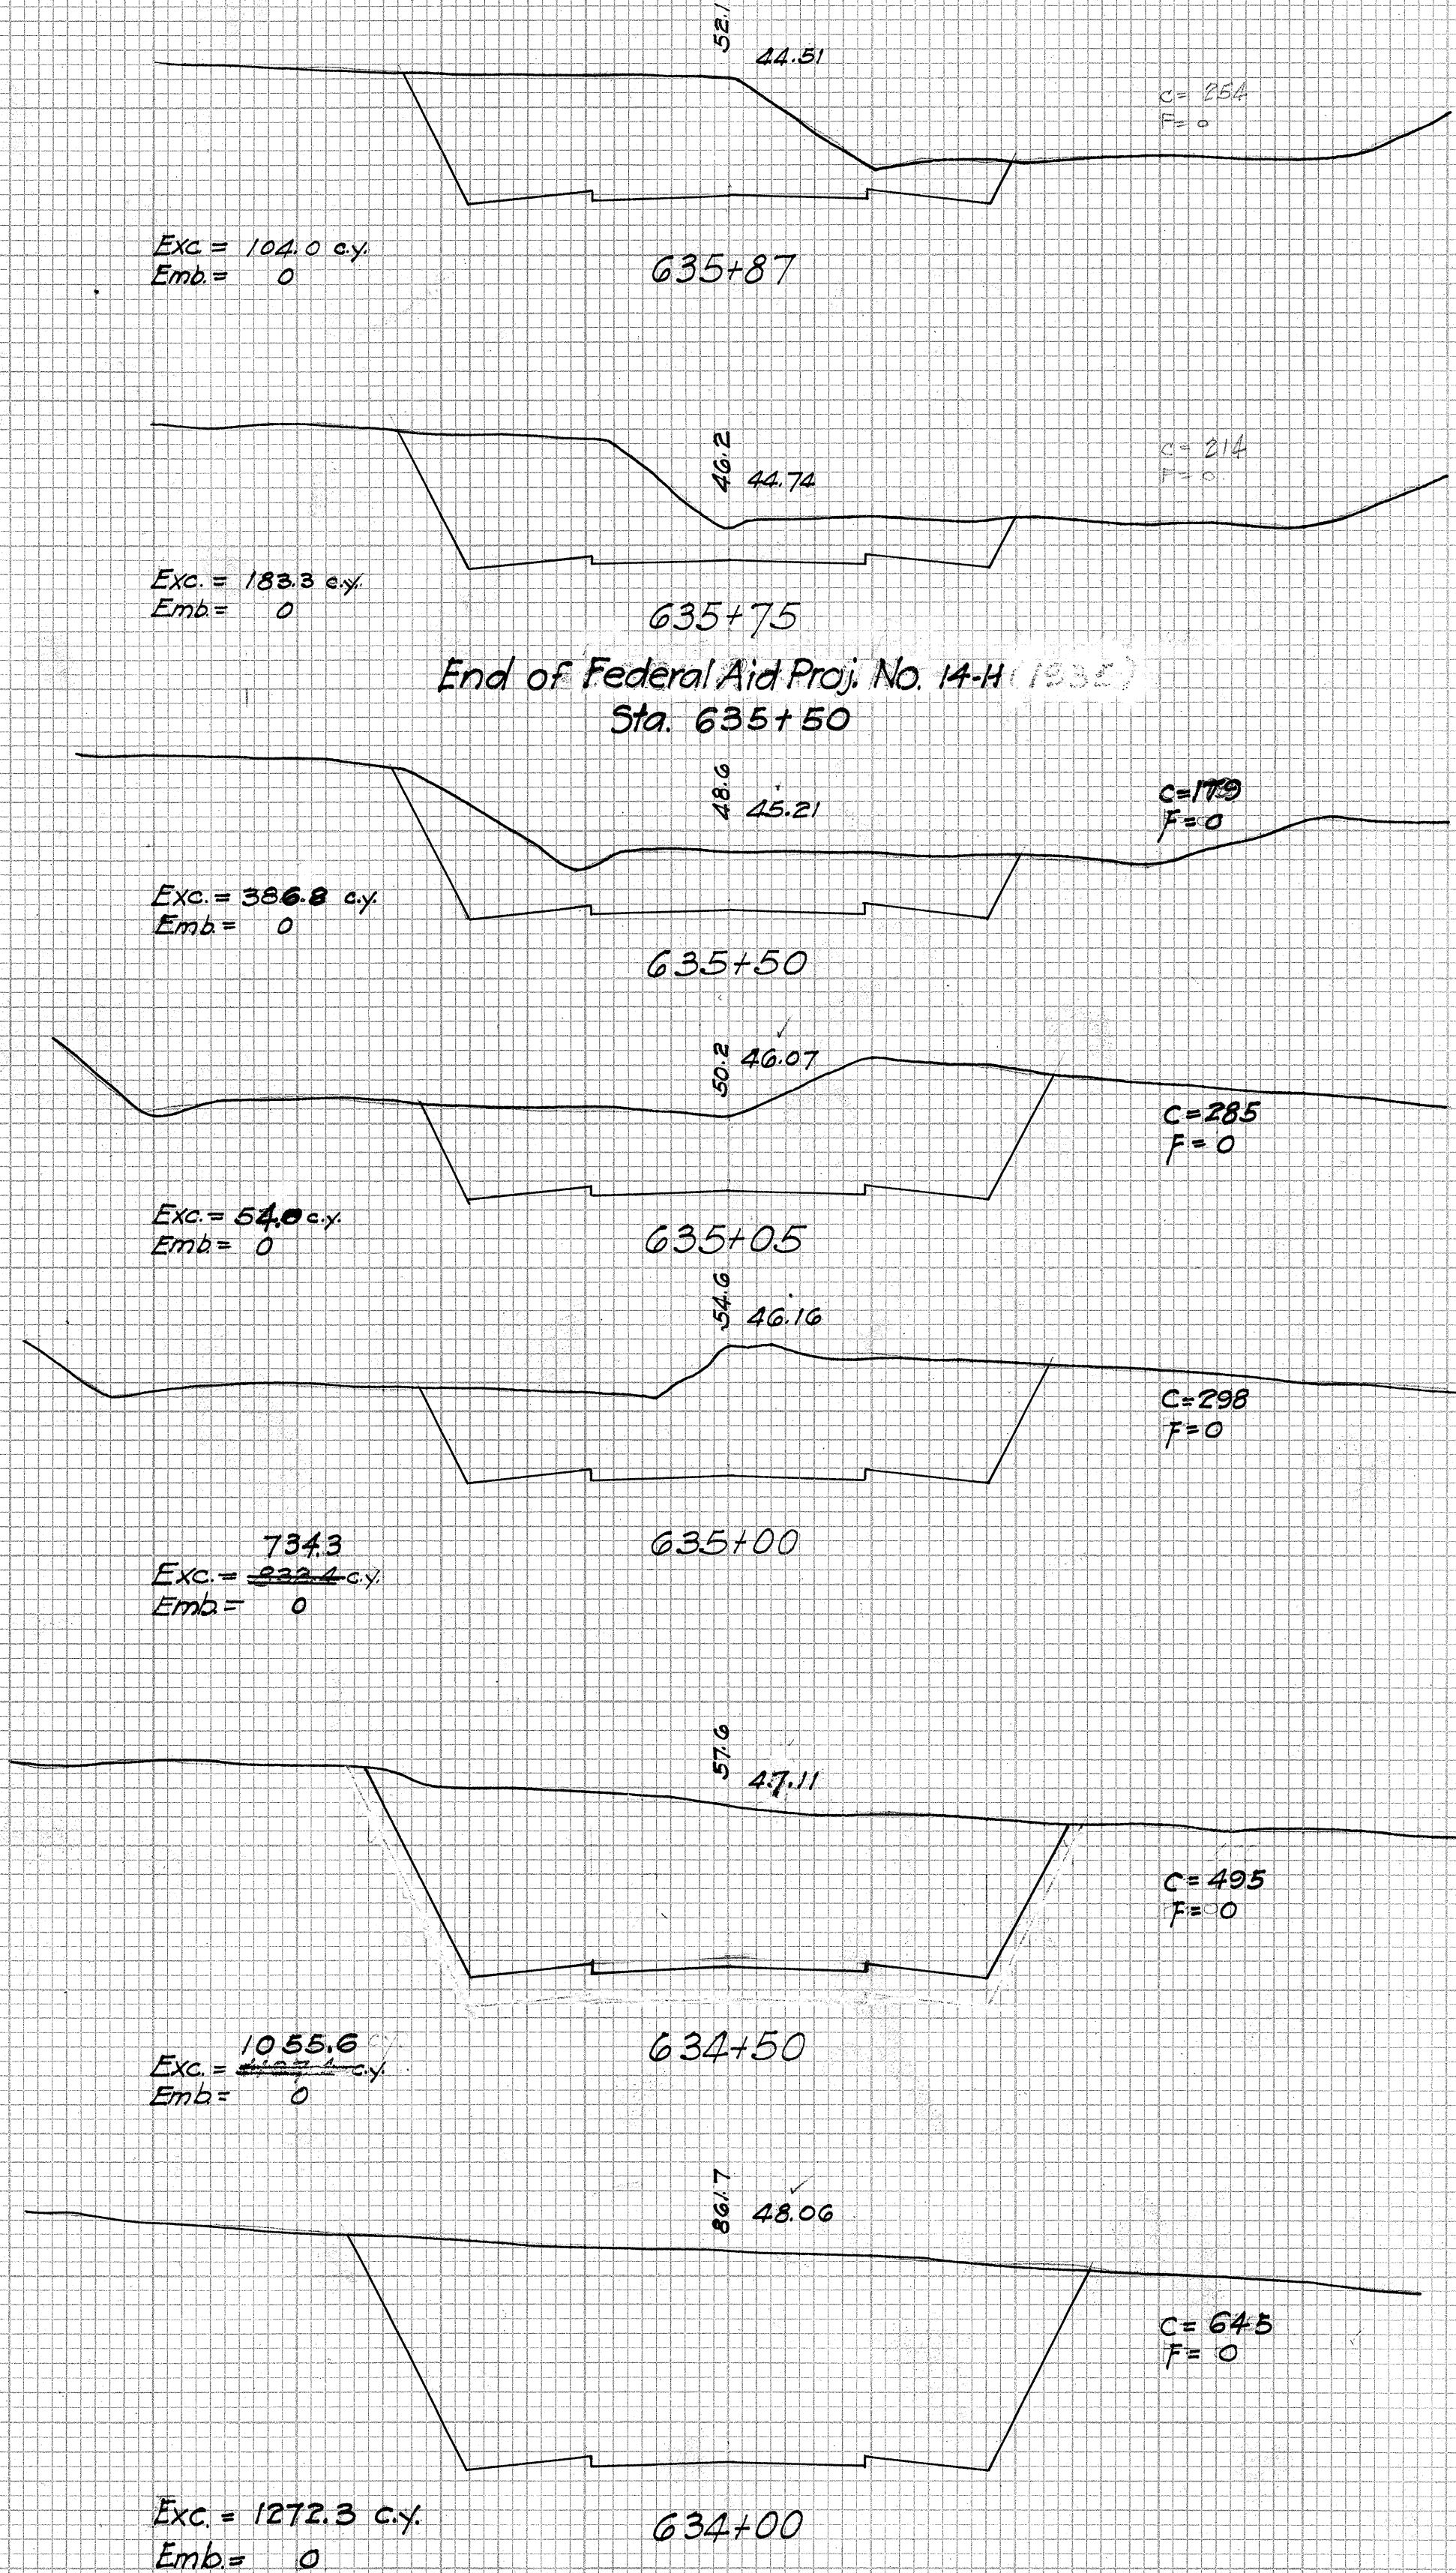

4340.20
4322.11