

FED. ROAD DIST. NO.	STATE	FED. AID PROJ. NO.	FISCAL YEAR	SHEET NO.	TOTAL SHEETS
HAWAII	HAW.	NR-1	1934	11	11


FED. ROAD DIST. NO.	STATE	FED. AID PROJ. NO.	FISCAL YEAR	SHEET NO.	TOTAL SHEETS
HAWAII	HAW.	NR-1	1935	20	20

DATE	BY	NO.

DATE	BY	NO.

DATE	BY	NO.

DATE	BY	NO.

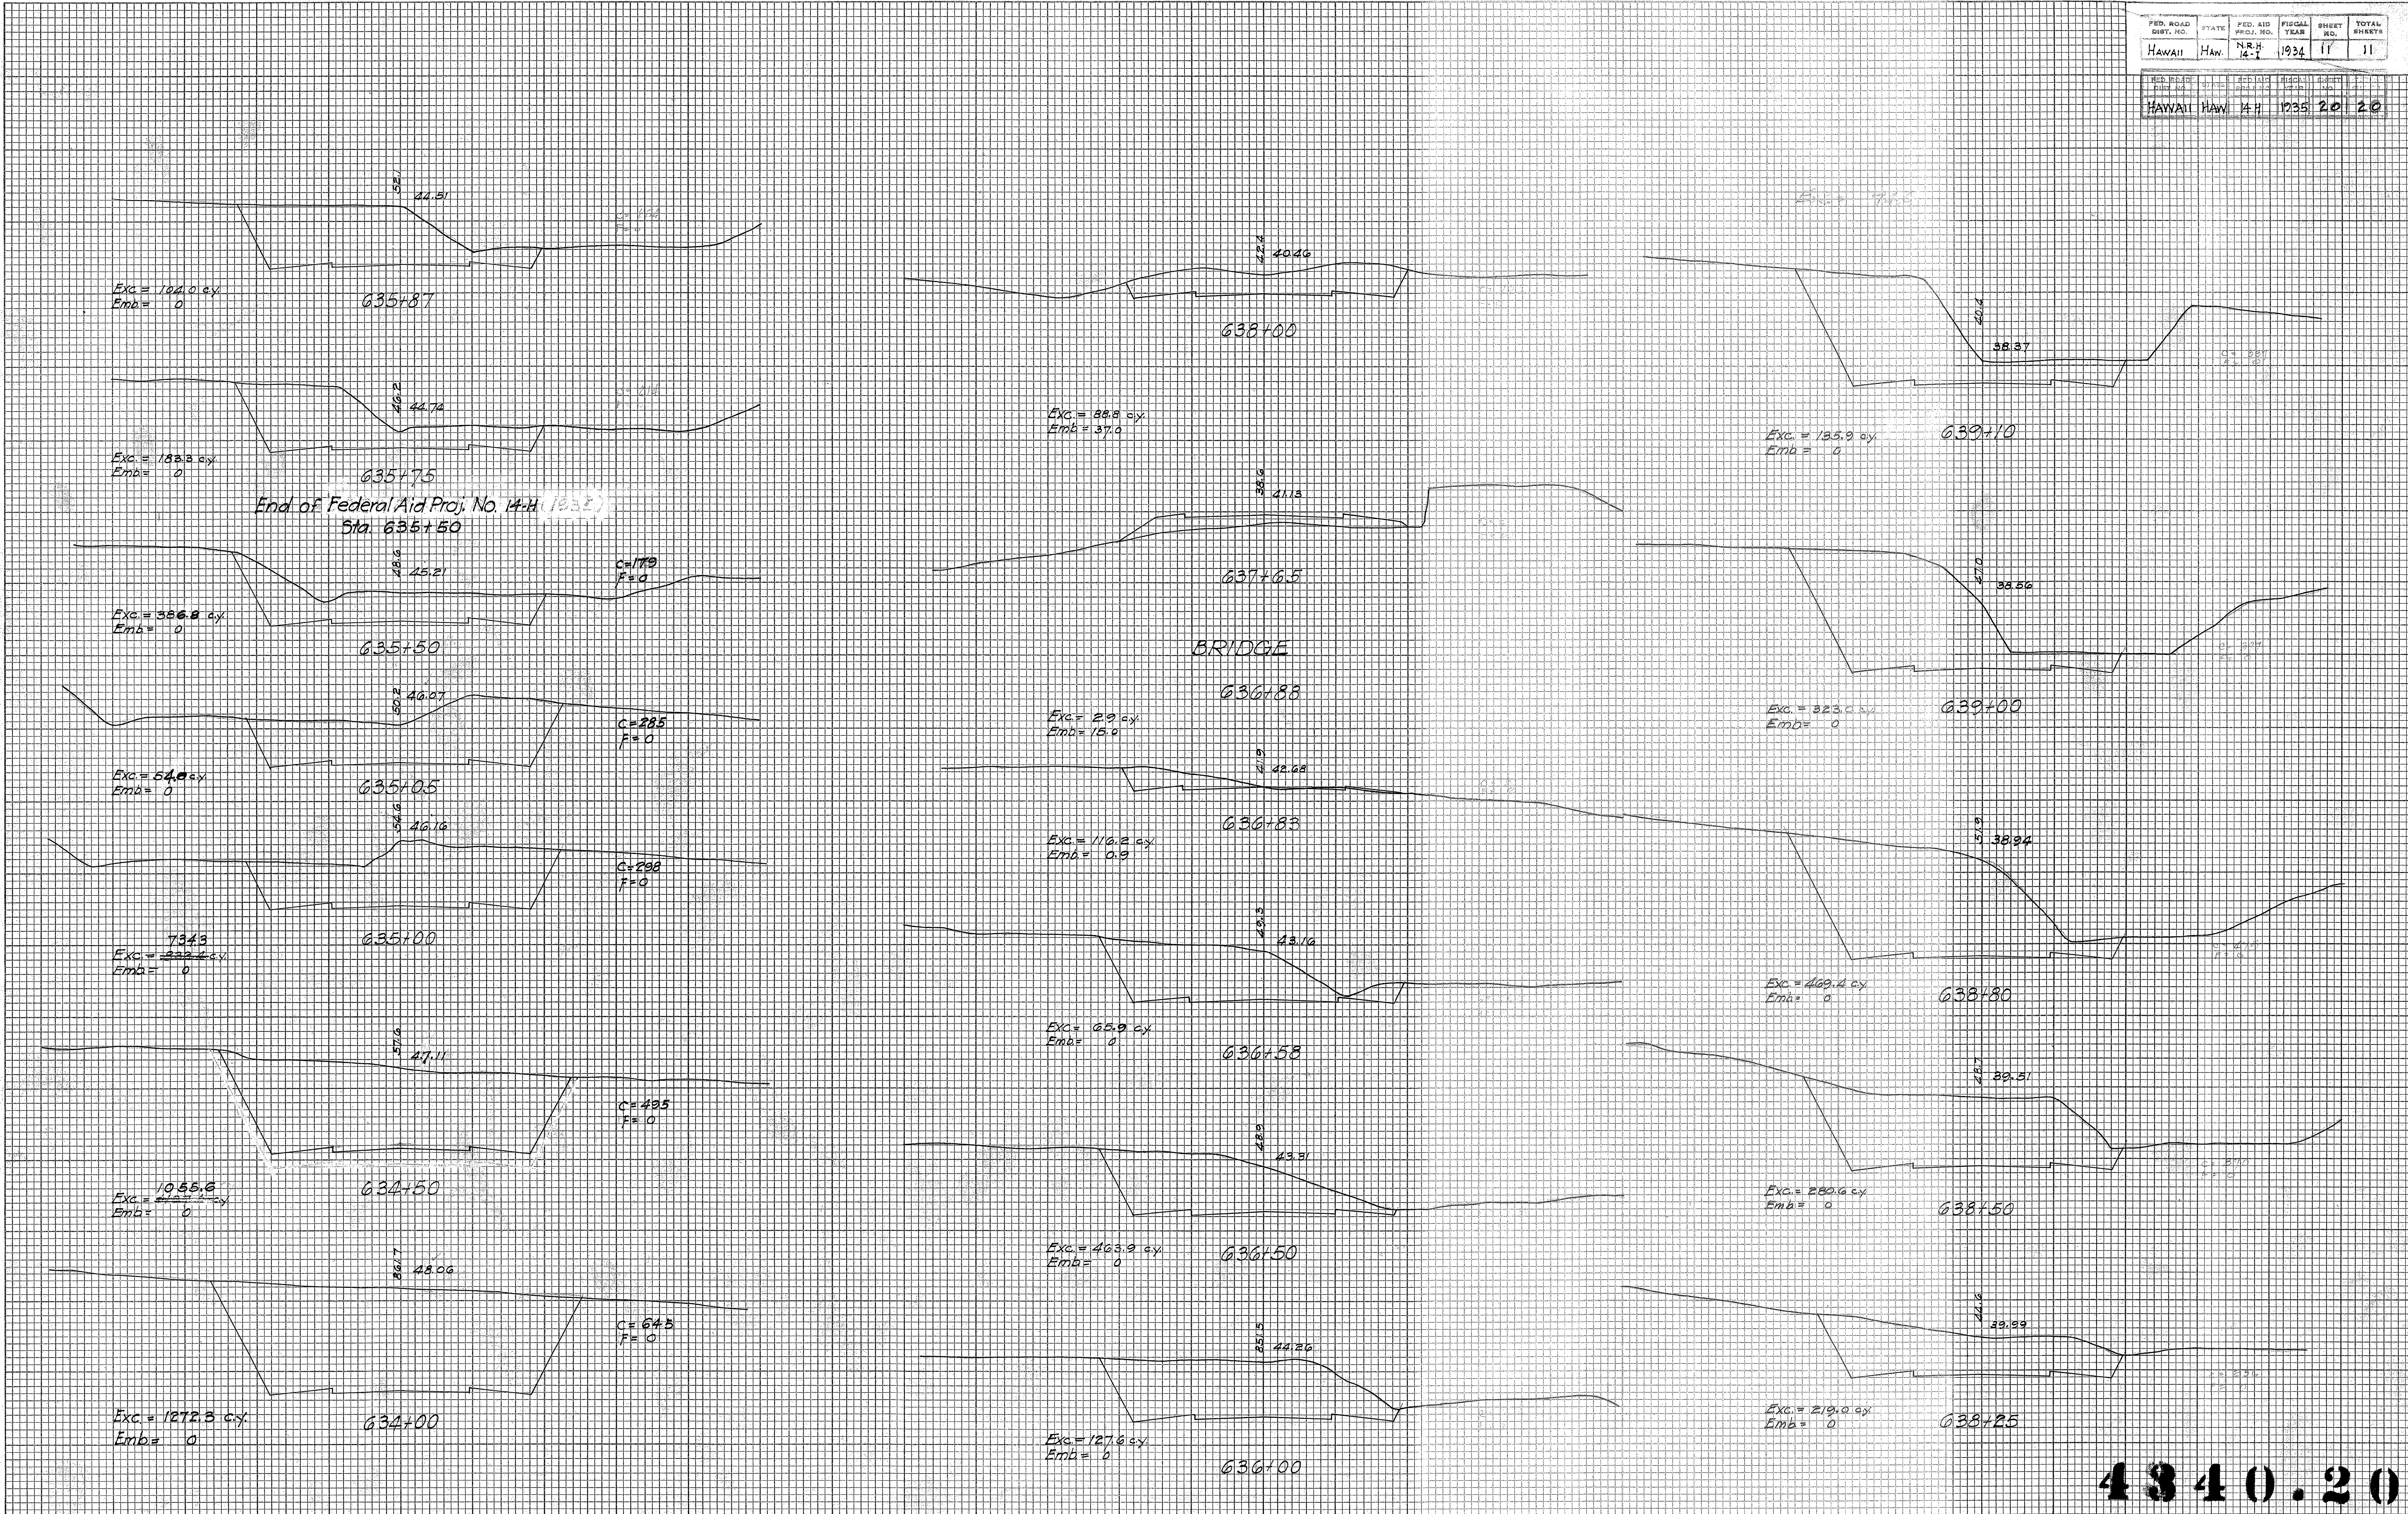

4840.20
4322.11