


NOTES ON BASE COURSE AND PAVEMENT

CRUSHER RUN BASE COURSE: 5" (compacted thickness) Crusher Run material (20% wear).
 ASPHALT MACADAM SURFACE COURSE: 2" (compacted thickness) No. 2 Crushed Rock (2 1/2 to 1 1/4); 10 lbs. per sq. yd. Asphalt (85-100) and sufficient No. 3 Crushed Rock (1 1/4 to 3/4) to cover.
 SEAL COAT: 3 to 4 lbs. per sq. yd. Asphalt (85-100) and sufficient No. 6 Crushed Rock (1/4 to 1/8) to cover.
 BITUMINOUS FOOTPATH SURFACE: 2" (compacted thickness) Crusher Run material (2 1/2 to dust) covered by a bituminous surface of hot or emulsified asphalt and fine crushed rock.
 GENERAL NOTES: Particular reference is made to the specifications covering these items of work.

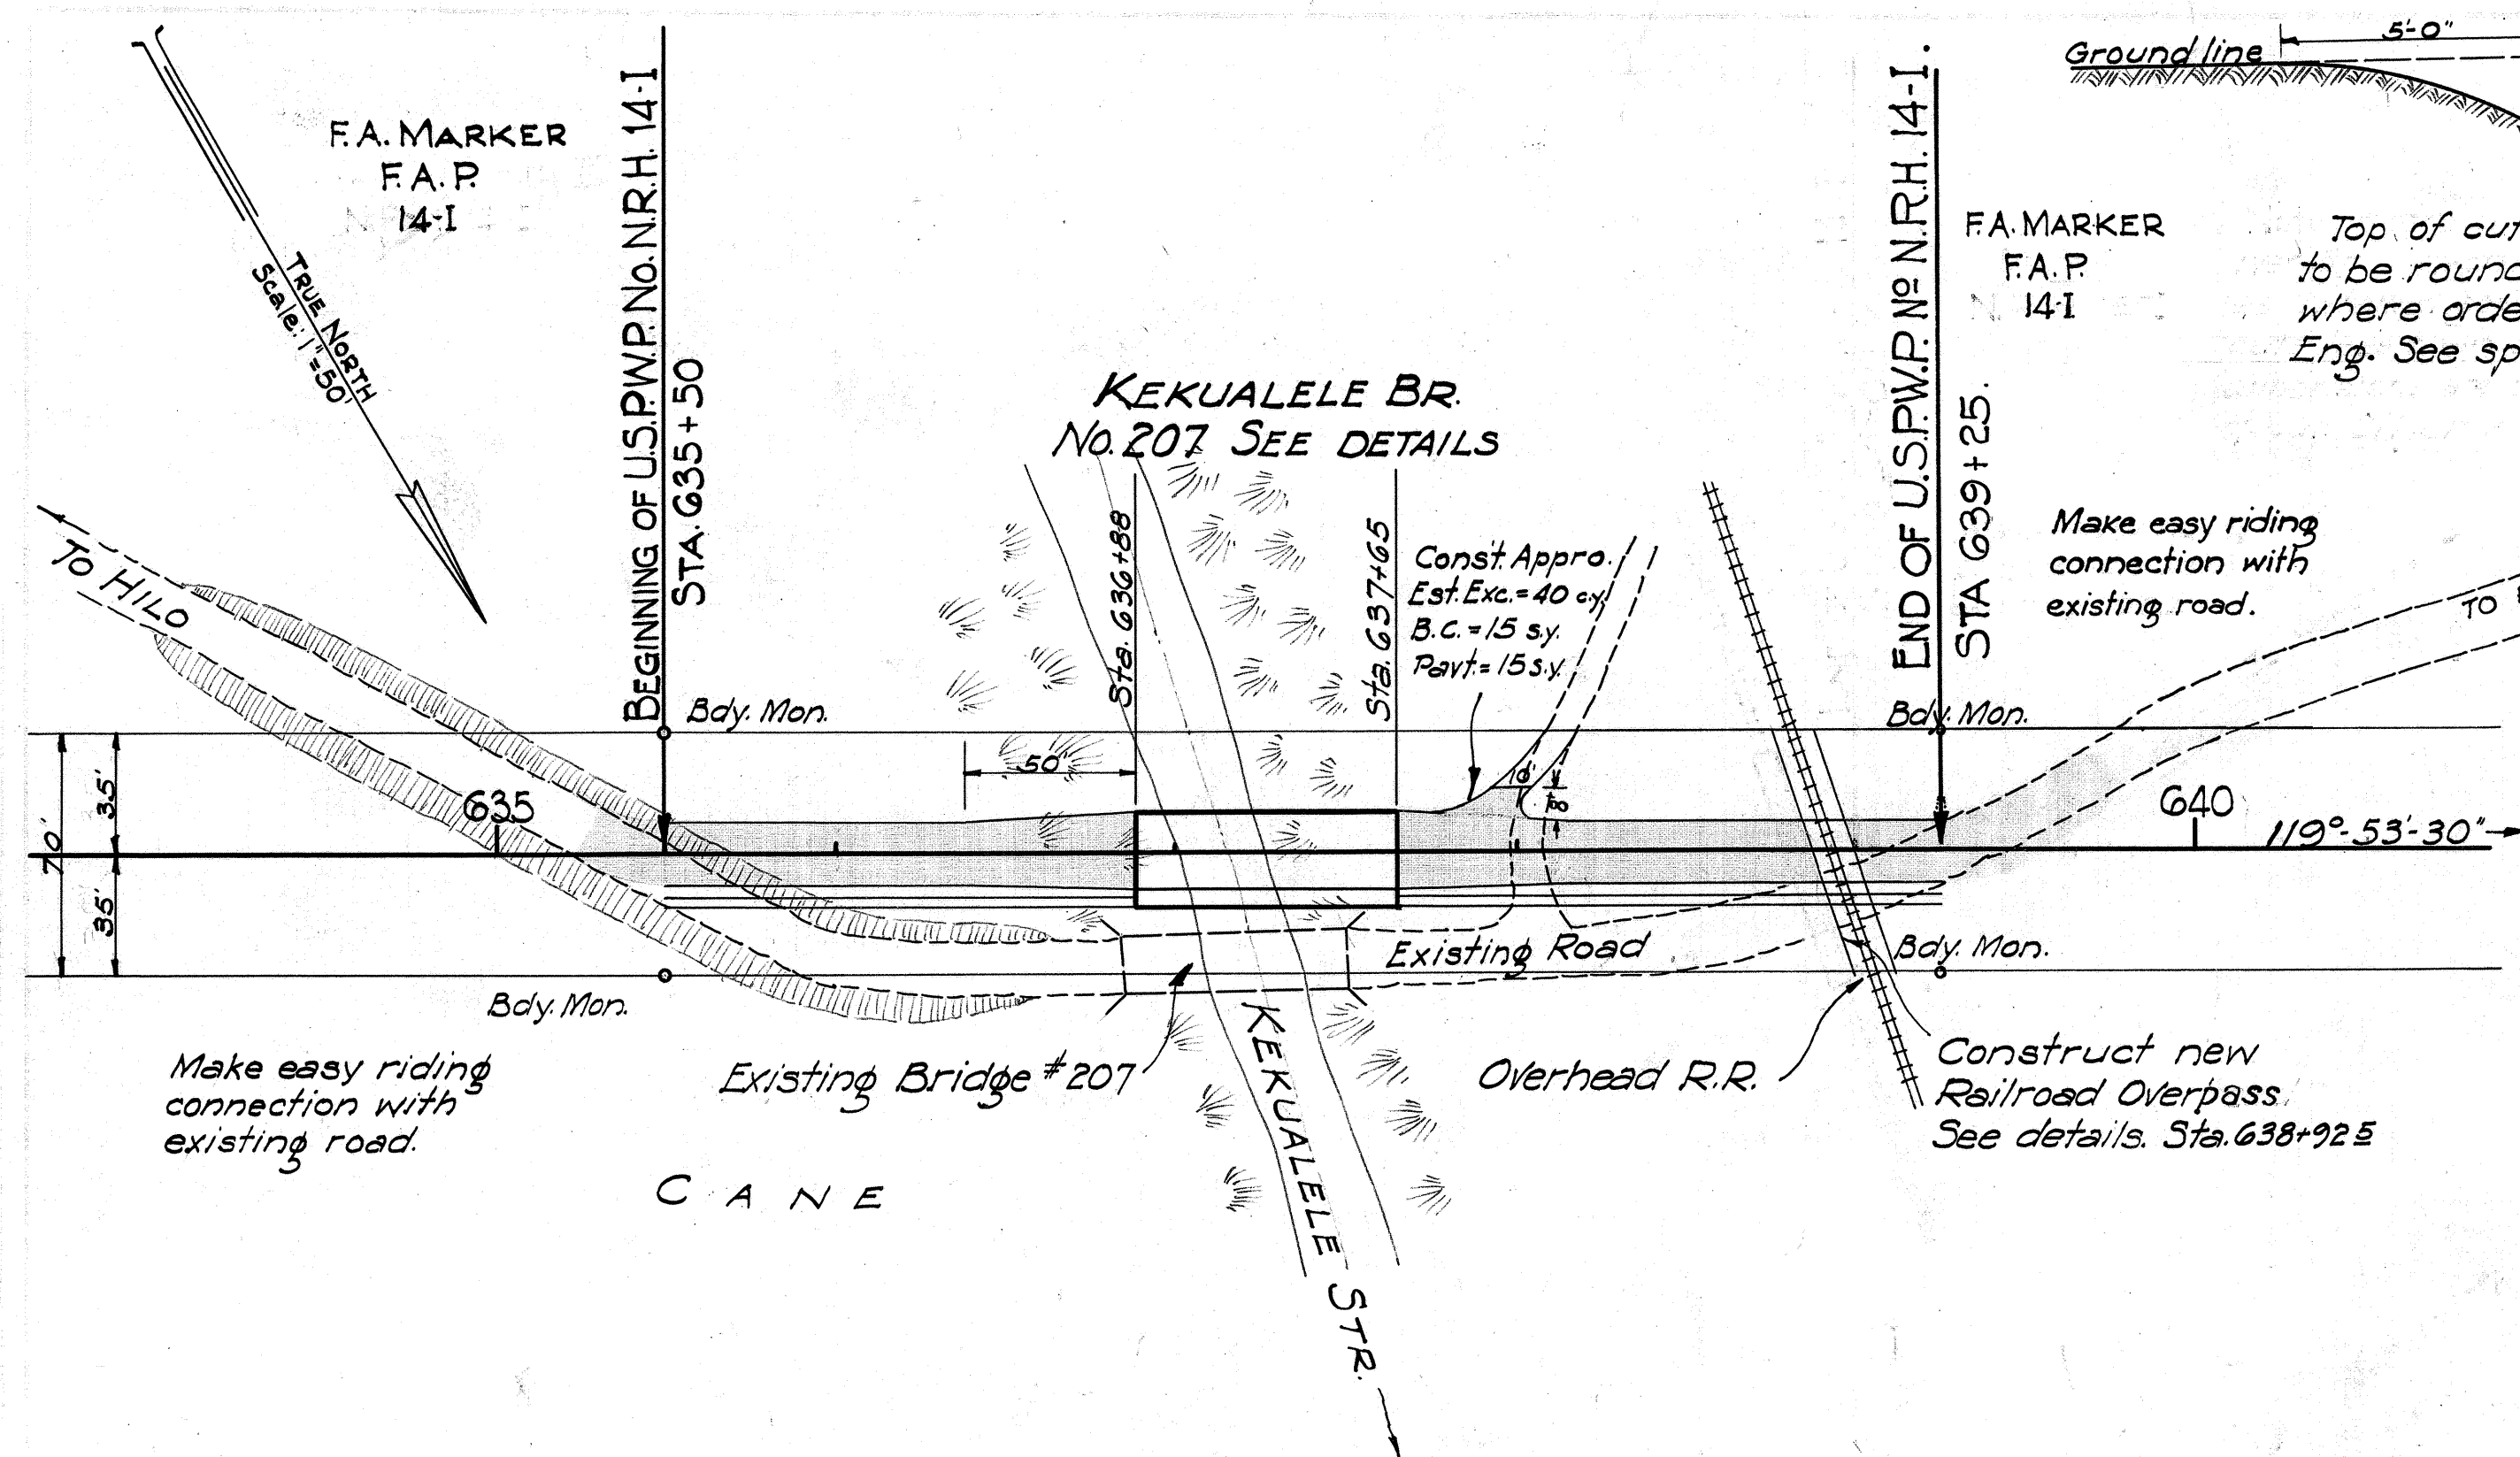