


DATE: Feb. 1936  
 BY: G. D. Kobatake  
 SURVEYED: G. D. Kobatake  
 NOTE BOOK: A. A. You  
 AREAS CHECKED: G. D. Kobatake

DATE:   
 BY:   
 SURVEYED:   
 NOTE BOOK:   
 AREAS CHECKED:

| FED. ROAD DIST. NO. | STATE | FED. AID PROJ. NO. | FISCAL YEAR | SHEET NO. | TOTAL SHEETS |
|---------------------|-------|--------------------|-------------|-----------|--------------|
| Hawaii              | Haw.  | 148 (1935)         | 1936        | 97        | 7            |

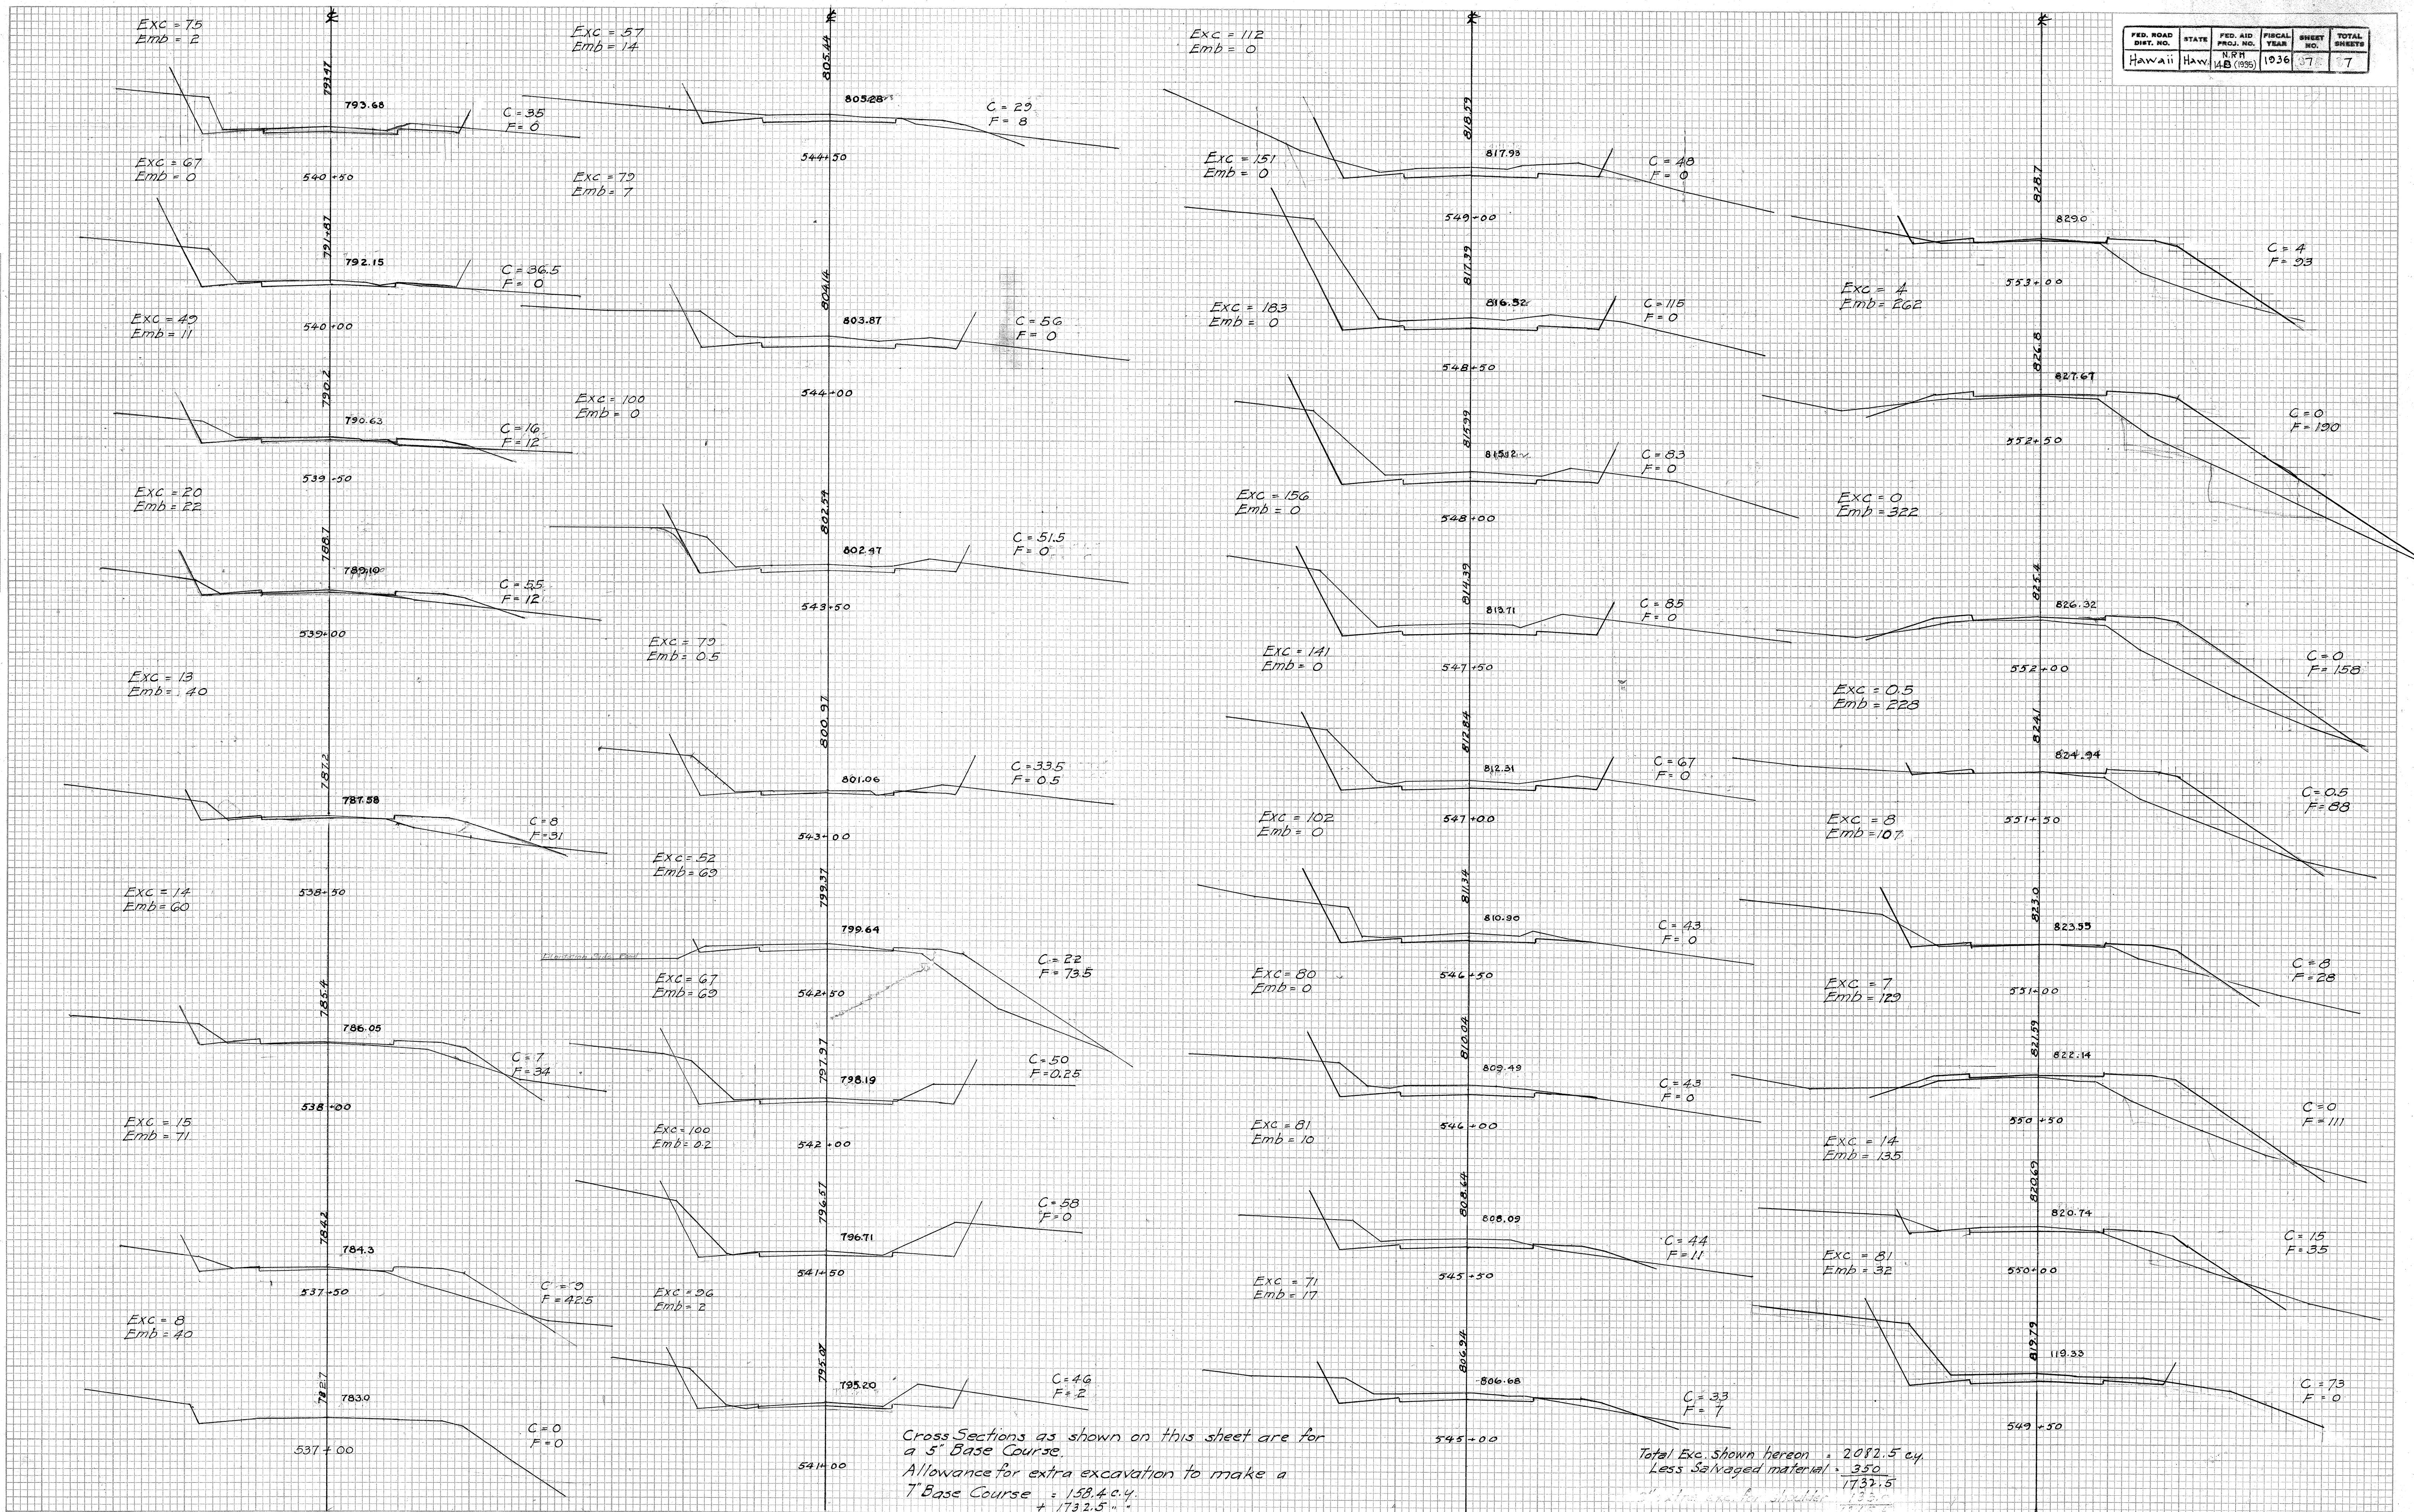

4377.7