



FED. ROAD DIST. NO.	STATE	FED. AID PROJ. NO.	FISCAL YEAR	SHEET NO.	TOTAL SHEETS
Hawaii	Haw.	N.R.H. 14B (1935)	1936	3	7

L. Payne
G. F. Kobalake
H. F. Criss

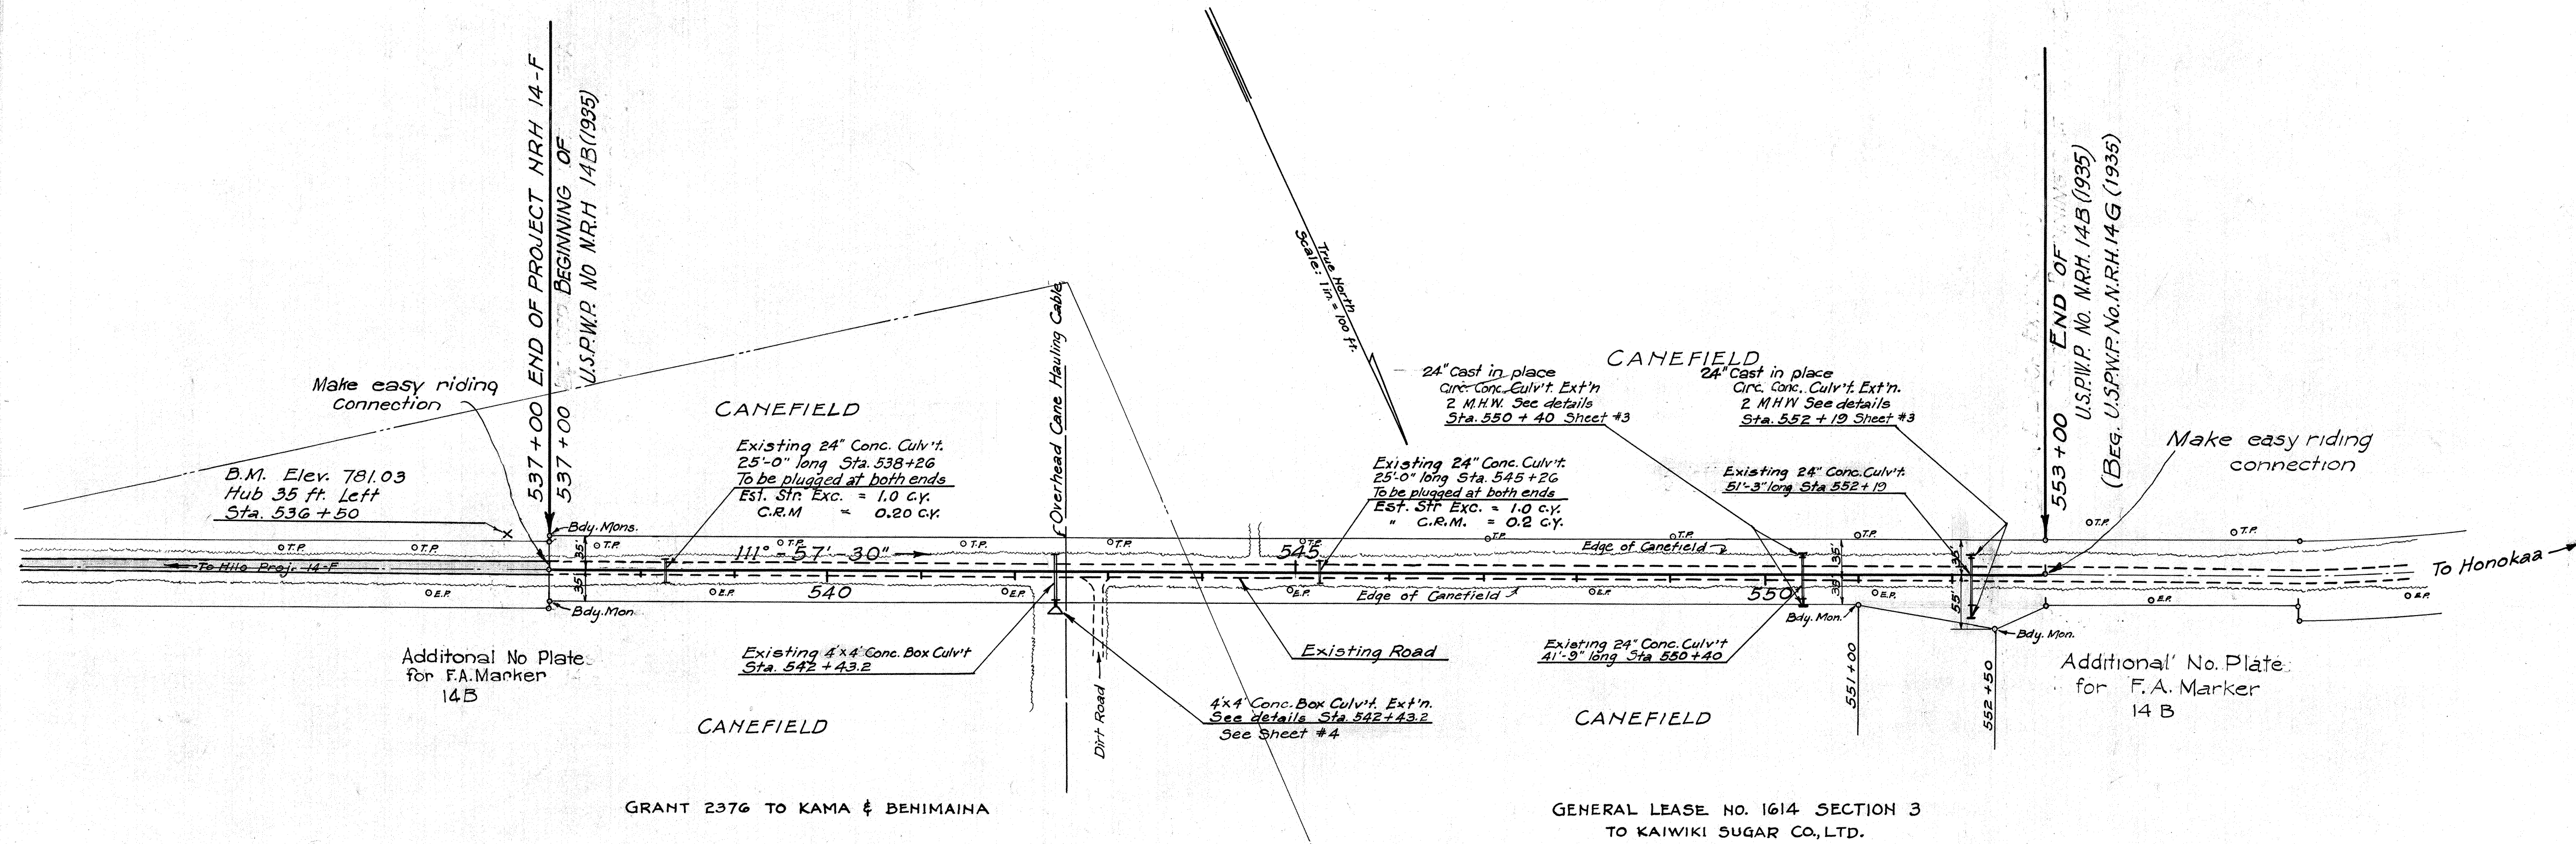

L. Payne
G. F. Kobalake
H. F. Criss

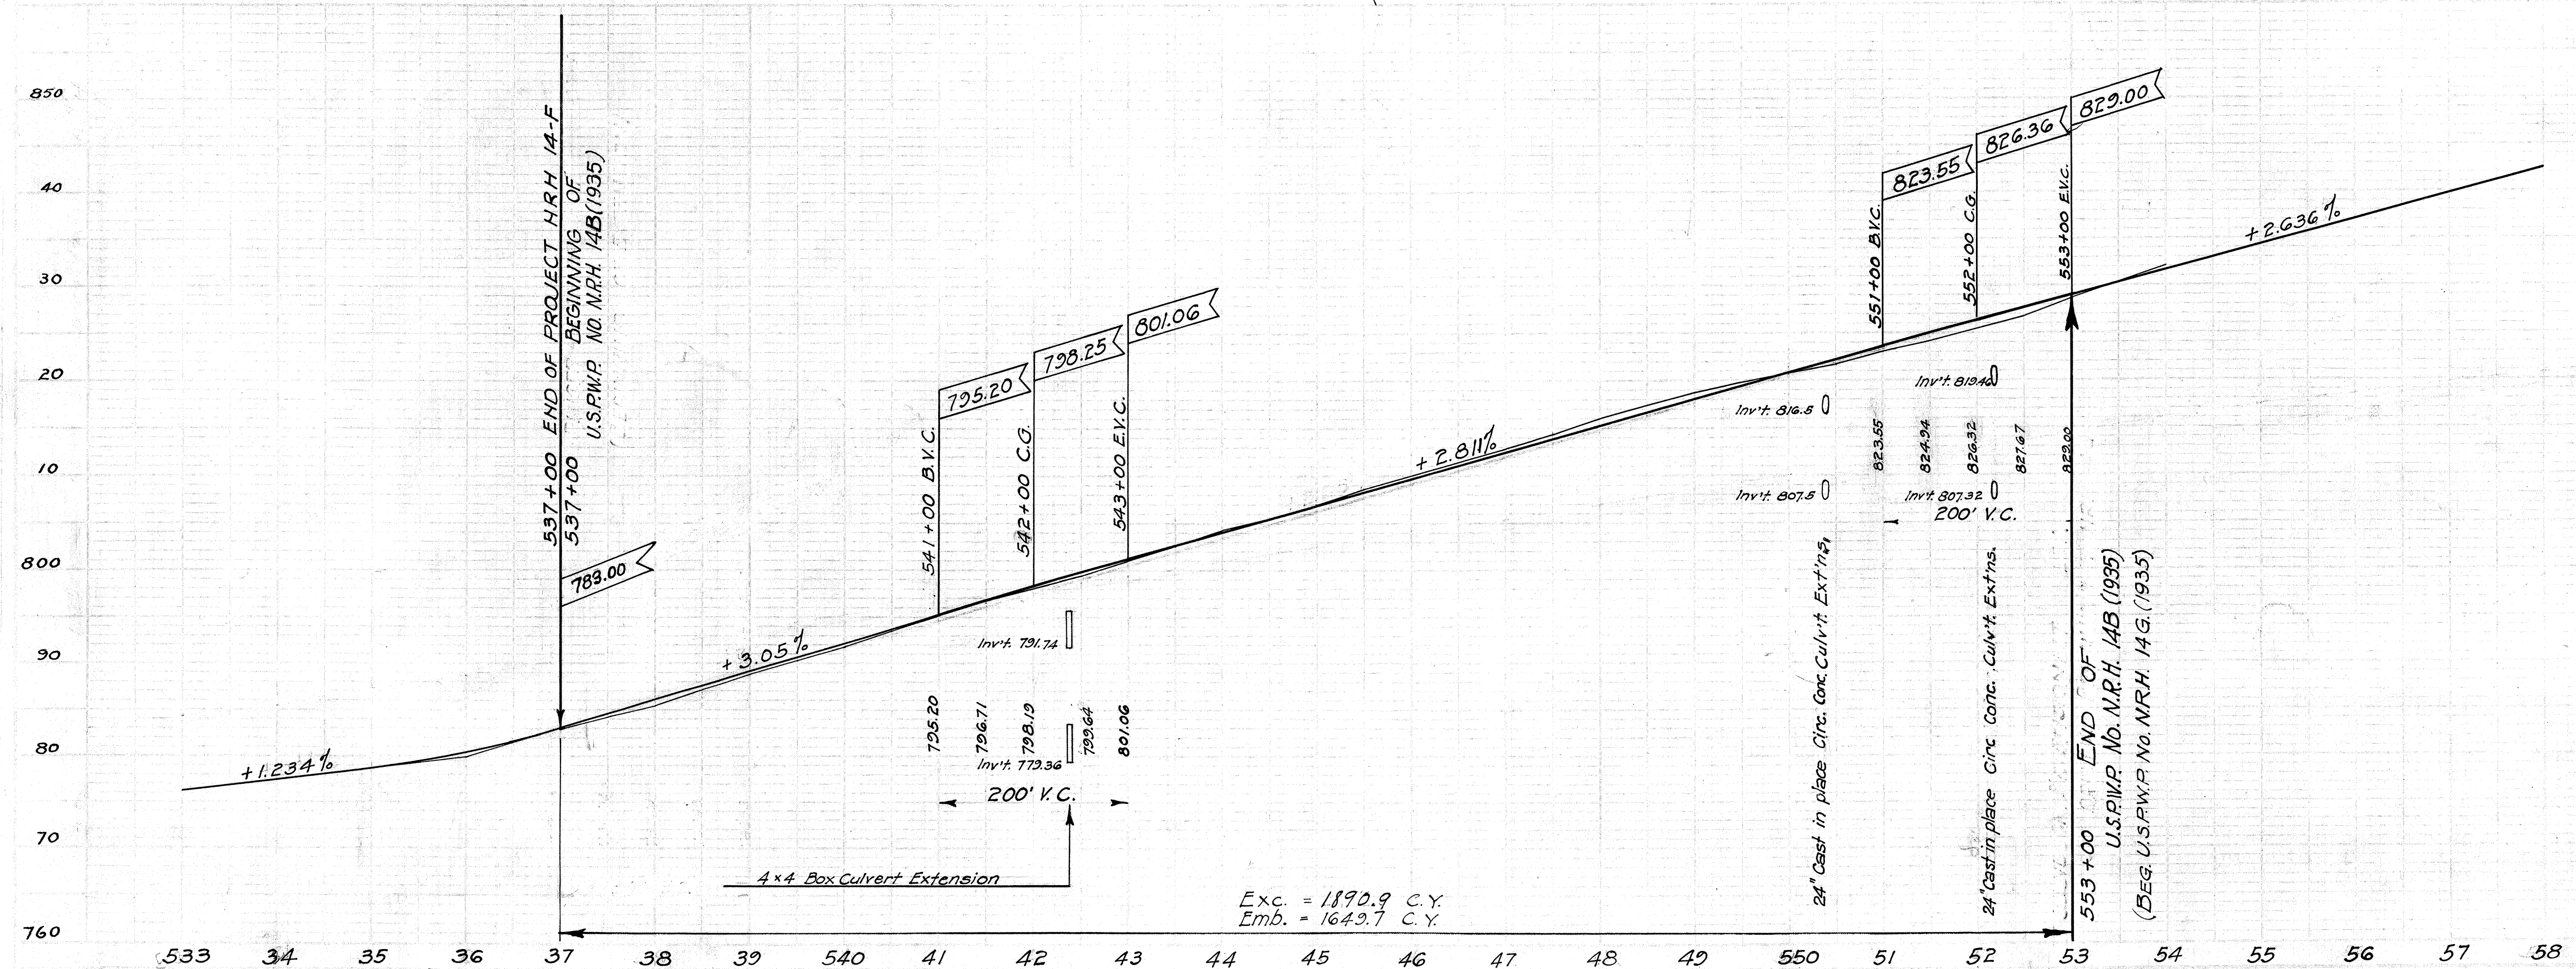

4377.3