

FED. ROAD DIST. NO.	STATE	FED. AID PROJ. NO.	FISCAL YEAR	SHEET NO.	TOTAL SHEETS
HAWAII	HAW	V.P.G.H. 14 E	1936	27A	31

SUPERSEDES SHEET 4356.27

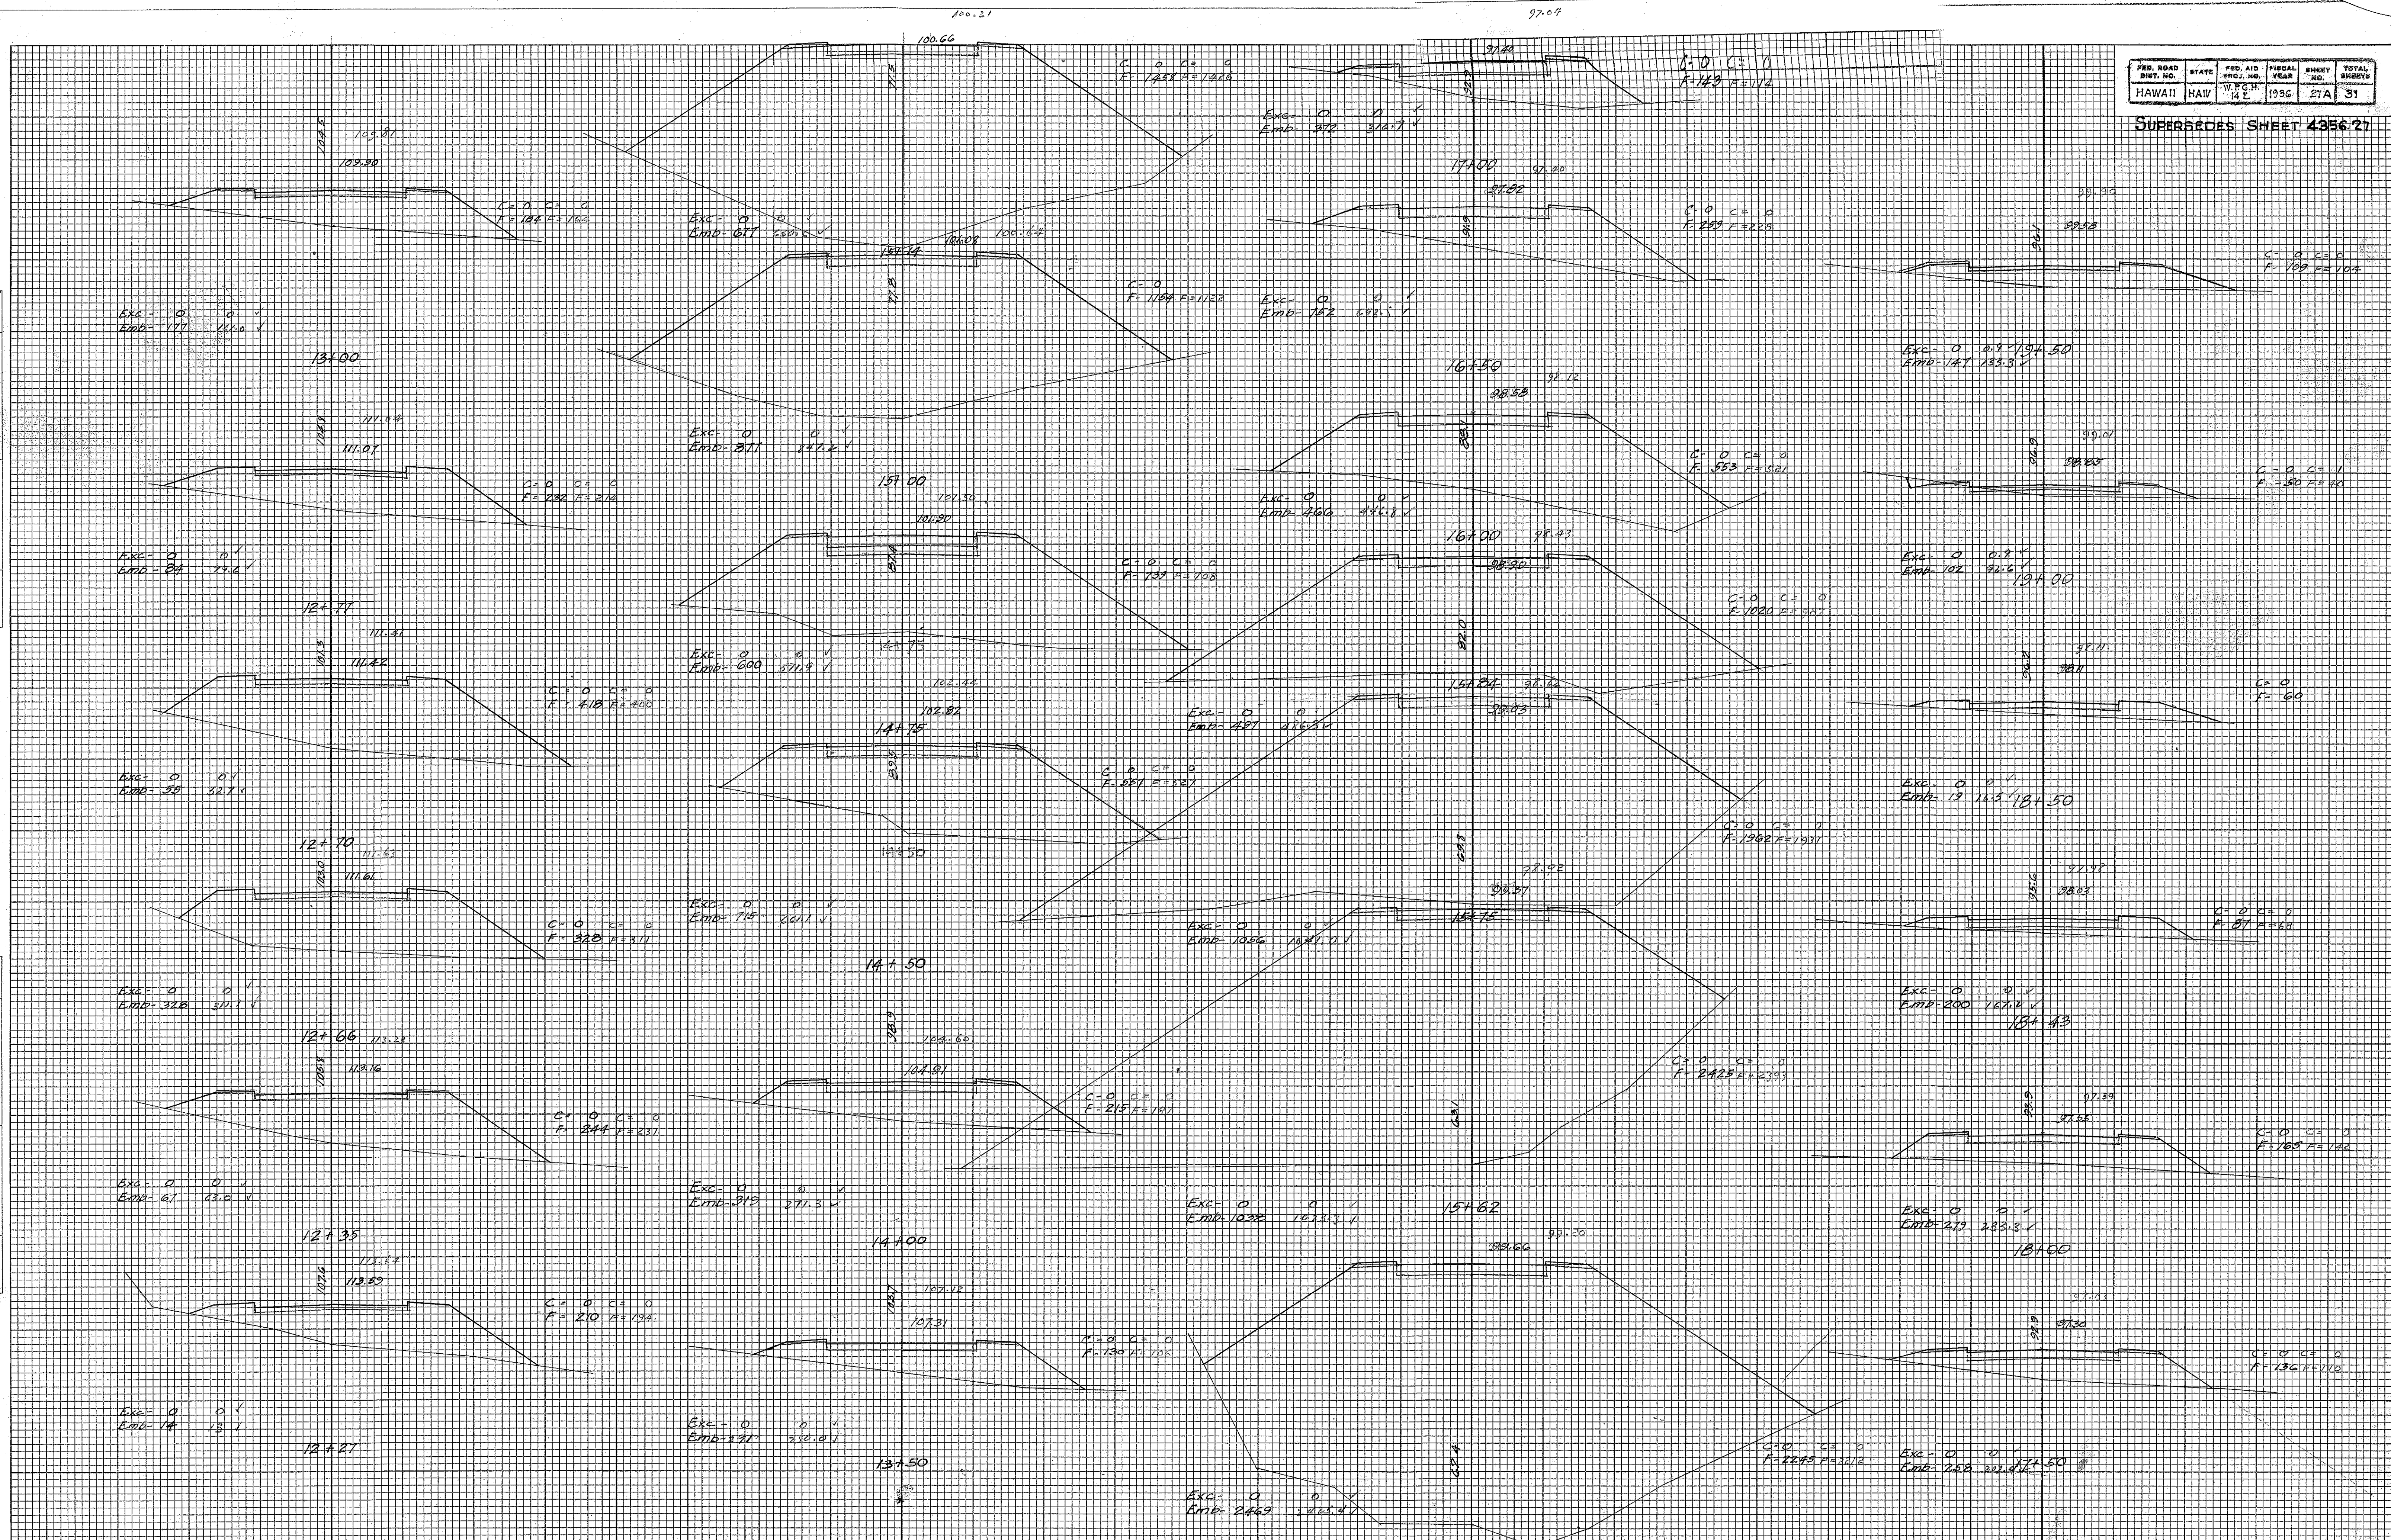
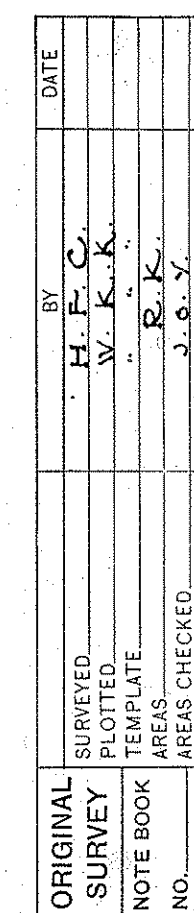
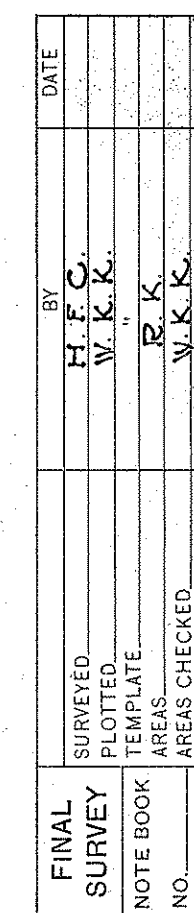


PLATE 3—CROSS SECTION O. P. R. & R. E. STANDARD
KEUFFEL & ESSER CO., NEW YORK.

923000


4 3 5 6 . 2 7 A

FED. ROAD DIST. NO.	STATE	FED. AID PROJ. NO.	FISCAL YEAR	SHEET NO.	TOTAL SHEETS
HAWAII	HAW	W.P.H. 4 E	1996	28A	31

SUPERSEDES SHEET 4356.28


DATE	BY	FINAL SURVEY	SURVEYED	PLOTTED	TEMPERATURE	NOTE BOOK	AREAS CHECKED
	H. F. C.						
	W. K. K.						
	B. K.						

DATE	BY	ORIGINAL SURVEY	SURVEYED	PLOTTED	TEMPERATURE	NOTE BOOK	AREAS CHECKED
	H. F. C.						
	W. K. K.						
	B. K.						

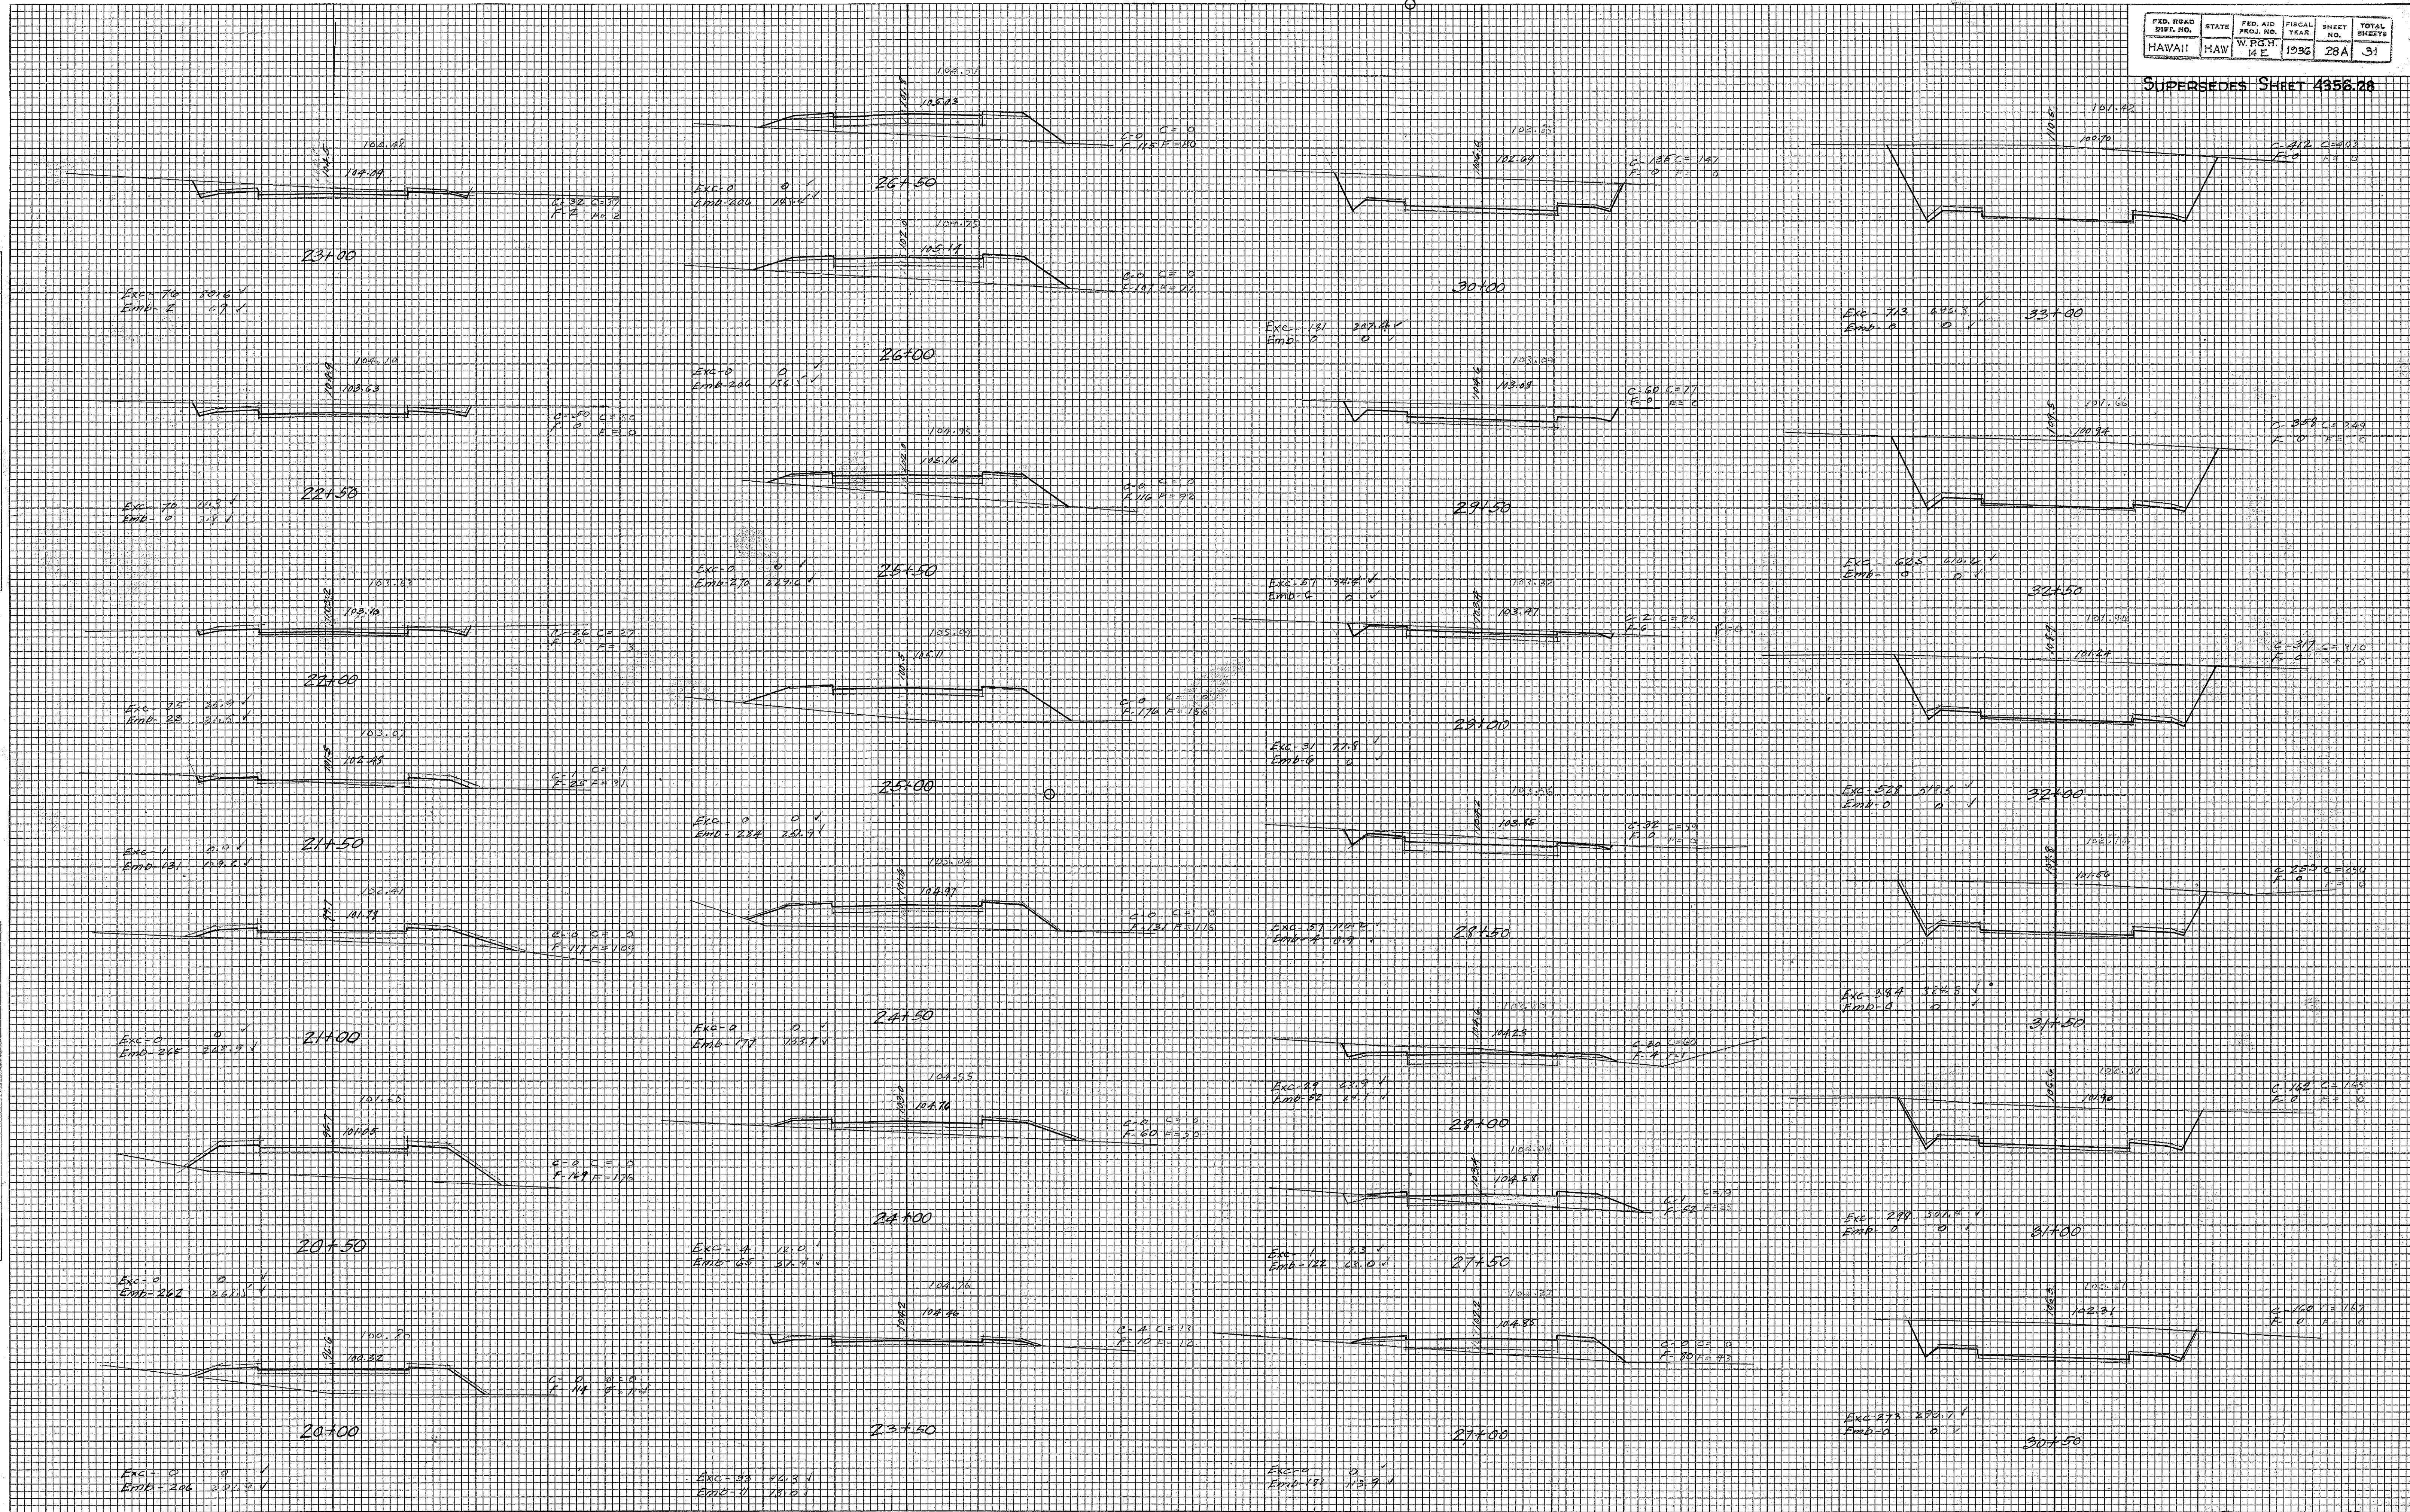


SUPERSEDES SHEET 4356.29

ORIGINAL SURVEY				DATE
NOTE BOOK	SURVEYED	BY		
	PLOTTED	H. F. C.		
	TEMPLATE	W. K. K.		
	AREAS	W. K. K.		
NO. _____	AREAS CHECKED	P. K. Y.		

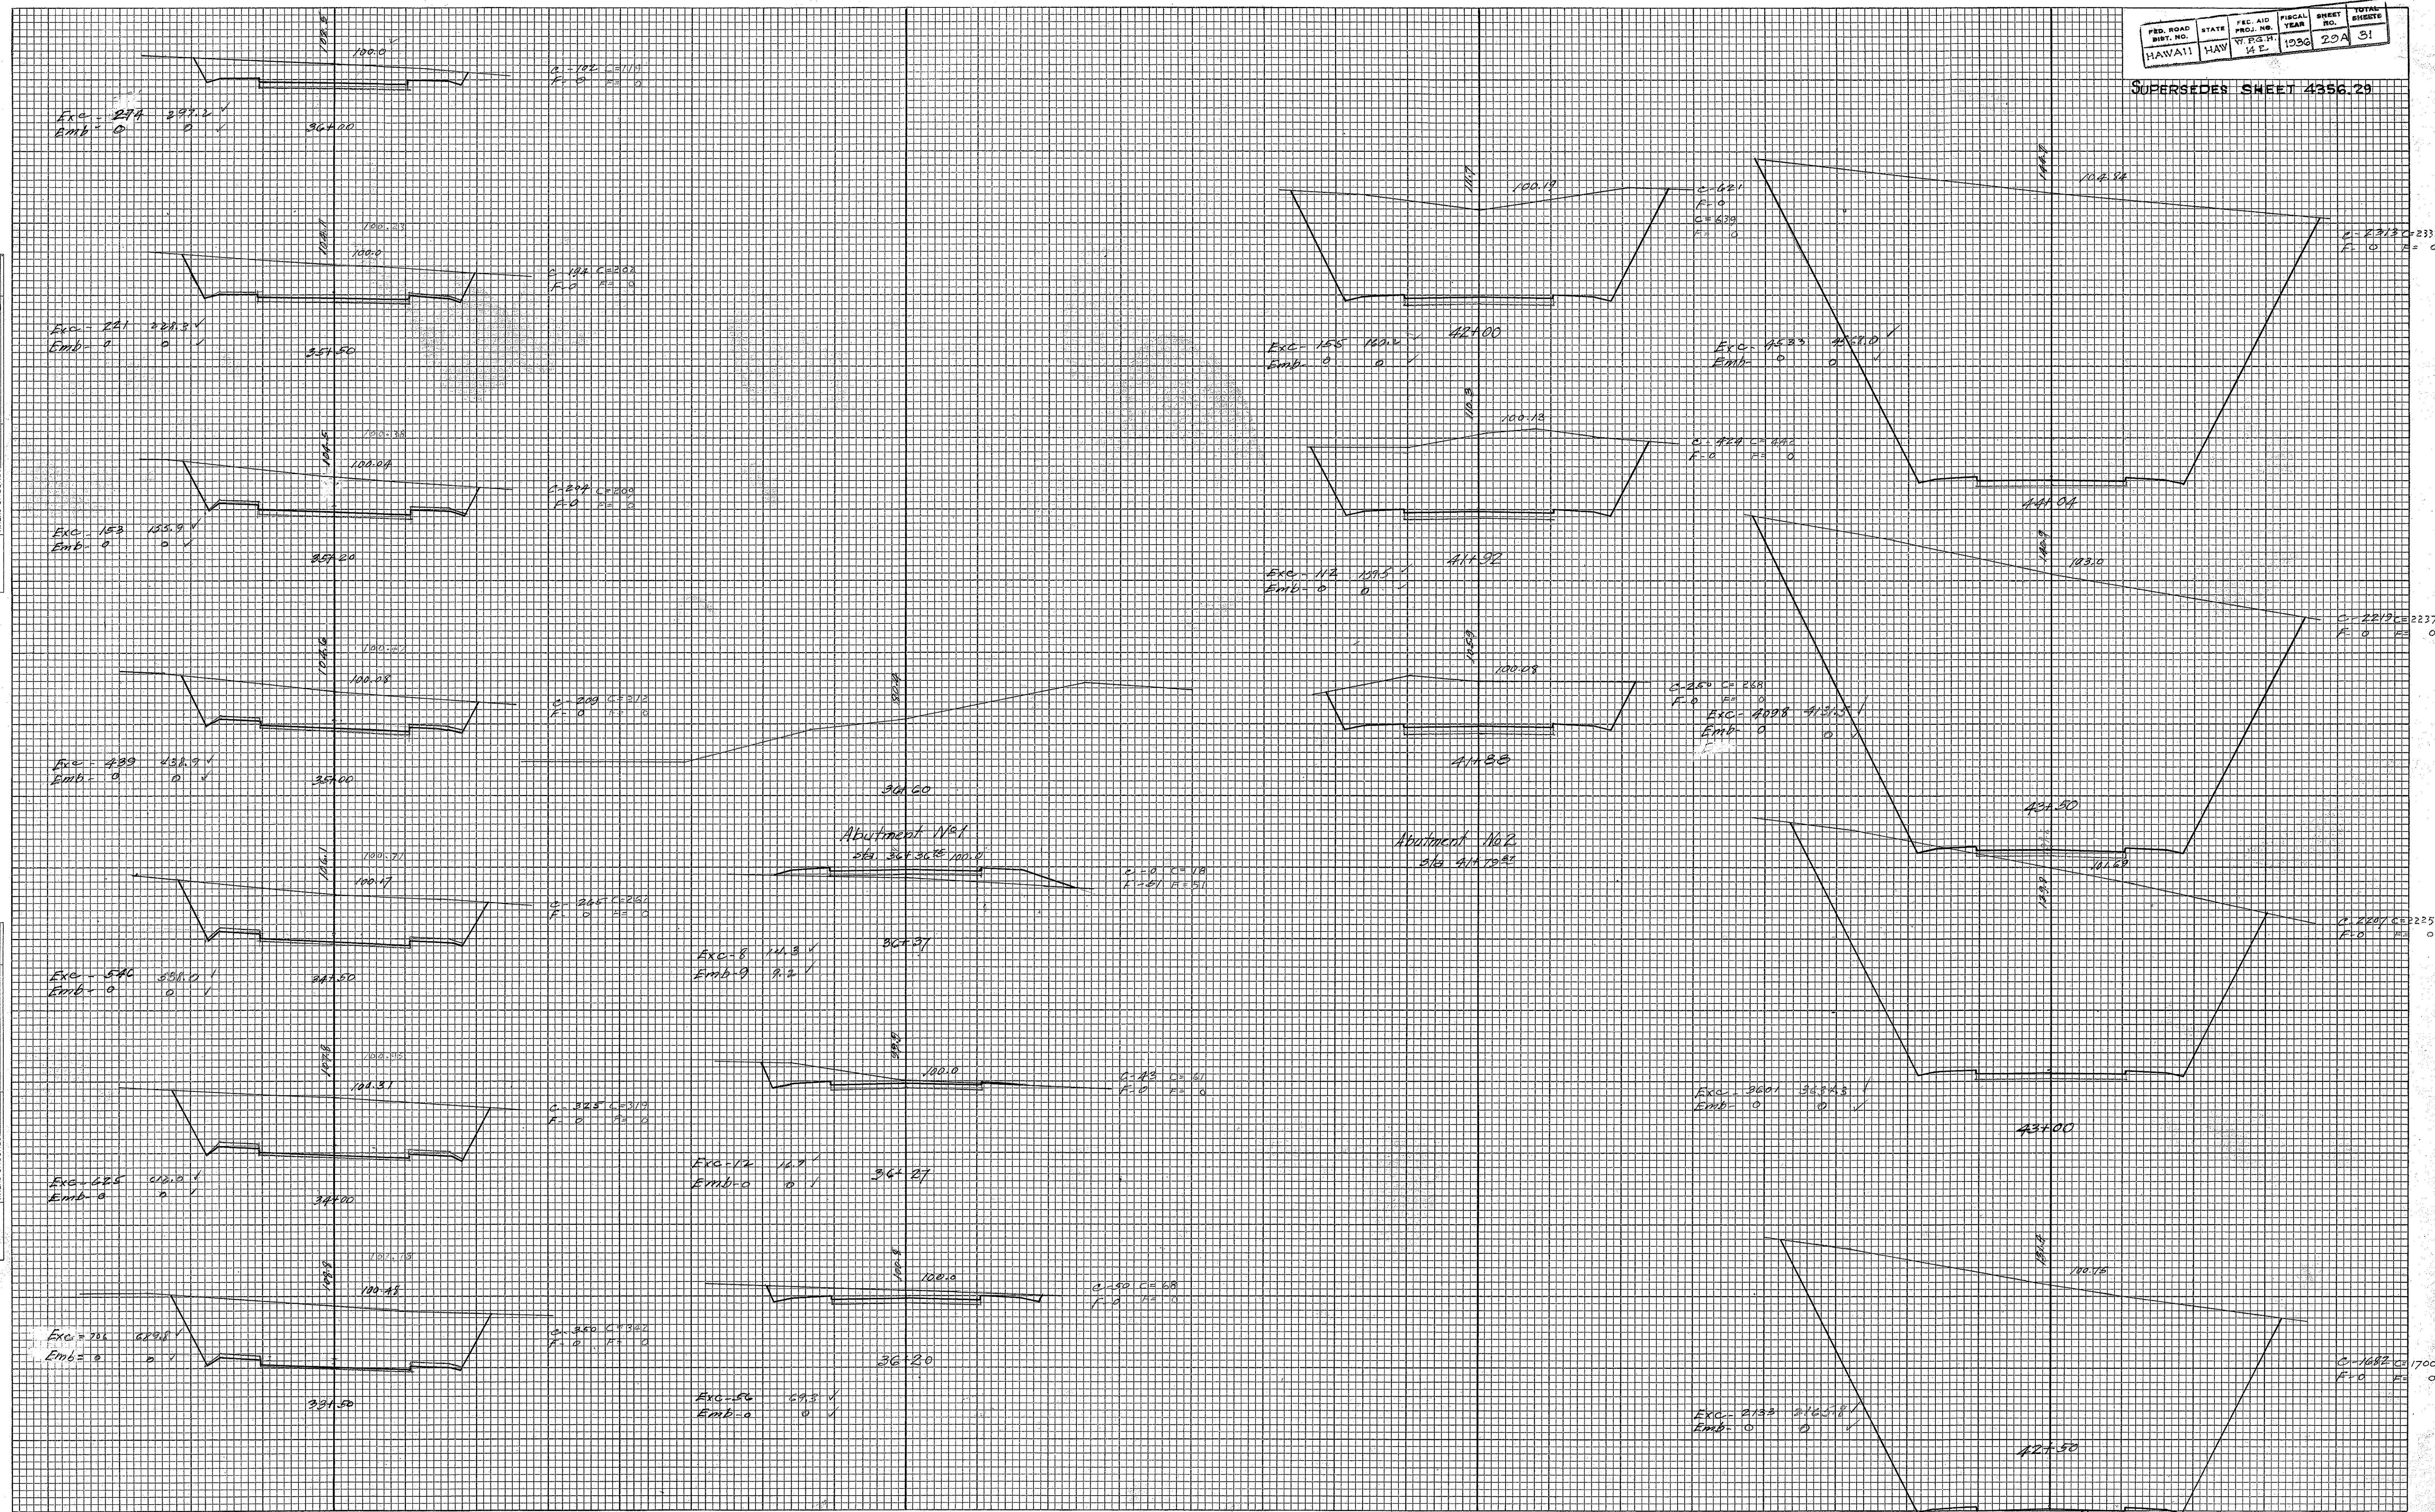

FINAL SURVEY		BY	DATE
SURVEYED		H. F. C.	Dec. 35
PLOTTED		W. K. K.	Dec. "
TEMP. _____		E. J. S.	Jan. 36
AREAS _____		R. E. S.	" "
NO. _____	AREAS CHECKED	H. F. C.	" "

ORIGINAL SURVEY	SURVEYED PLOTTED TEMPLATE AREAS AREAS CHECKED.	BY	DATE
NOTE BOOK			
NO.			

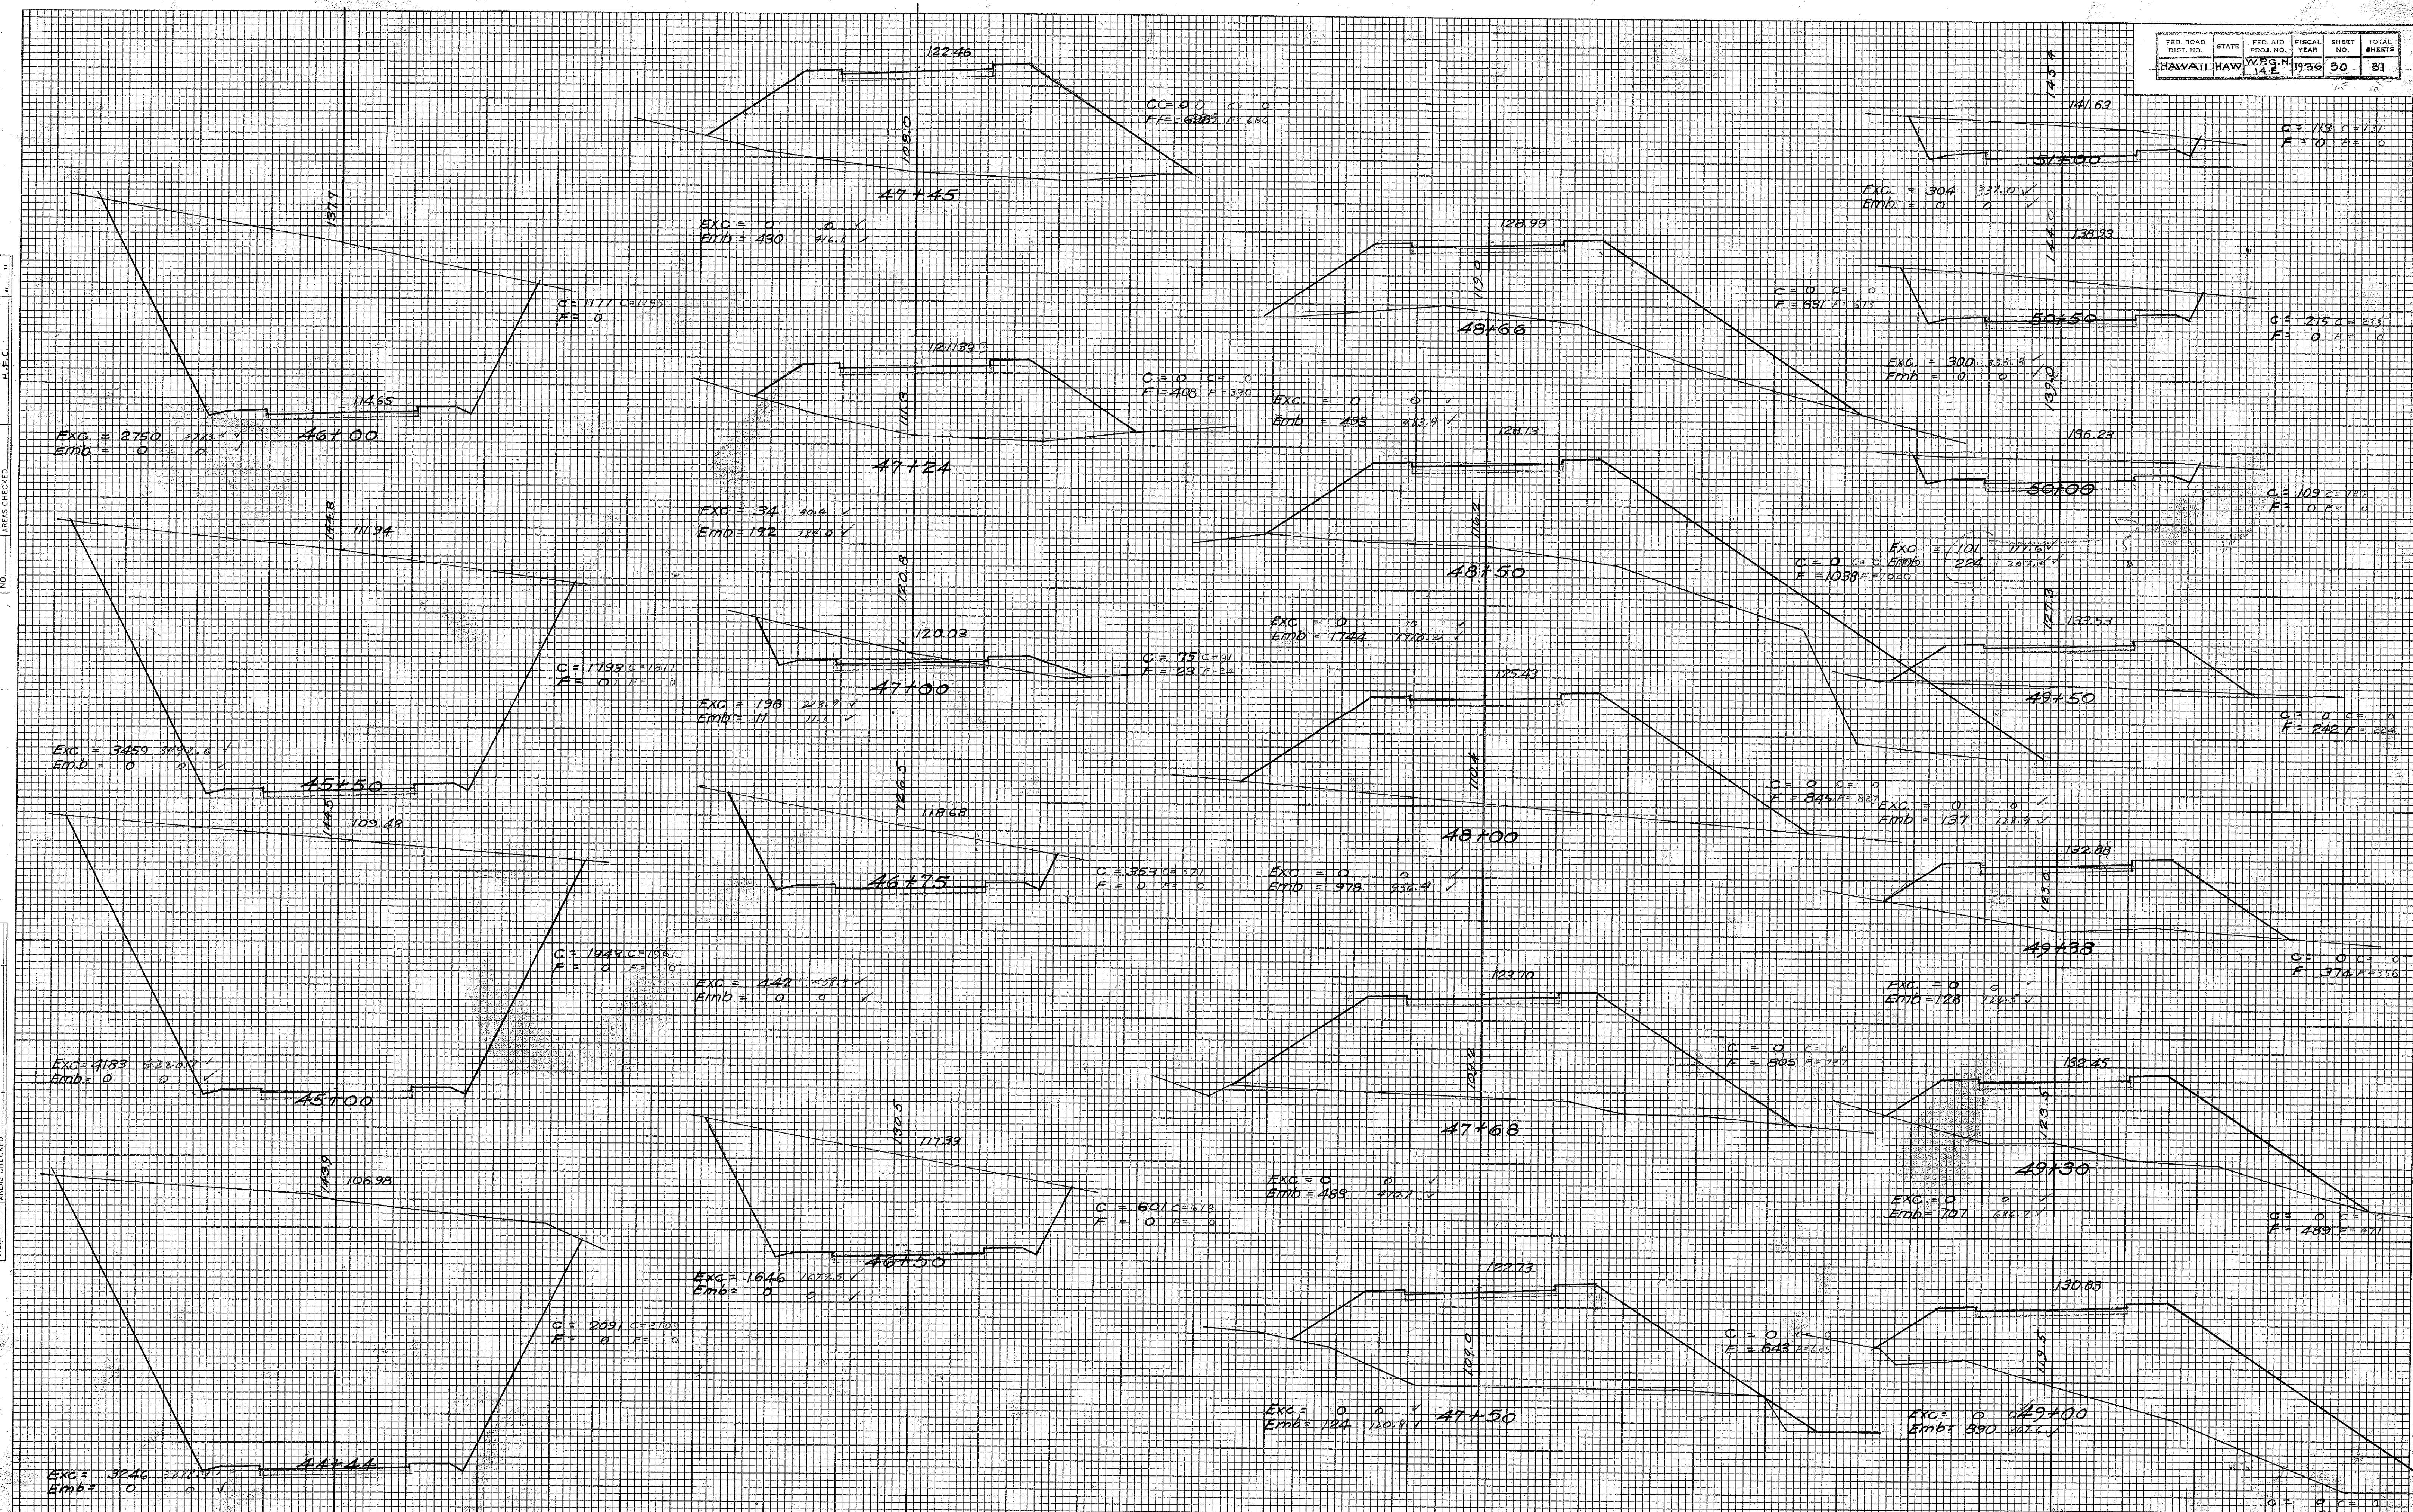

4356.30

FINAL SURVEY	SURVEY PLOT NOTE BOOK NO.	BY H.F.C. W.K.C. E.J.S. H.E.R.	DATE
			Dec. 26 Jan. 26

ORIGINAL SURVEY PLOT NOTE BOOK NO.	BY	DATE

FED. ROAD DIST. NO.	STA.	FED. AID PROJ. NO.	FISCAL YEAR	SHEET NO.	TOTAL SHEETS
HAWAII	HAW	W.R.G.H. 14-E	1936	31	31

