
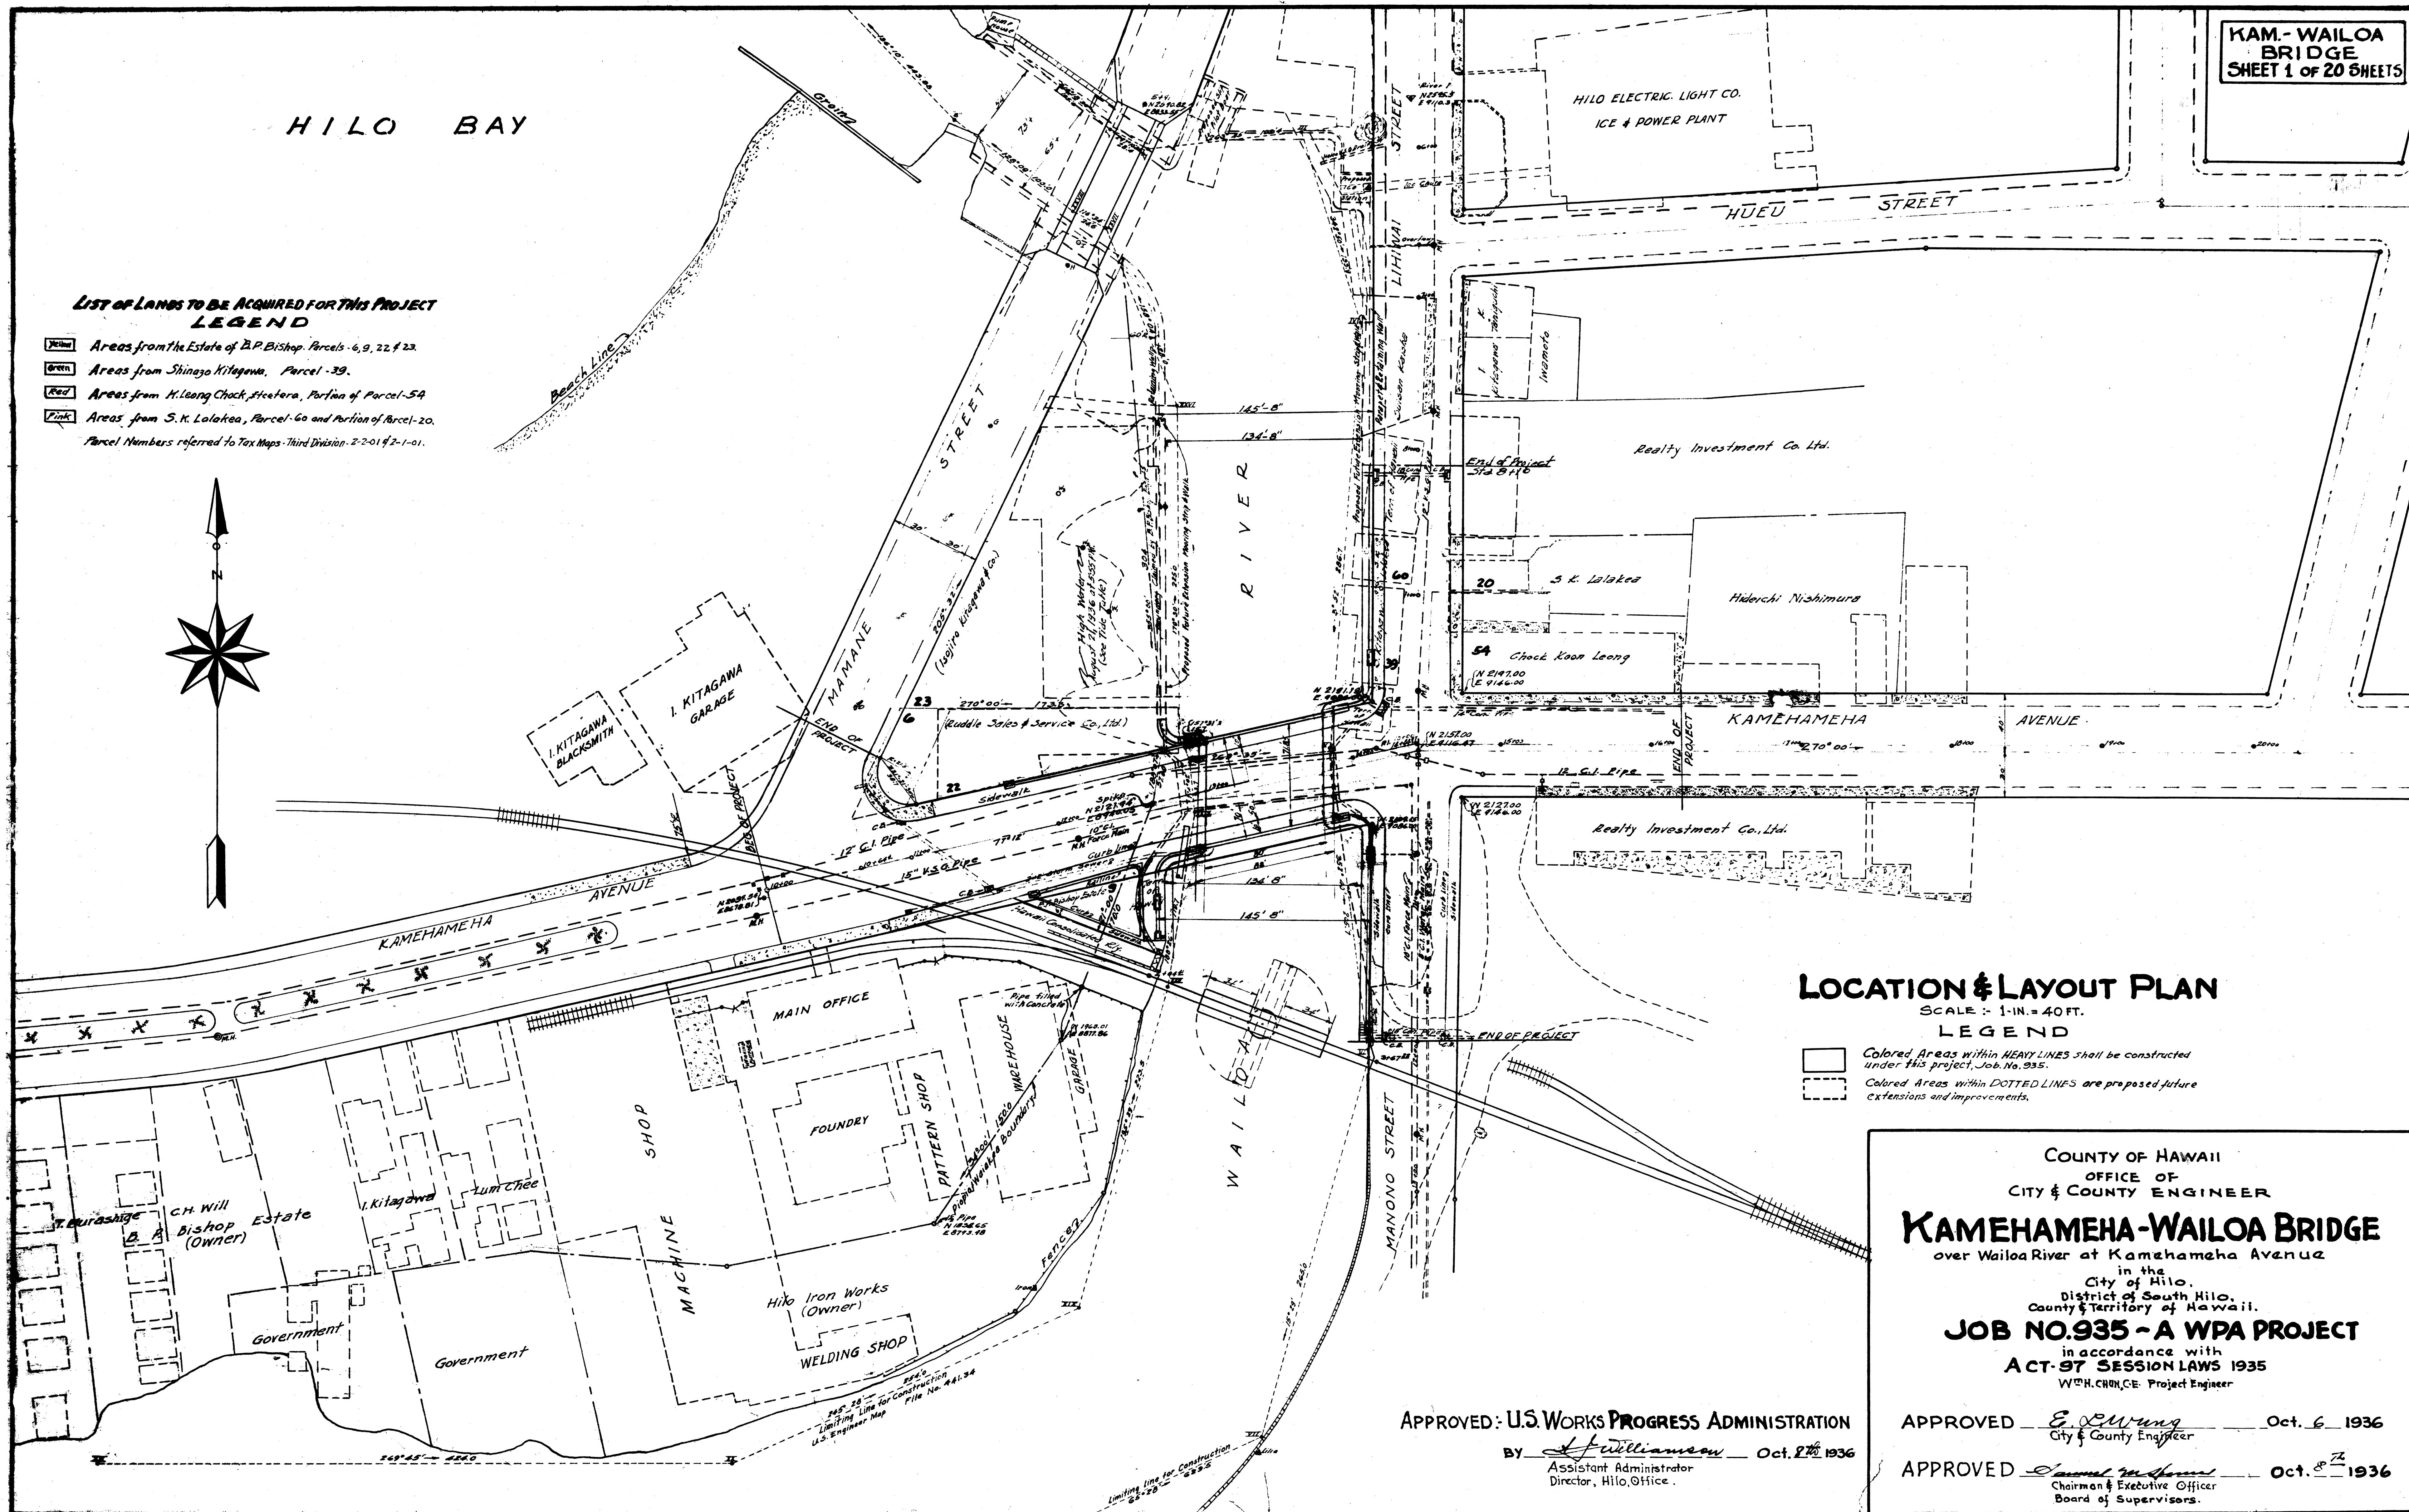


H I L O B A Y

**LIST OF LANDS TO BE ACQUIRED FOR THIS PROJECT
LEGEND**

- Yellow Areas from the Estate of B.P. Bishop, Parcels - 6, 9, 22 & 23.
 - Green Areas from Shinzo Kitagawa, Parcel - 39.
 - Red Areas from H. Leong Chock, etc., etc., Portion of Parcel - 54.
 - Pink Areas from S. K. Lalakea, Parcel - 60 and Portion of Parcel - 20.
- Parcel Numbers referred to Tax Maps - Third Division - 2-2-01 & 2-1-01.

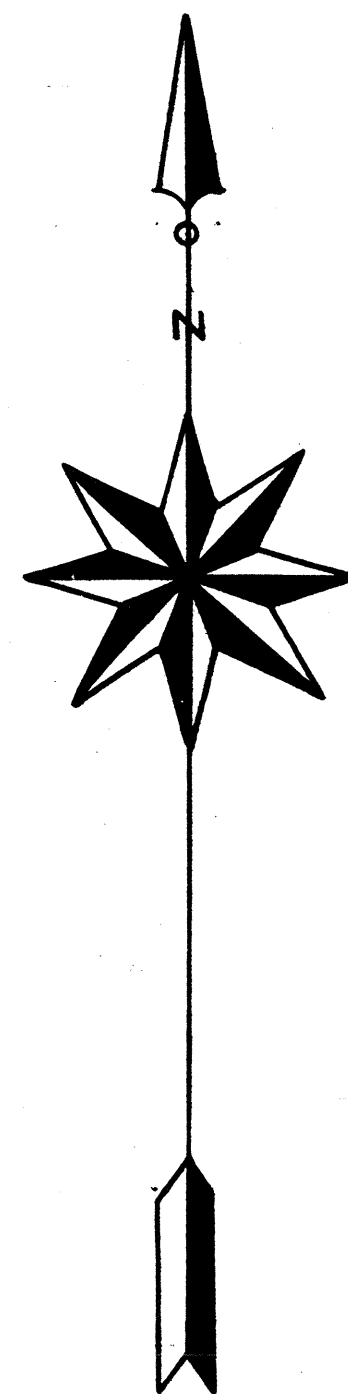

LOCATION & LAYOUT PLAN

SCALE: 1-IN. = 40 FT.

LEGEND

- Colored Areas within HEAVY LINES shall be constructed under this project, Job No. 935.
- Colored Areas within DOTTED LINES are proposed future extensions and improvements.

COUNTY OF HAWAII
OFFICE OF
CITY & COUNTY ENGINEER

KAMEHAMEHA-WAILOA BRIDGE

over Wailoa River at Kamehameha Avenue

in the
City of Hilo,
District of South Hilo,
County & Territory of Hawaii.

JOB NO. 935 - A WPA PROJECT

in accordance with
ACT. 97 SESSION LAWS 1935
W. H. CHUNG, Project Engineer

APPROVED: U.S. WORKS PROGRESS ADMINISTRATION

BY J. Williamson Oct. 27th 1936
Assistant Administrator
Director, Hilo, Office.

APPROVED E. C. Wong Oct. 6 1936
City & County Engineer

APPROVED Samuel W. Brown Oct. 8th 1936
Chairman & Executive Officer
Board of Supervisors.