


FED. ROAD DIST. NO.	STATE	FED. AID PROJ. NO.	FISCAL YEAR	SHEET NO.	TOTAL SHEETS
HAWAII	HAW	26-B(1)	1939	2	14
FED. ROAD DIST. NO.	STATE	FED. AID PROJ. NO.	FISCAL YEAR	SHEET NO.	TOTAL SHEETS
HAWAII	HAW	26-A	1939	2	51

REVISED: 4/27/39
REVISED: 6/6/39

Note: Tops of cut slopes are to be rounded as shown at the places indicated by the Engineer. Where cut slopes measure less than 5 ft. the 5 ft. tangent shown in the rounding of cuts shall be changed to correspond with depth of cut. Rounded tops of cuts are paid for by their length as per specifications. Materials excavated in this shaded area shall not be included for payment under the items of excavation and overhaul.

Note: In cut sections the shoulder and cutters shall be formed to the dimensions and slopes required and then the edge of the shoulders rounded off evenly as shown at no particular radius. This work shall be considered incidental to 'Unclassified Excavation.'


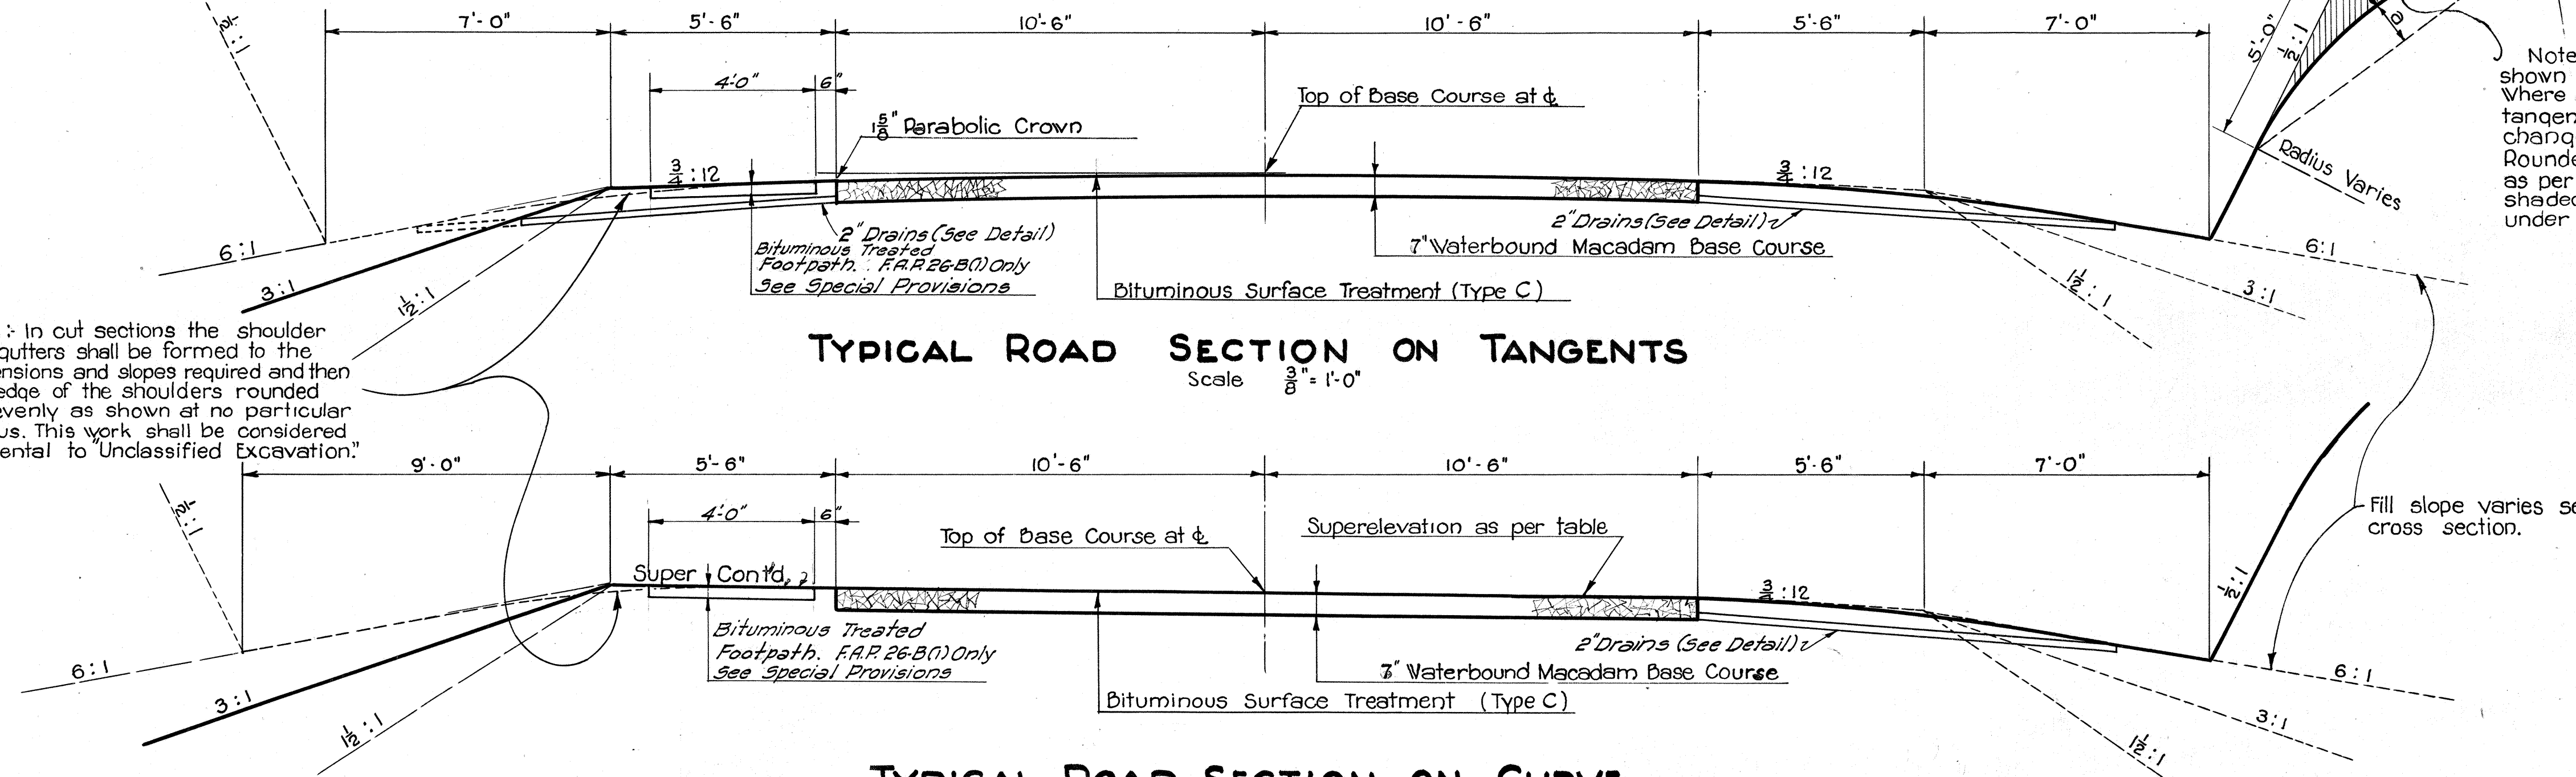


TYPICAL ROAD SECTION ON TANGENTS

Scale $\frac{3}{8}$ " = 1'-0"


TYPICAL ROAD SECTION ON CURVE

Scale $\frac{3}{8}$ " = 1'-0"

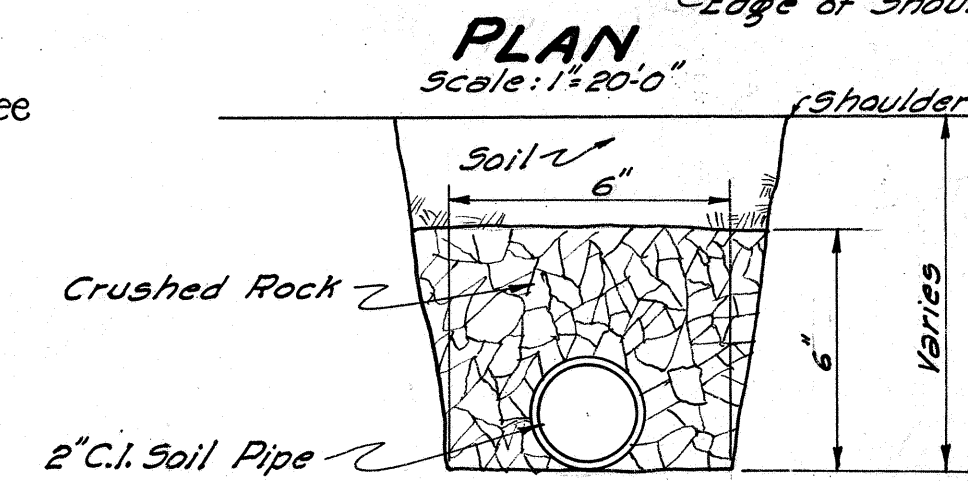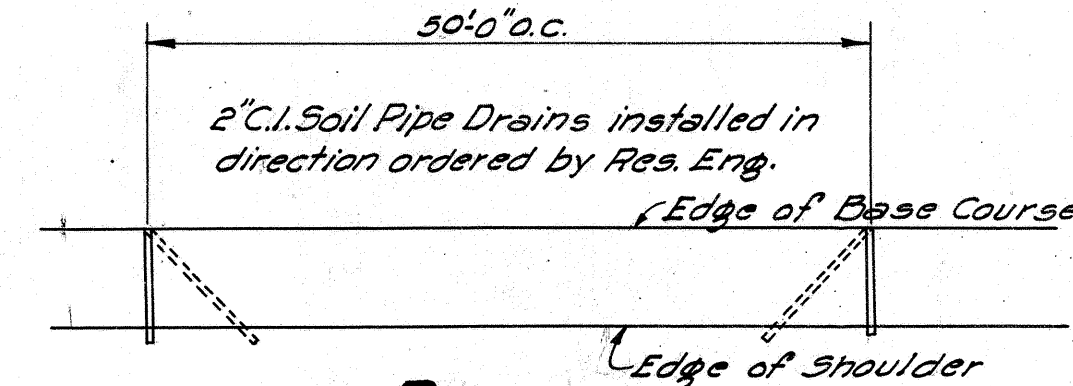

SECTION
Scale: 1" = 20'-0"


DETAIL C.I. SOIL PIPE DRAIN

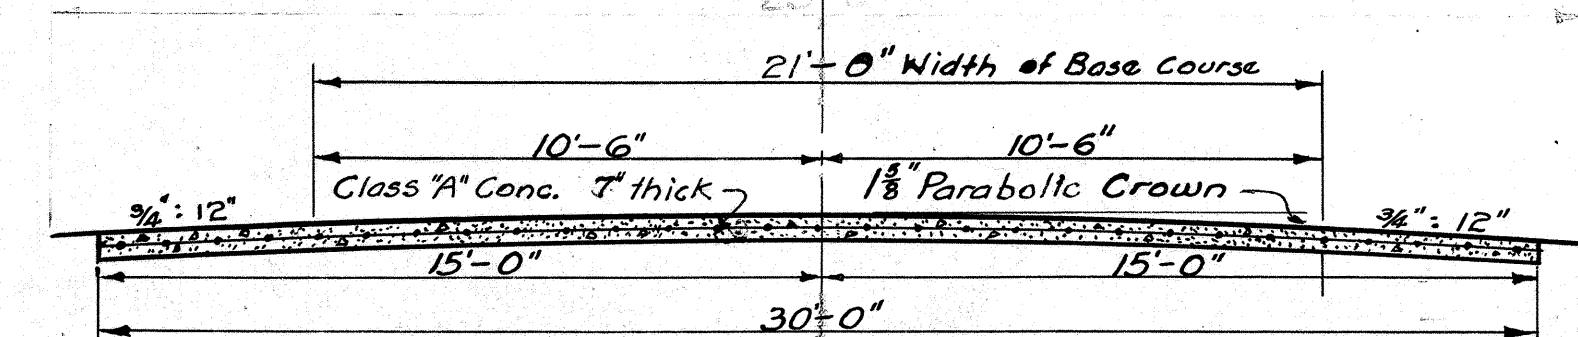

Wire Mesh Reinf: 40# 3/4 ft. to be paid for under item "Reinf. Steel other than in Bridges." Crossing to be 15'-0" wide and to conform to Base Course Grade.

DETAIL OF CONCRETE TRACTOR CROSSING.

Scale $\frac{1}{4}$ " = 1'-0"

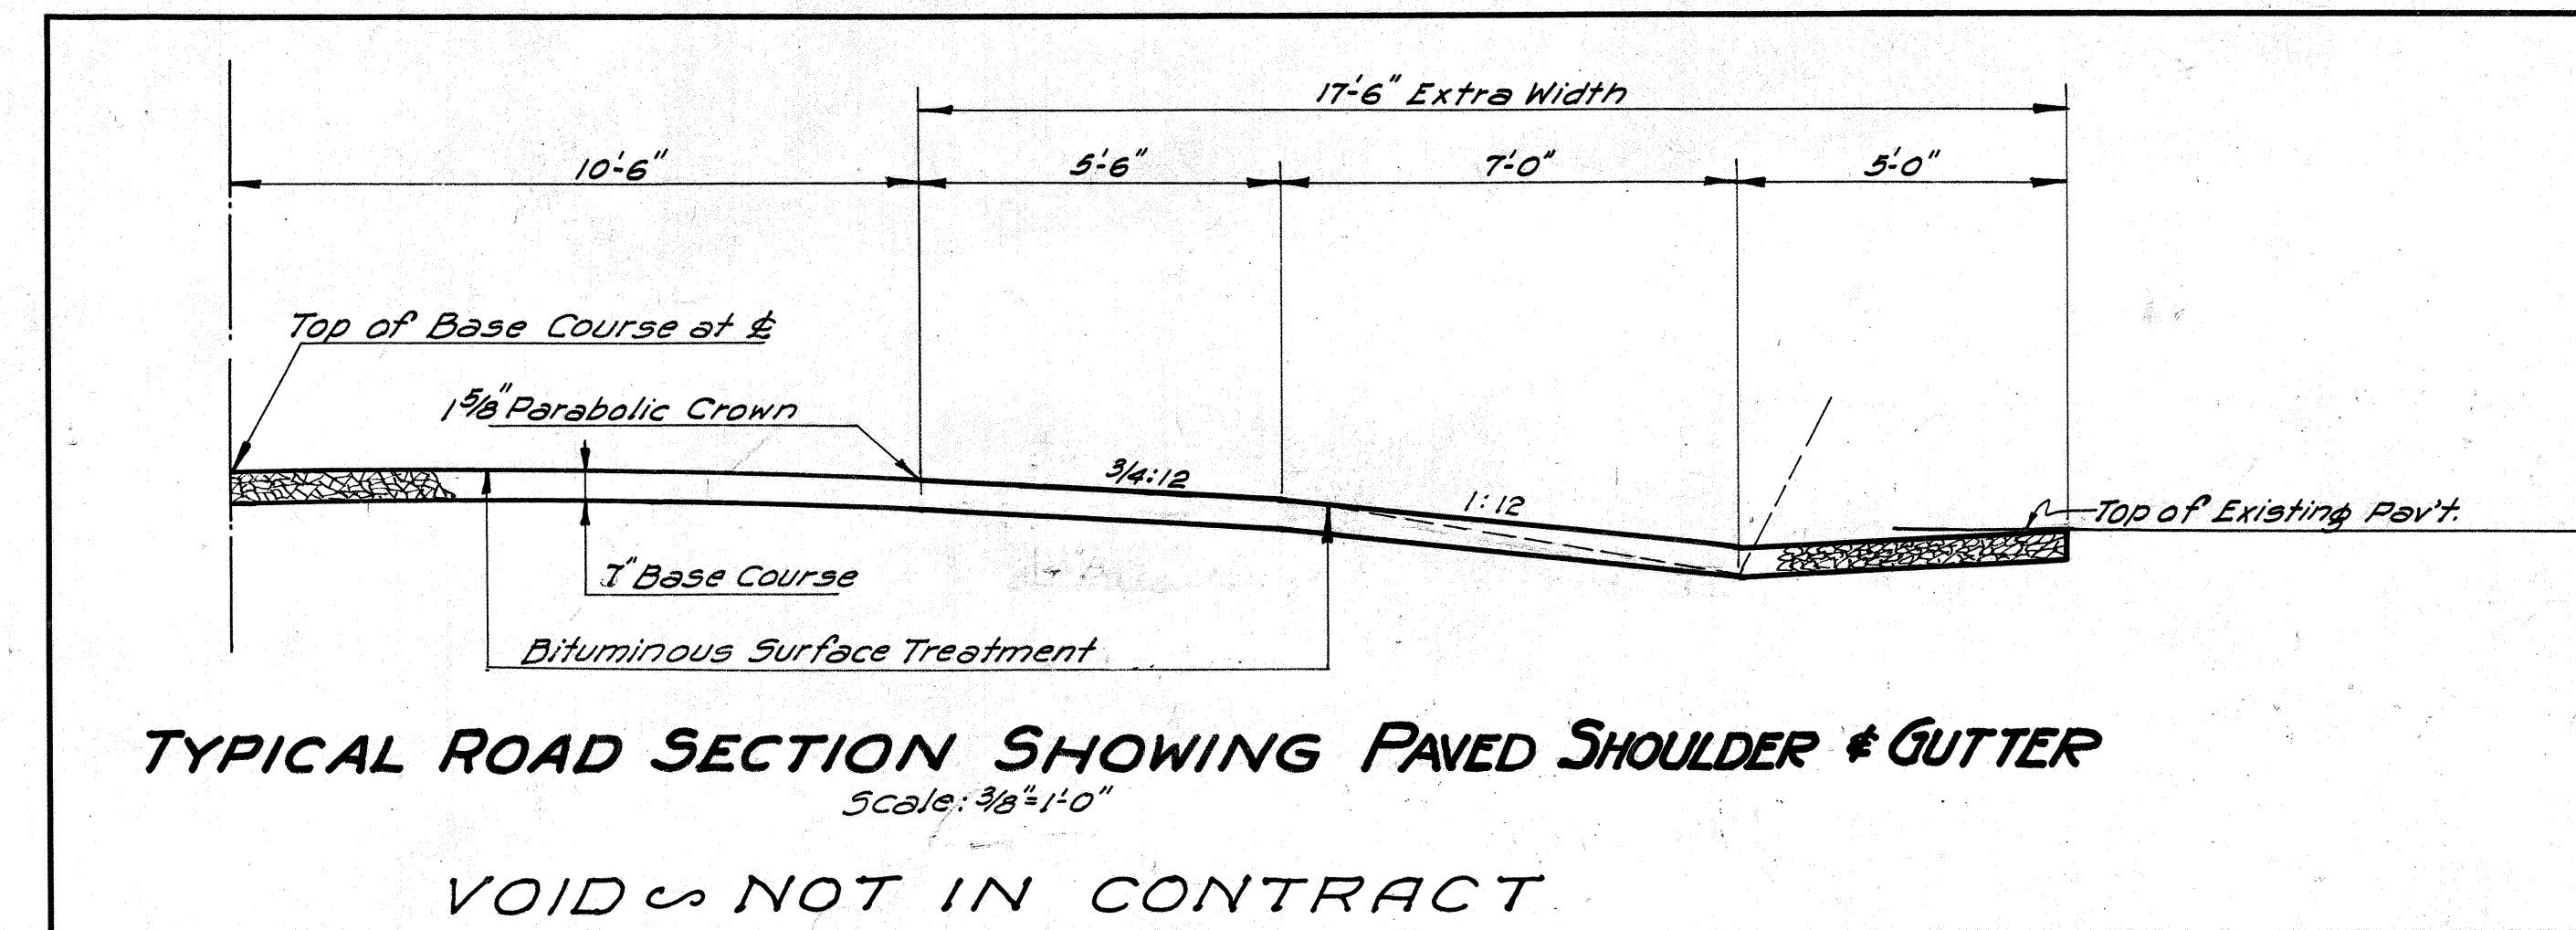

TYPICAL ROAD SECTION SHOWING PAVED SHOULDER & GUTTER

Scale: $\frac{3}{8}$ " = 1'-0"

VOID ~ NOT IN CONTRACT

NOTES ON BASE COURSE AND SURFACE TREATMENT

BASE COURSE: Waterbound Macadam Base Course 7" Compacted Thickness.

BITUMINOUS SURFACE TREATMENT: Type C.

TERRITORIAL HIGHWAY DEPARTMENT
TERRITORY OF HAWAII

TYPICAL ROAD SECTIONS

HAWAII BELT ROAD F.A.P. 26-A
F.A.G.H. 26-A
F.A.P. 26-B(1)

SHEET NO. OF SHEETS

4484.2

4442.2

4441.2

DESIGNED BY	DATE
DRAWN BY	Jan. 1937
CHECKED BY	
NOTED BY	
QUANTITIES CHECKED BY	
CHECKED BY	