



ORIGINAL SURVEY	SURVEY DATED	BY	DATE
		2008 State & 7/20/08	
		7/6/08	
		2/6/08	
		7/20/08 & 7/21/08	

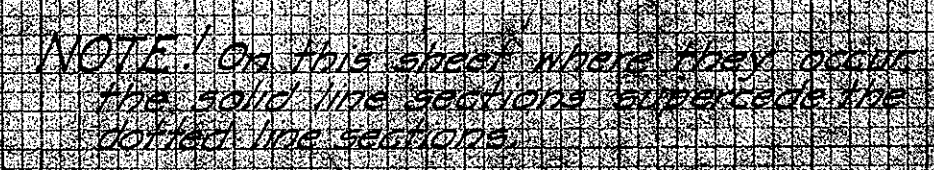

FOR TRAINING LOG
FAP 26A

4441.50

ORIGINAL	SURICED	DATE
SURVEY	PLOTTED	1962-5
NOTE BOOK	TEMPLE	1962-5
NO 12-14-1	AFSAS	1962-5
	AFSAS CHECKED	1962-5

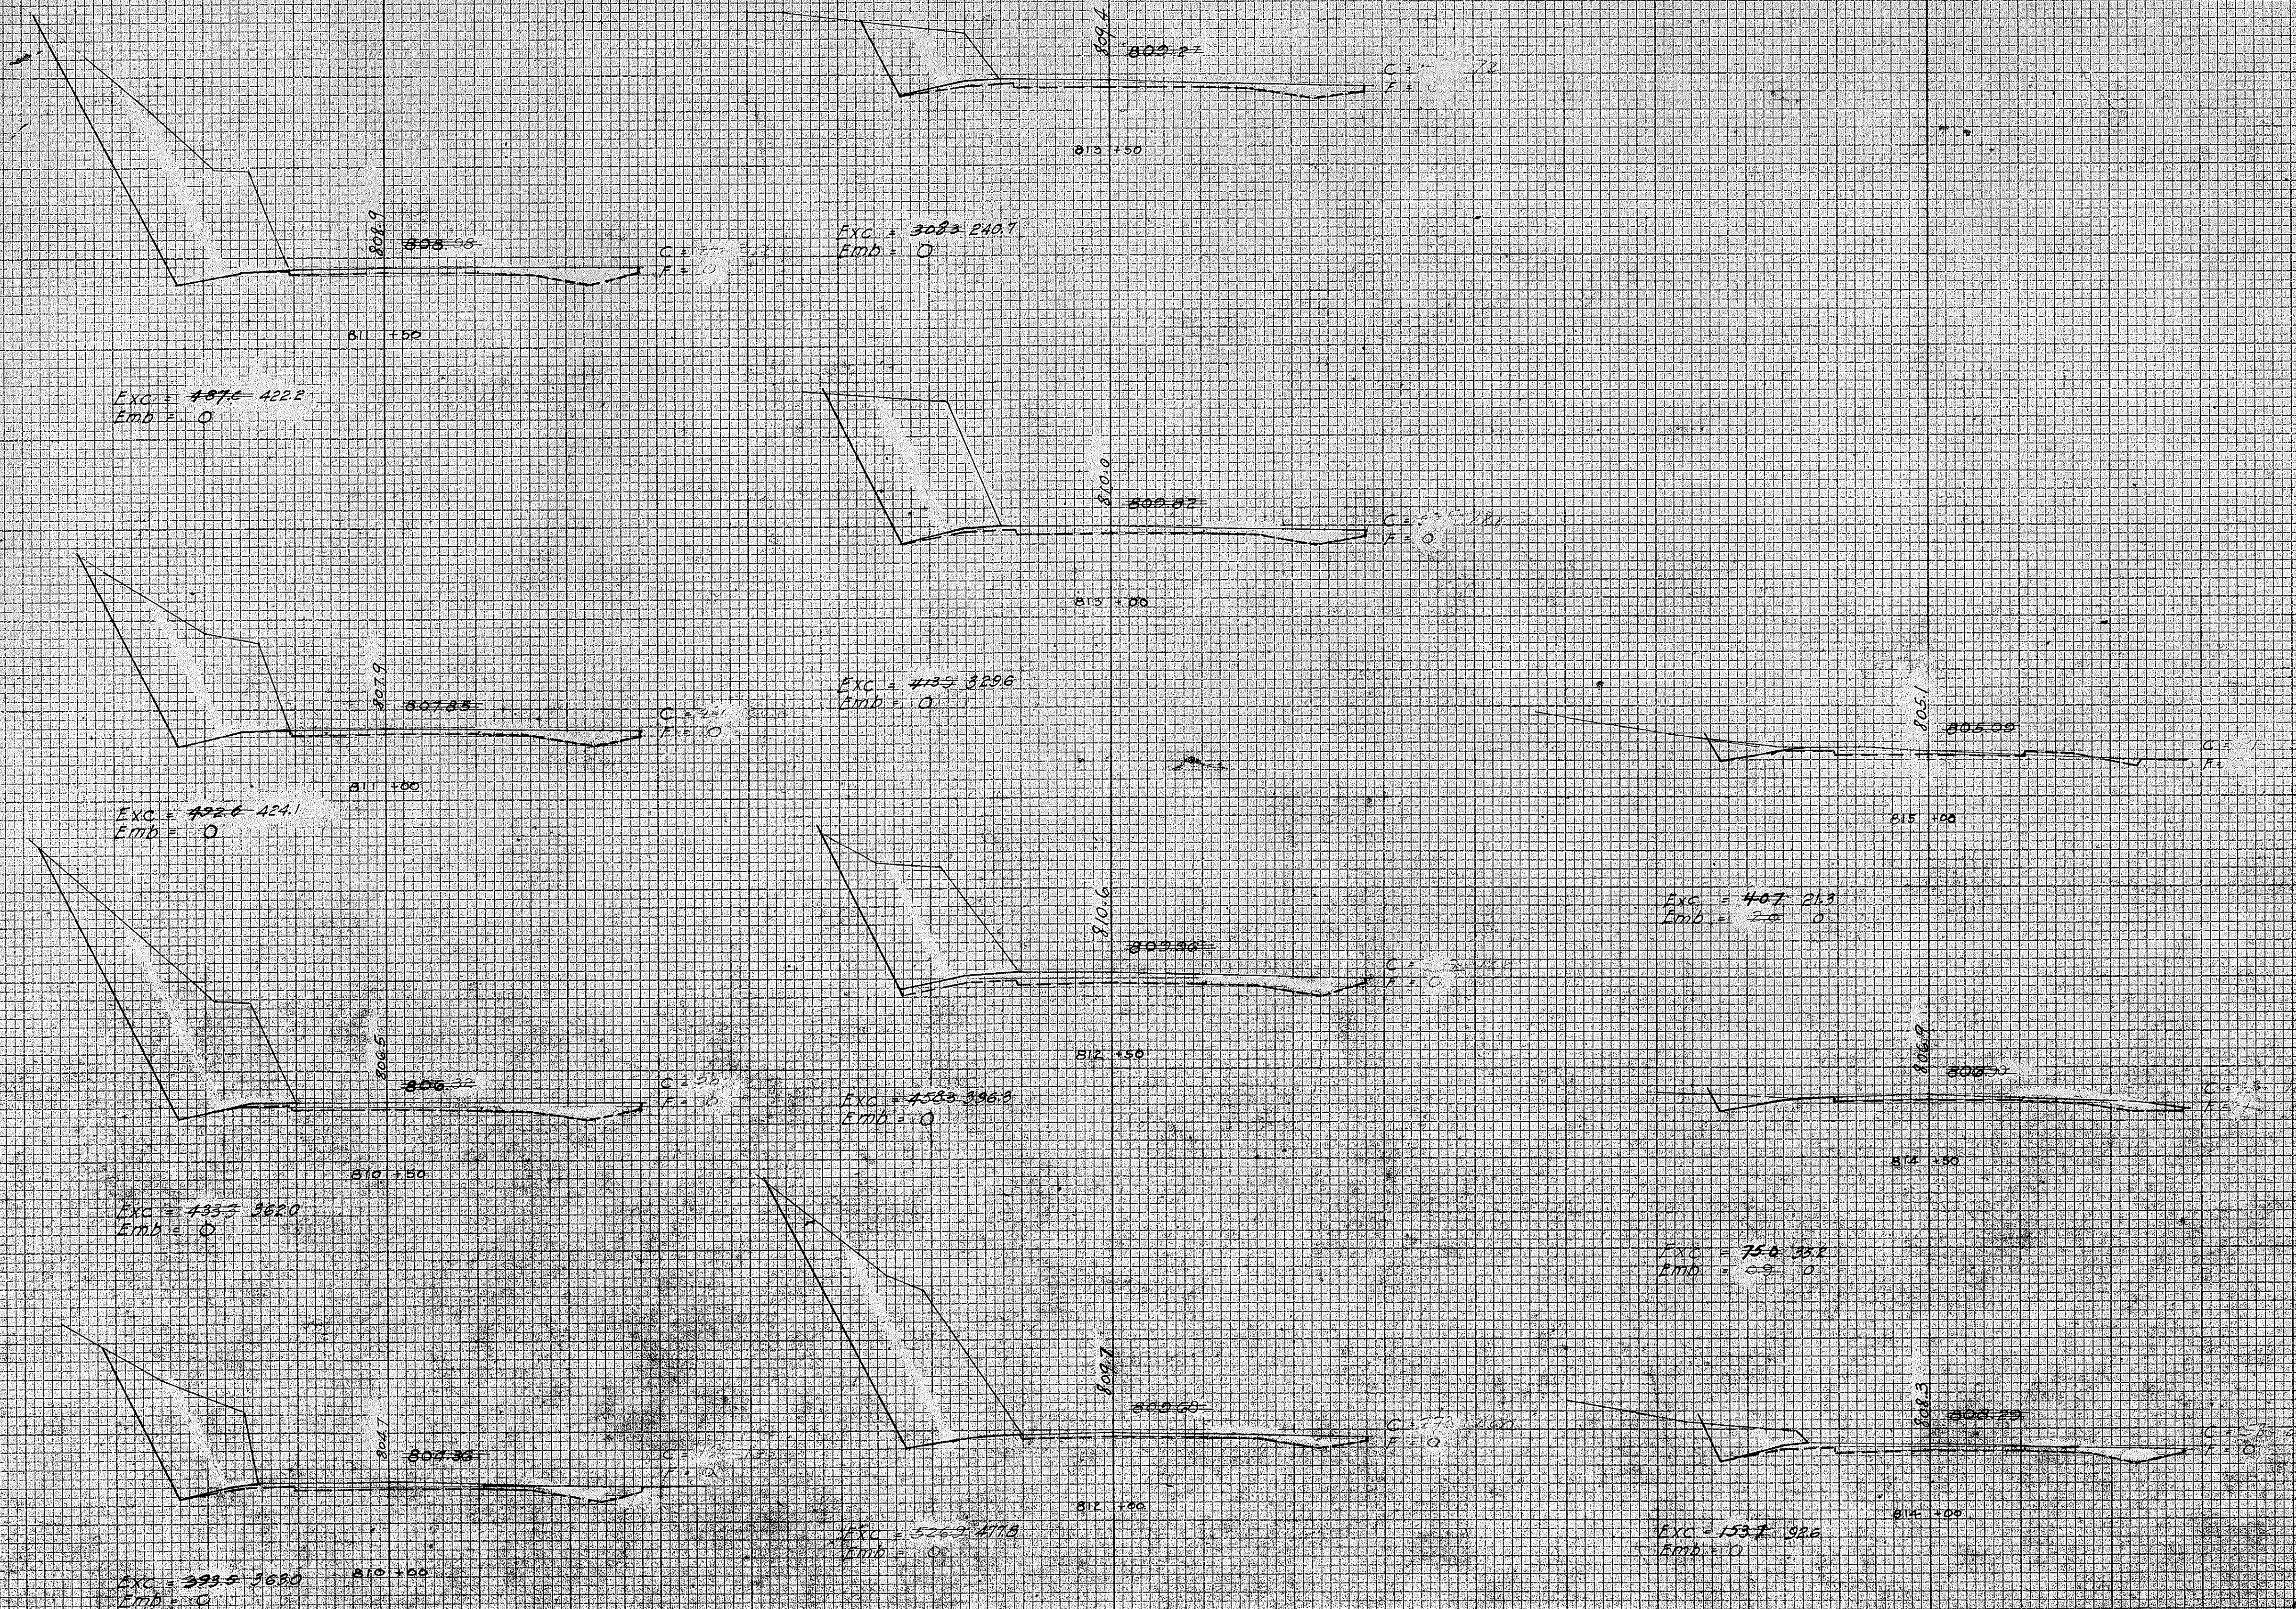

FORM TRACING FEB
FAP 26A

NOTE: On this sheet the solid line sections supersede the dotted line.

4484.14 4441.51