


INDEX TO DRAWINGS	
SHEET NO.	DESCRIPTION
1	Title Sheet
2	Typical Sections
3	Plan & Profile
4	Standard Details
	Culvert Details
5 - 11	Bridge Details
12 - 14	Cross Sections

CONVENTIONAL SIGNS

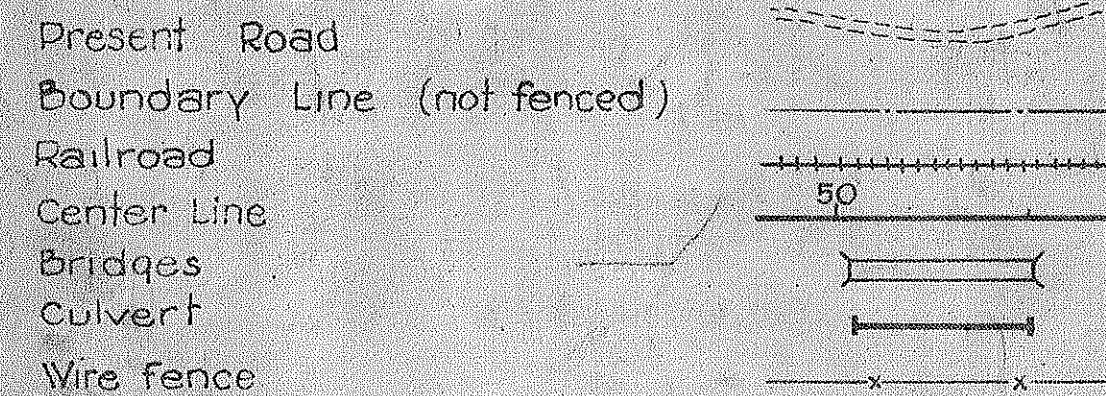


TERRITORY OF HAWAII
TERRITORIAL HIGHWAY DEPARTMENT
HONOLULU - T. H.

PLANS OF
HAWAII BELT ROAD
FEDERAL AID PROJECT NO 26-B(1)
DISTRICT OF HAMAKUA
ISLAND OF HAWAII


SCALES

PLAN	1 INCH = 100 FEET
PROFILE	1 INCH = 100 FEET
CROSS SECTIONS	1 INCH = 10 FEET

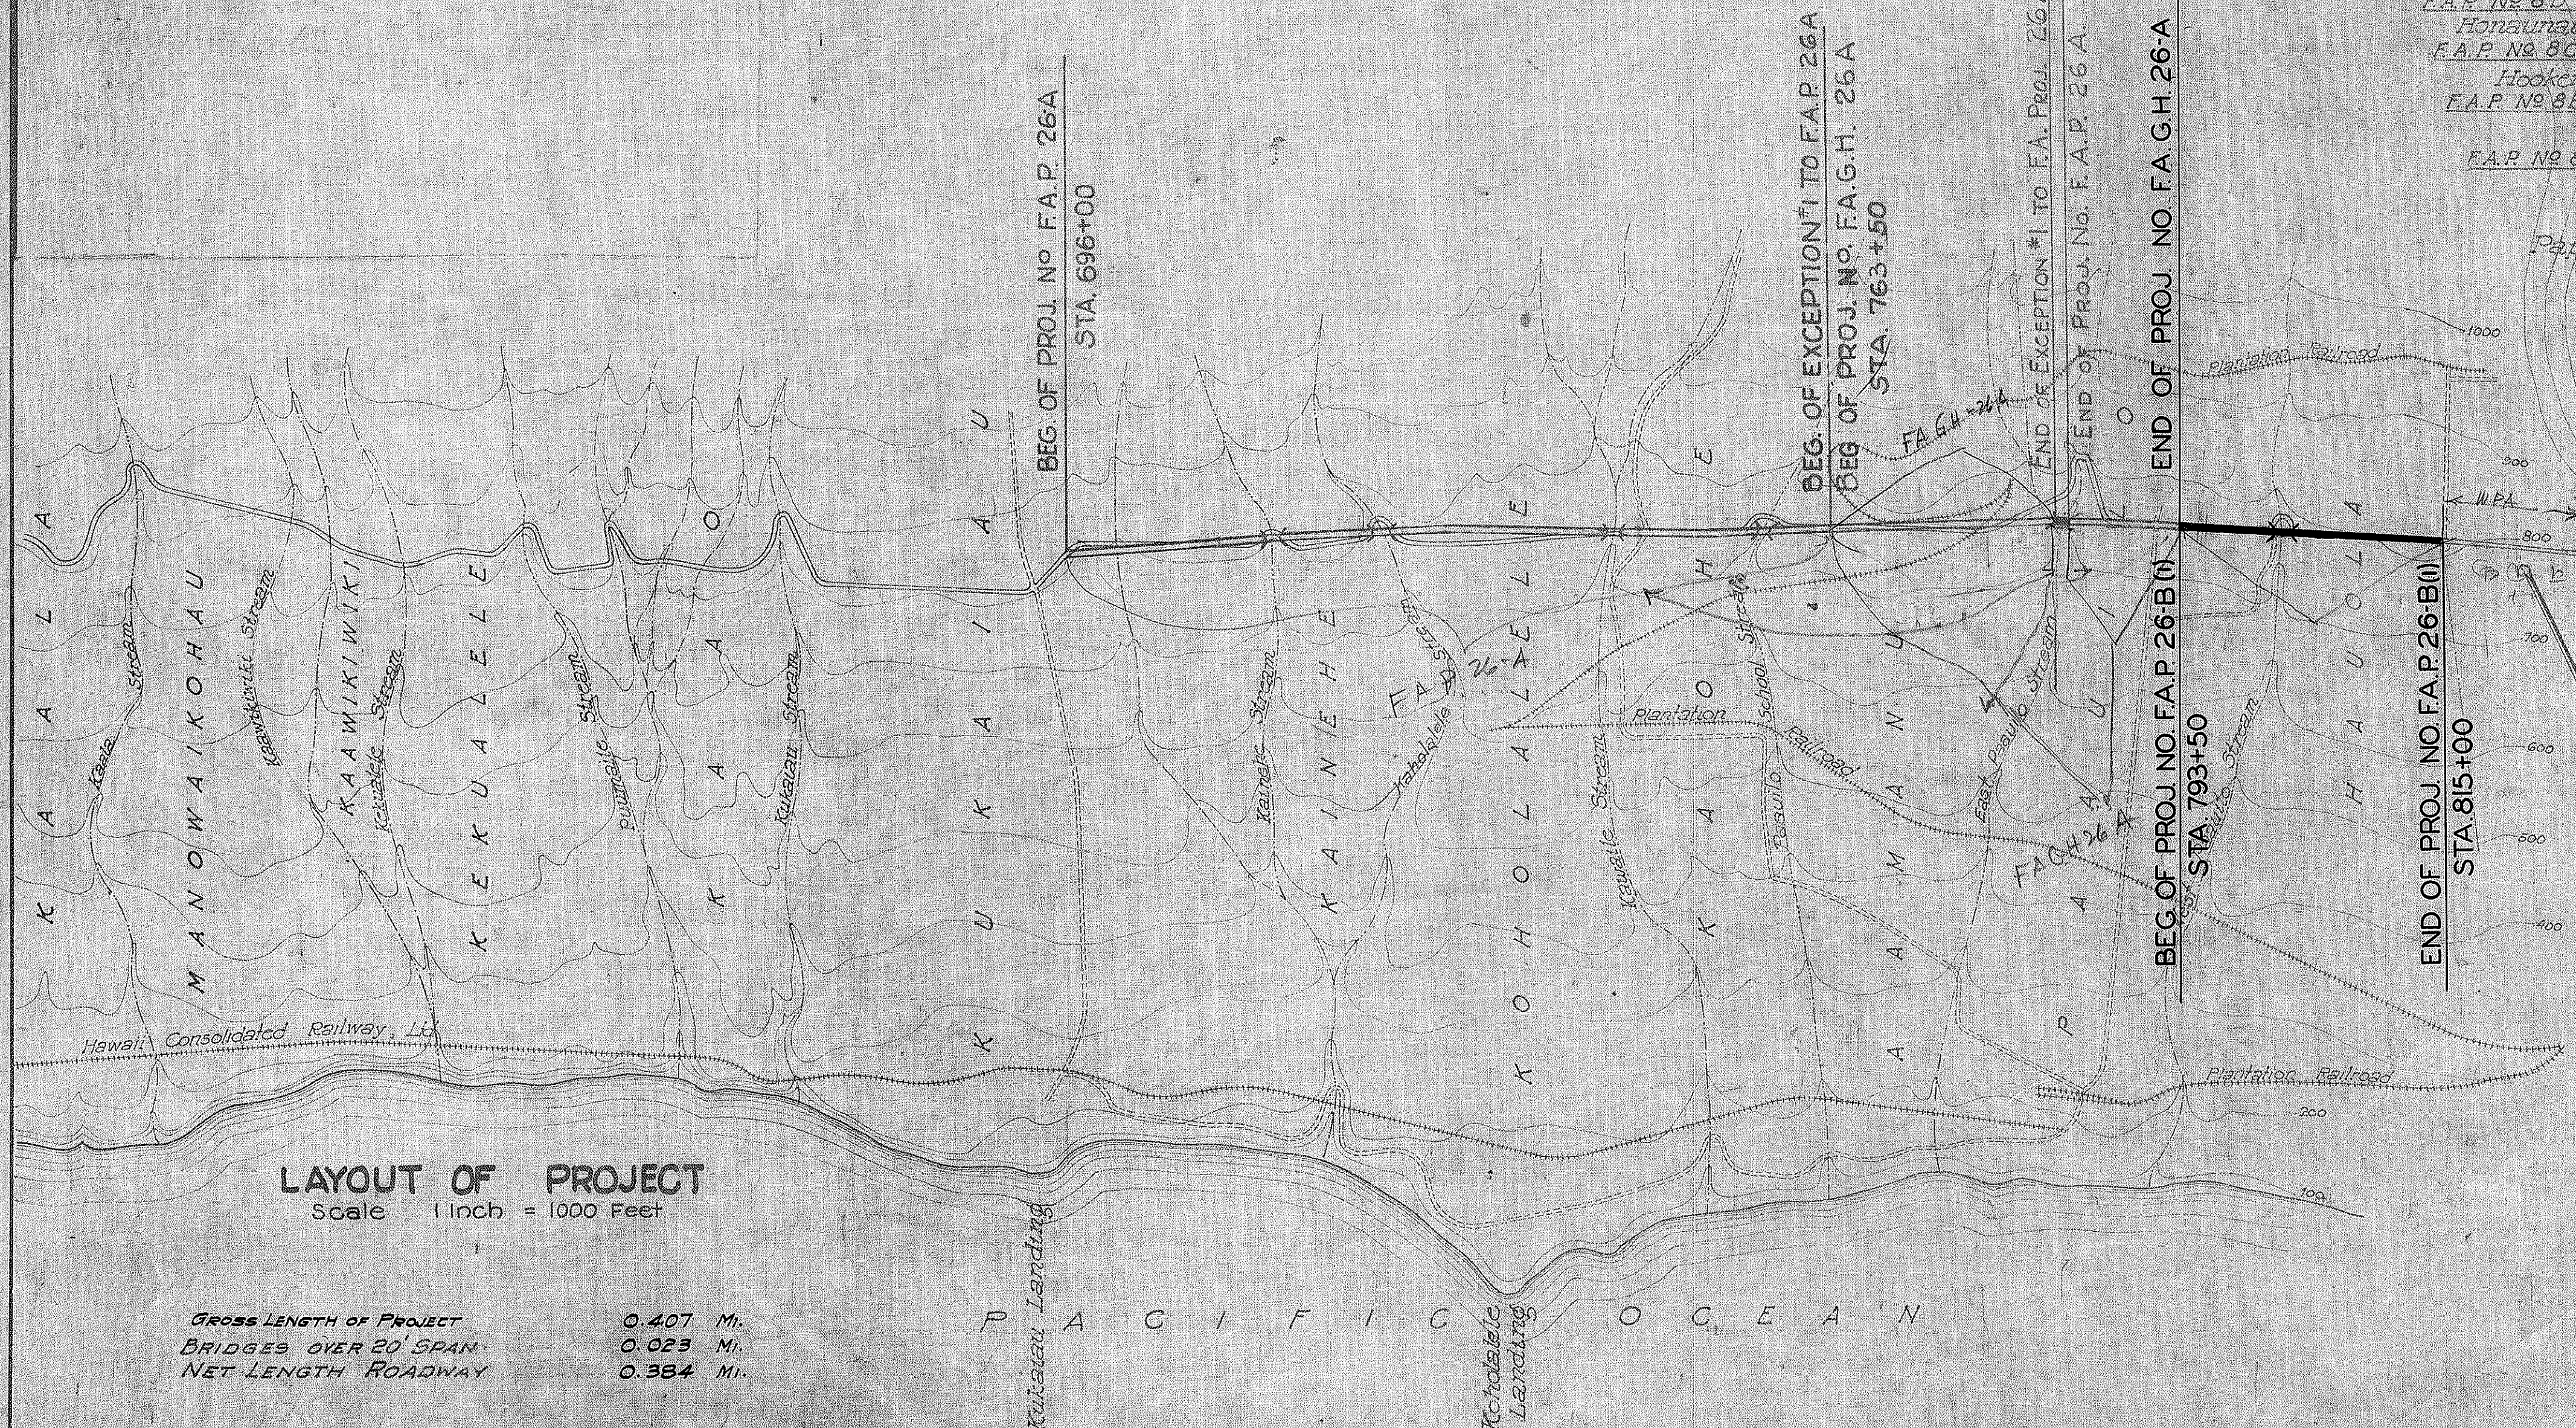

LAYOUT OF PROJECT
Scale 1 Inch = 1000 Feet

GROSS LENGTH OF PROJECT 0.407 Mi.
BRIDGES OVER 20' SPAN 0.023 Mi.
NET LENGTH ROADWAY 0.384 Mi.

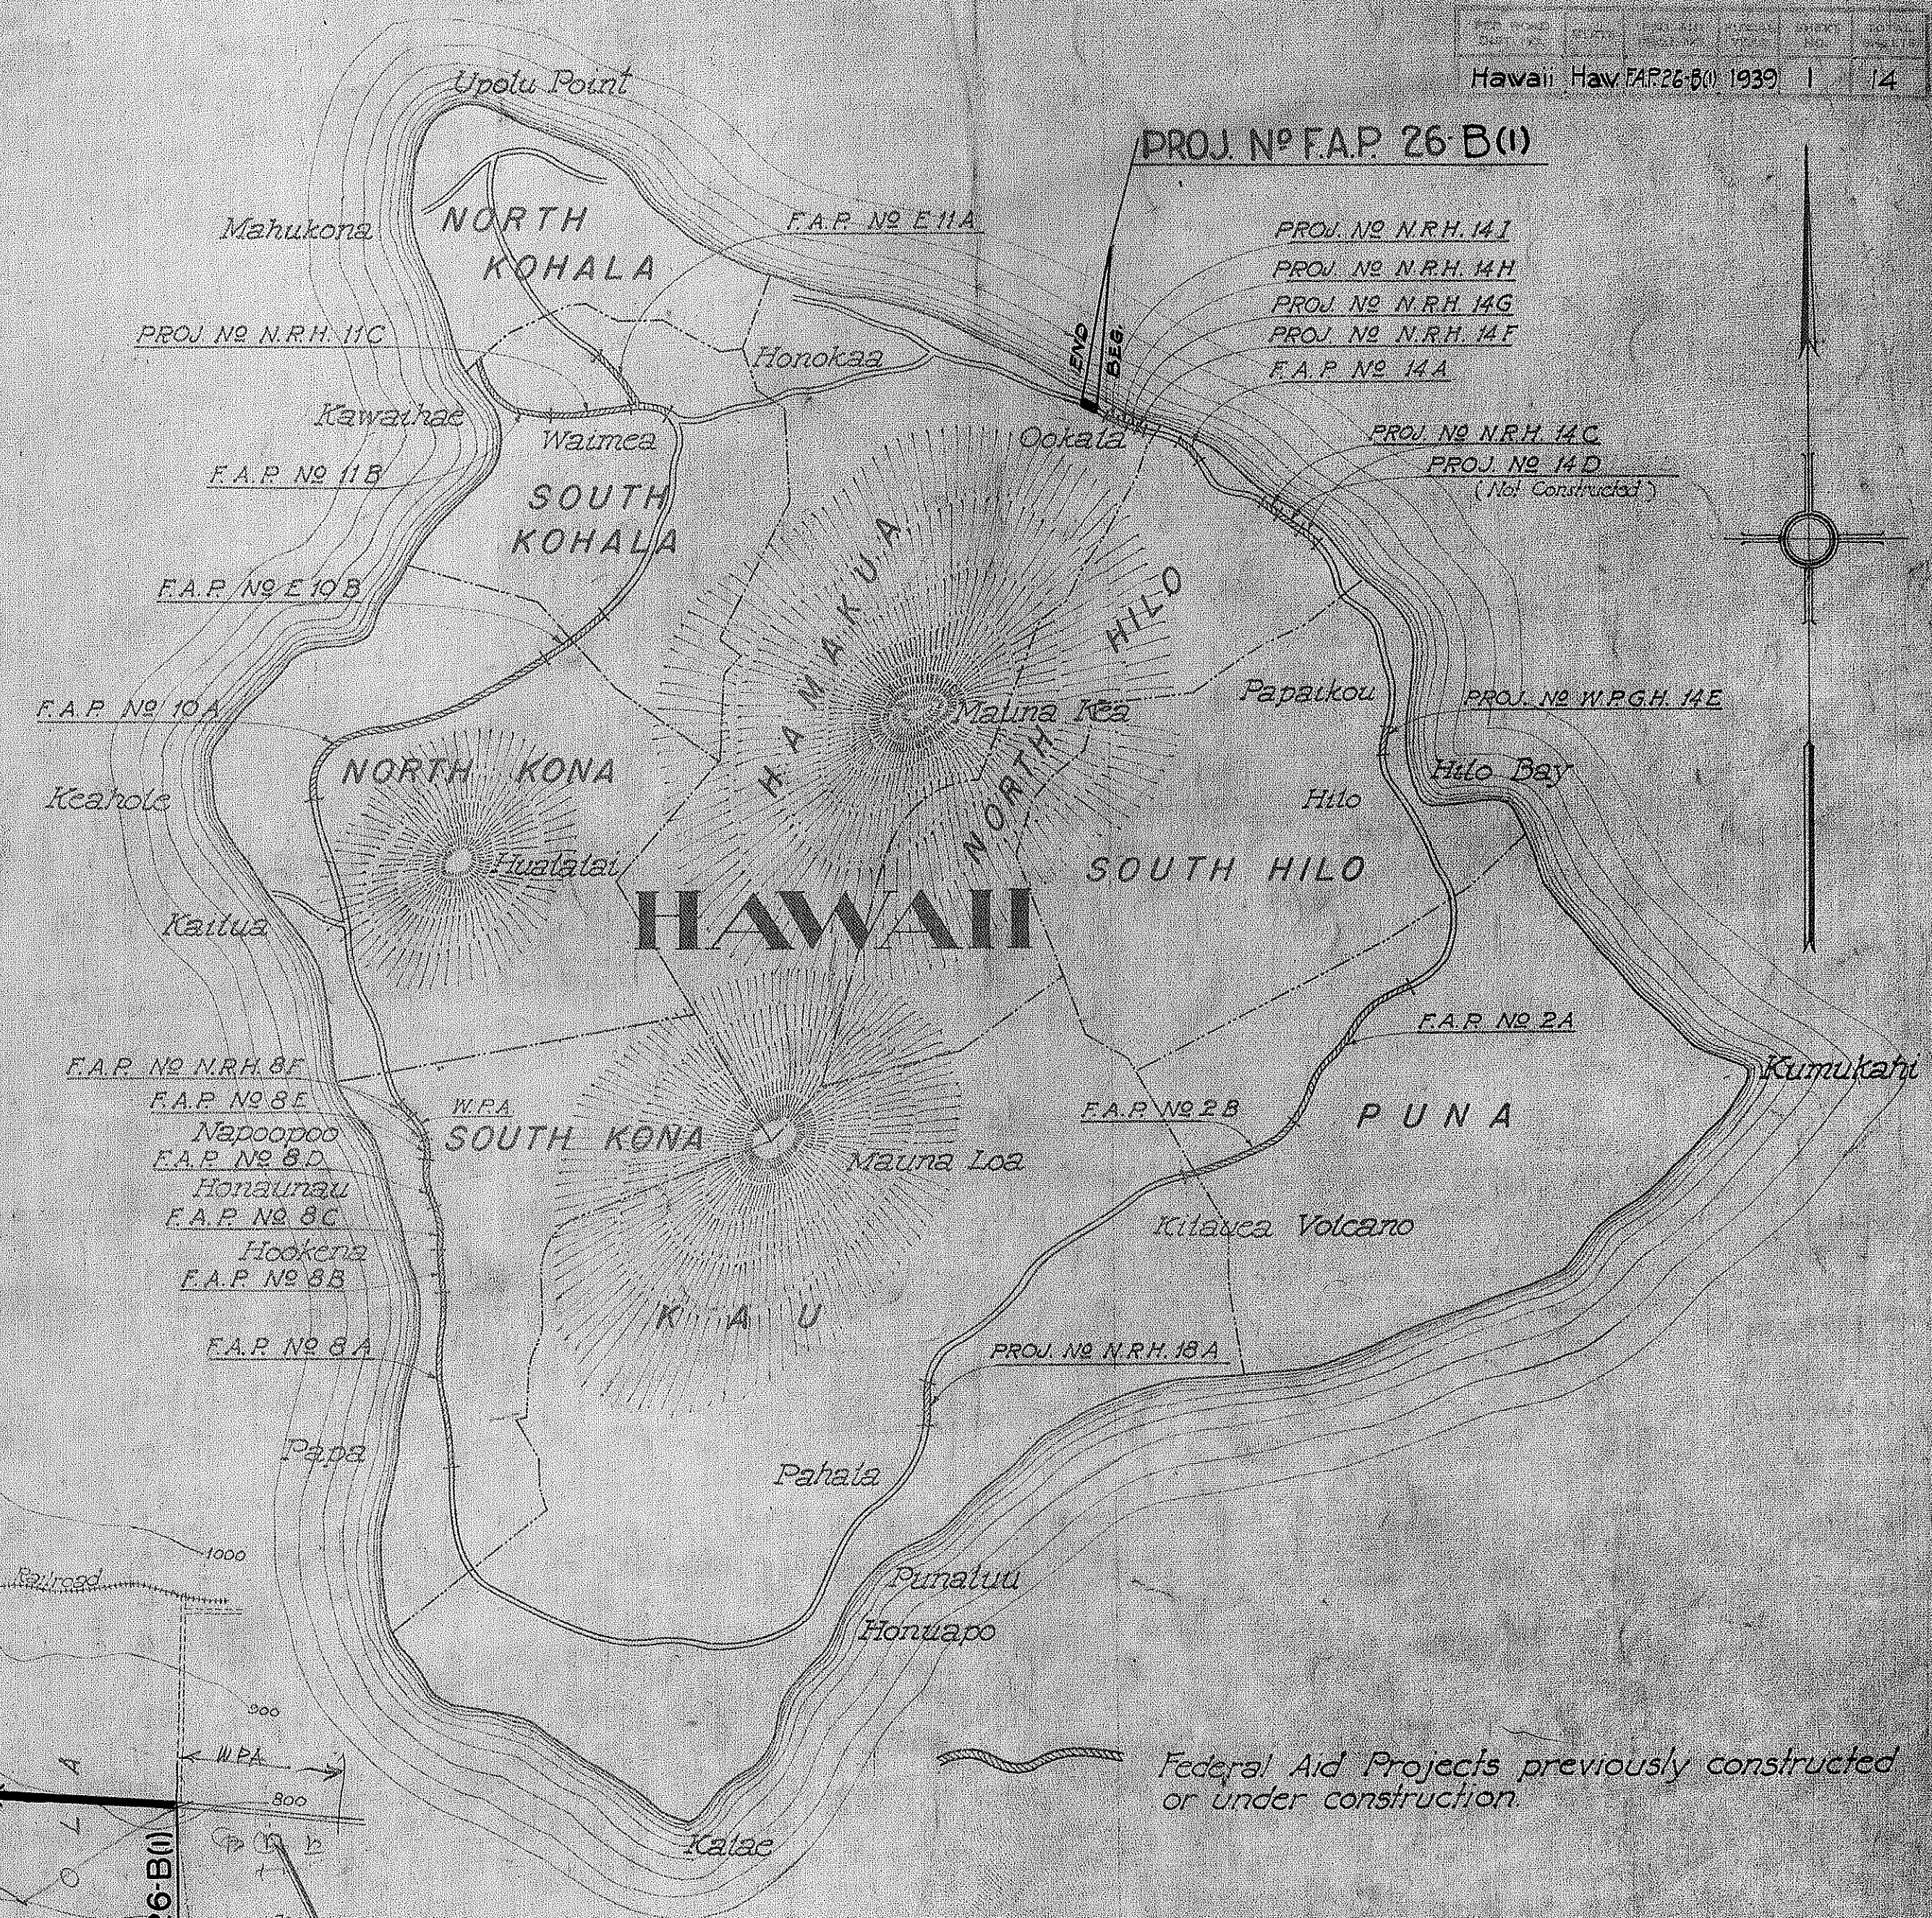

RECOMMENDED FOR APPROVAL

Principal Highway Engr. Bureau of Pub. Rds.

RECOMMENDED FOR APPROVAL

Deputy Chief Engineer, Bur. of Pub. Rds.

APPROVED

Chief Division of Design, Bur. of Pub. Rds.

APPROVED BY THE SECRETARY OF AGRICULTURE

PROJECT AGREEMENT EXECUTED

APPROVED
Louis B. Law
Date 1/7/37
Territorial Highway Engineer