

DATE	BY	FINAL SURVEY	SURVEYED	PLOTTED	DATE	NO.

DATE	BY	ORIGINAL SURVEY	SURVEYED	PLOTTED	DATE	NO.

FED. ROAD DIST. NO.	STATE	FED. AID PROJ. NO.	FISCAL YEAR	BRIDGE NO.	SHEET NO.
H2W211	H2W	14-B01941	84	92	


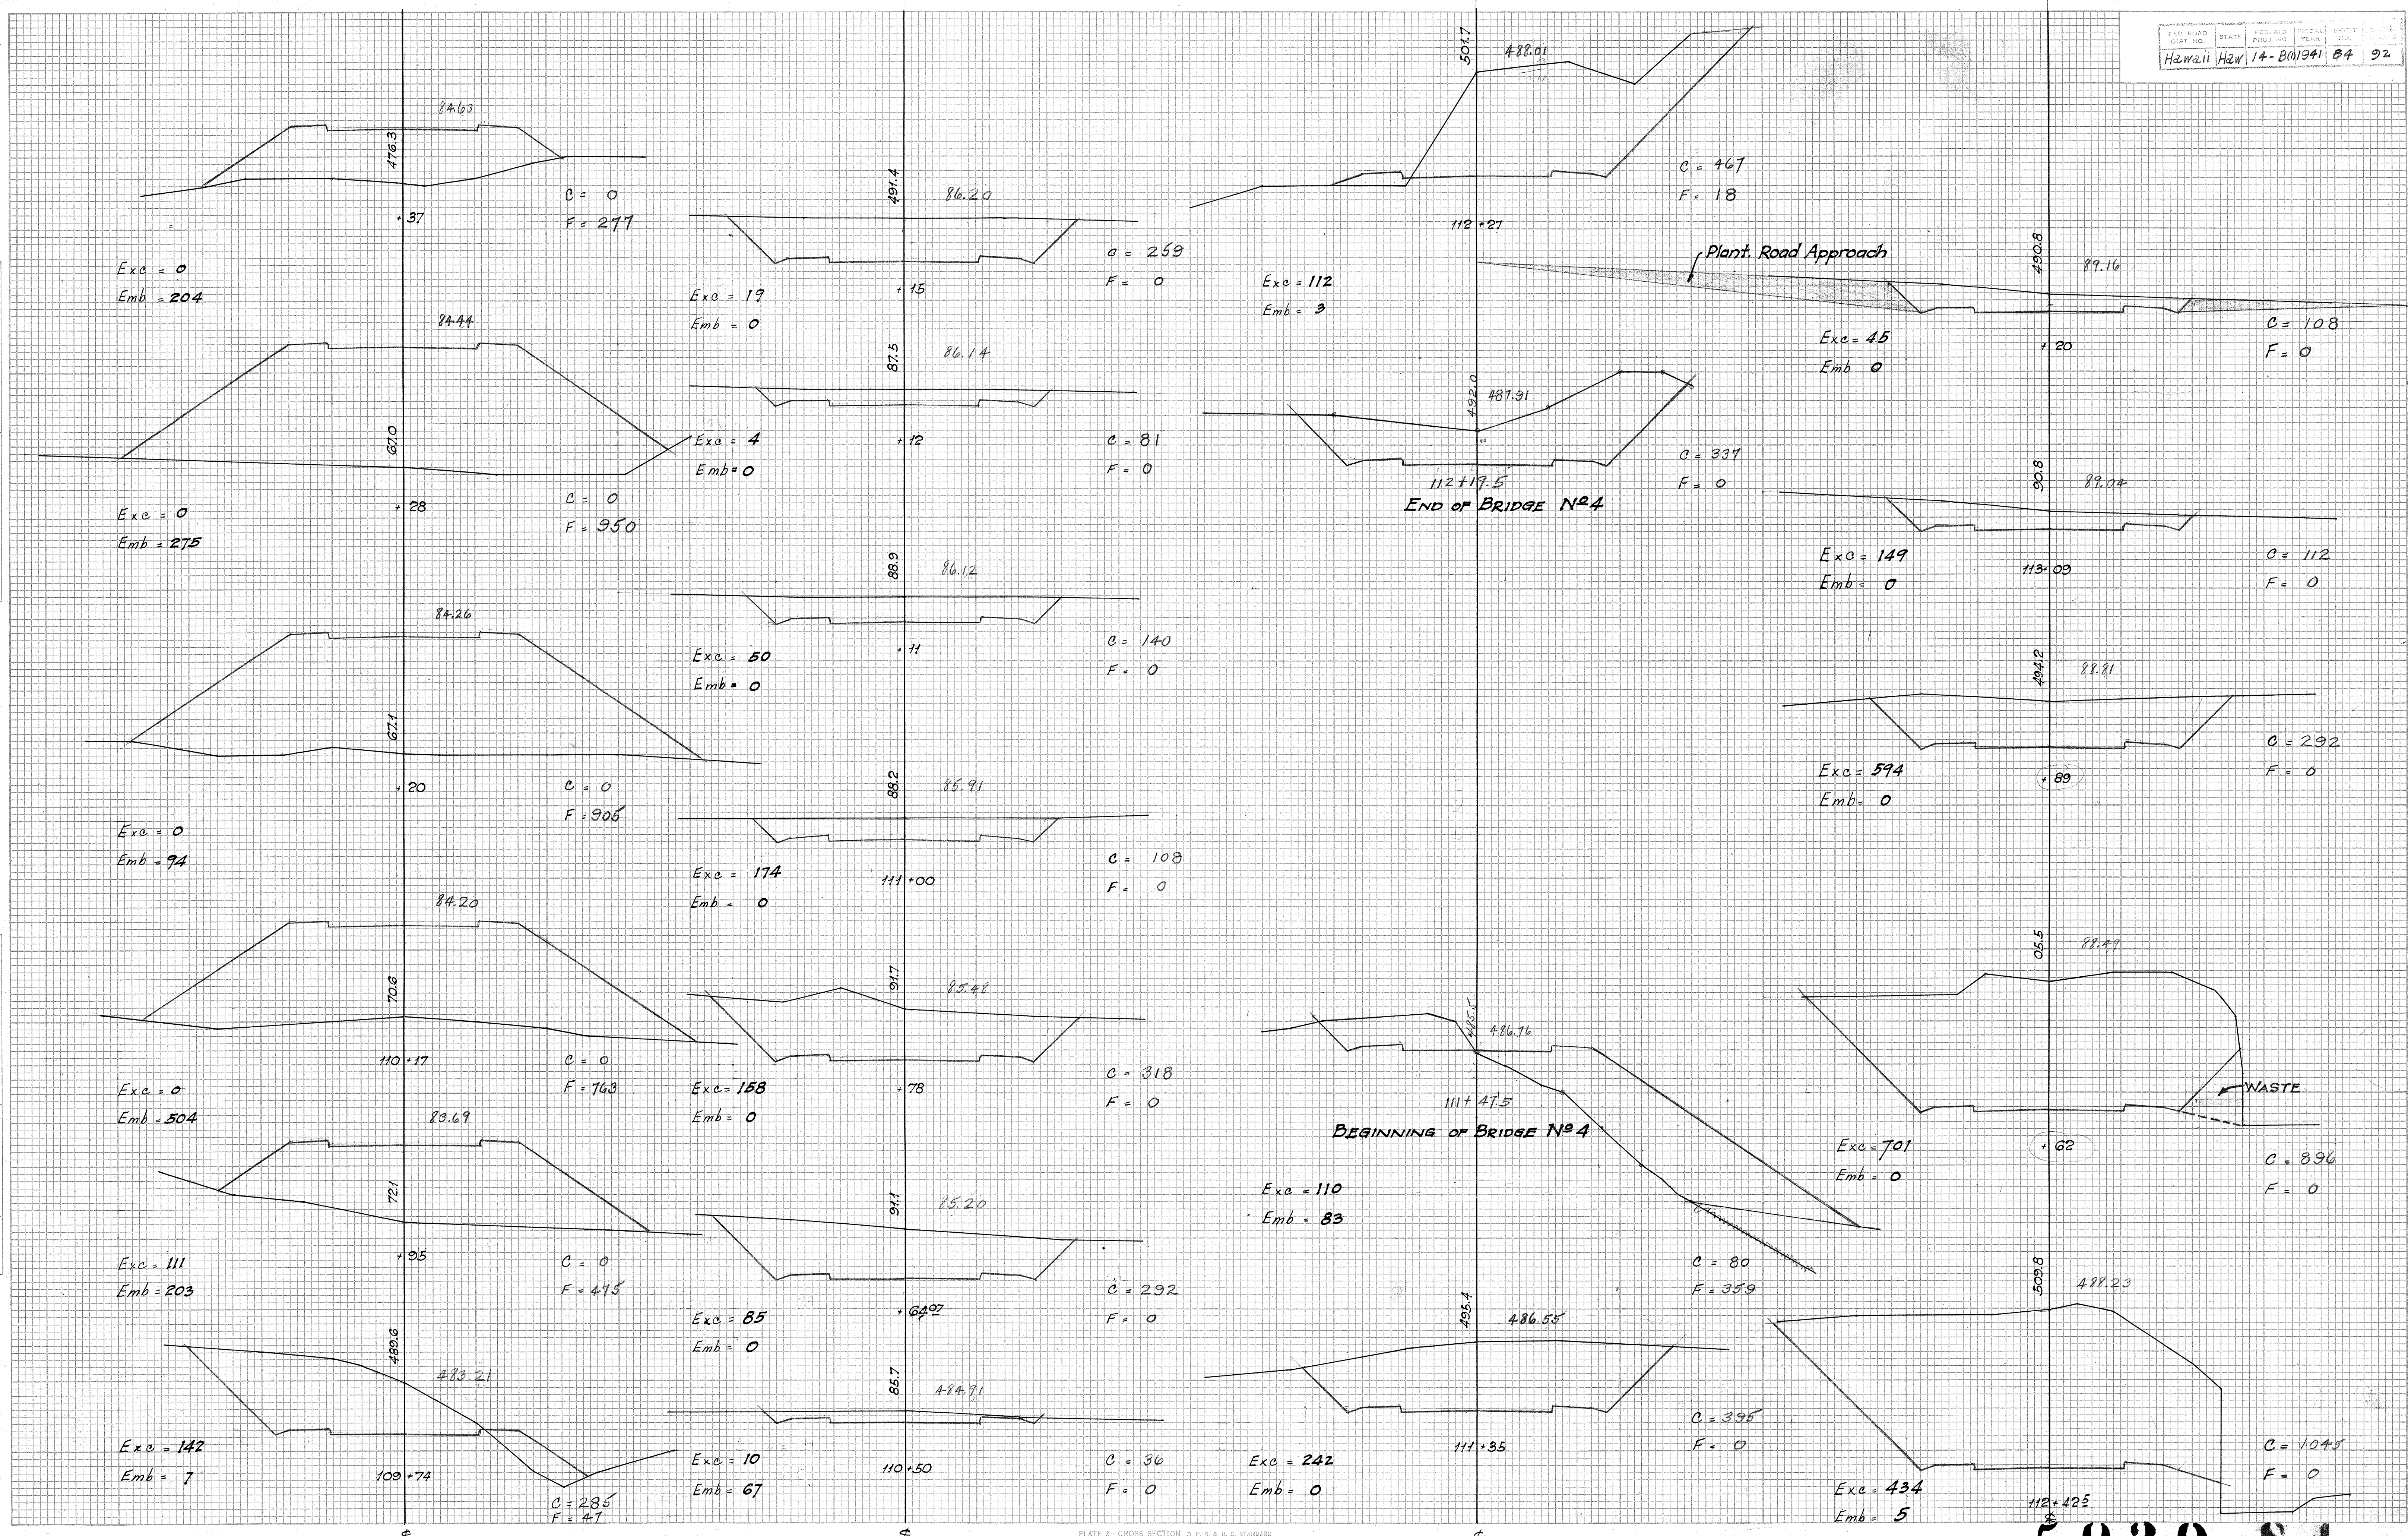


PLATE 3 - CROSS SECTION O. P. R. & E. STANDARD
KEUPPEL & ESSER CO., NEW YORK.

5039.84
5039.13

DATE _____
BY _____
FINAL SURVEY PLOTS
NOTE BOOK TEMPLATE
AREAS CHECKED
NO. _____

DATE _____
BY _____
ORIGINAL SURVEY PLOTS
NOTE BOOK TEMPLATE
AREAS CHECKED
NO. _____

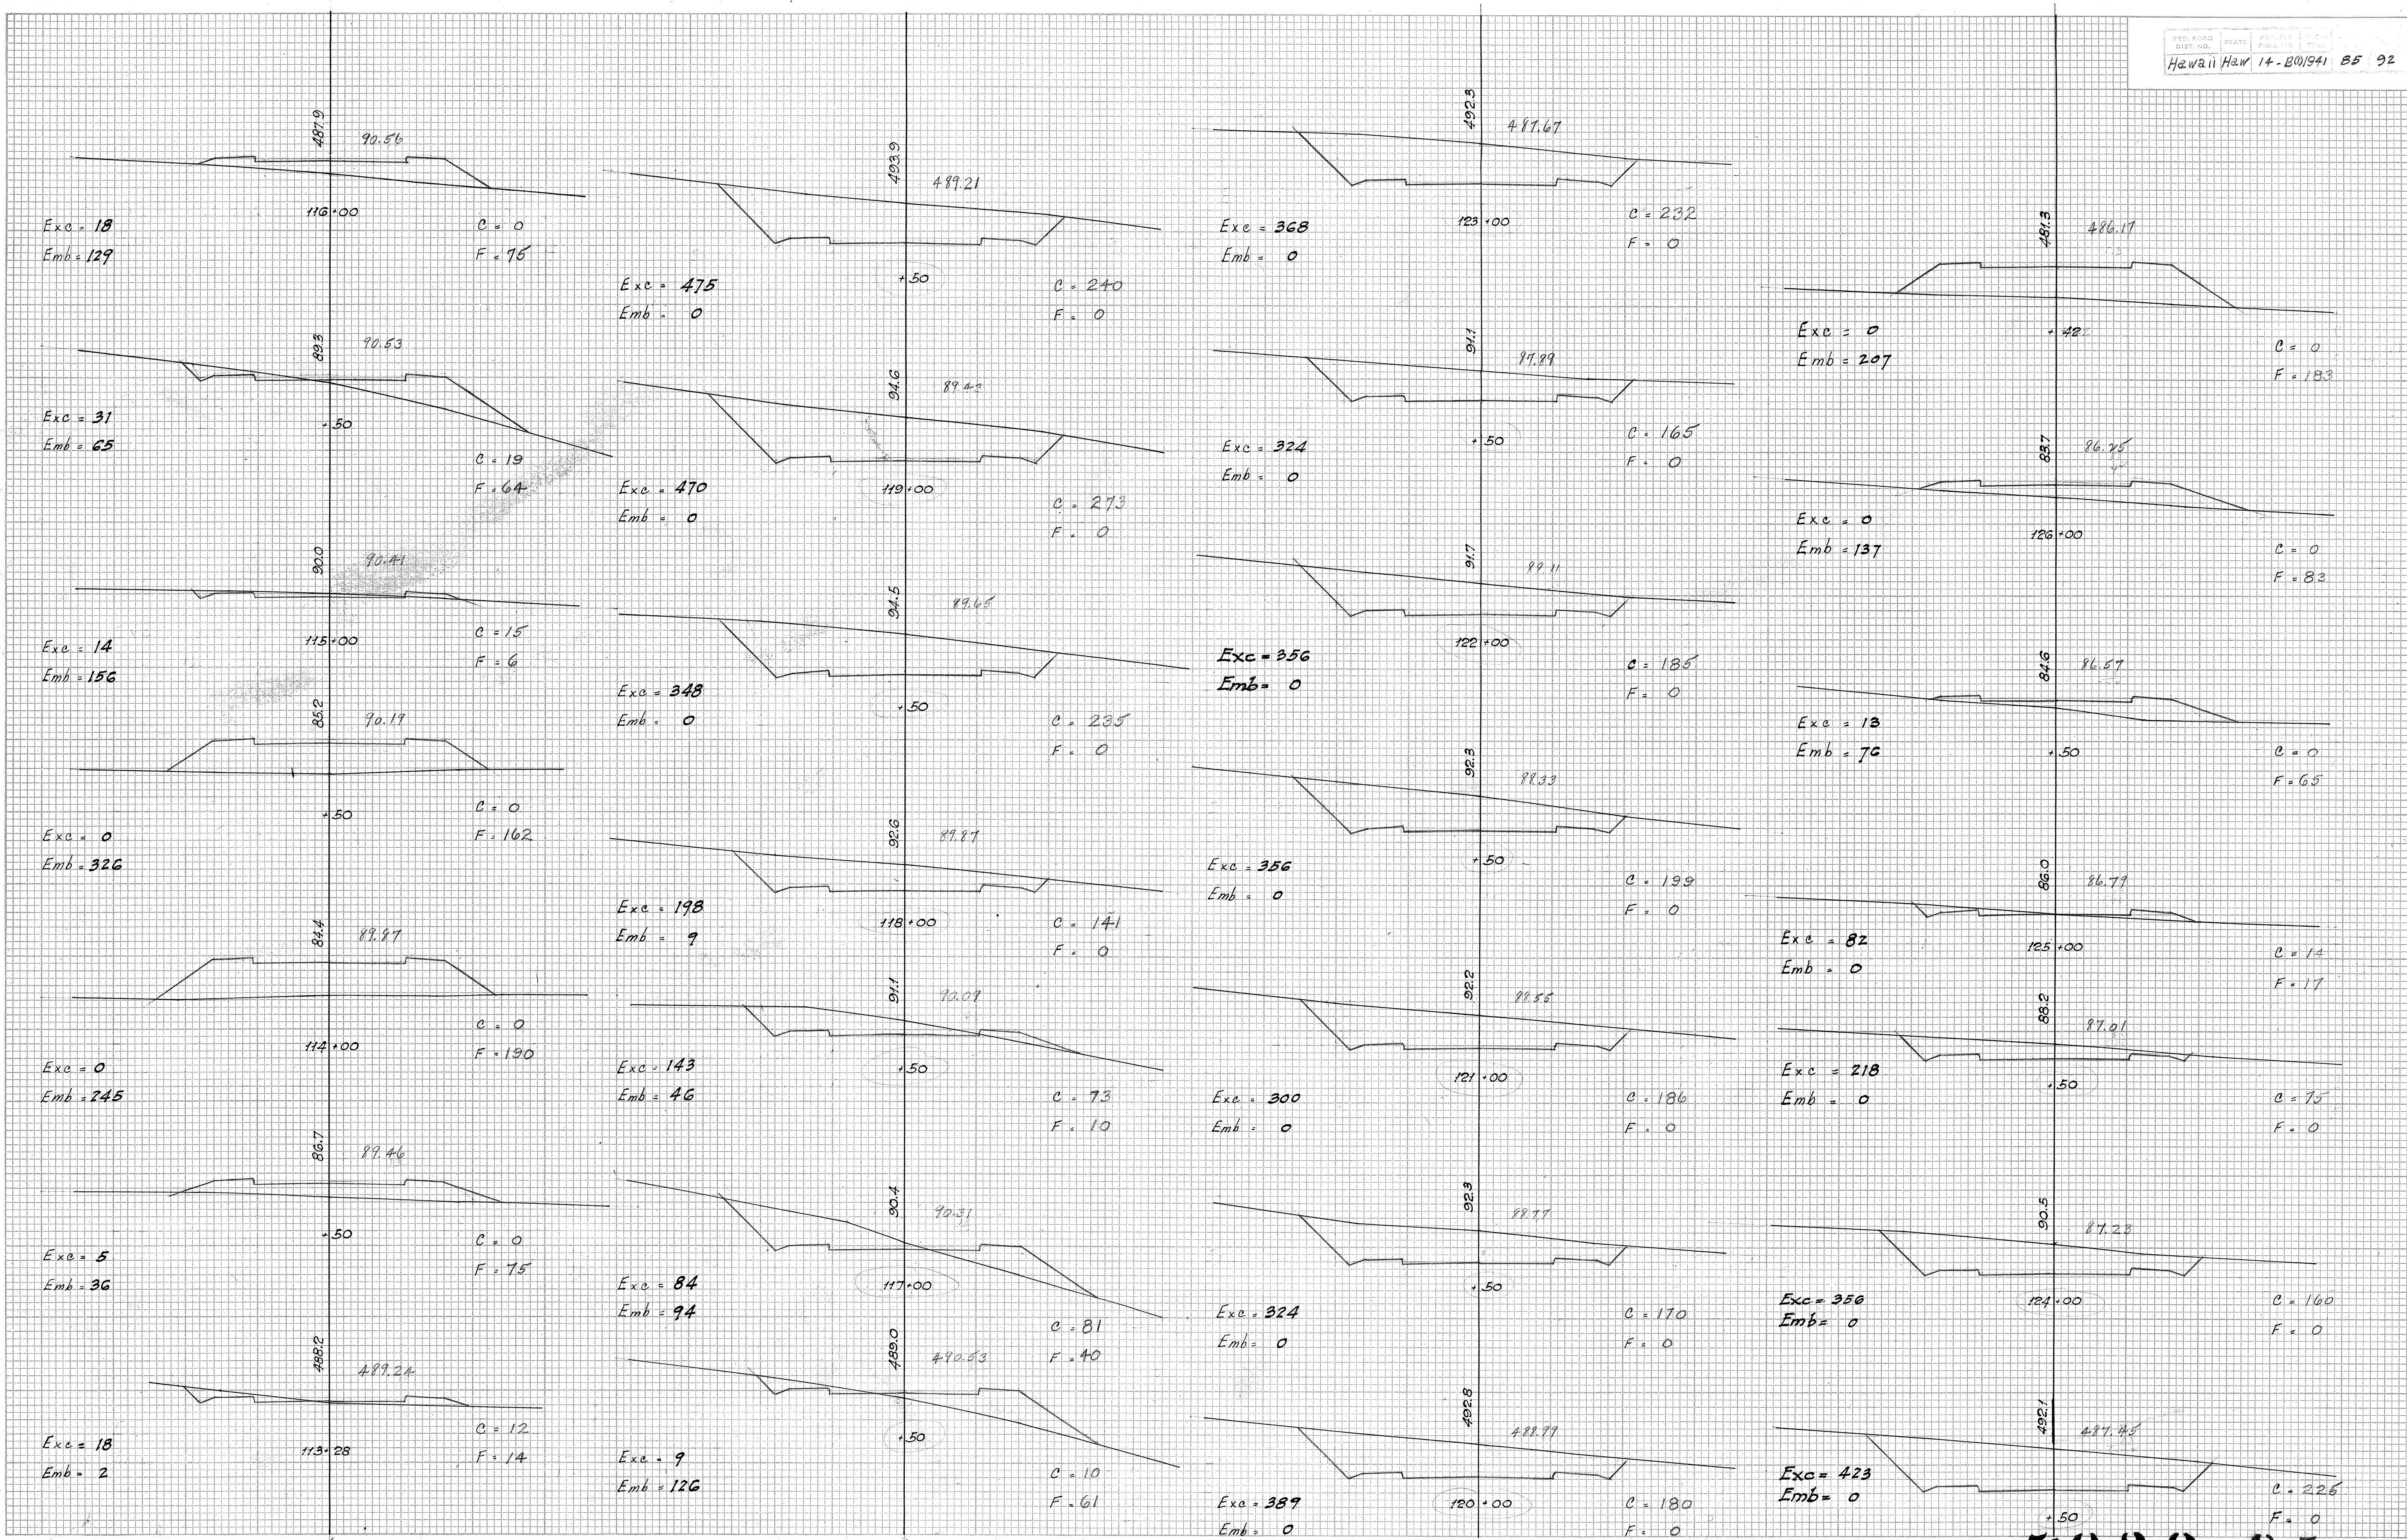

5039.85
5039.14

FINAL SURVEY PLOTTED
NOTE BOOK NO. 1
DATE BY

ORIGINAL SURVEY PLOTTED
NOTE BOOK NO. 1
DATE BY

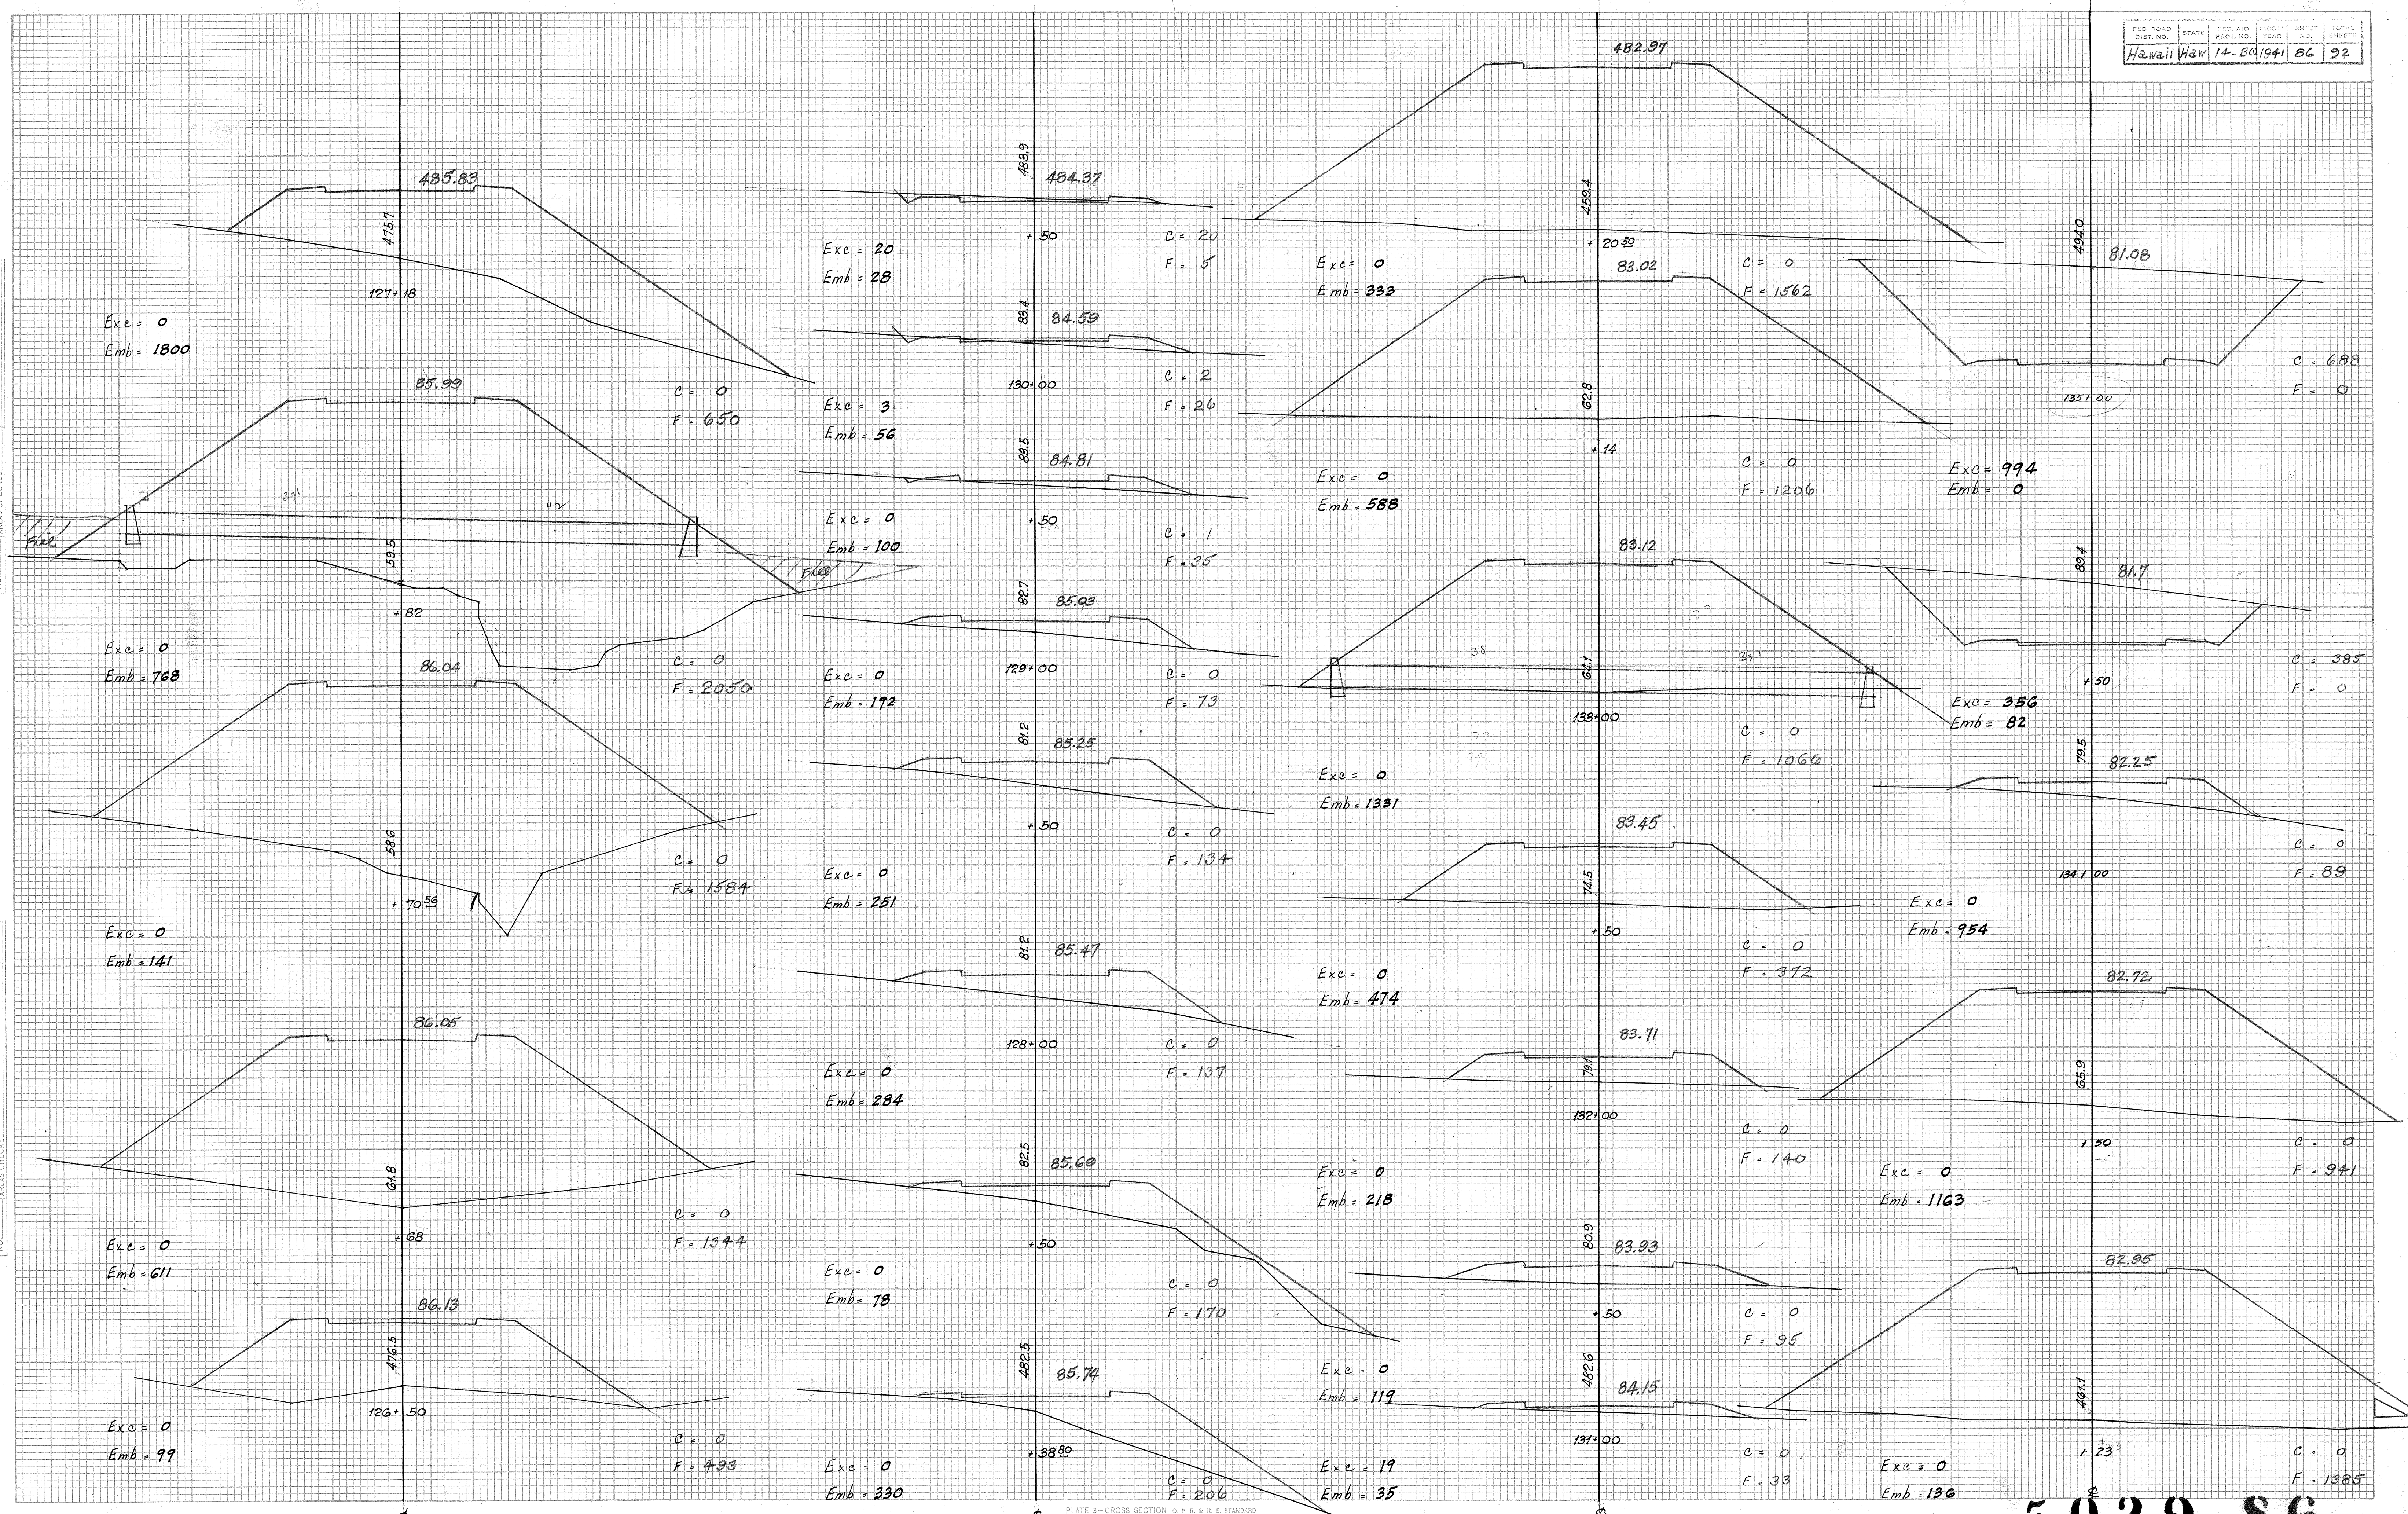


PLATE 3 - CROSS SECTION O. P. R. & R. E. STANDARD
KEUFFEL & ESSER CO., NEW YORK





5039.86

FINAL SURVEY
NOTE BOOK
NO.

ORIGINAL SURVEY
NOTE BOOK
NO.


DATE
BY

DATE
BY

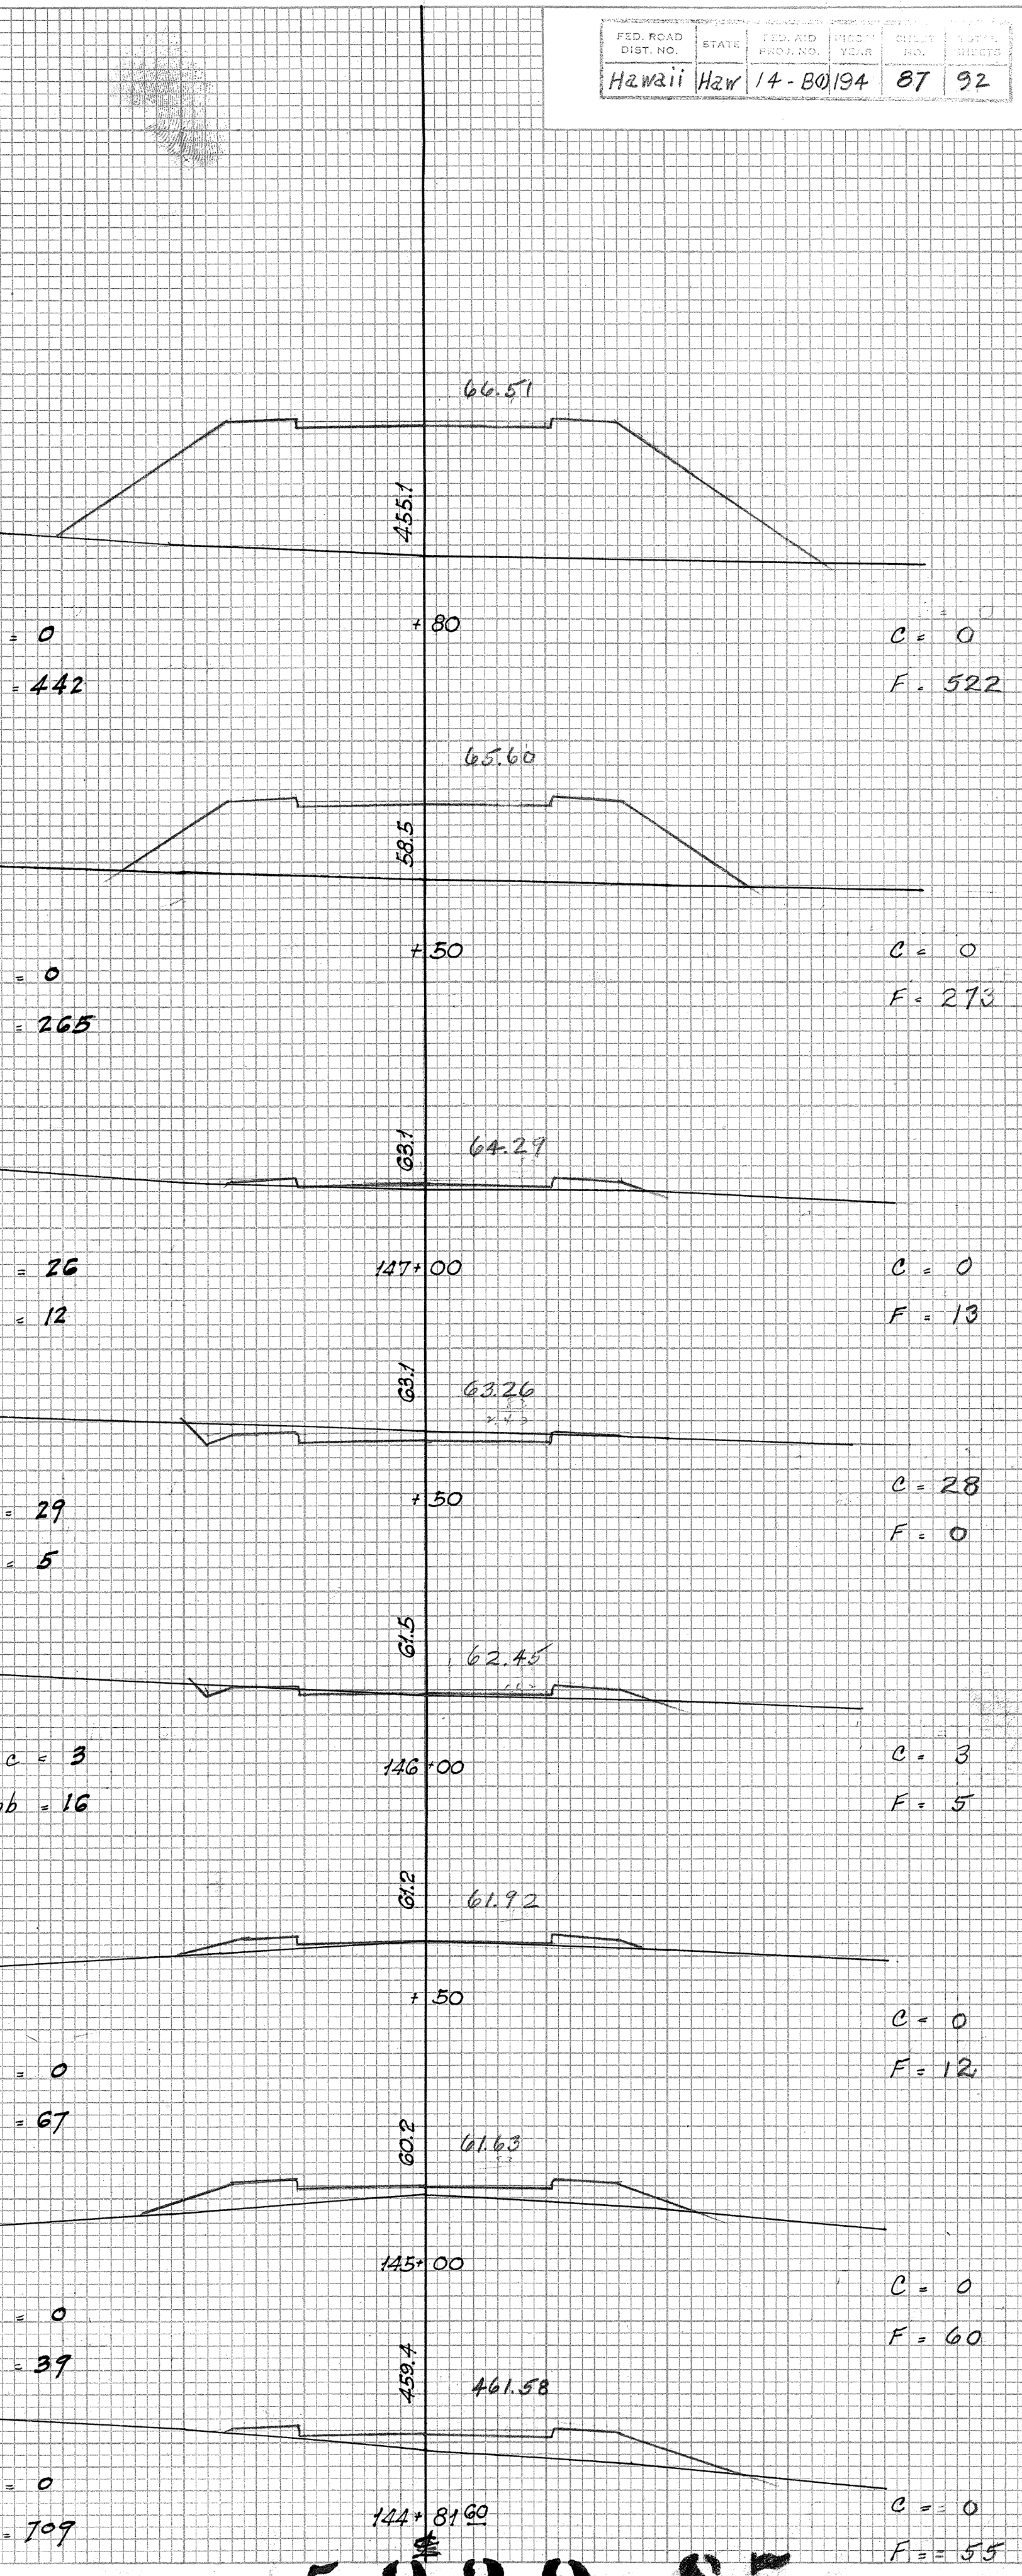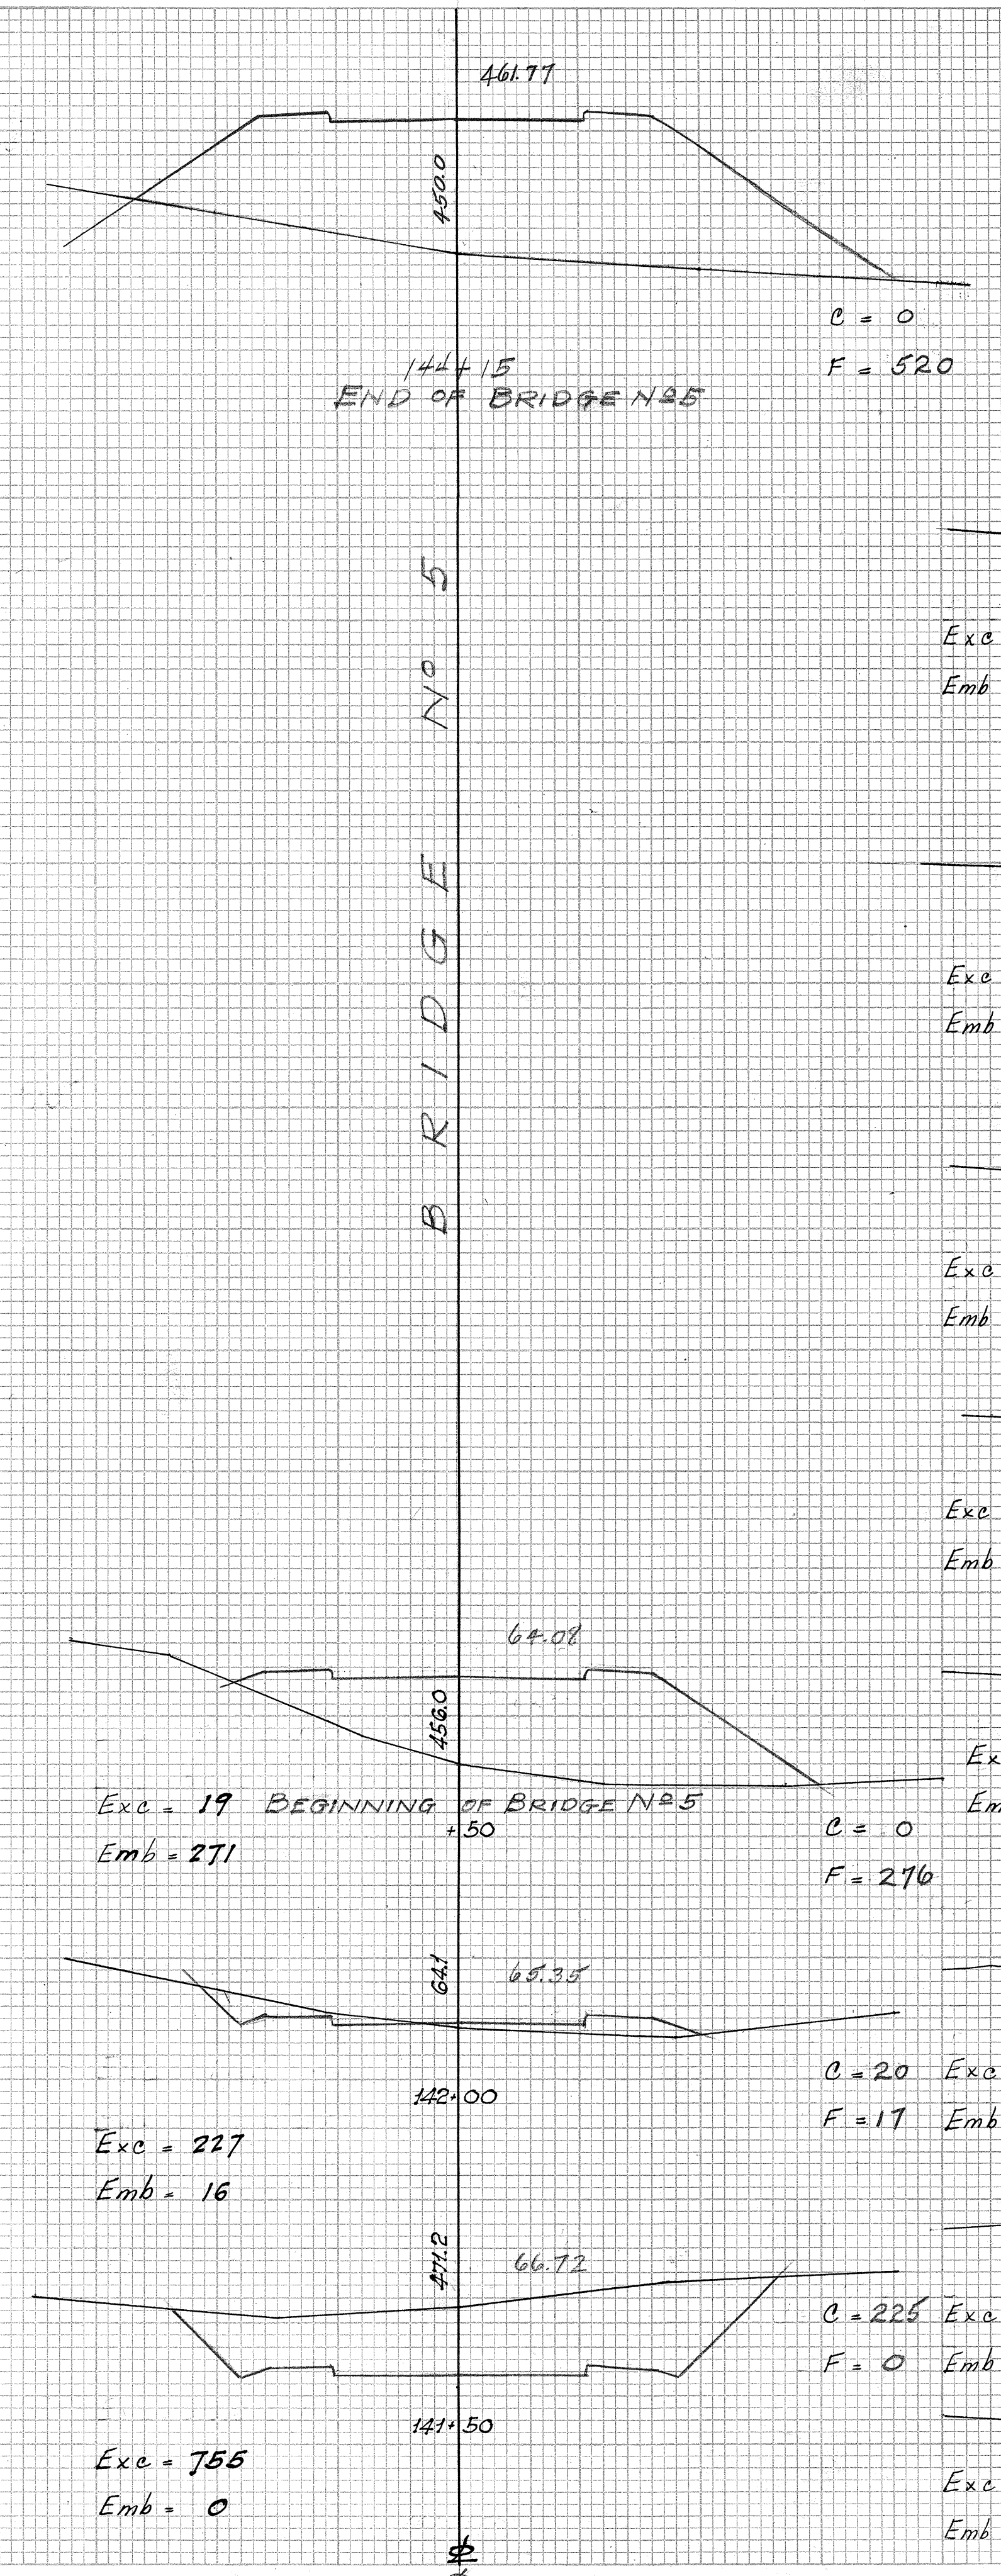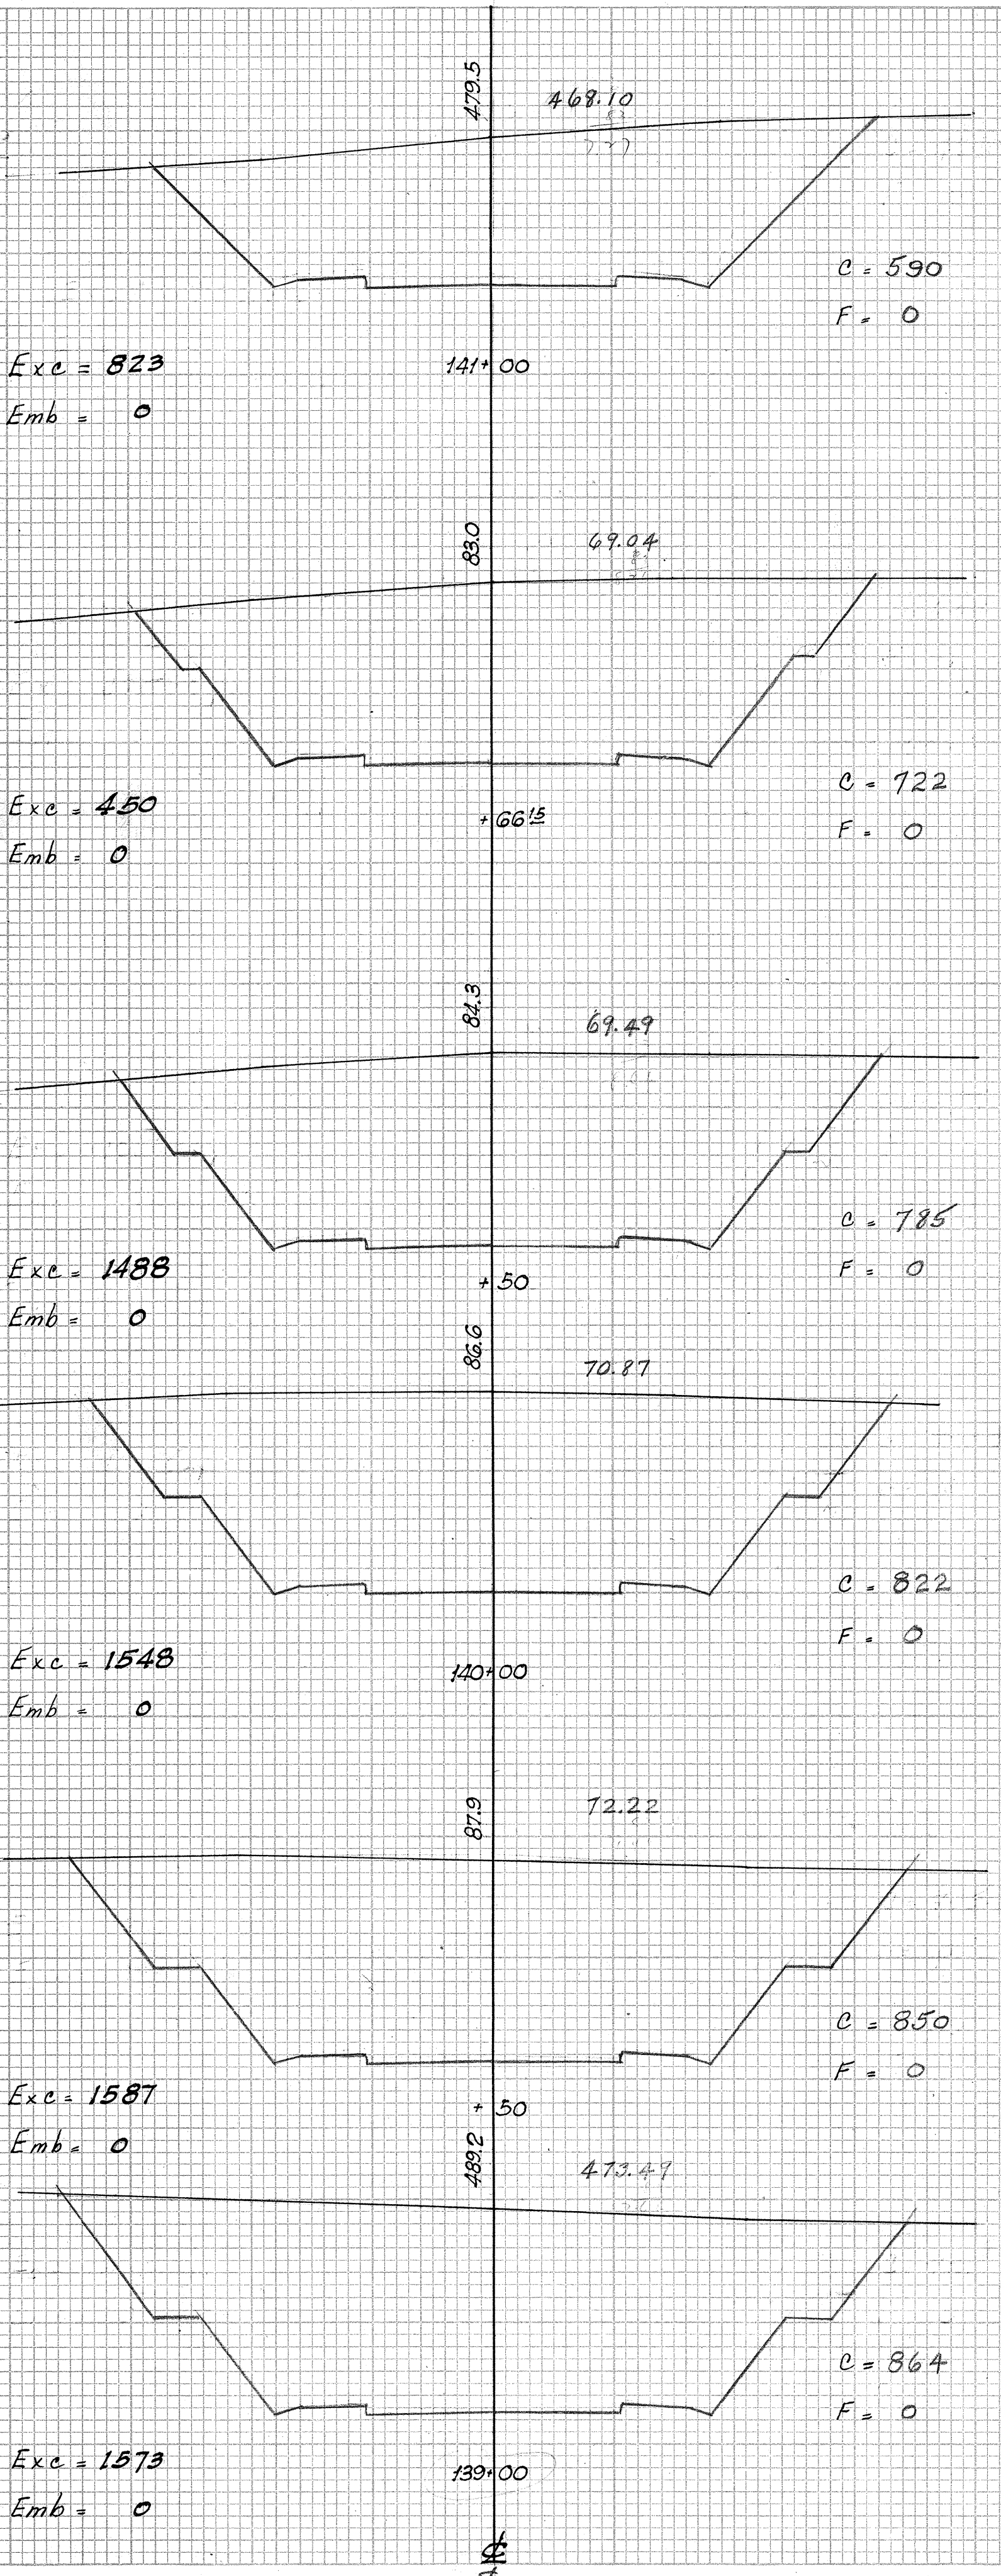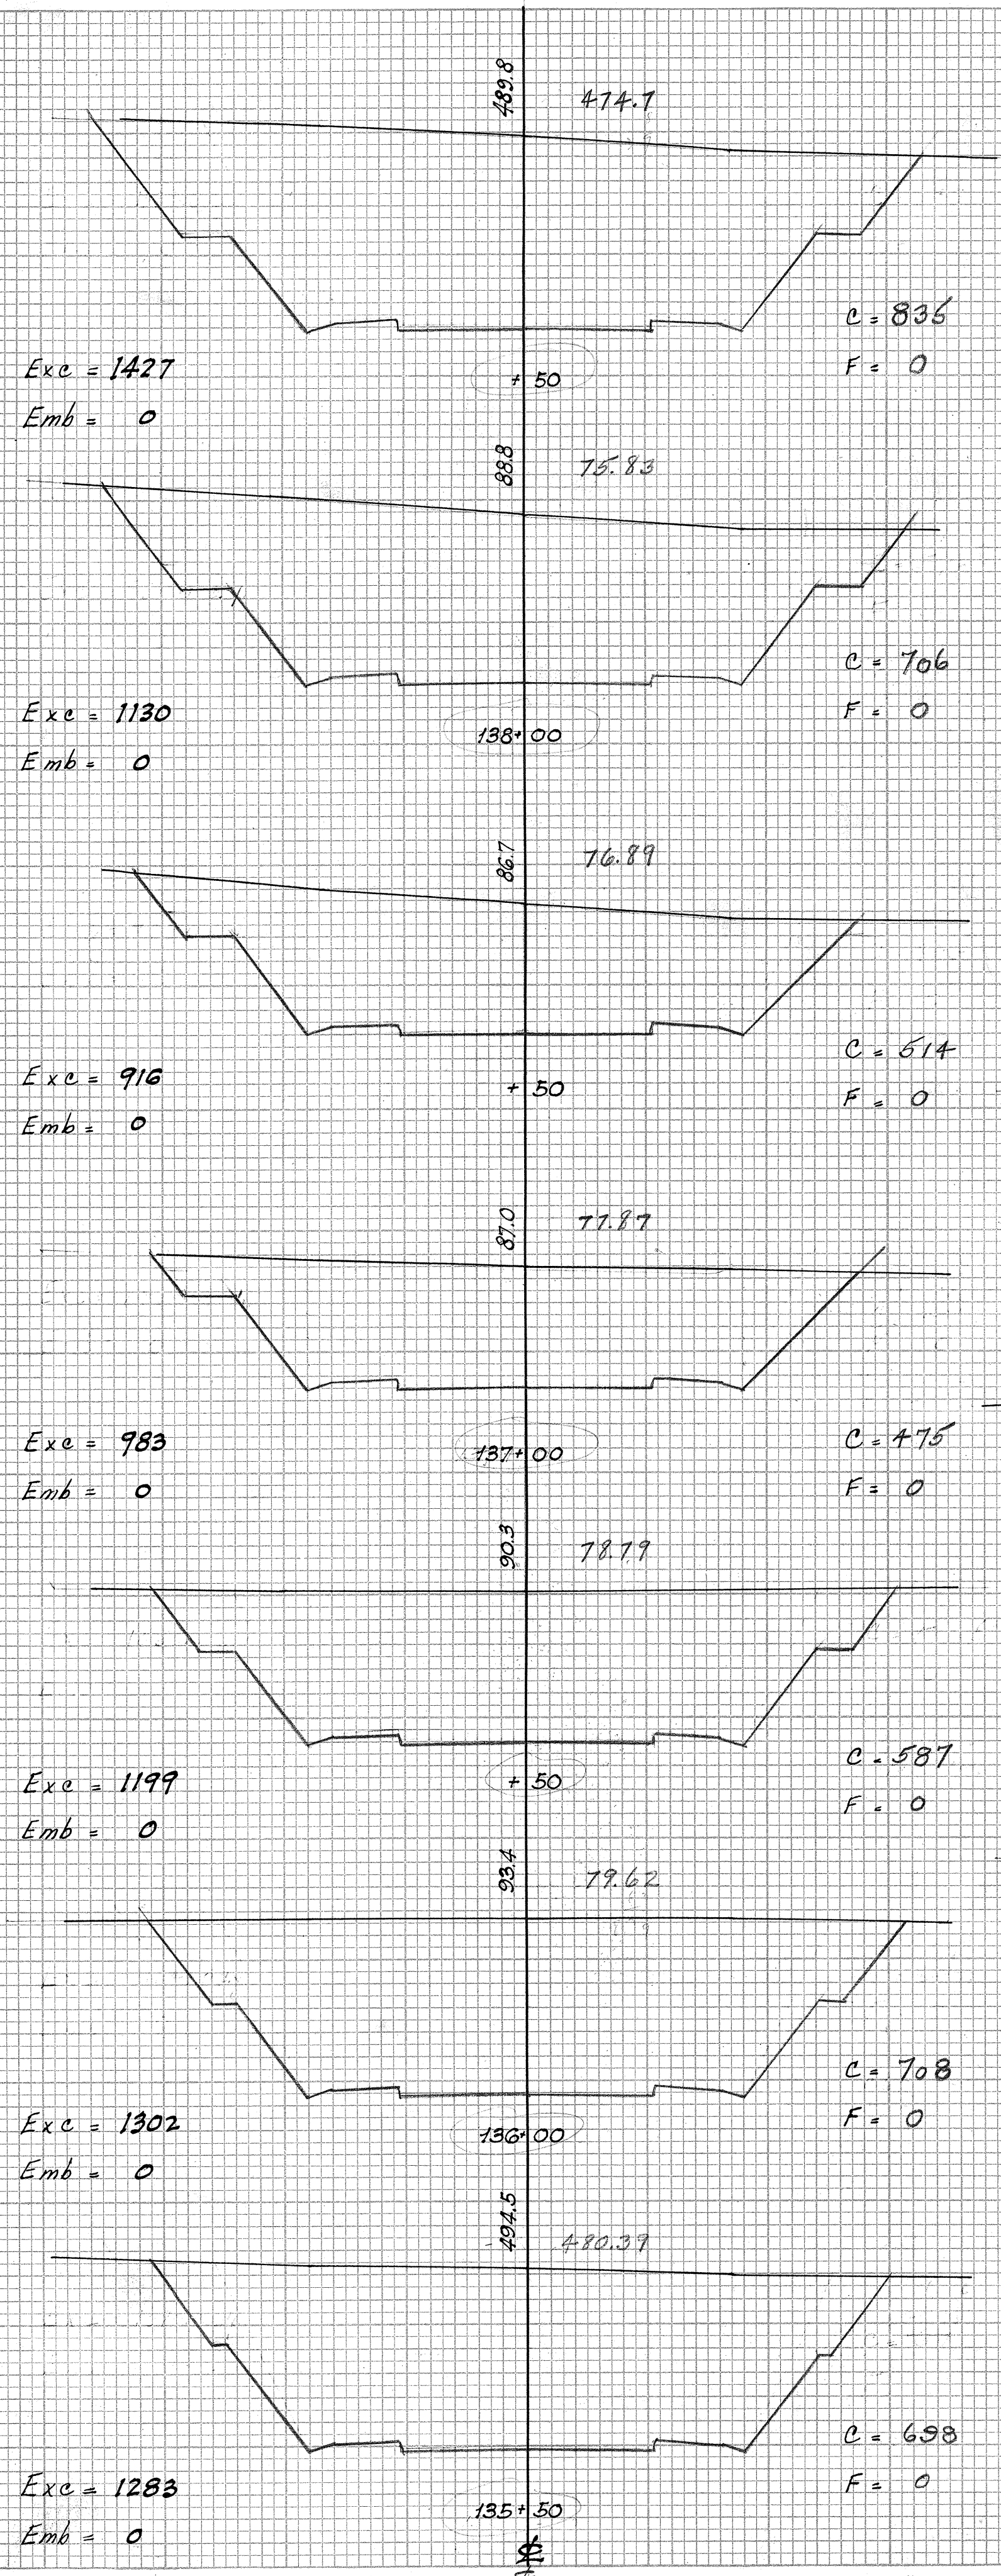


FINAL SURVEYED BY DATE
SURVEY PLOTTED BY DATE
NOTE BOOK NO. AREAS CHECKED


ORIGINAL SURVEYED BY DATE
SURVEY PLOTTED BY DATE
NOTE BOOK NO. AREAS CHECKED

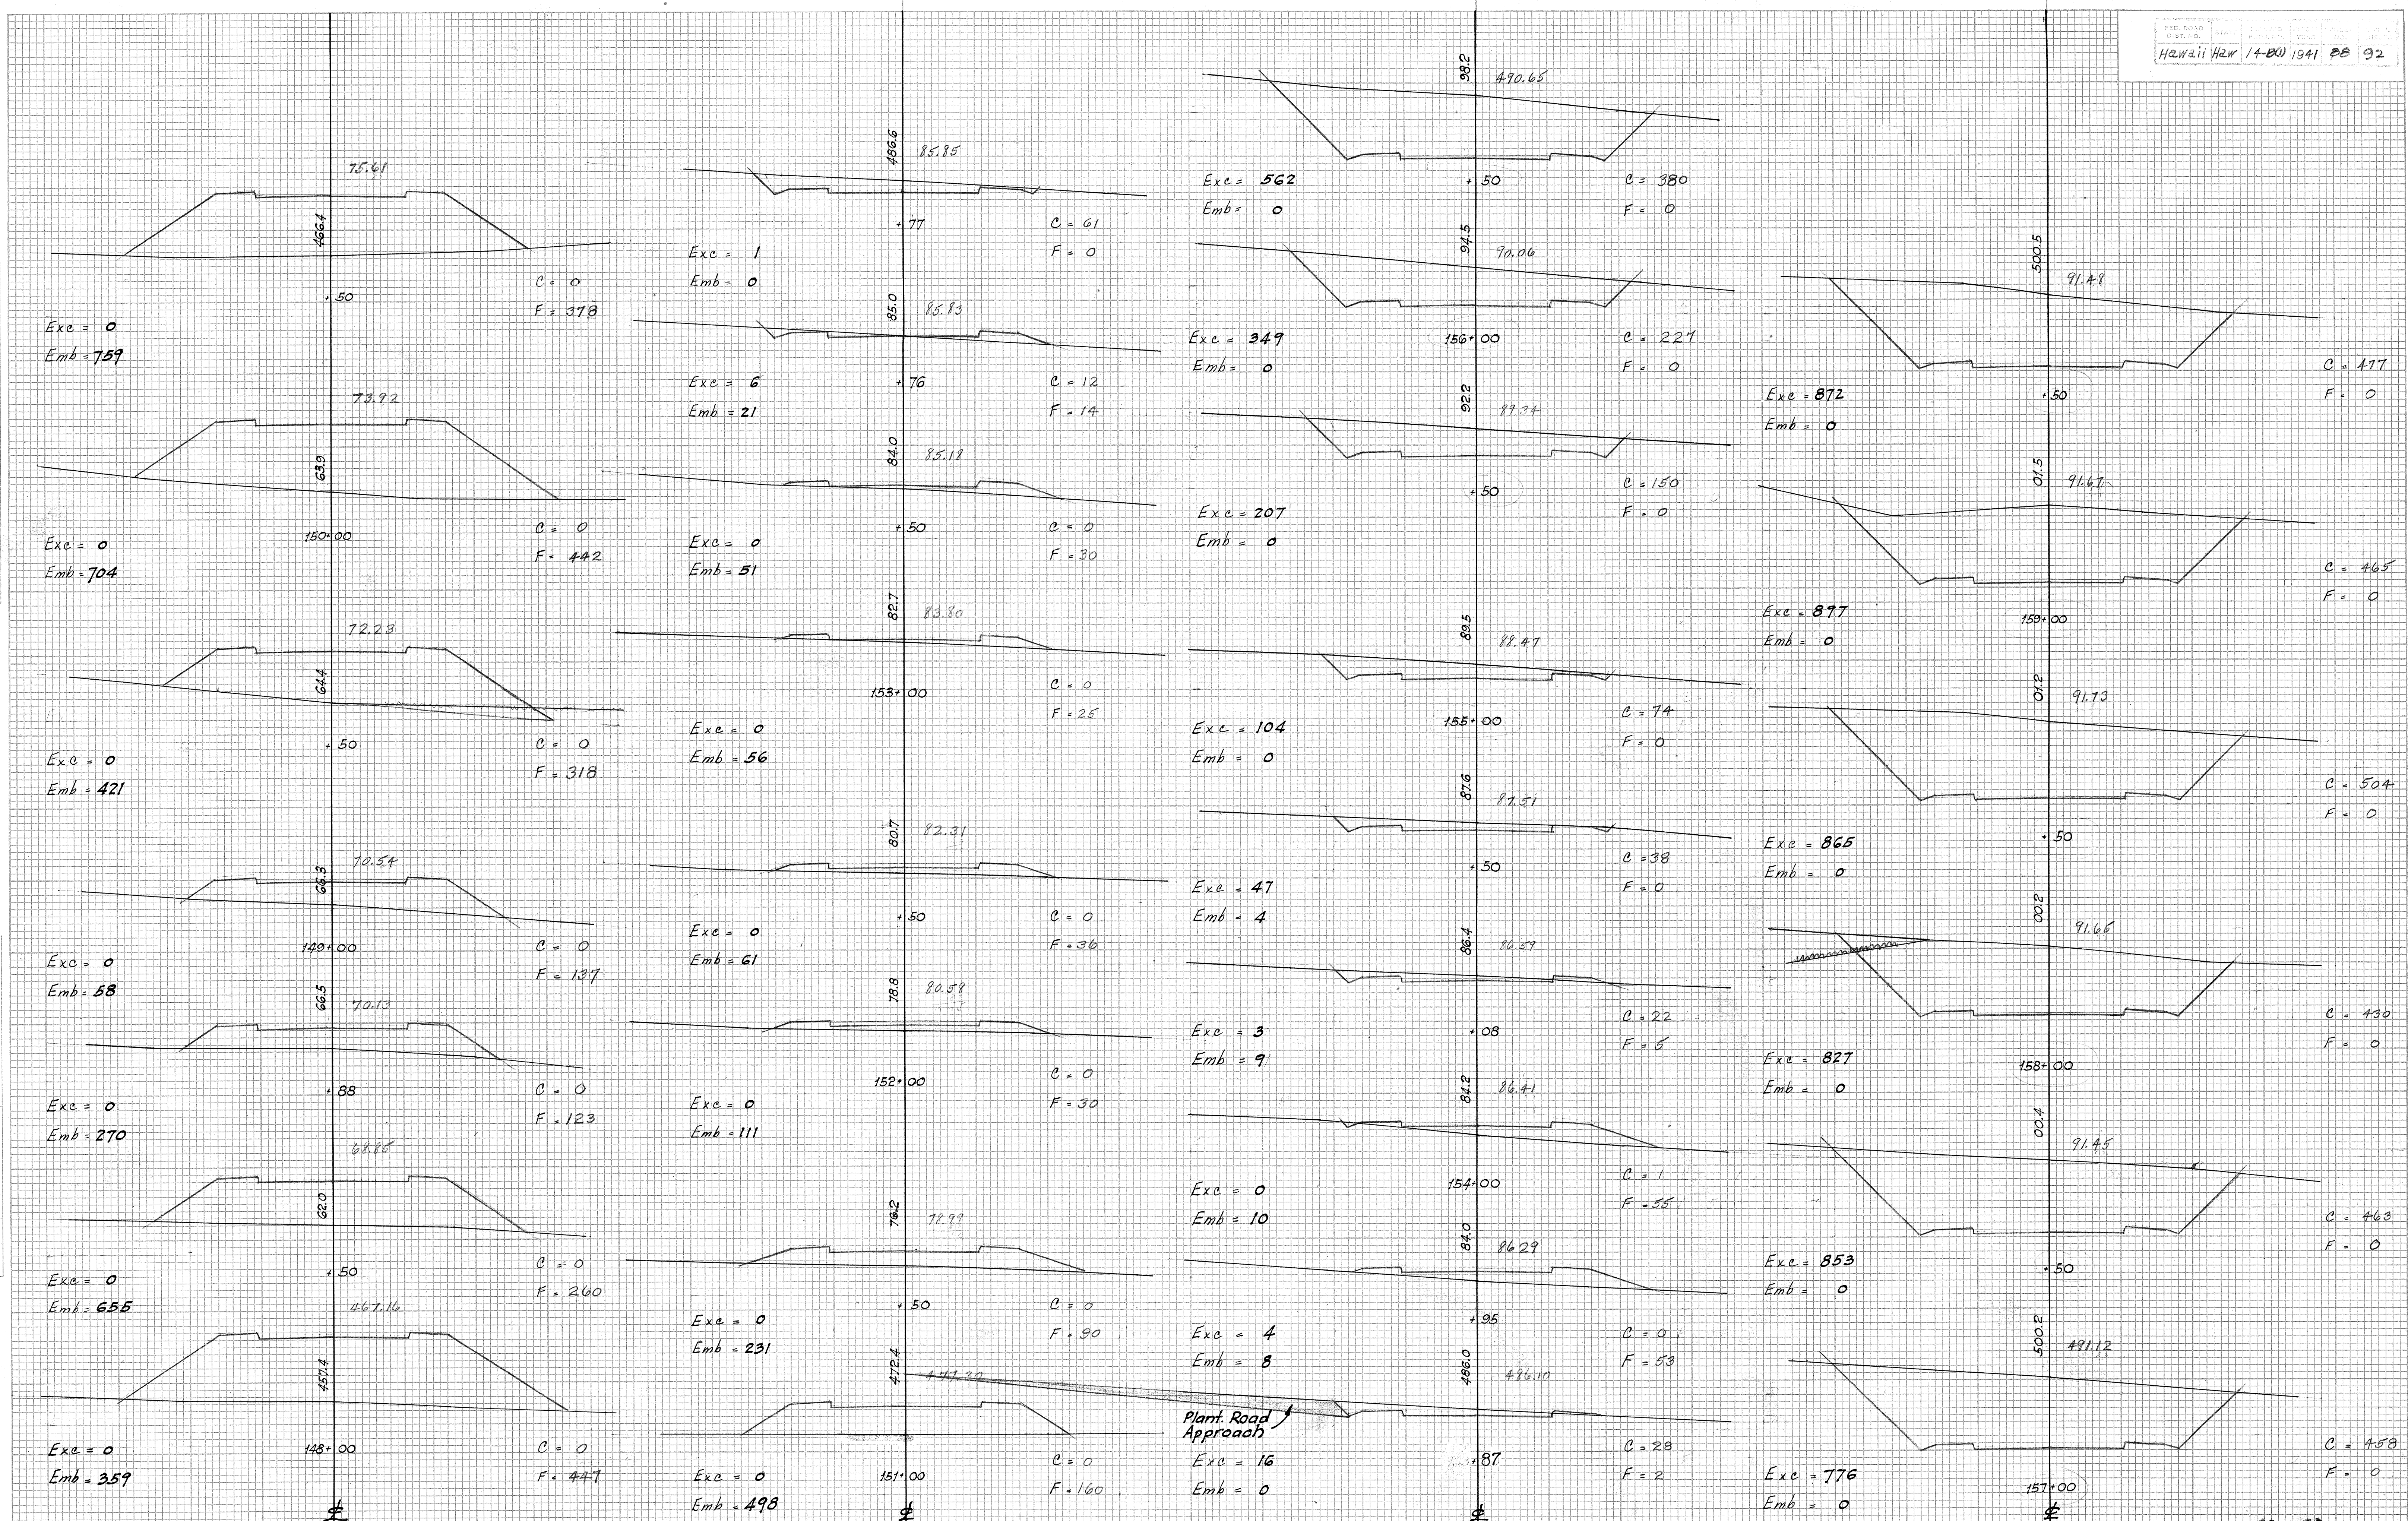

FINAL SURVEY NO. _____
 SURVEY BOOK NO. _____
 PLOTTED TEMPLATE AREAS CHECKED




ORIGINAL SURVEY NO. _____
 SURVEY BOOK NO. _____
 PLOTTED TEMPLATE AREAS CHECKED

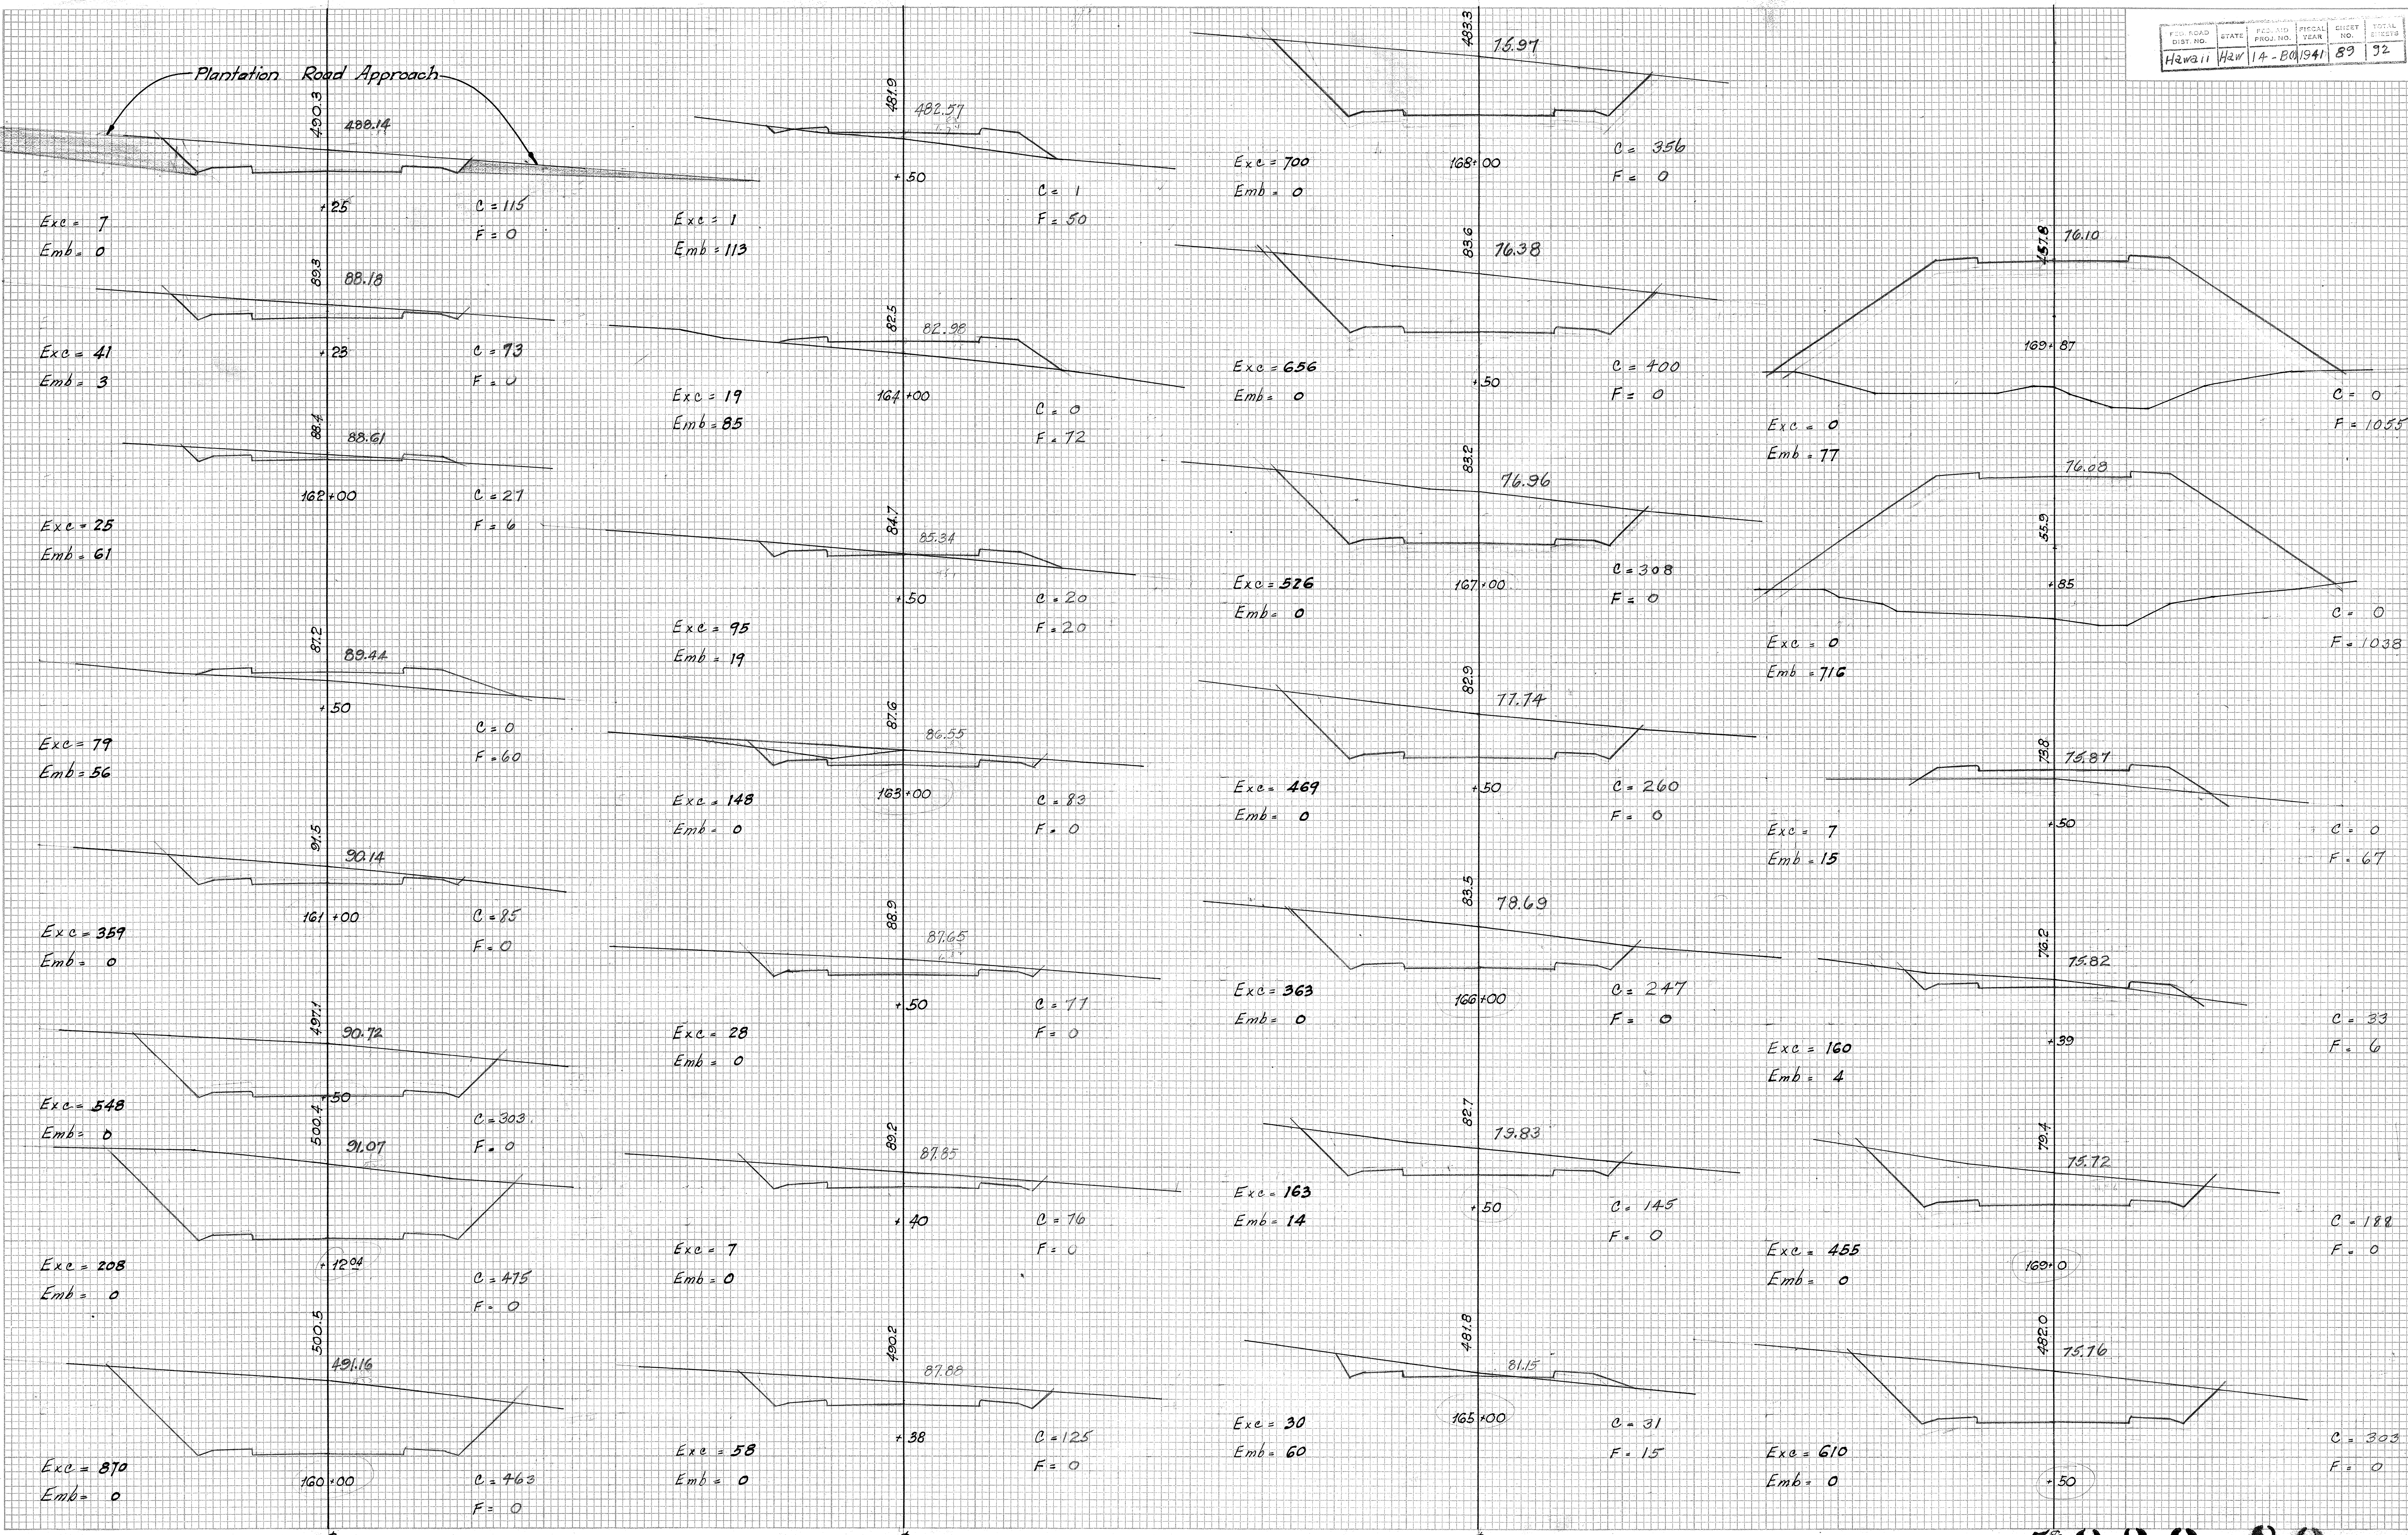

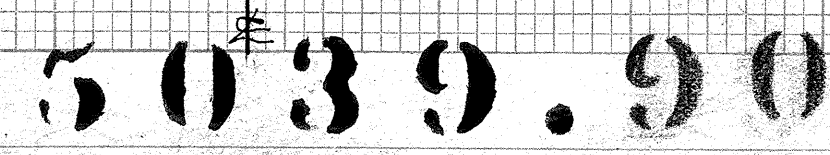


FINAL SURVEY
 SURVEY PLOTTED
 NOTE BOOK AREAS
 NO. AREAS CHECKED

ORIGINAL SURVEY
 SURVEY PLOTTED
 NOTE BOOK AREAS
 NO. AREAS CHECKED

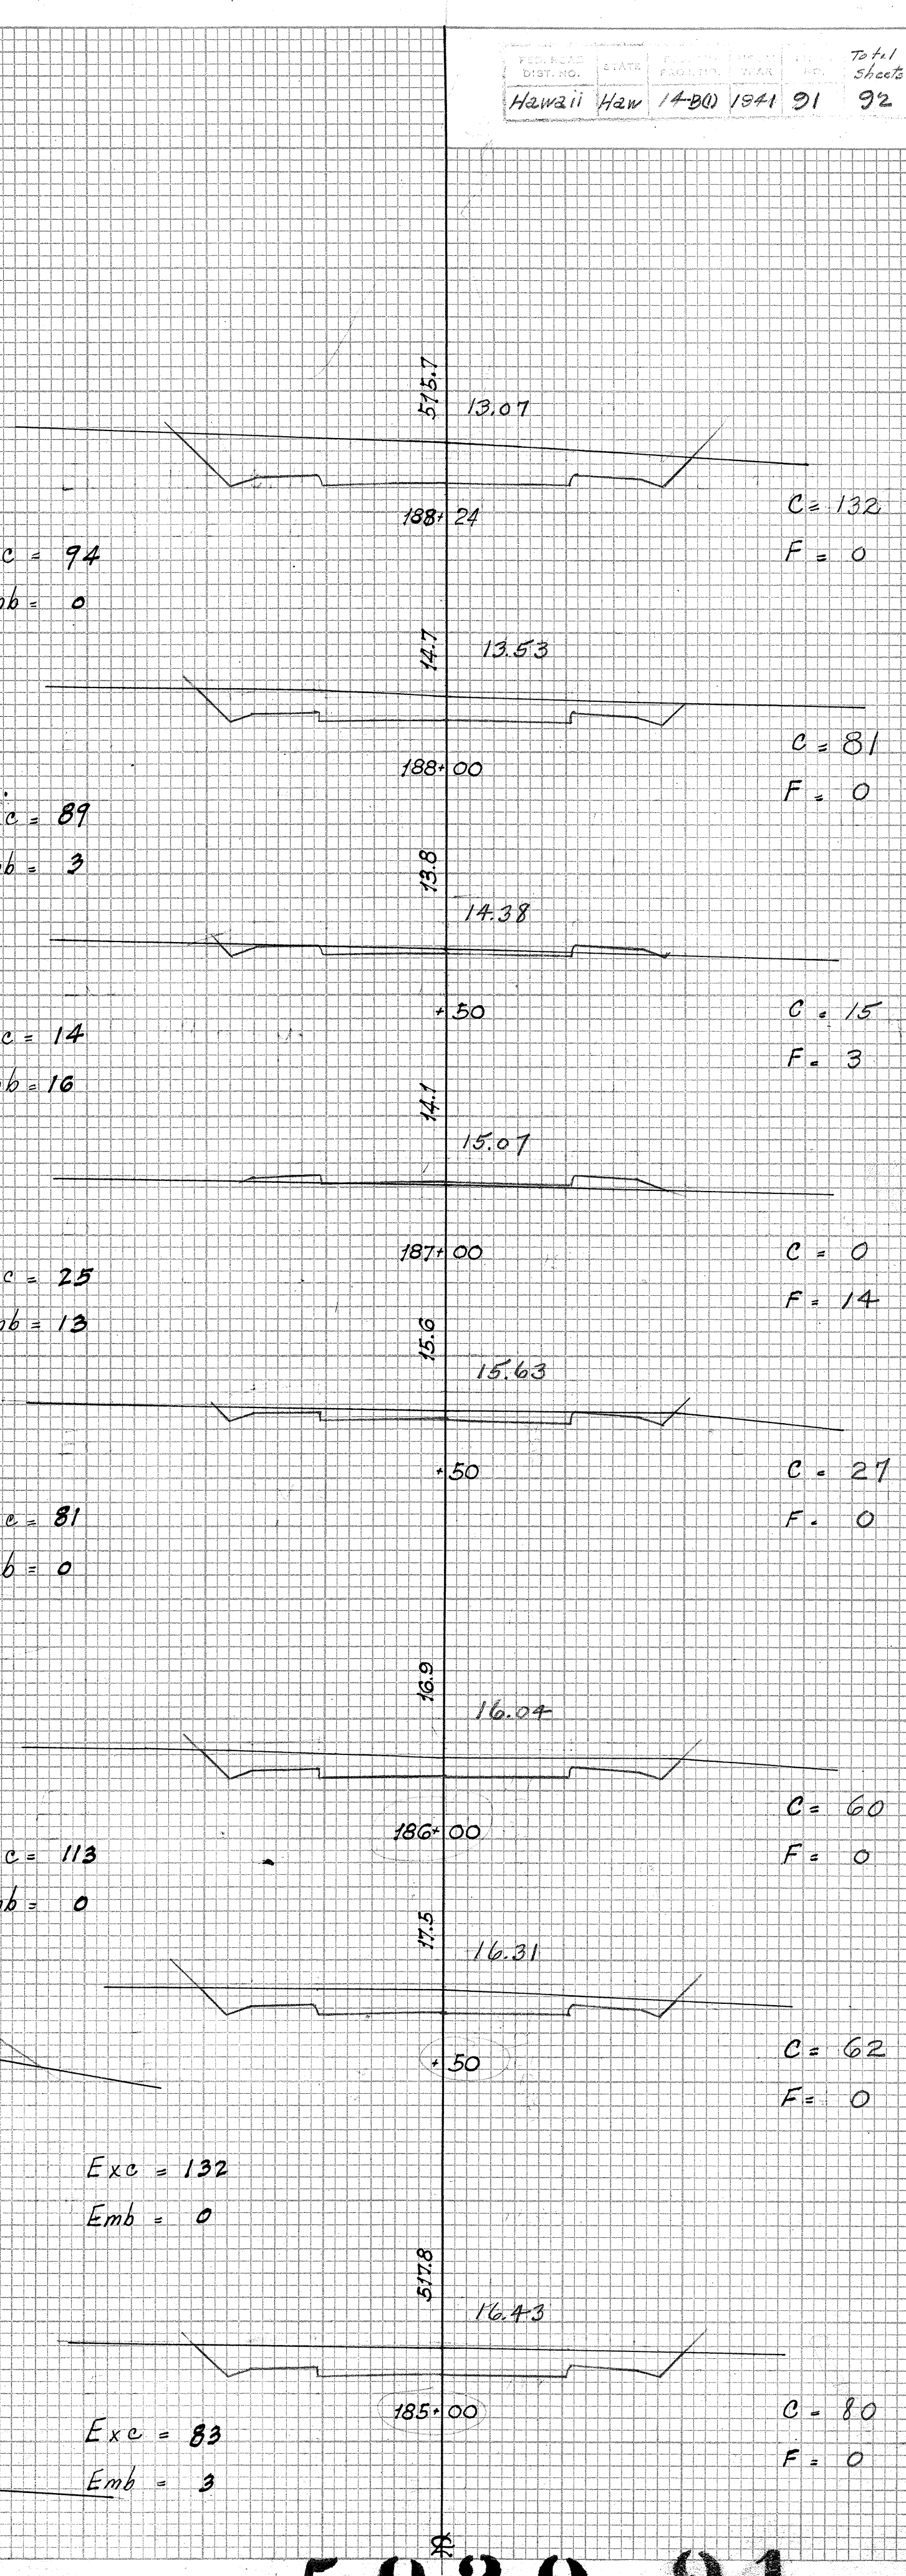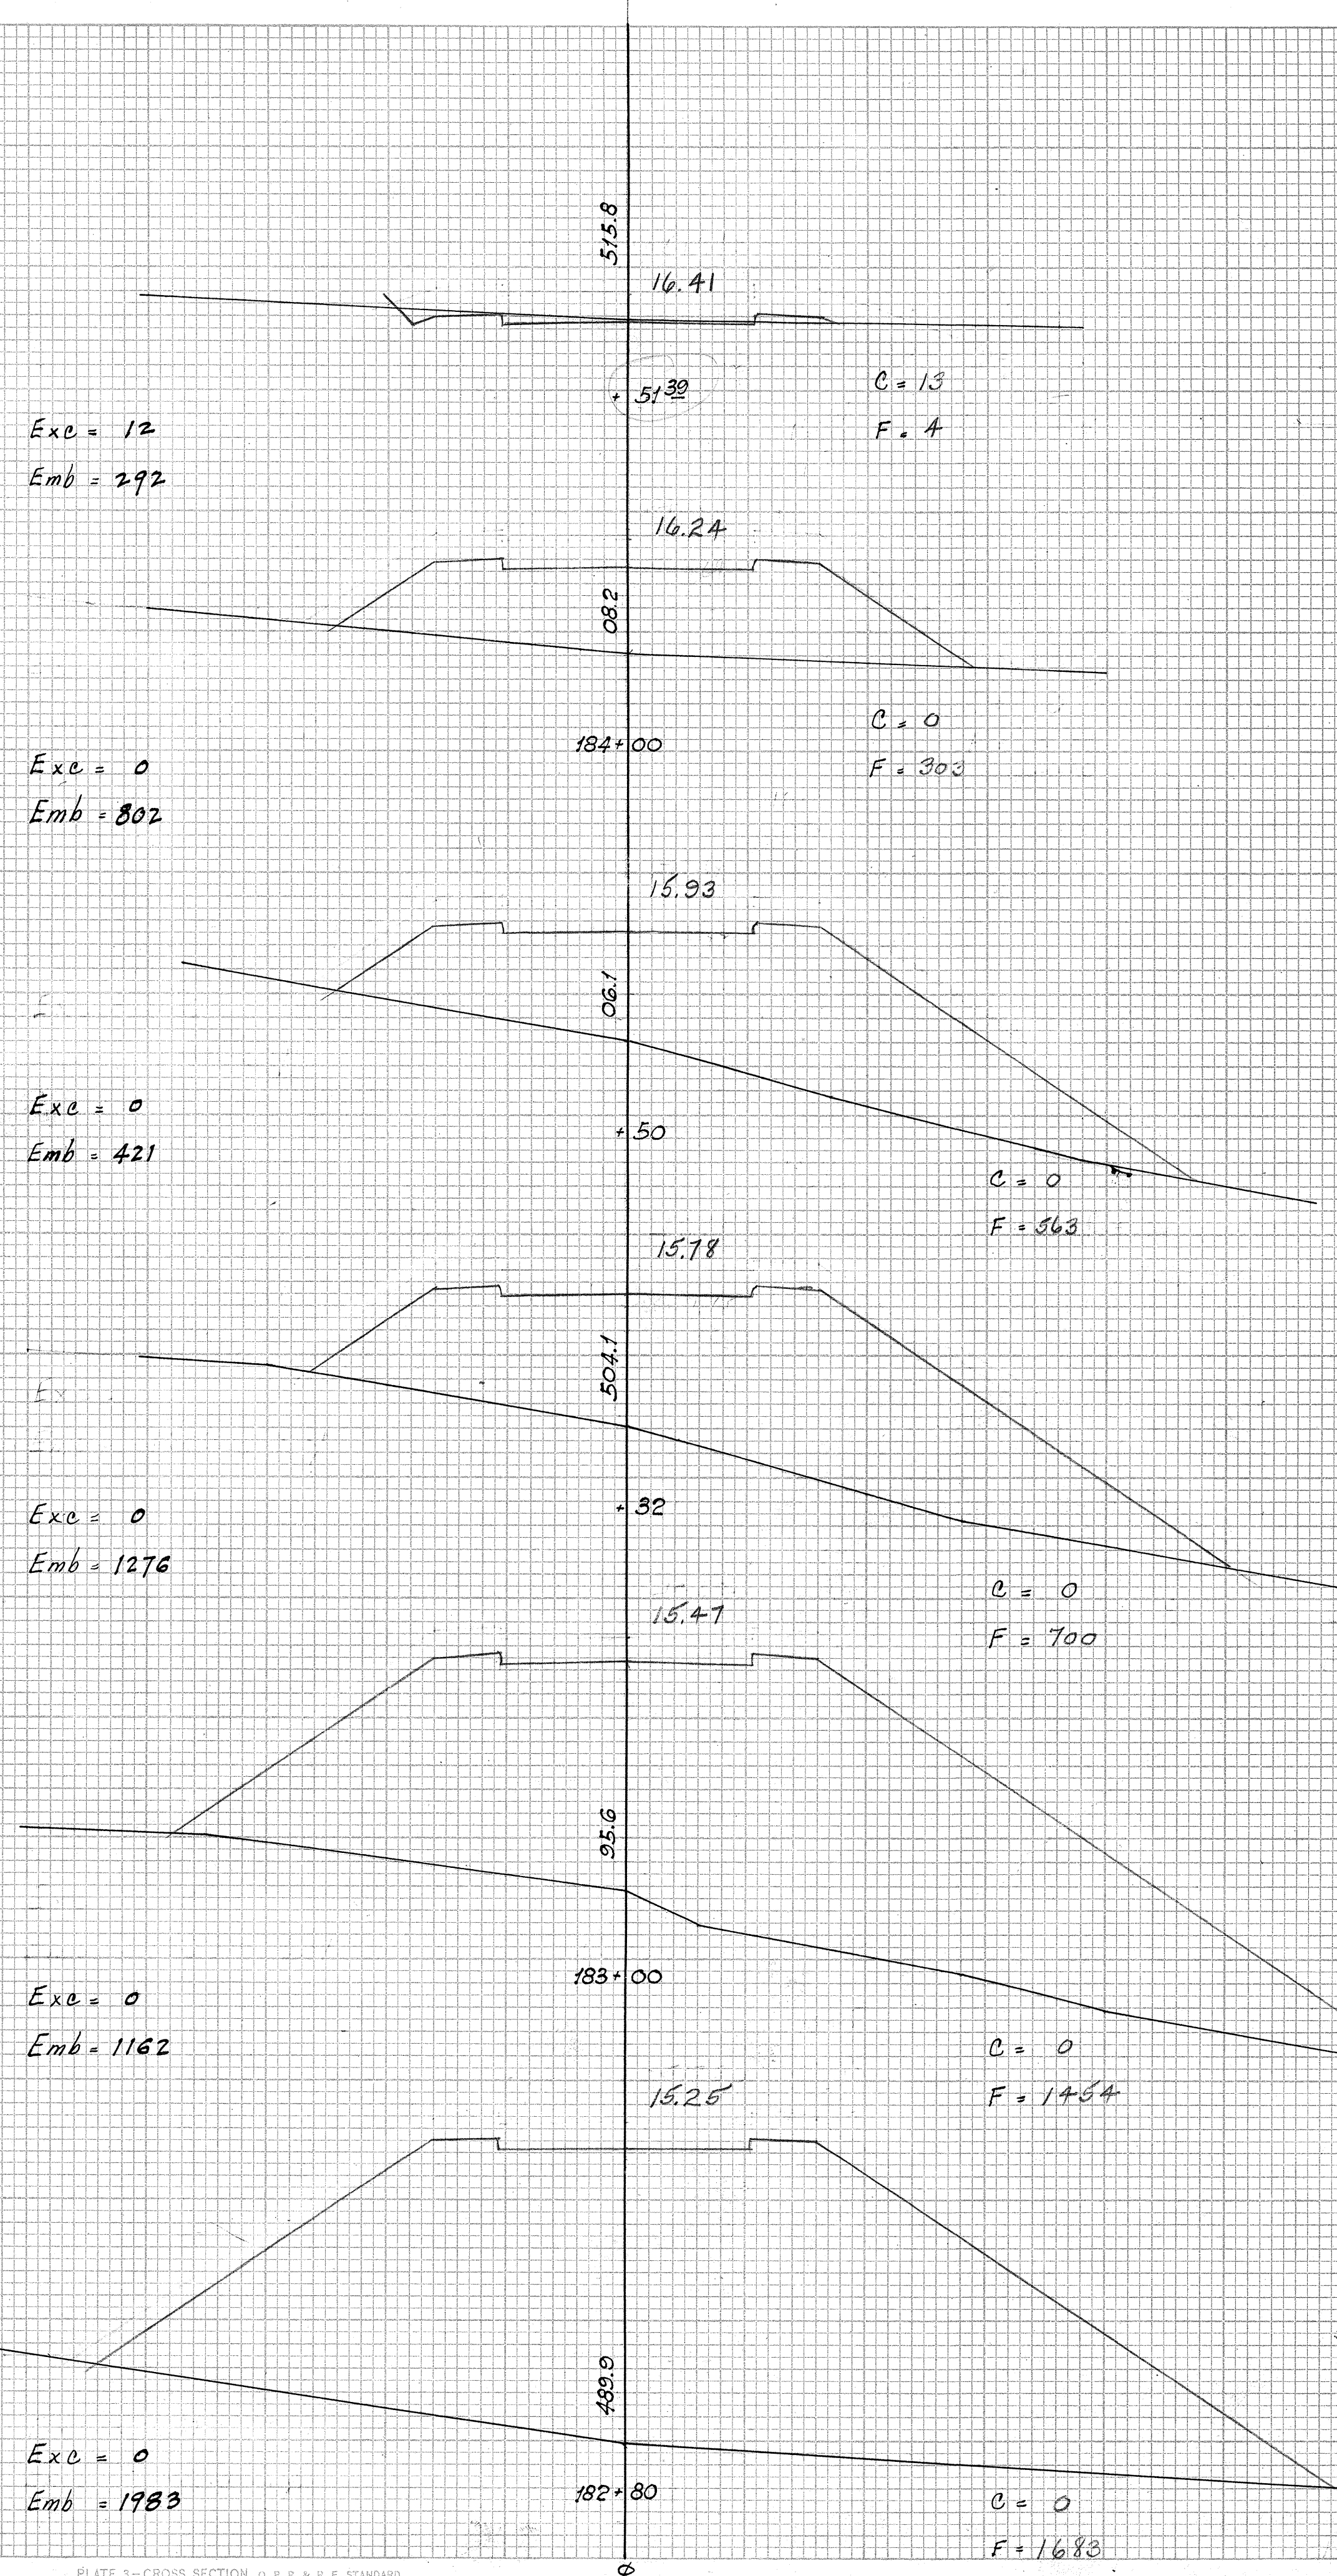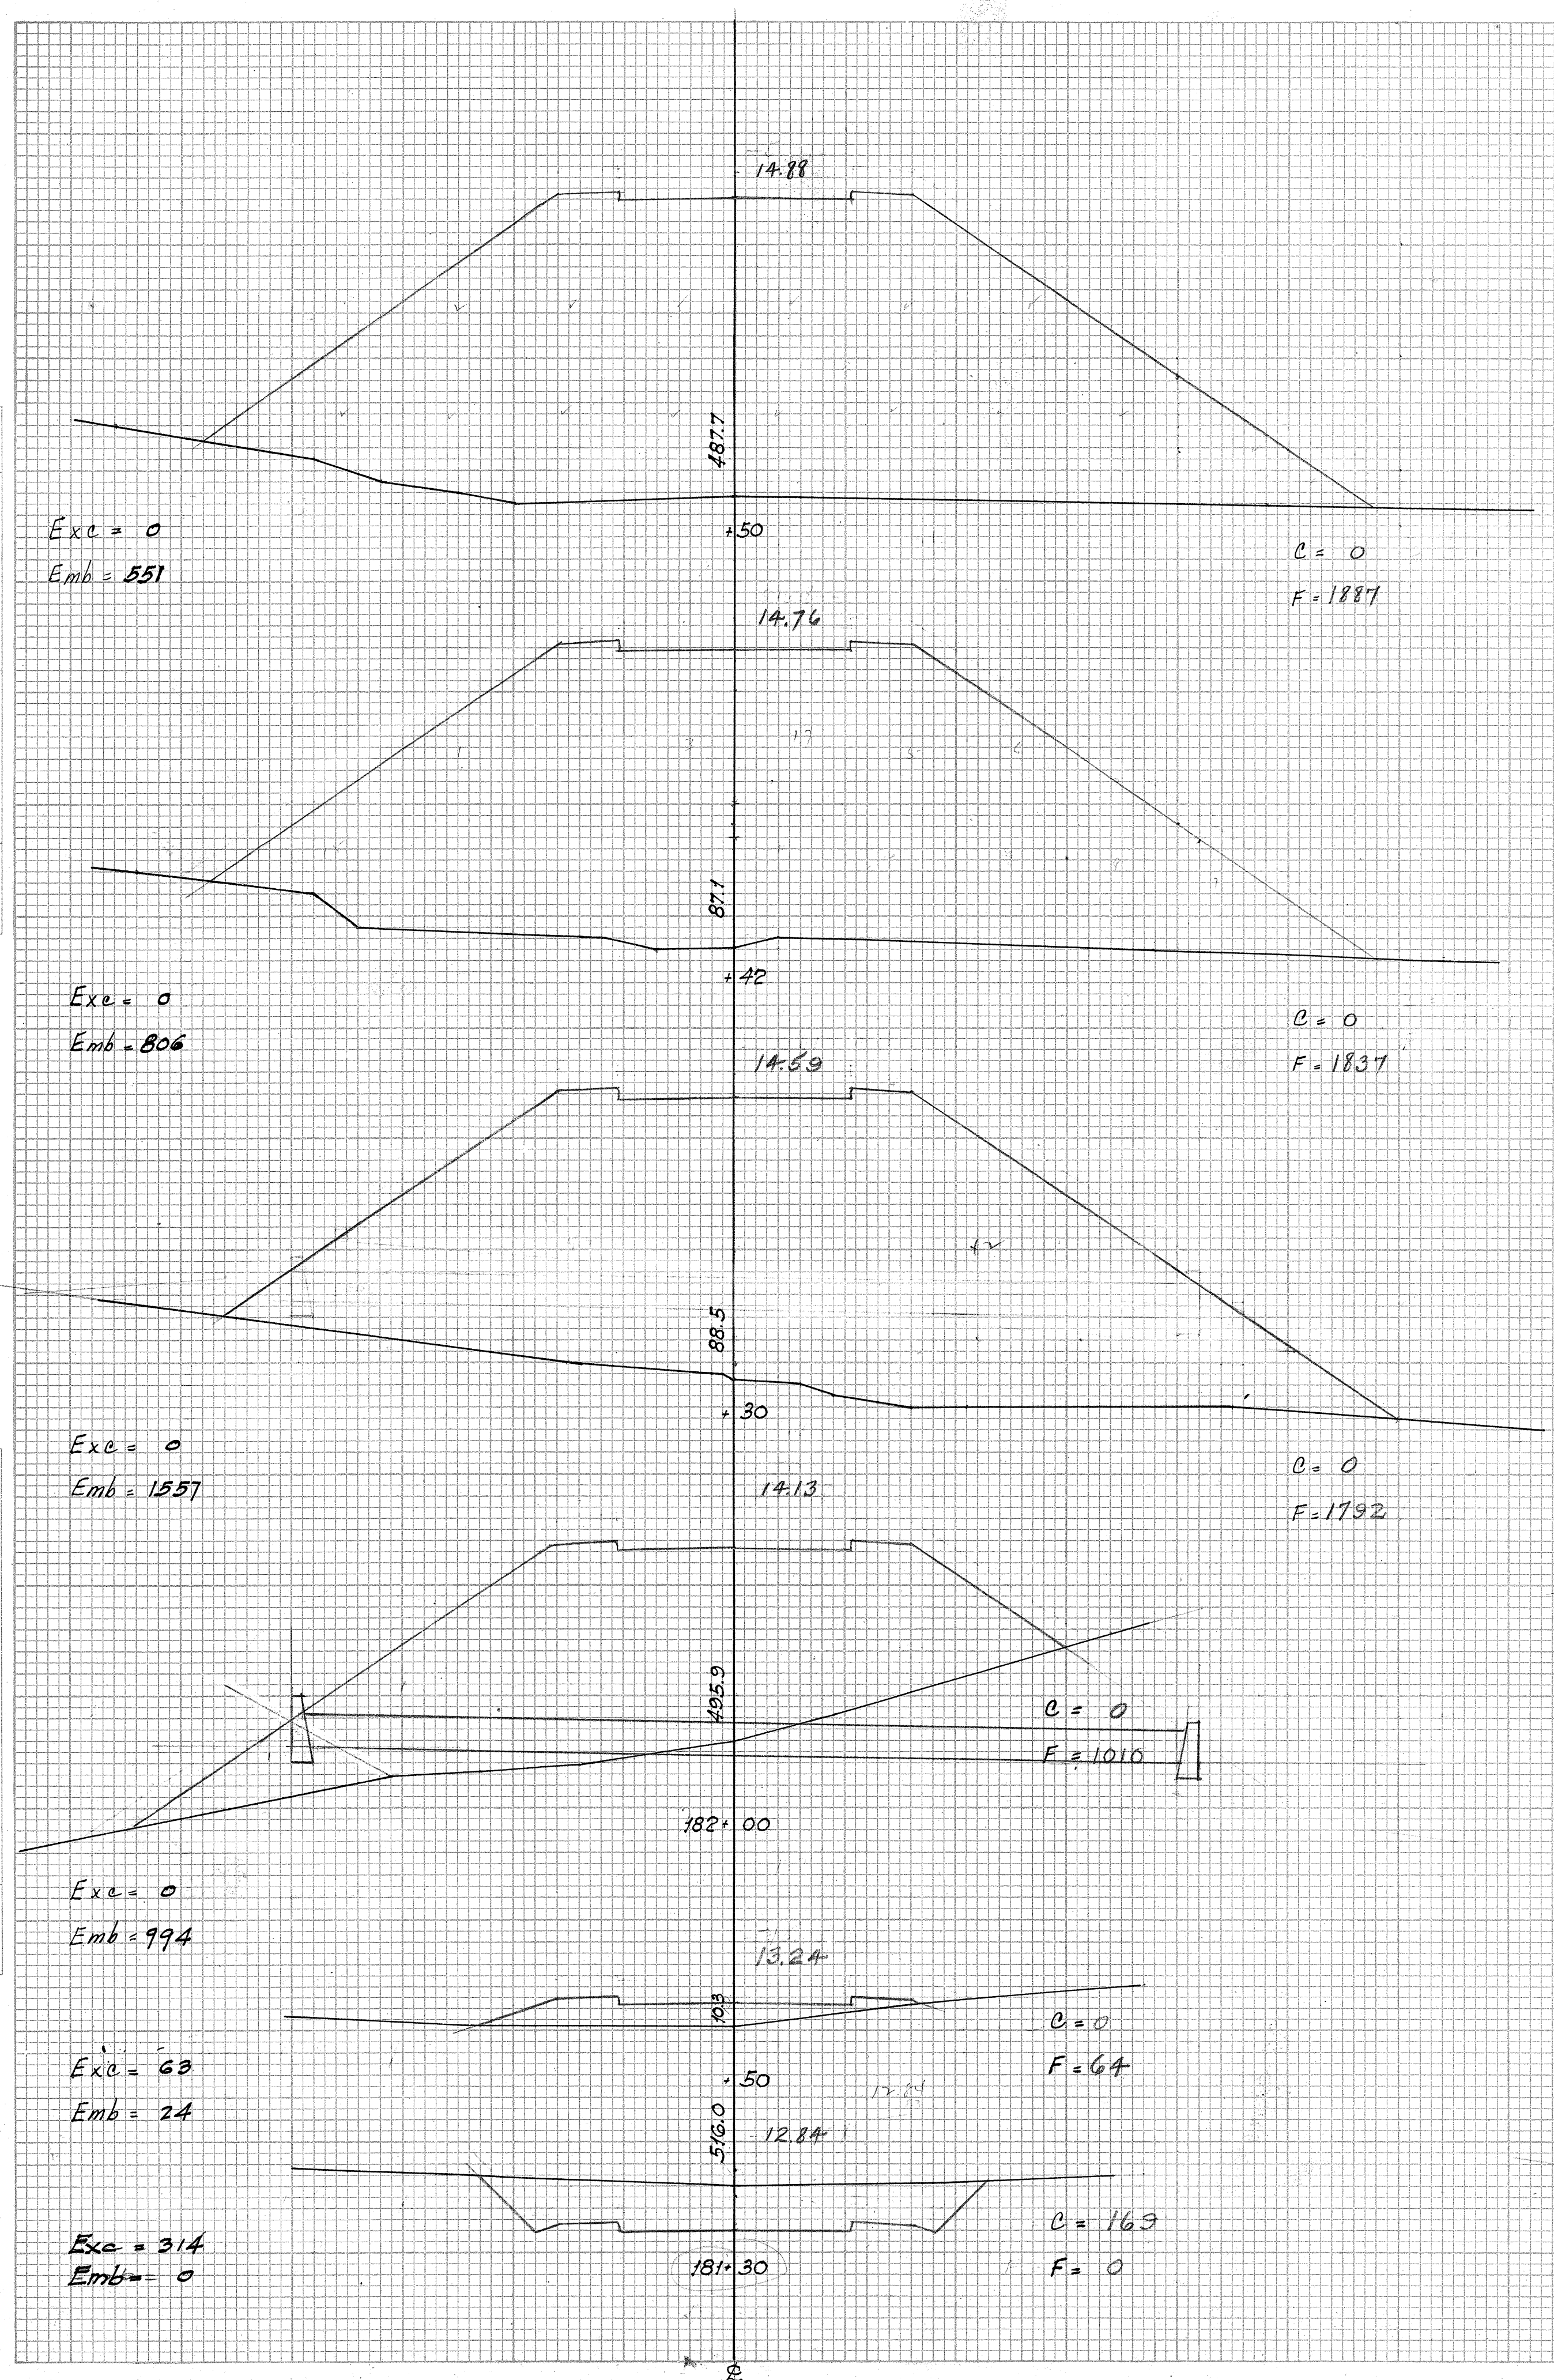

DATE _____ BY _____
 SURVEYED _____
 NOTE BOOK _____
 NO. _____
 AREAS CHECKED _____

DATE _____ BY _____
 SURVEYED _____
 NOTE BOOK _____
 NO. _____
 AREAS CHECKED _____

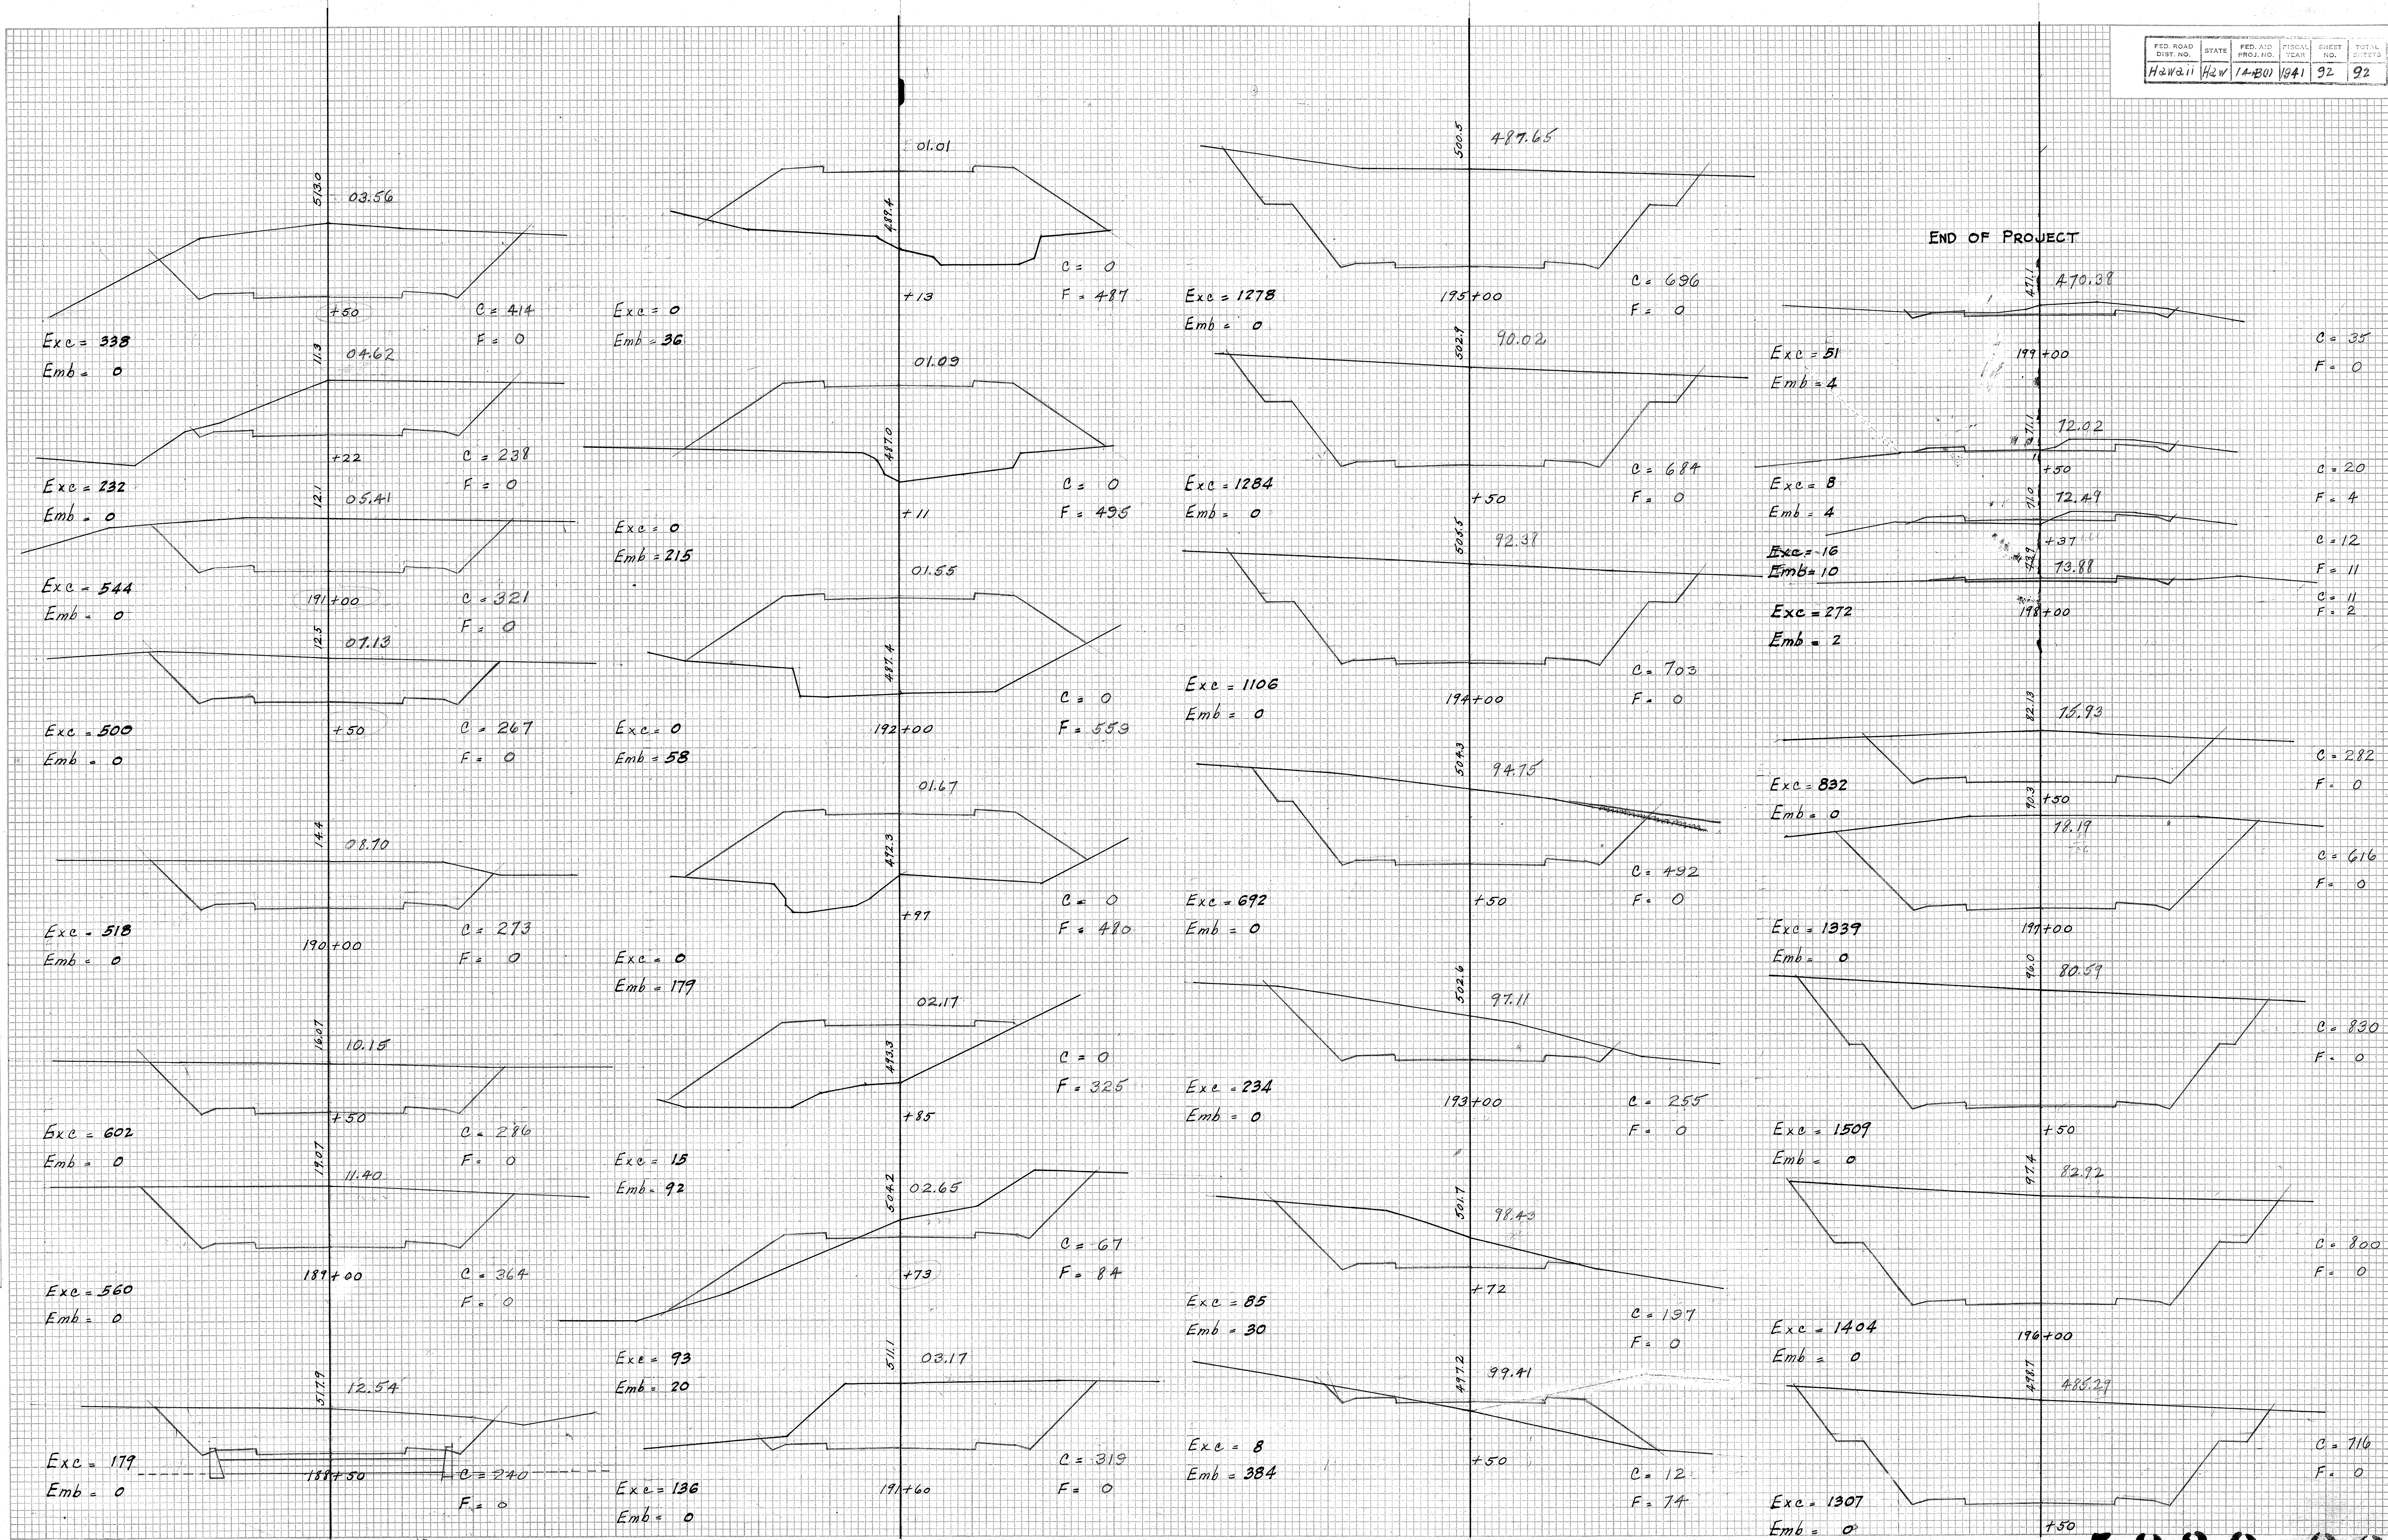

END OF PROJECT