

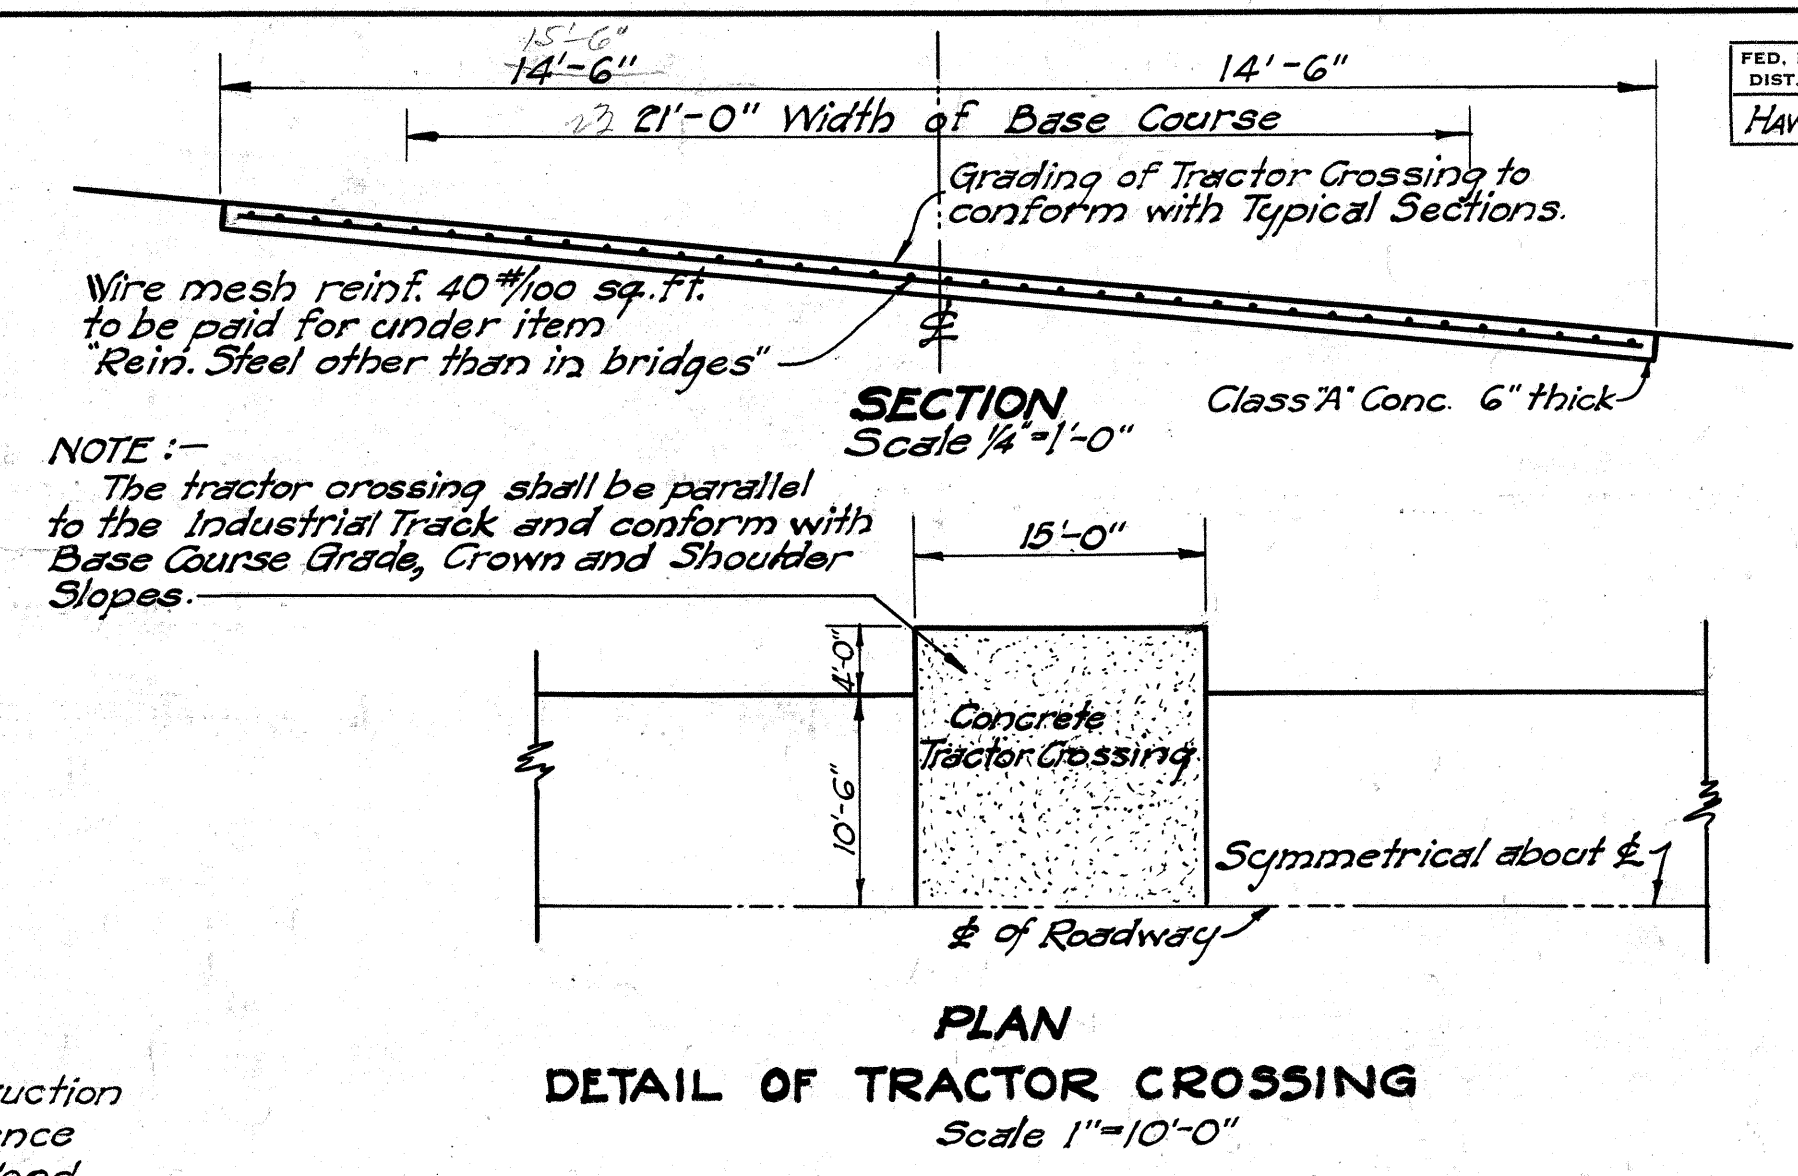
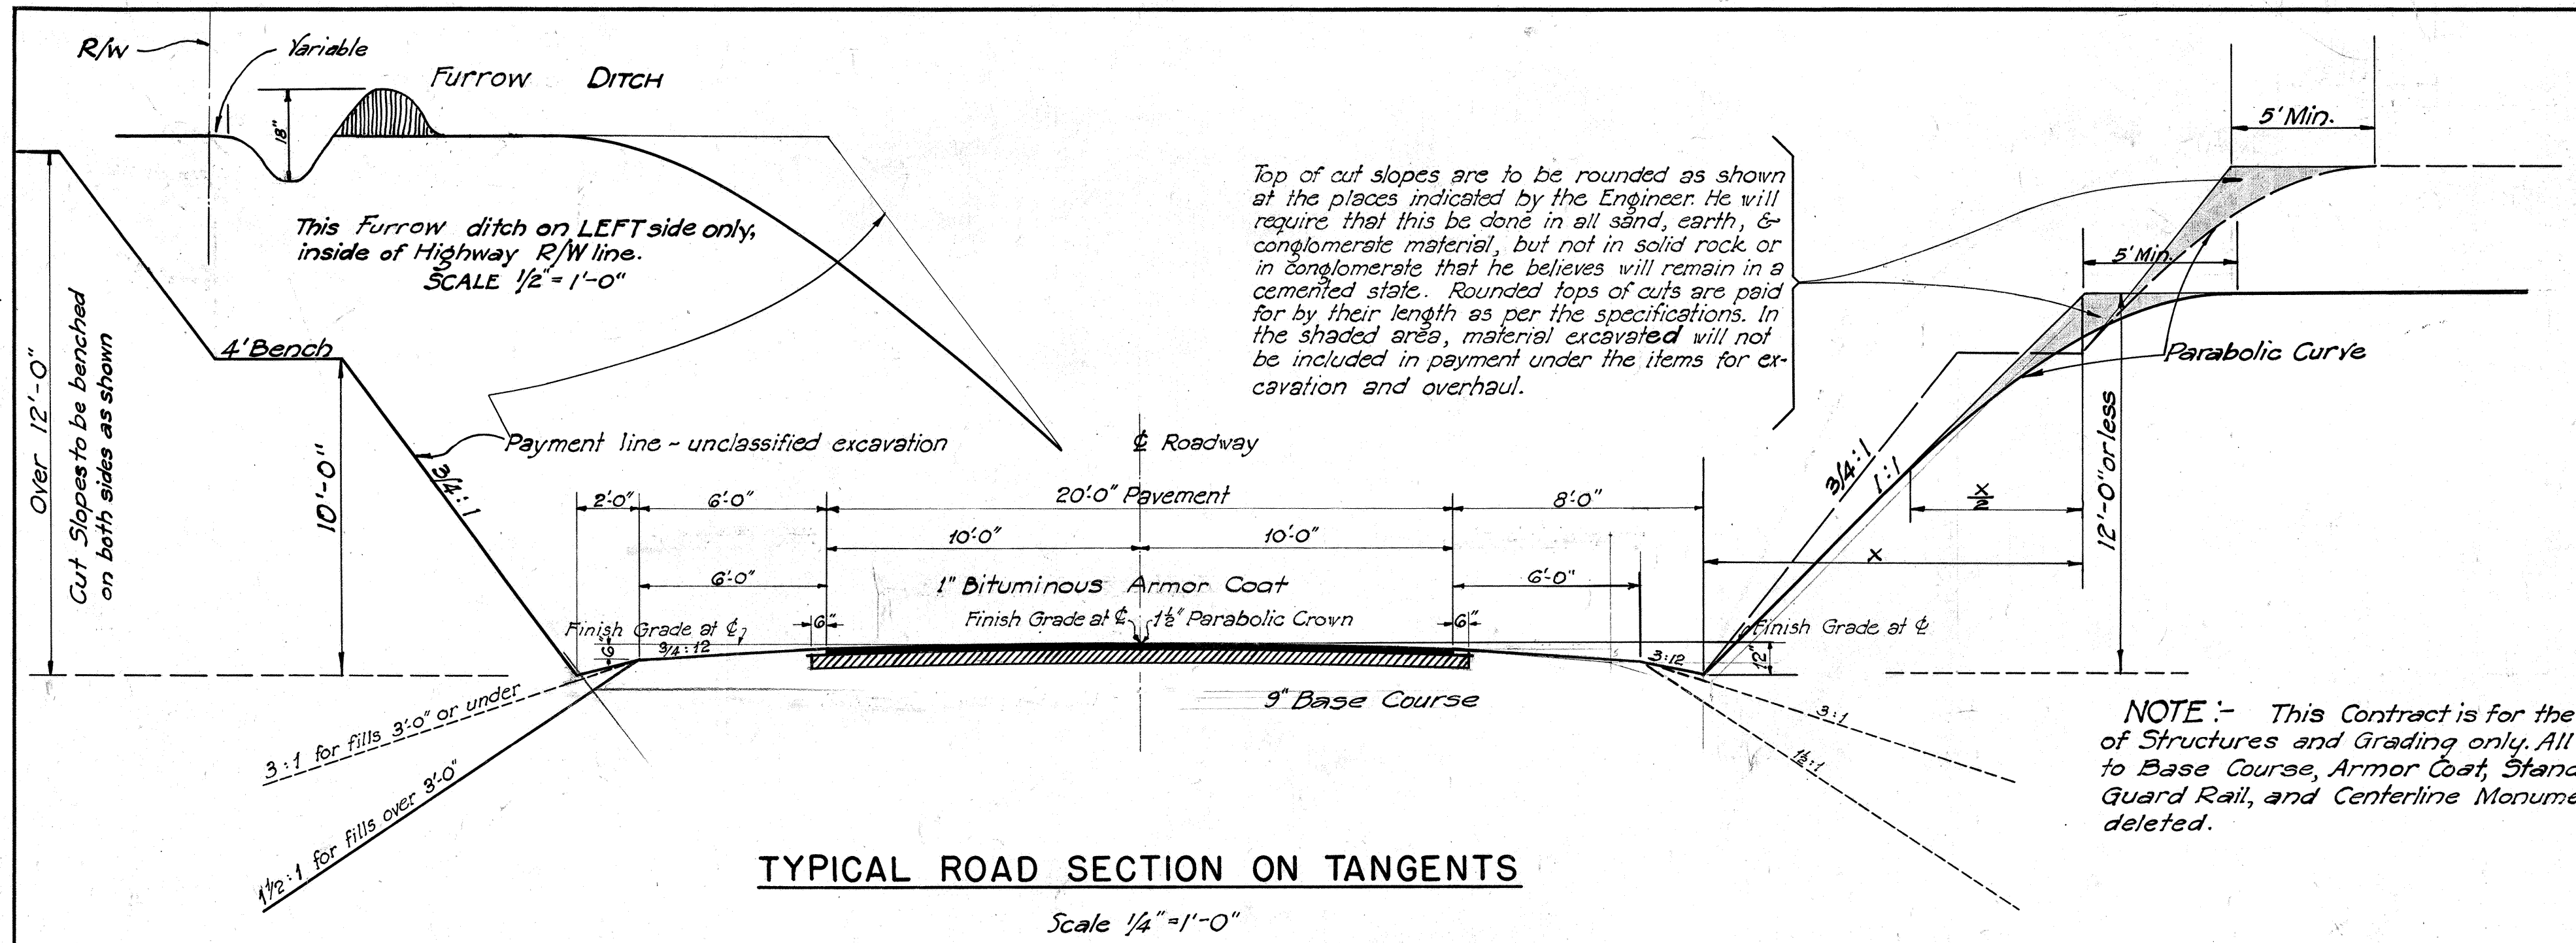


FED. ROAD DIST. NO.	STATE	FED. AID PROJ. NO.	FISCAL YEAR	SHEET NO.	TOTAL SHEETS
HAWAII	HAW.	14-B(0)	1941	2	96

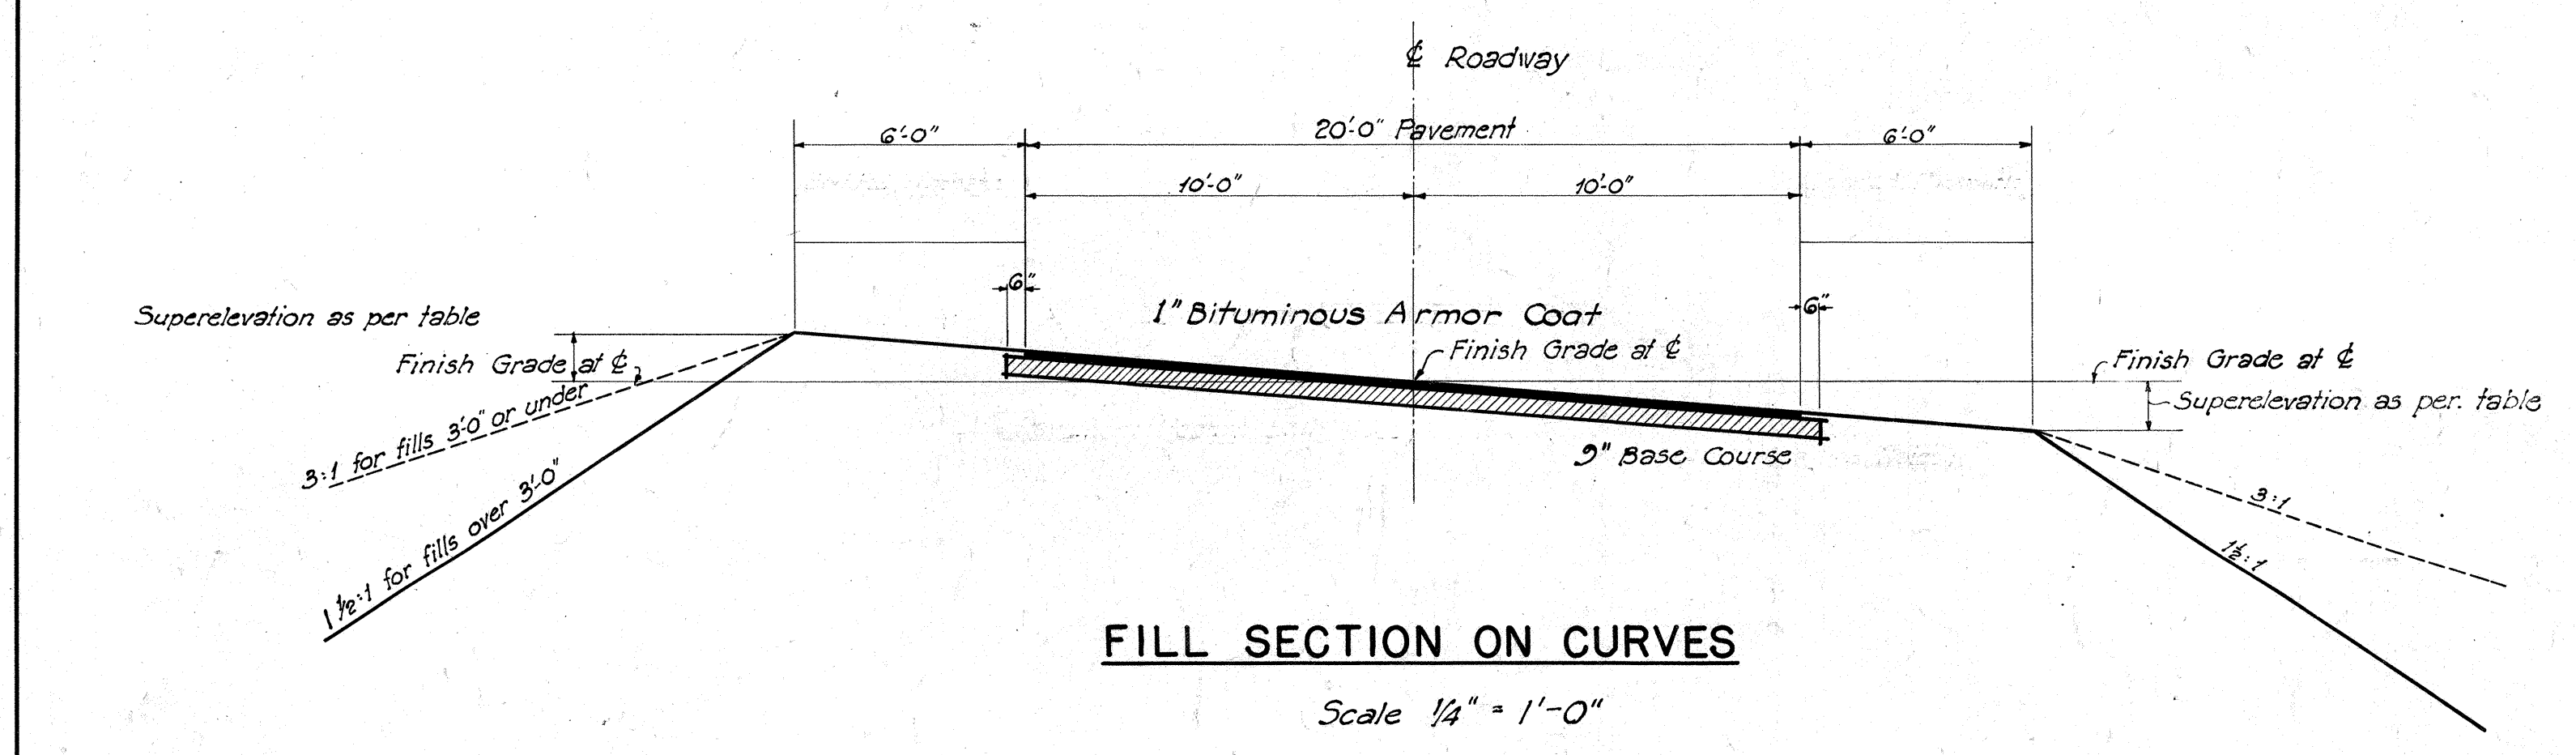

NOTE:- This Contract is for the Construction of Structures and Grading only. All reference to Base Course, Armor Coat, Standard Wood Guard Rail, and Centerline Monuments is hereby deleted.

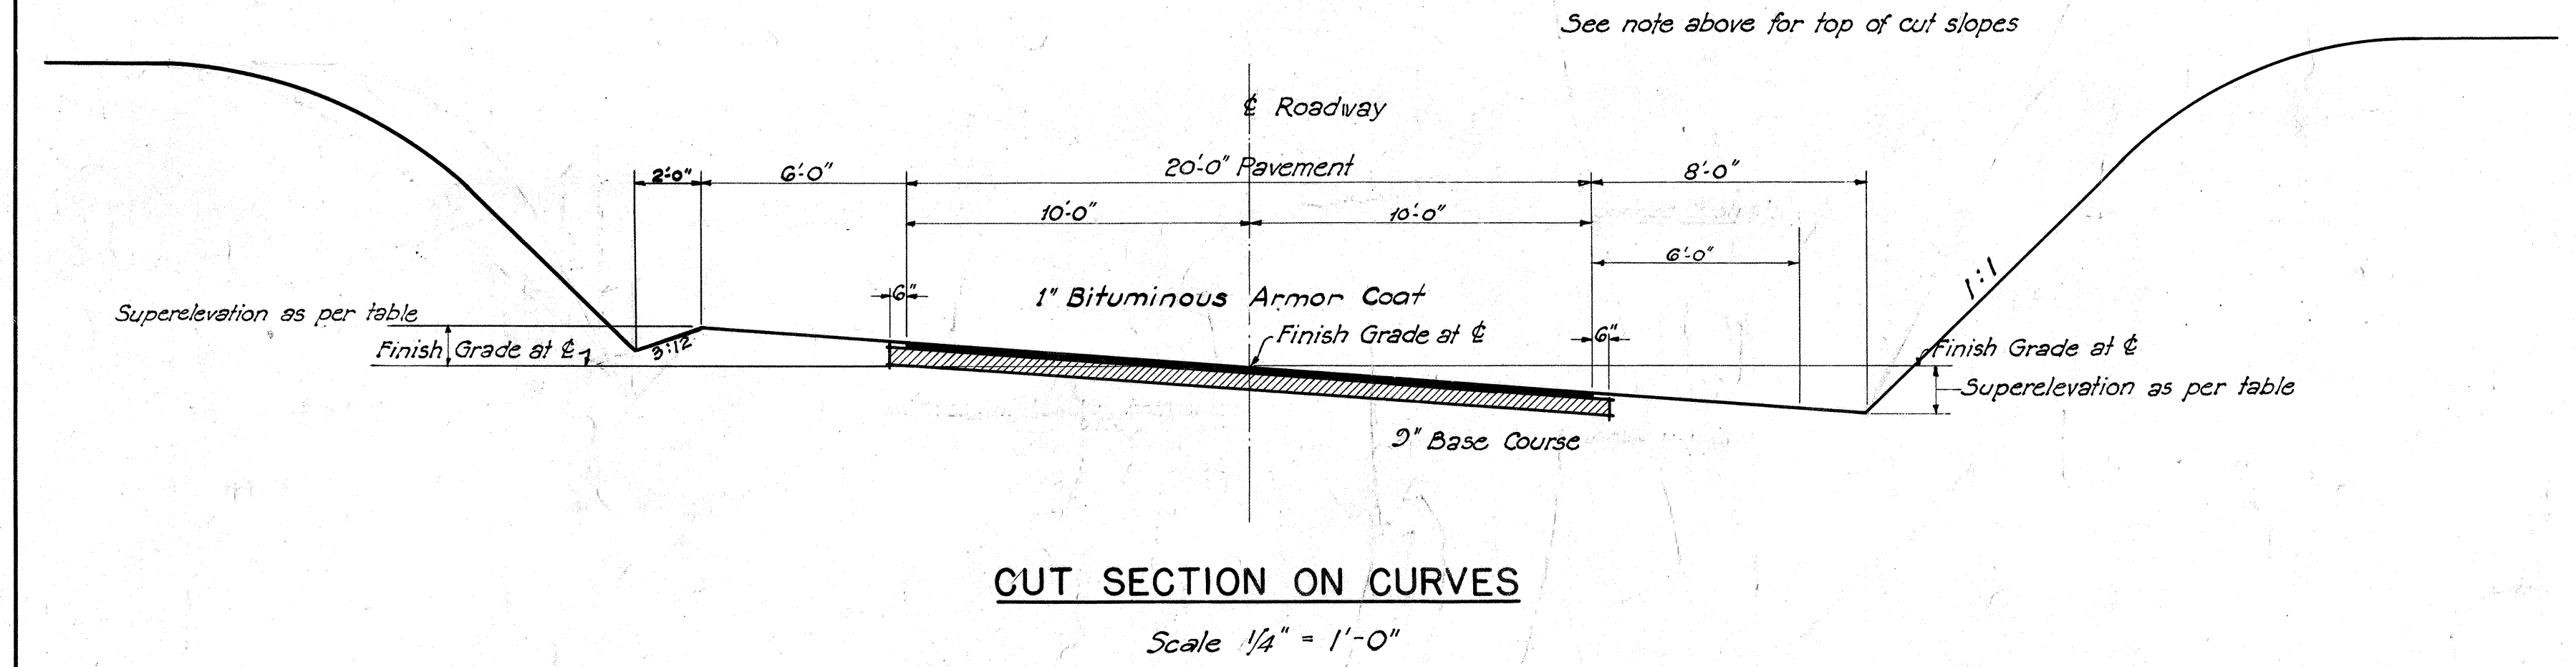

DATE	
SURVEY PLOTTED BY	
DRAWN BY	
TRACED BY	
NOTE BOOK	
QUANTITIES CHECKED BY	
CHECKED BY	

Change

TERRITORIAL HIGHWAY DEPARTMENT
TERRITORY OF HAWAII

TYPICAL ROAD SECTIONS
F.A.P. 14-B(0)