
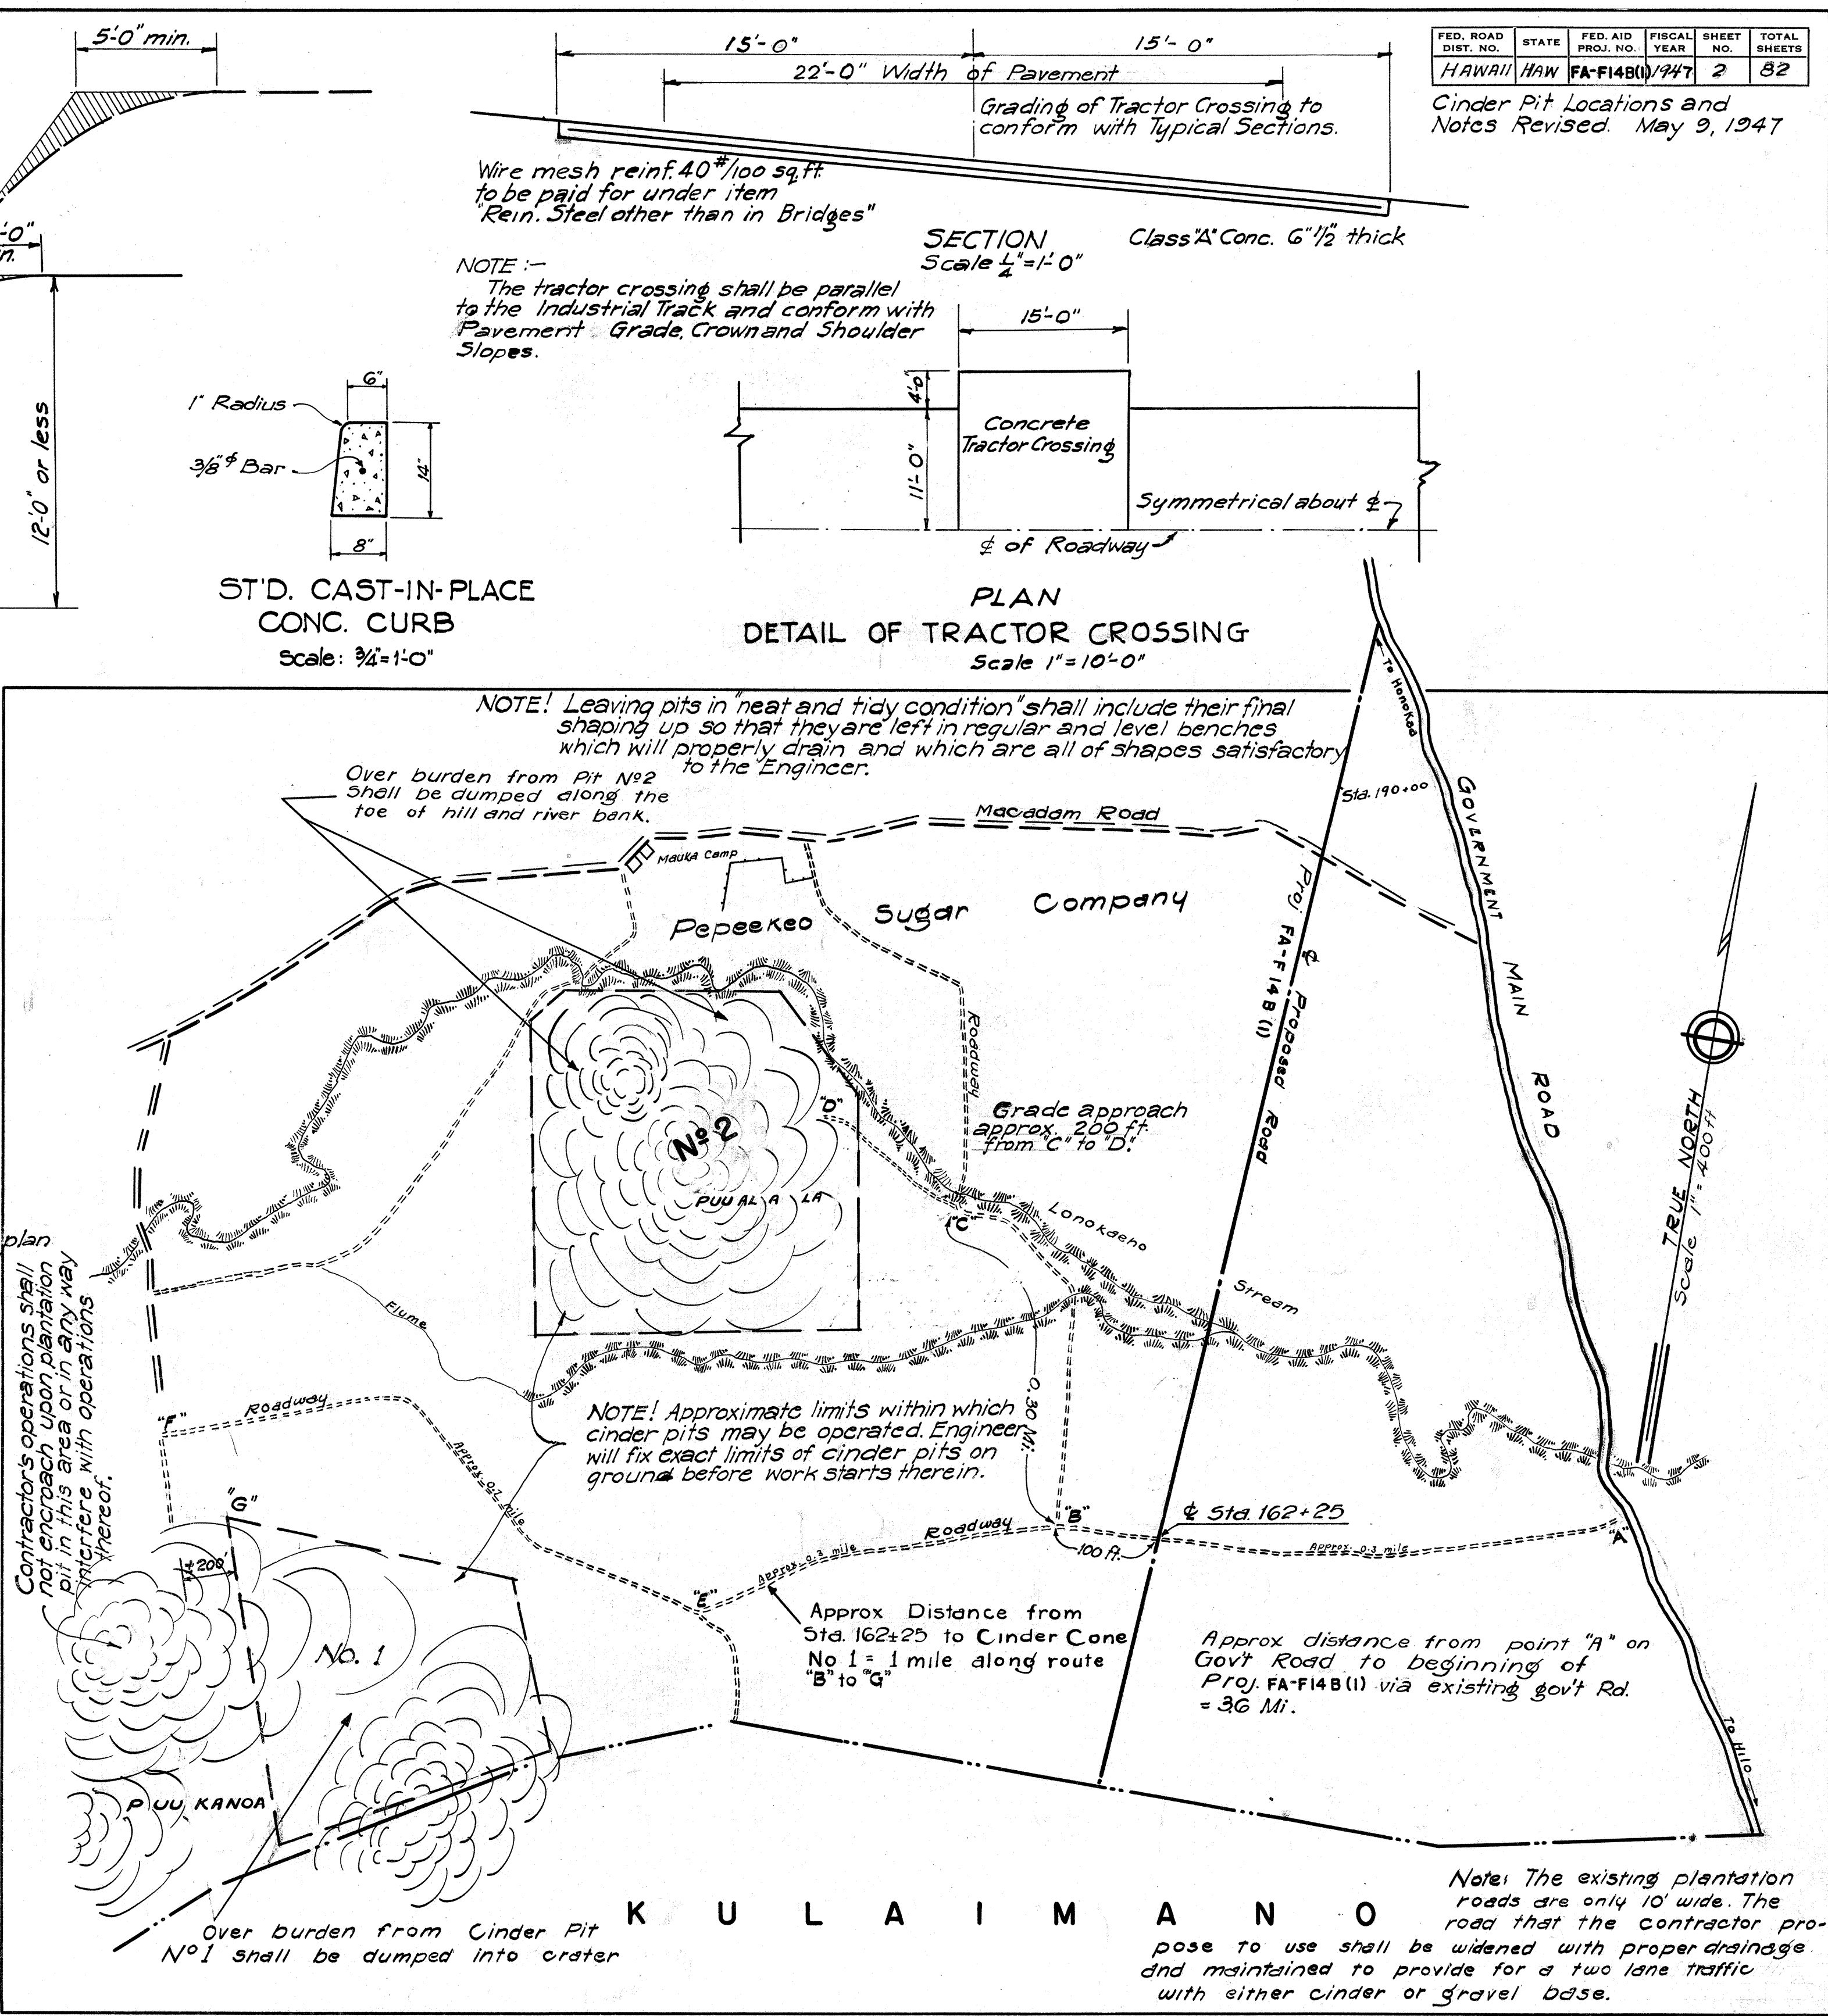
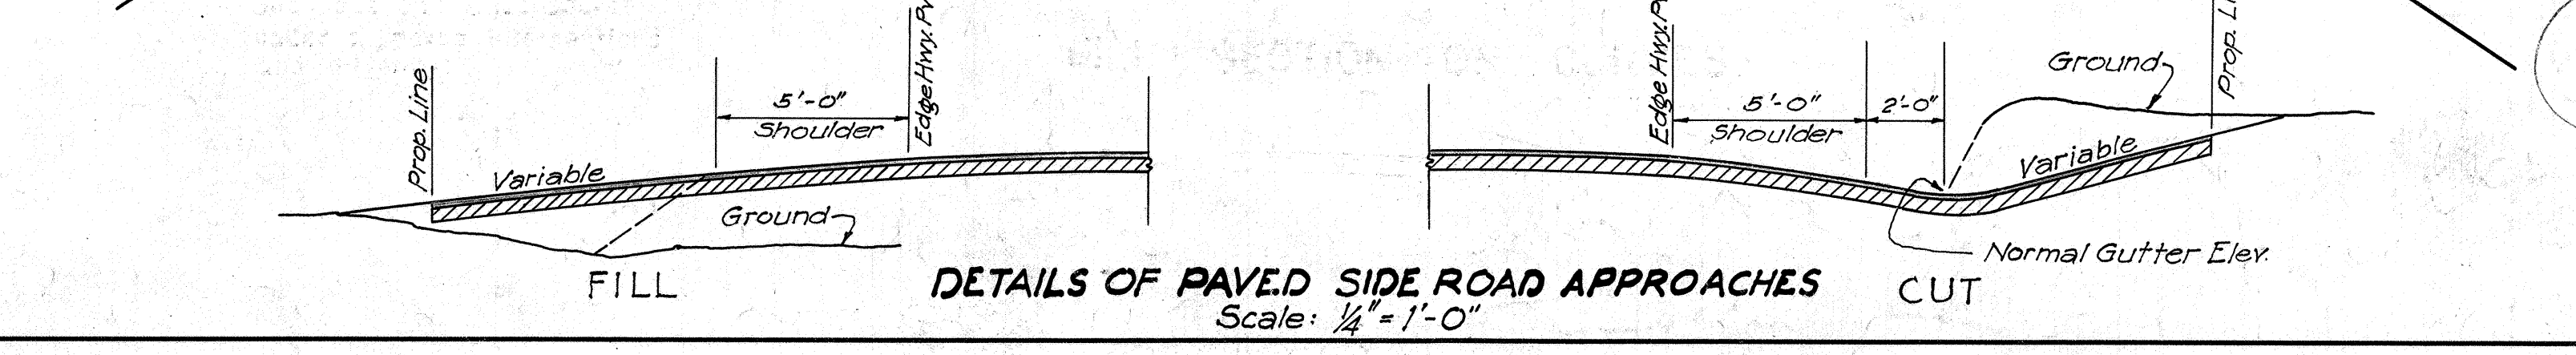
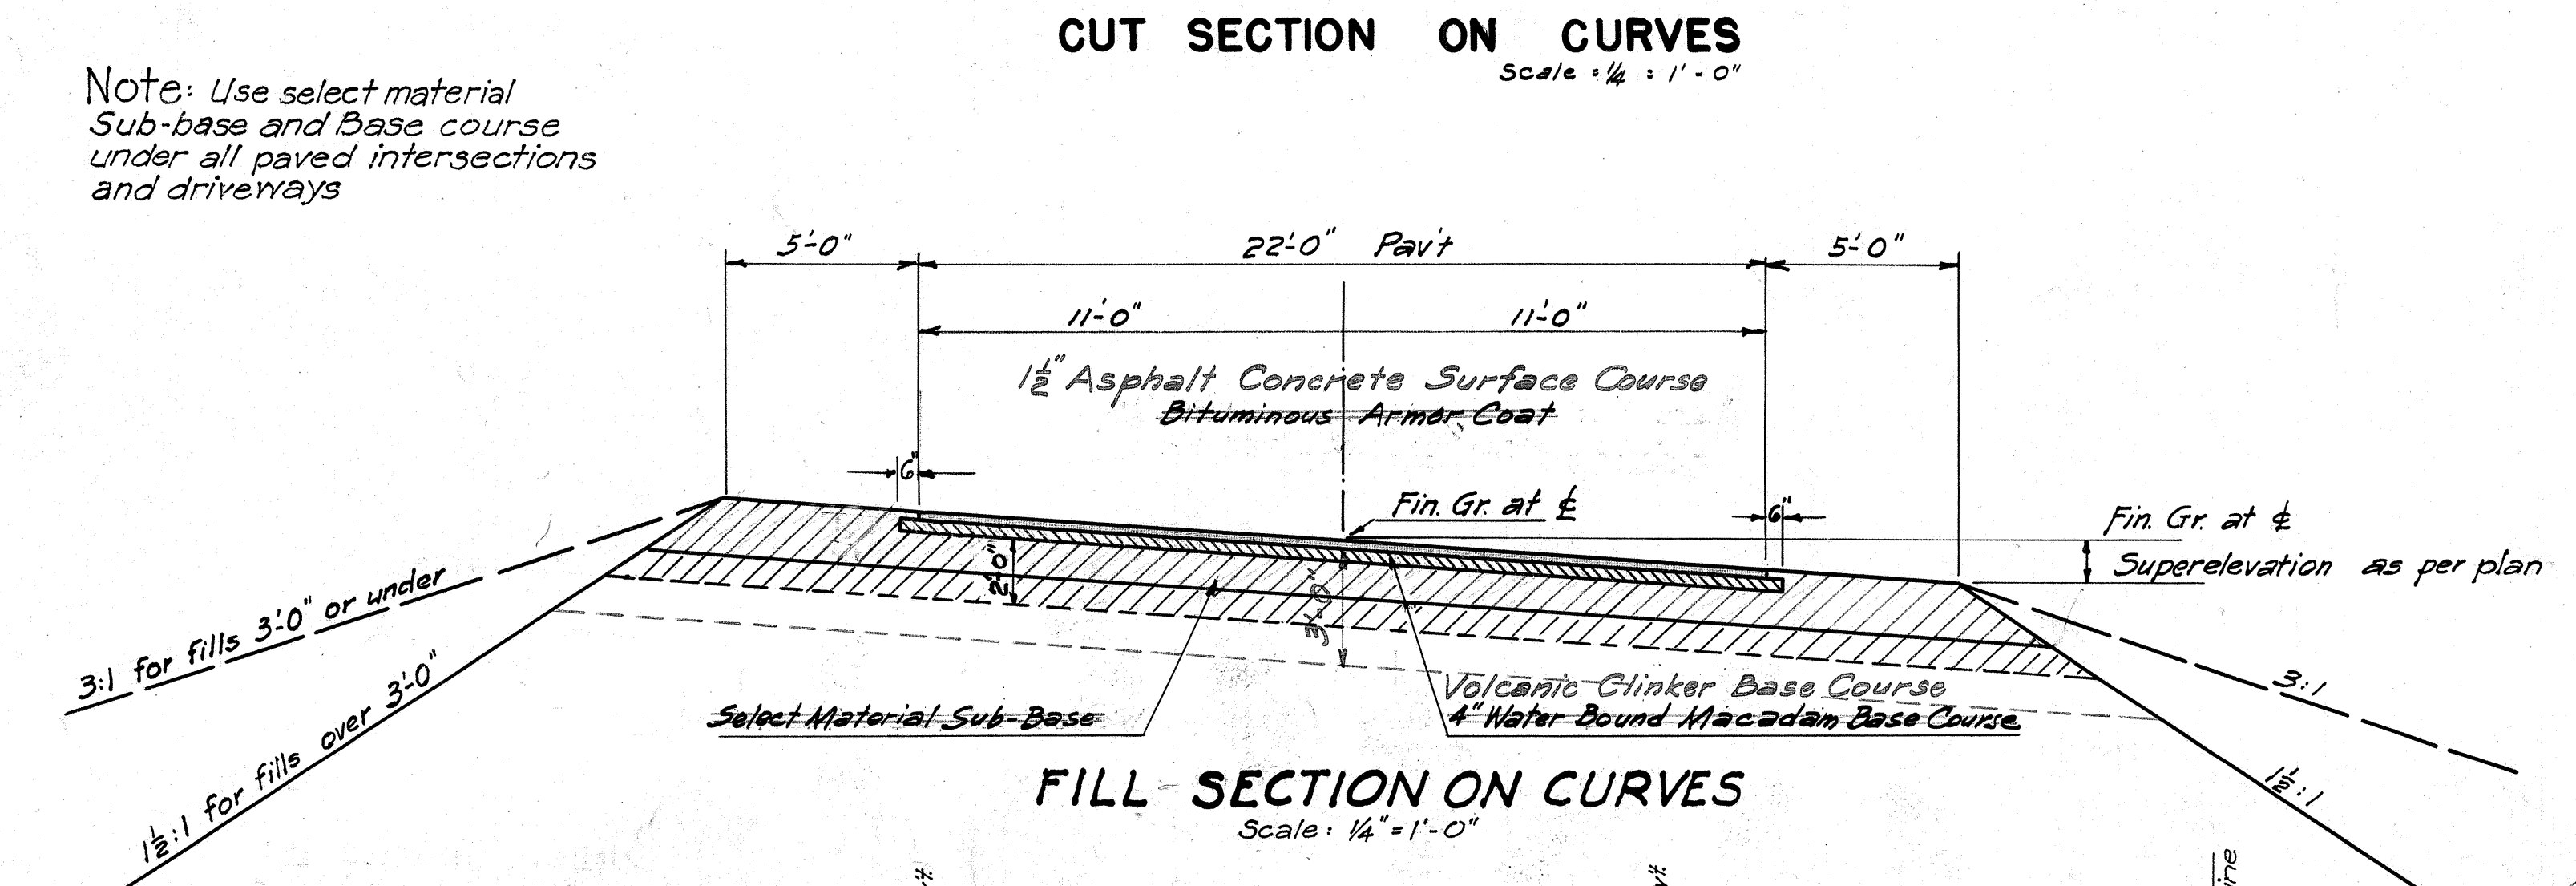
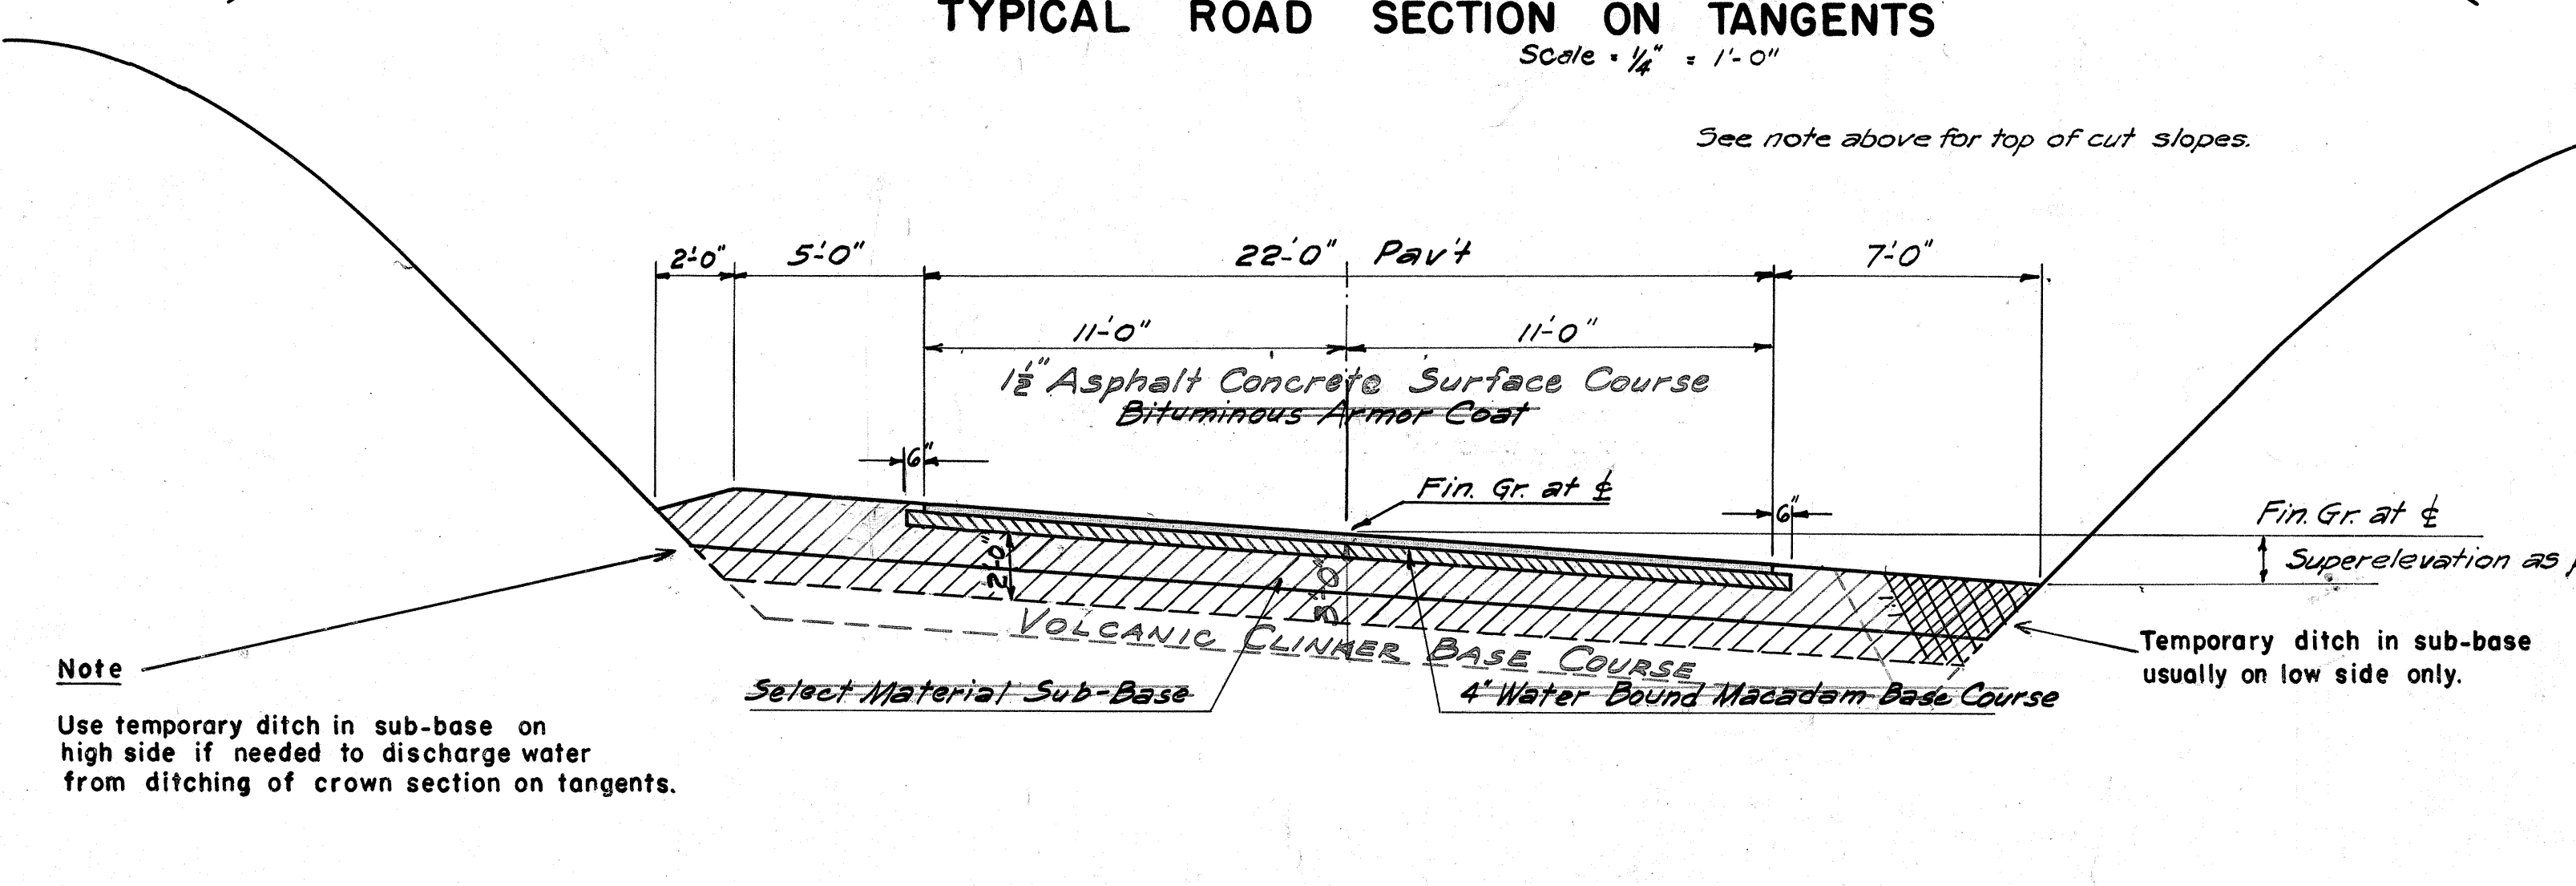


Revised as of Aug. 7, 1946
Revised Feb. 1947
Corrected May 31, 1949

DATE	DESIGNED BY	CHECKED BY
PLAN	TRACED BY	QUANTITIES BY
NOTE BOOK	CHECKED BY	
No.		

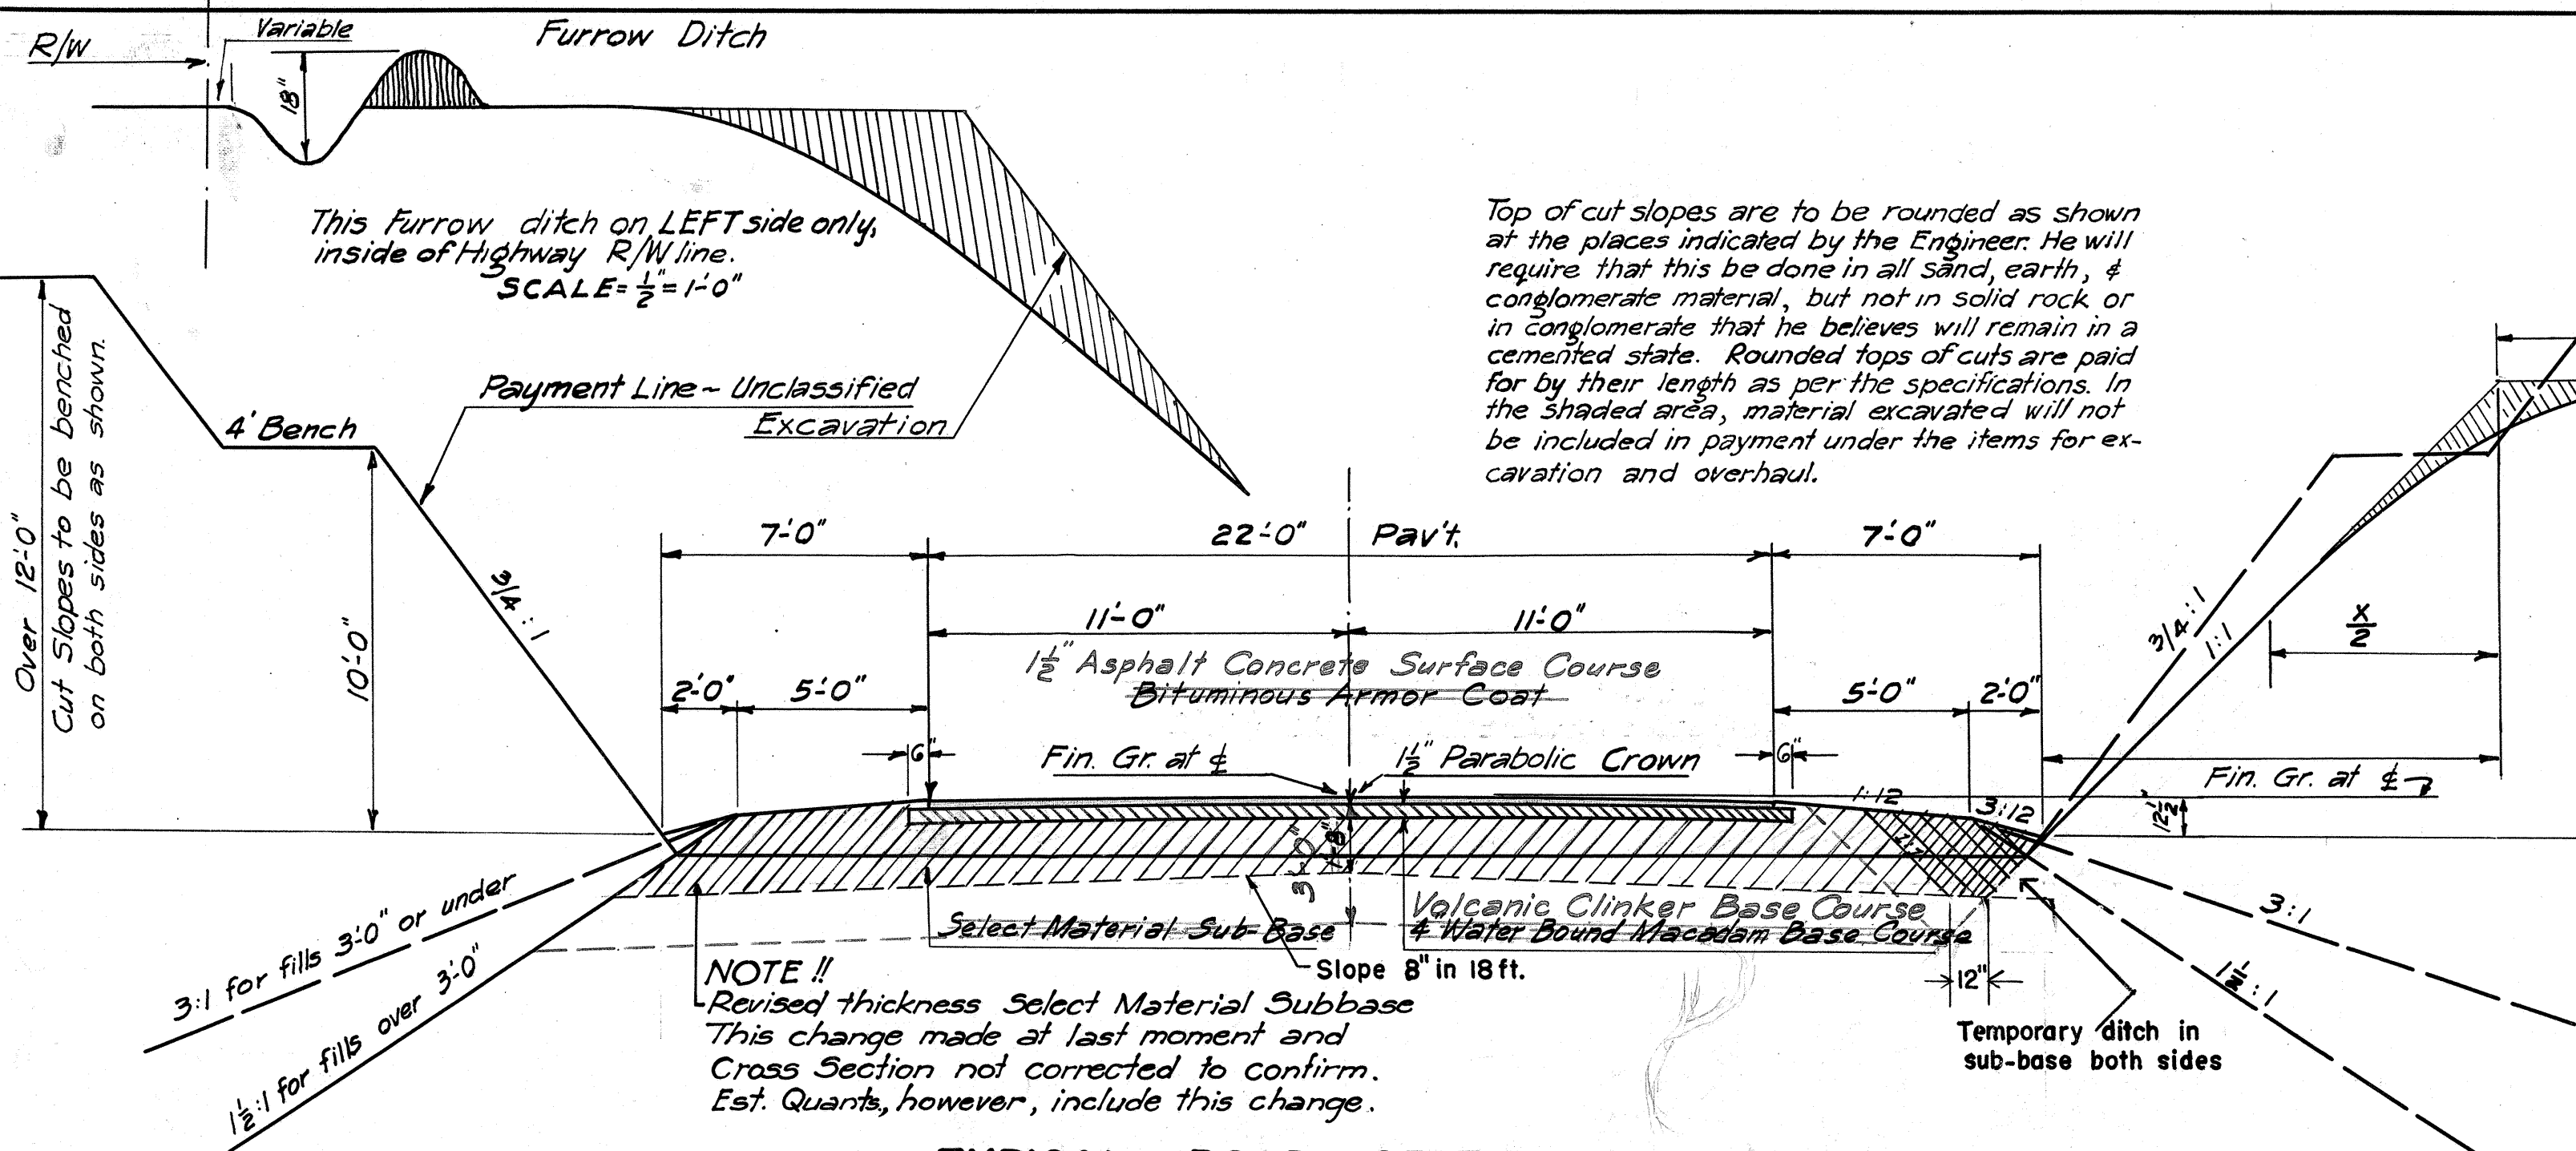

NOTES!!

LOCATIONS OF CINDER PITS

BASE COURSE: 4" Water Bound Macadam Base Course - 36" Volcanic Clinker Base Course

PAVEMENT: Bituminous Armor Coat shall consist of 0.20 to 0.25 gal/sq.yd. Liquid Asphalt Primer, 0.20 gal/sq.yd. Bituminous Binder 0.03 cu.yd/sq.yd. Screenings Size No. 50 (1/2"); 0.30 gal/sq.yd. Bituminous Binder; 0.005 cu.yd/sq.yd. fine keystone. Size No. 7 (1/2 - 3/8"); 0.20 gal/sq.yd. Bituminous Binder; 0.006 cu.yd/sq.yd. Chips Size No. 8 (3/8 - No. 4); 0.20 gal/sq.yd. Bituminous Binder; 0.004 cu.yd/sq.yd. Rock Sand Size No. 9 (No. 4 to No. 8) all in accordance with the applicable Specifications and/or special provisions. Size shown above thus (1" to 1/2") are nominal, gradings given in Specifications shall apply. Bituminous Binder is hot asphalt, 85-100 penetration all as specified.

1 1/2" Asphalt Concrete Surface Course


GENERAL NOTES: Particular reference is made to the specifications and special provisions covering these items of work.

TERRITORIAL HIGHWAY DEPARTMENT
TERRITORY OF HAWAII
TYPICAL ROAD SECTIONS
AND
LOCATIONS OF CINDER PITS

SHEET No. 1 OF 2 SHEETS

FED. ROAD DIST. NO.	STATE	FED. AID PROJ. NO.	FISCAL YEAR	SHEET NO.	TOTAL SHEETS
HAWAII	HAW	FA-F148(1)	1947	2	82


Cinder Pit Locations and Notes Revised May 9, 1947

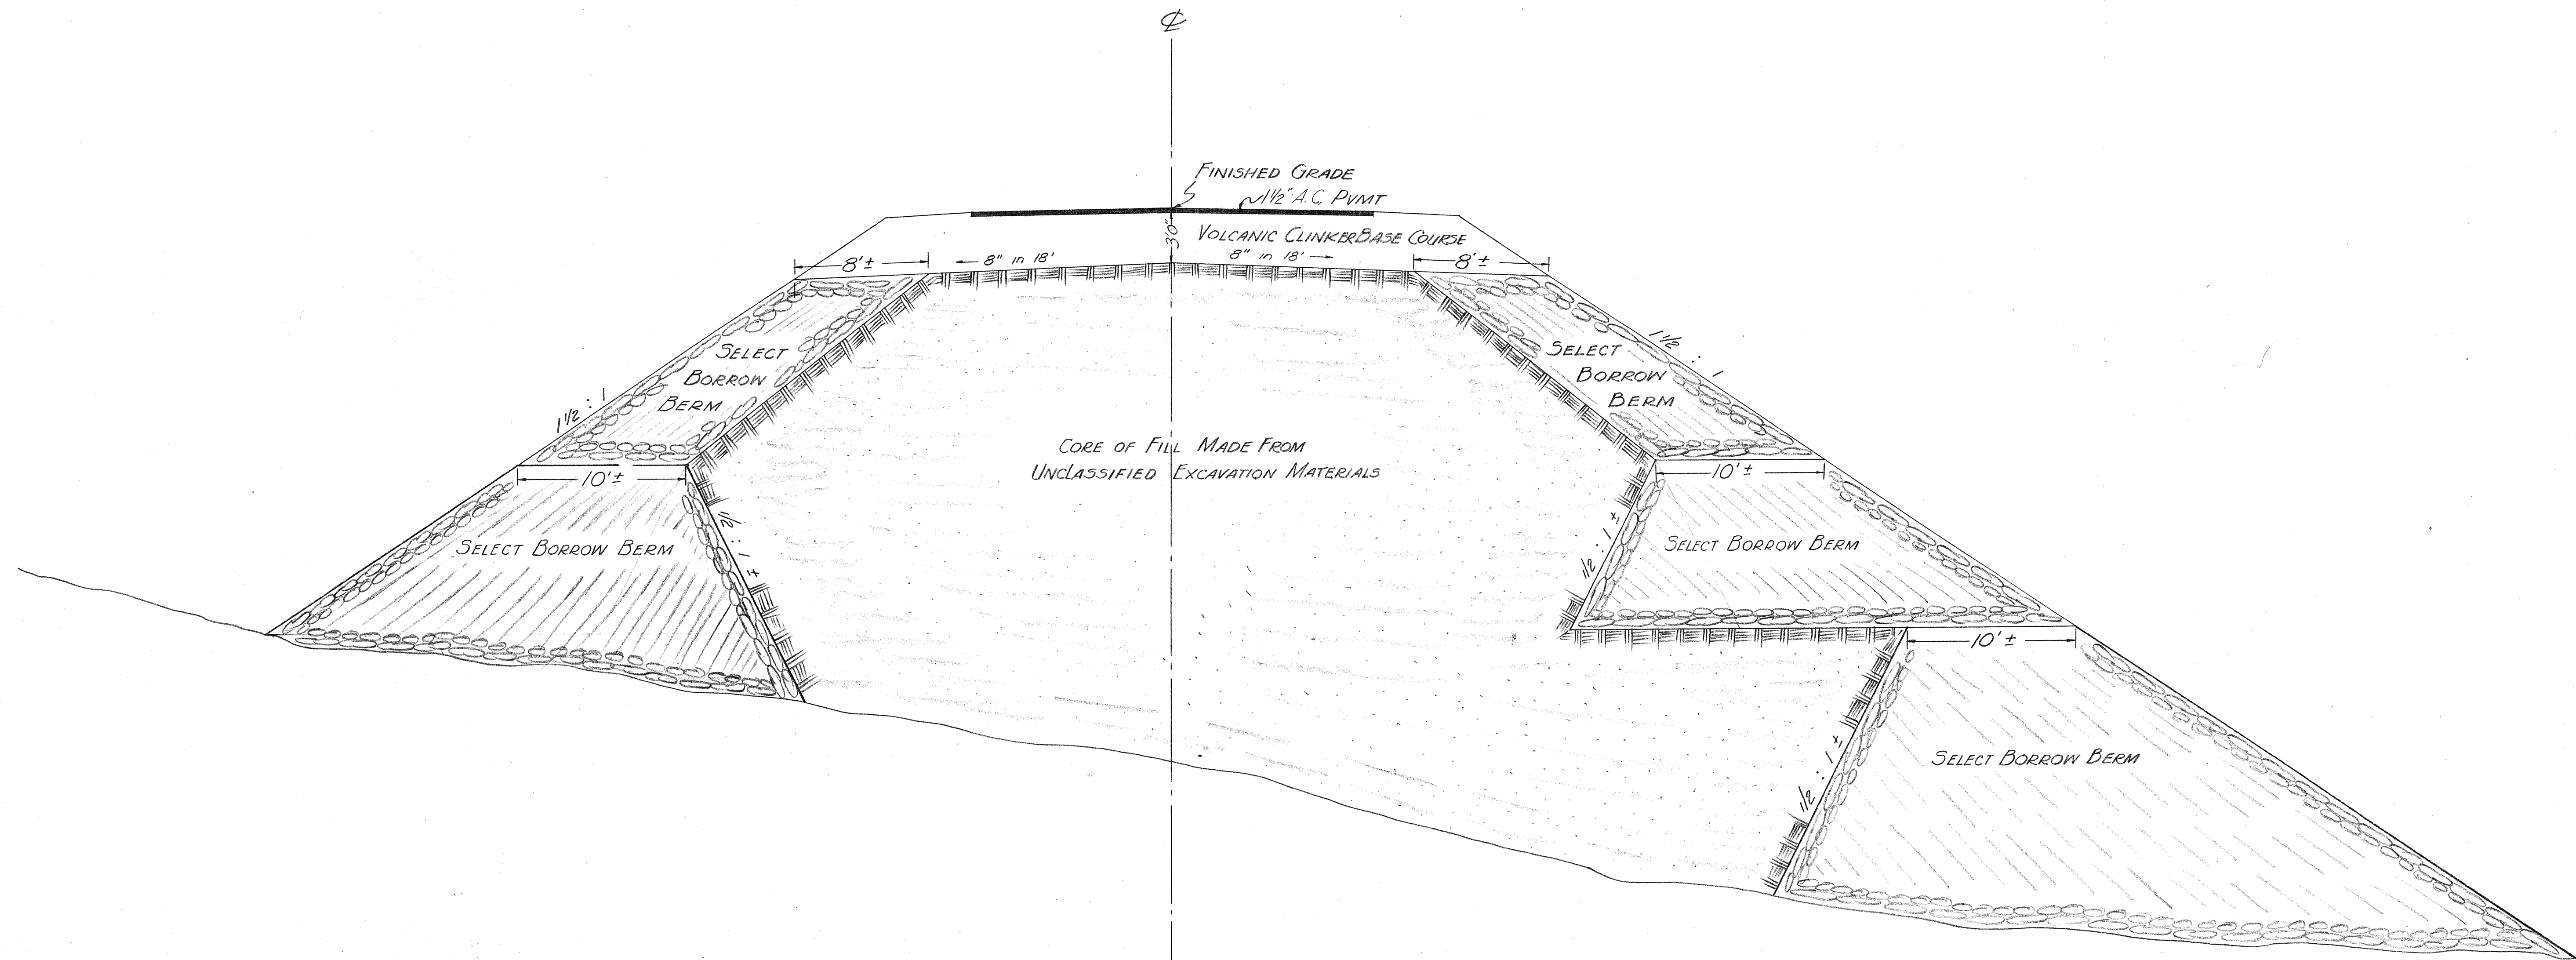

ORIGINAL PLAN	DATE
DESIGNED BY	
DRAWN BY	
CHECKED BY	
NOTED BY	
QUANTITIES BY	
QUANTITIES CHECKED BY	
CHIEF ENGINEER	


TERRITORIAL HIGHWAY DEPARTMENT
TERRITORY OF HAWAII

TYPICAL SECTION
FILLS WITH SELECT BORROW BERM
HAWAII BELT ROAD - PROJ. FAF 14-B(1)
Scale 1"=5' Date April 1949

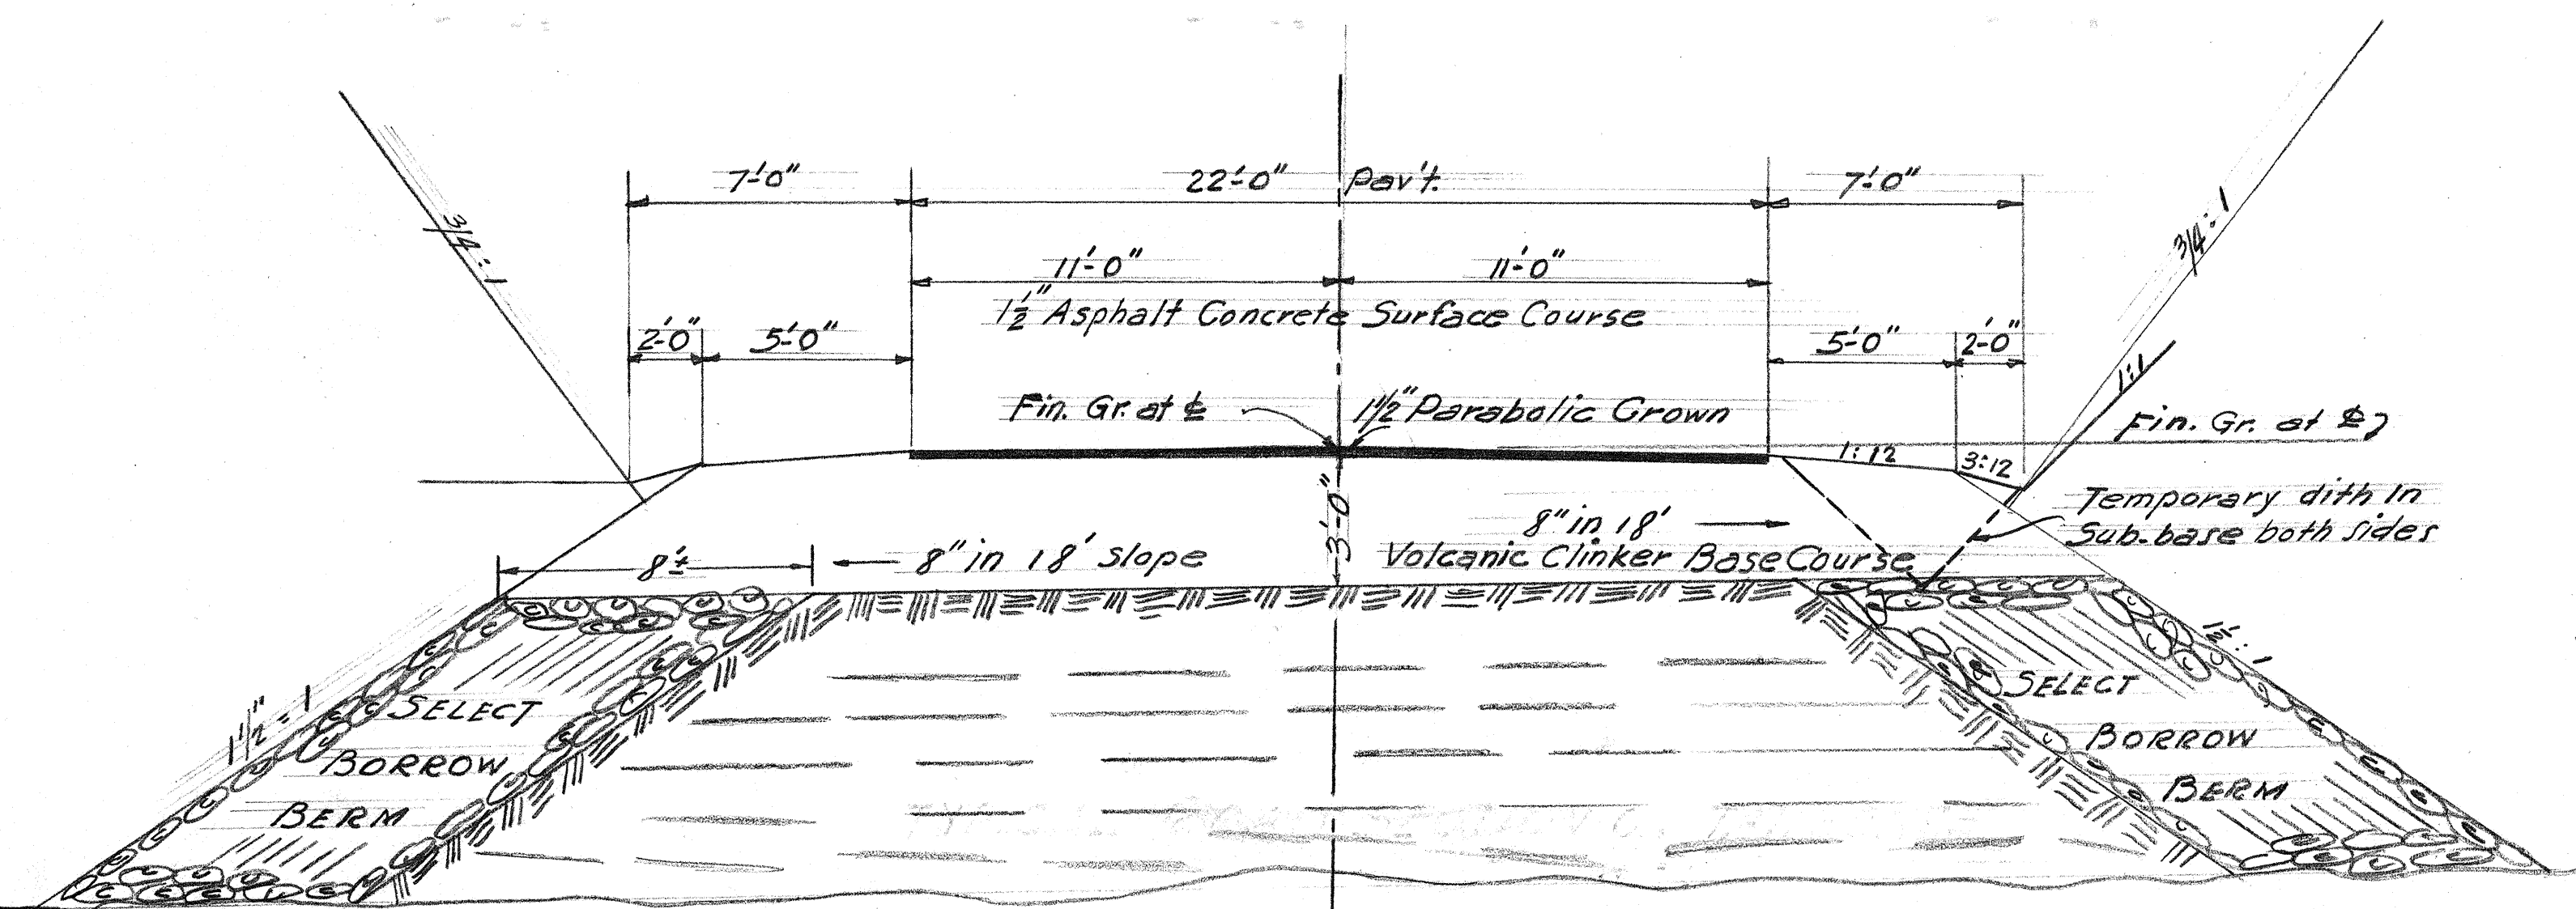


TYPICAL ROAD SECTION ON TANGENTS

Scale 1/4" = 1'-0"

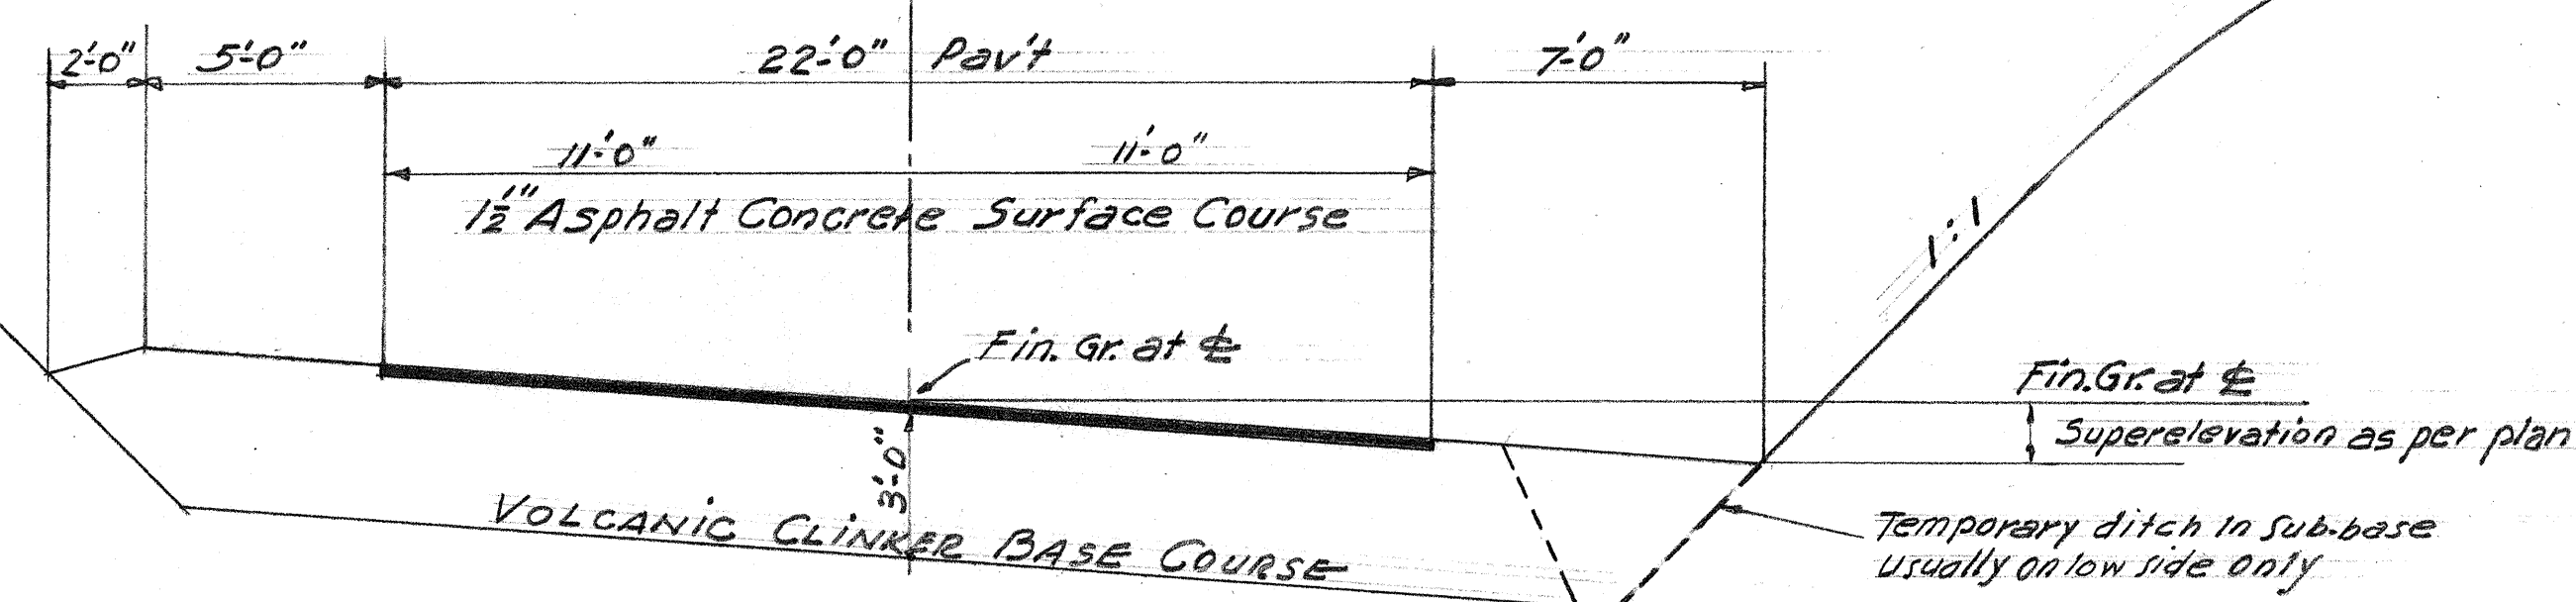

CUT SECTION ON CURVES

Scale 1/4" = 1'-0"

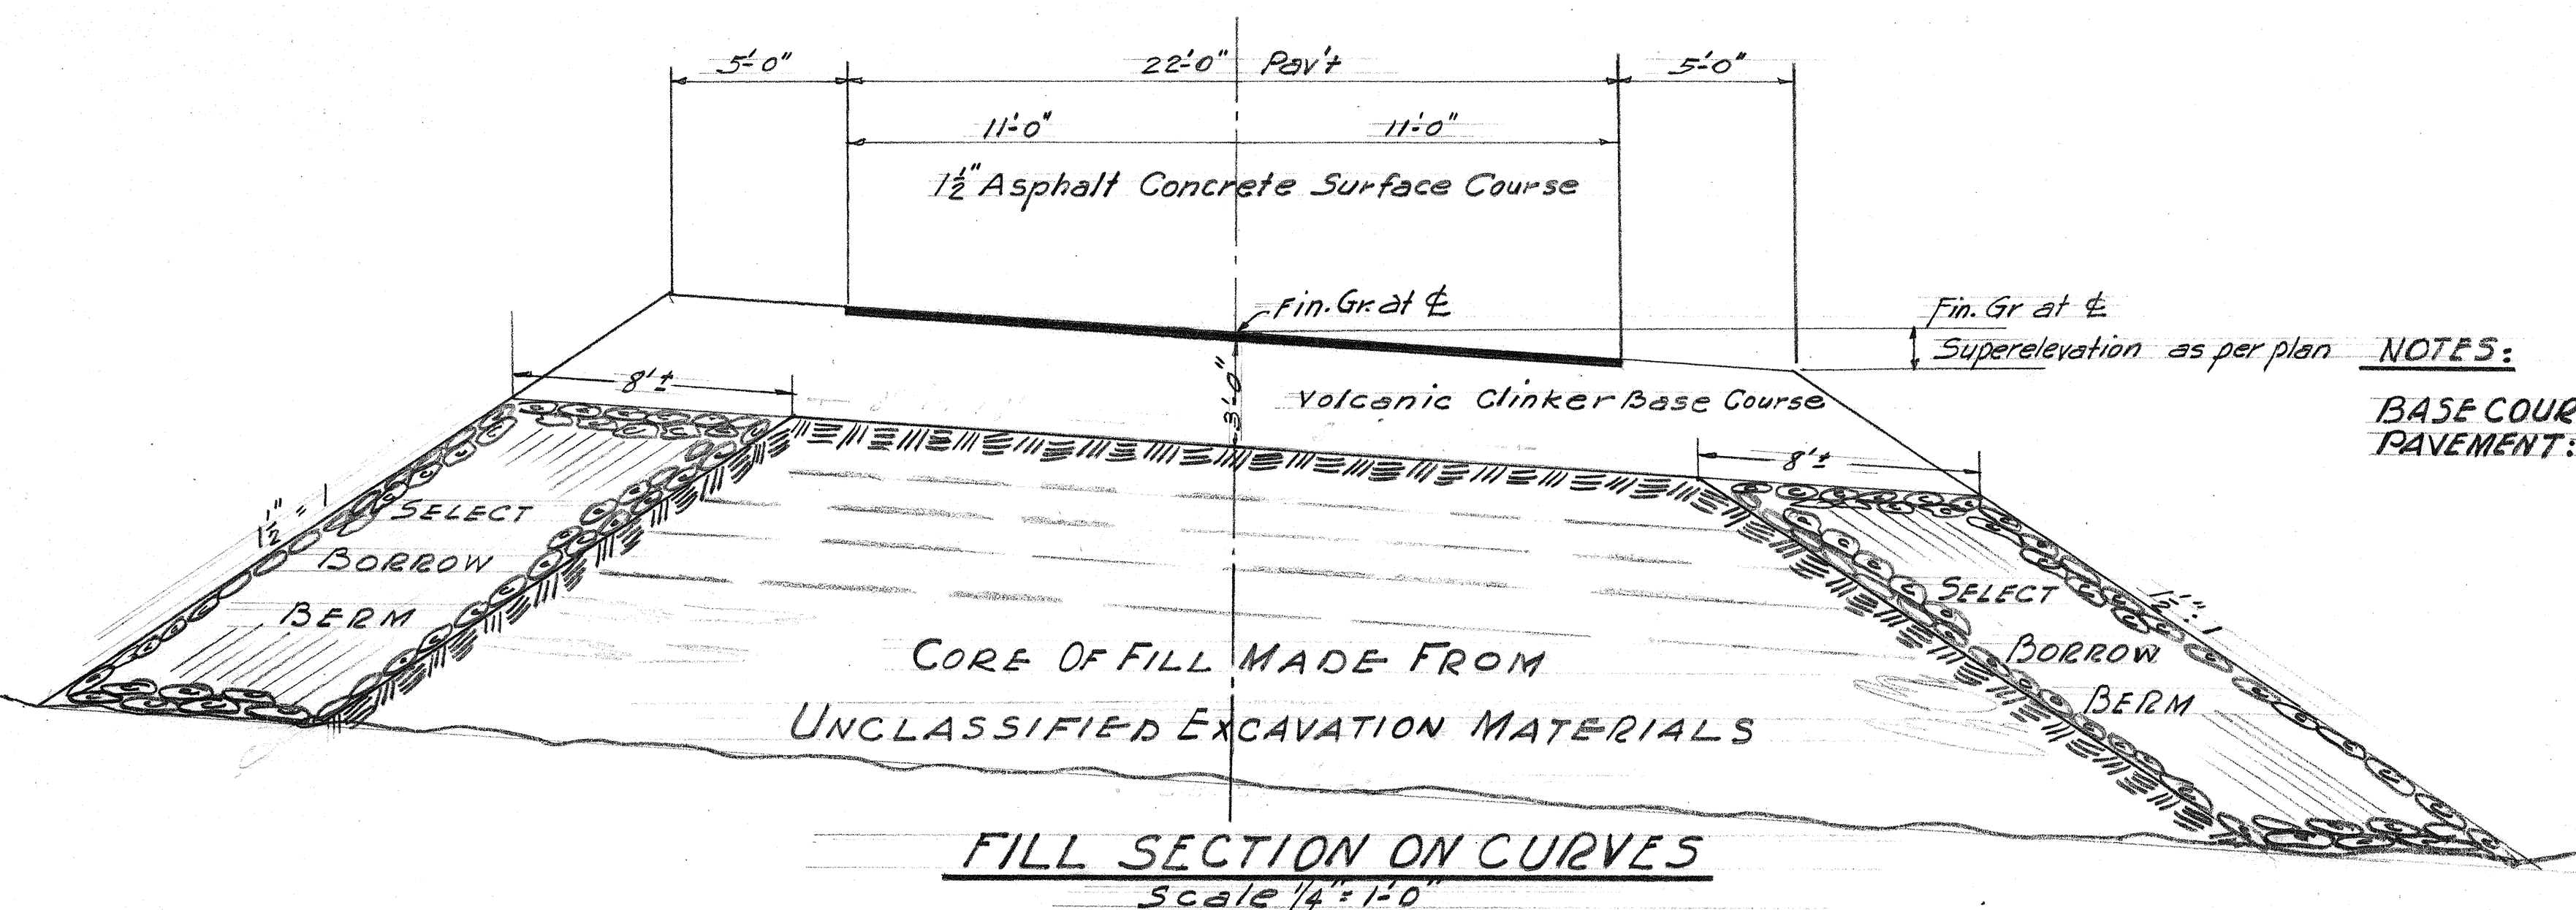

FILL SECTION ON CURVES

Scale 1/4" = 1'-0"

NOTES:

BASE COURSE: 36" Volcanic Clinker Base Course
PAVEMENT: 1/2" Asphalt Concrete Surface Course

GENERAL NOTES: Particular reference is made to the specifications and special provisions covering these items of work.

TERRITORIAL HIGHWAY DEPARTMENT
TERRITORY OF HAWAII

TYPICAL SECTIONS

FILLS WITH SELECT BORROW BERM

HAWAII BELT ROAD PROJ. FAF 14-B(1)

Scale 1/4" = 1'-0" Date June 1949

SHEET No. OF SHEETS

5194.2C

SURVEY PLOTTED BY: DATE: 6/10/49
DESIGNED BY: A. P. P.
DRAWN BY: A. P. P.
QUANTITIES CHECKED BY: A. P. P.
NOTE BOOK NO.: