



FED. ROAD DIST. NO.	STATE	FED. AID PROJ. NO.	FISCAL YEAR	CONTRACT NO.	TOTAL SHEETS
HAWAII	HAWAII	SDR3(3)D48	6	7	

FINAL SURVEY	BY	DATE
SURVEYED		
PLOTTED		
NOTE BOOK		
AREAS CHECKED		
NO.		


ORIGINAL SURVEY	BY	DATE
SURVEYED		
PLOTTED		
NOTE BOOK		
AREAS CHECKED		
NO.		

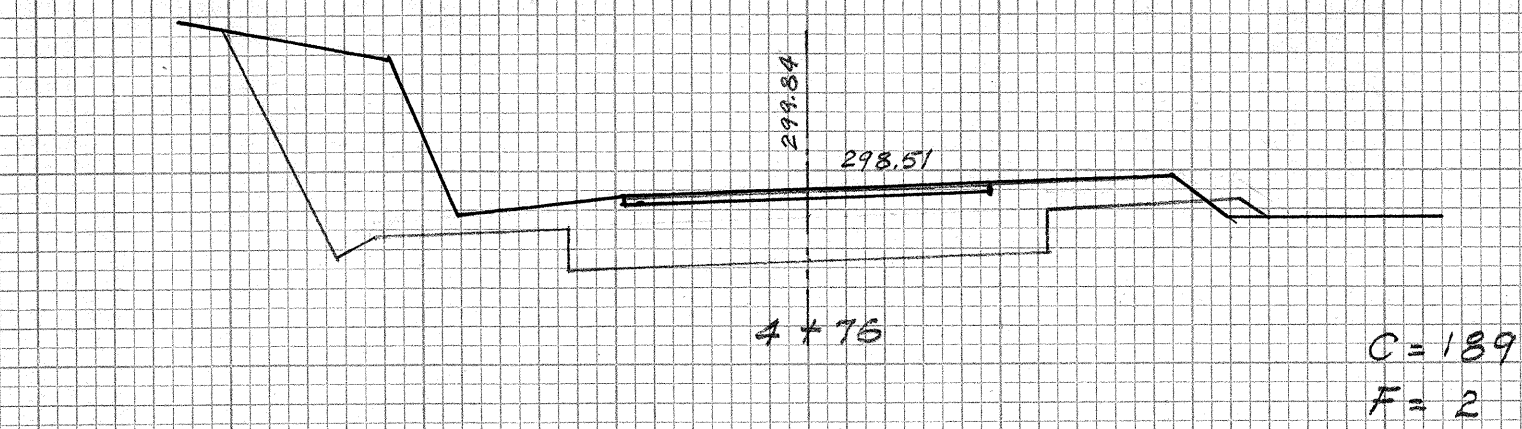


Exc = 328.7
Emb = 7.3

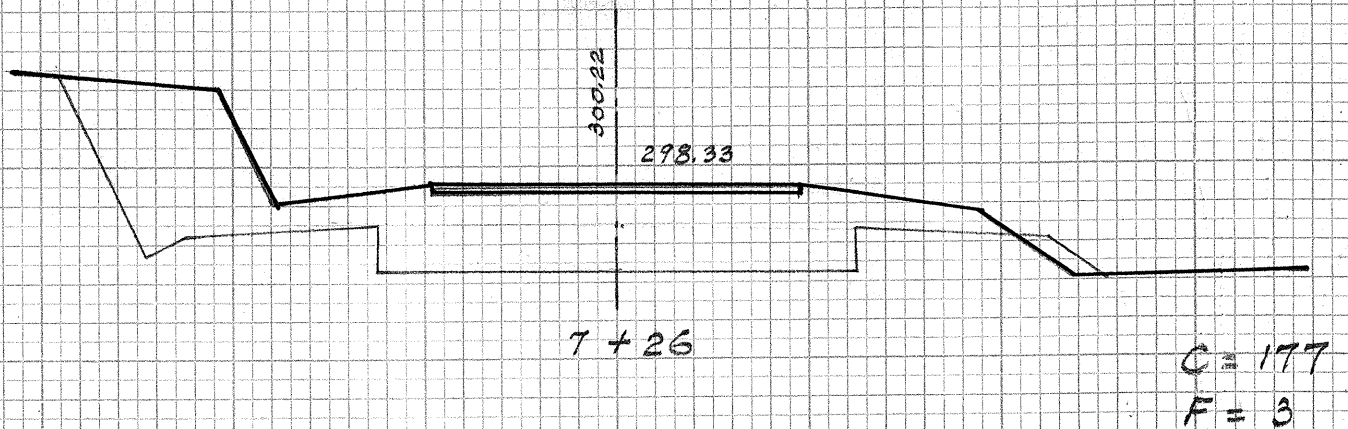


Exc = 389.8
Emb = 3.6

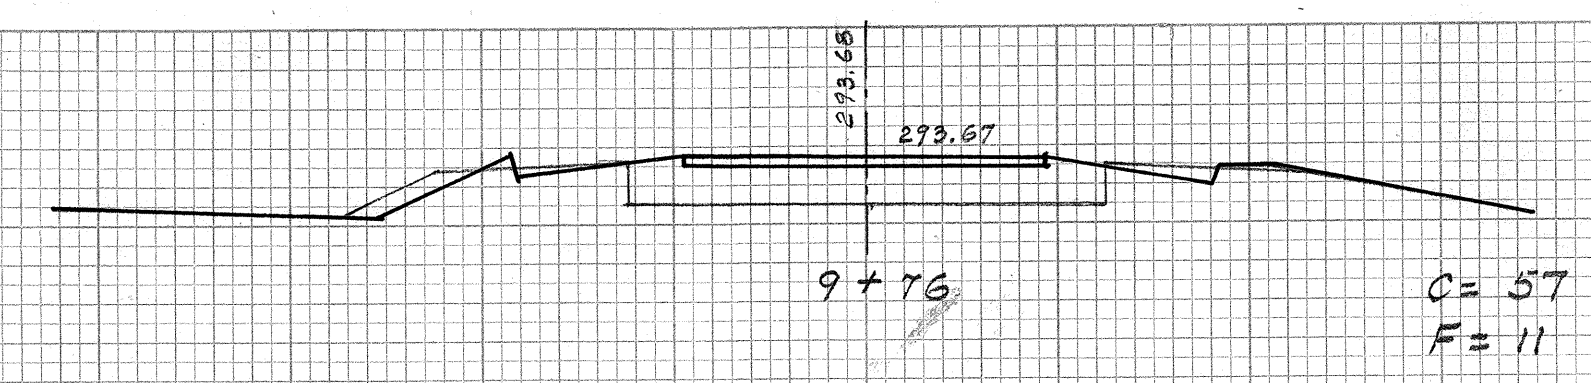


Exc = 107.4
Emb = 61.4

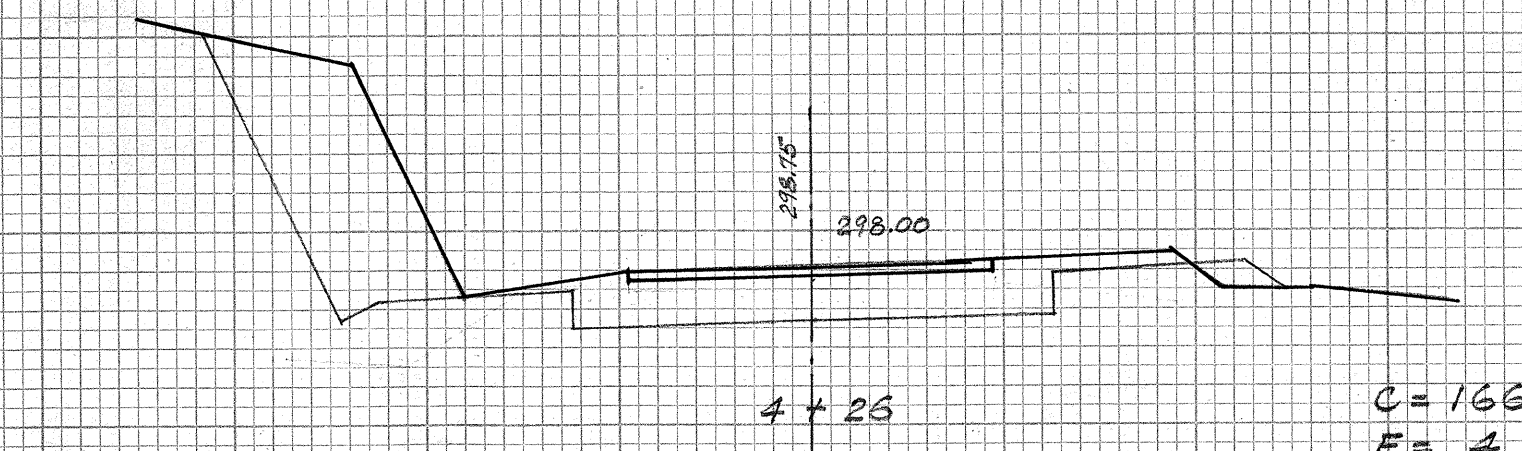


Exc = 259.3
Emb = 8.5

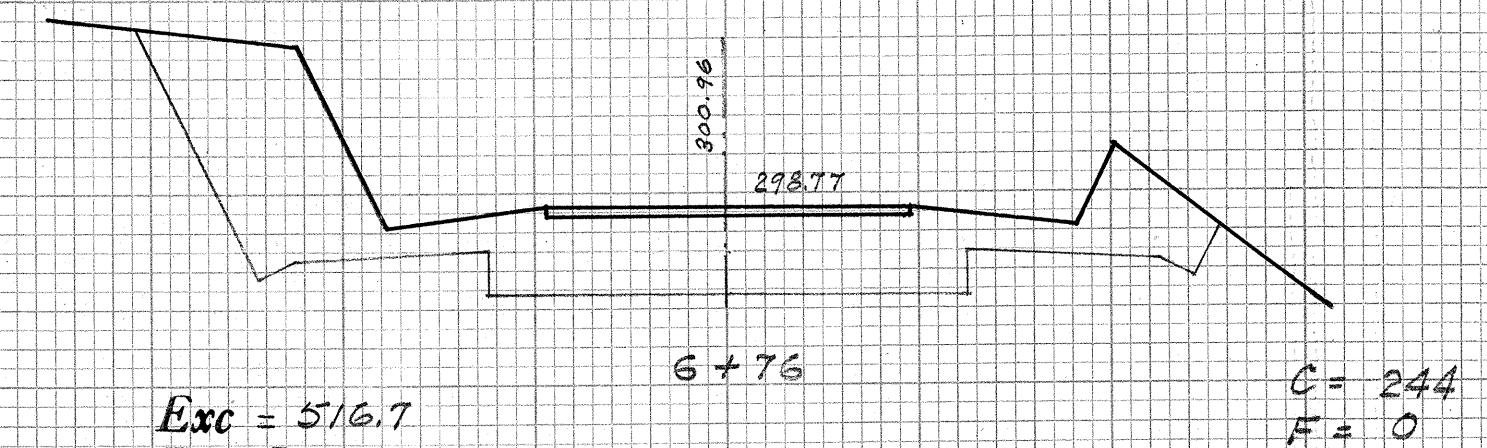


Exc = 516.7
Emb = 0

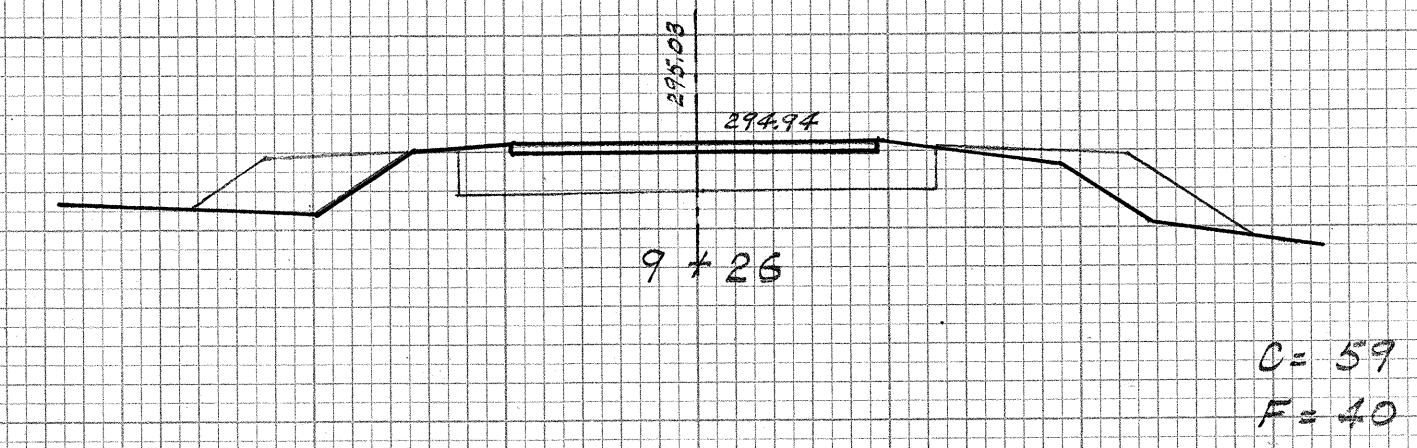


Exc = 107.4
Emb = 139.6

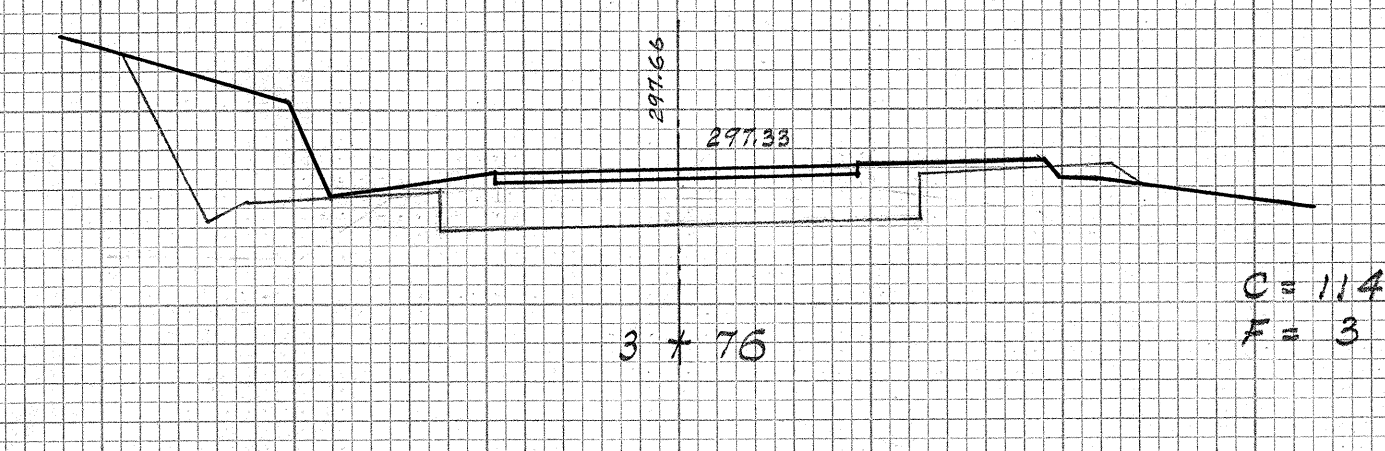


Exc = 194.4
Emb = 6.0

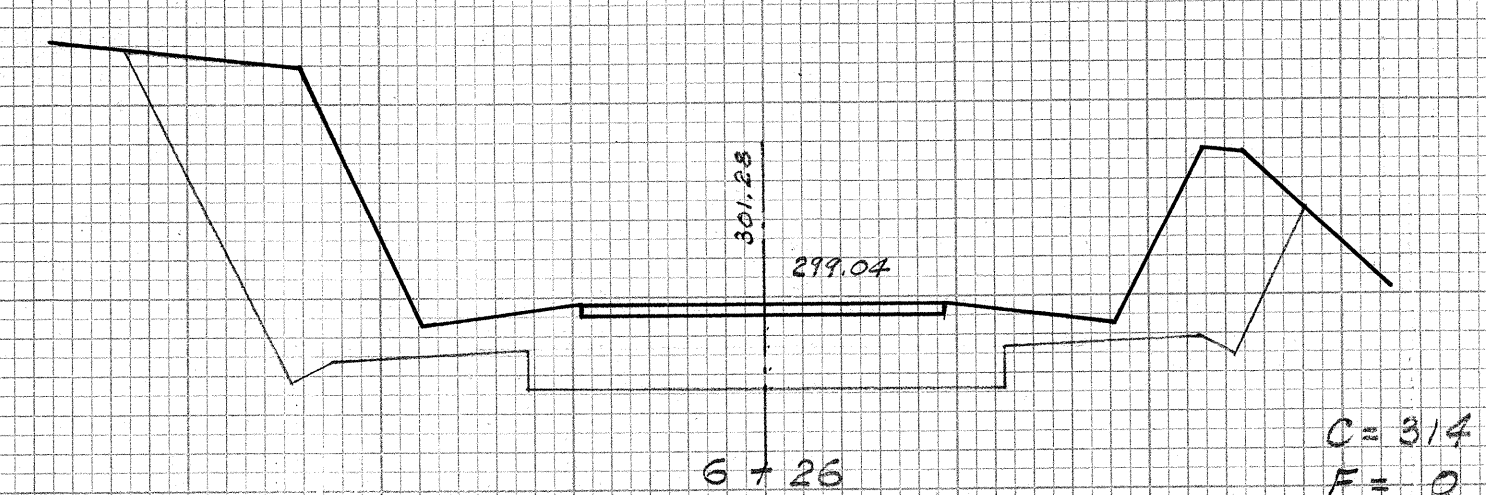


Exc = 509.2
Emb = 0

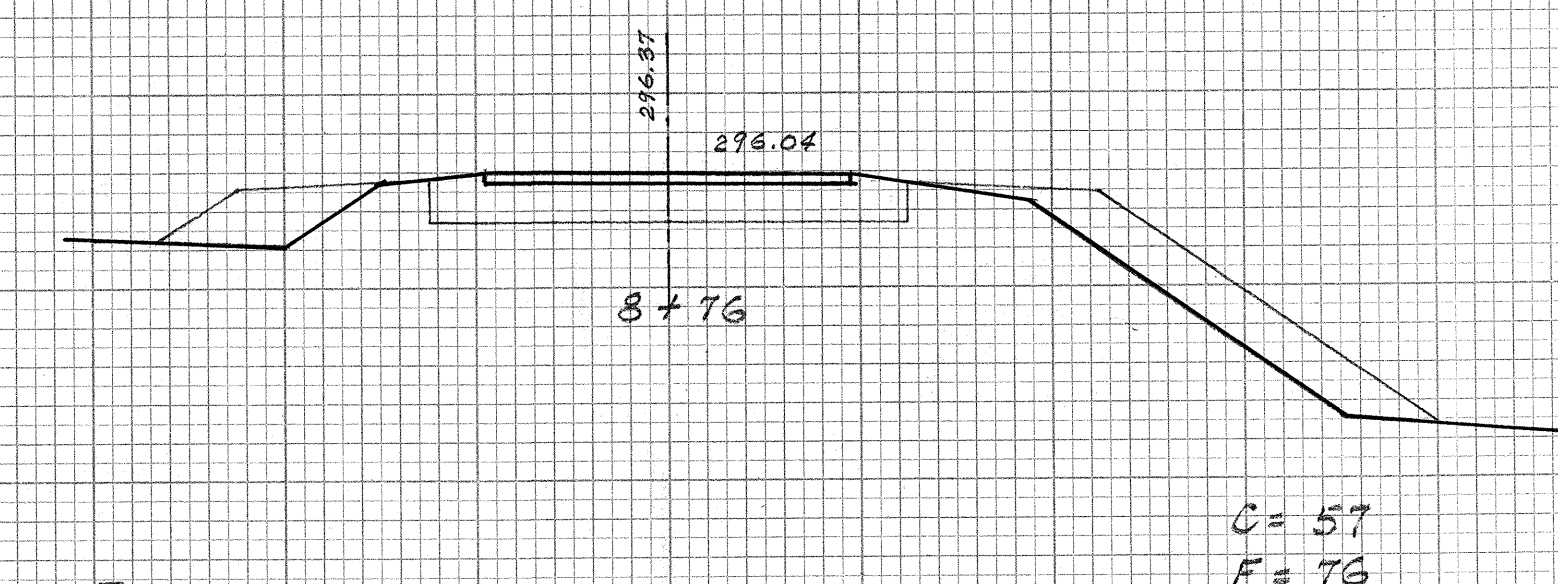


Exc = 127.8
Emb = 143.3

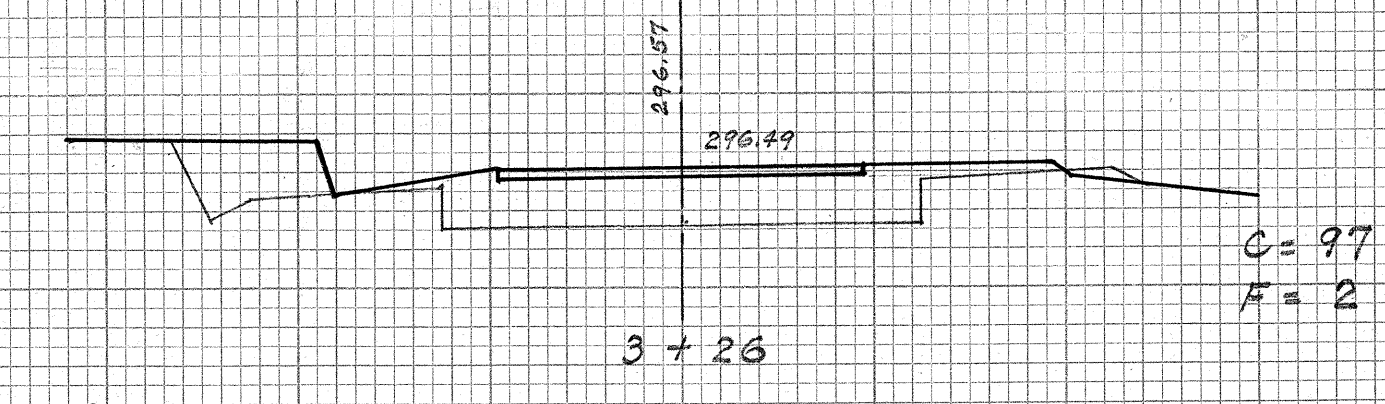



Exc = 190.7
Emb = 2.5

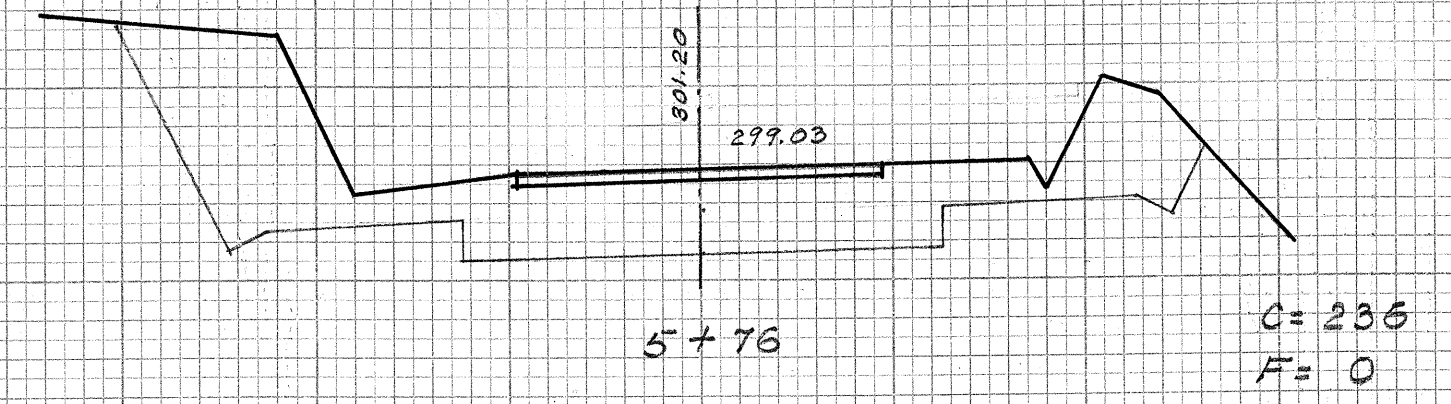


Exc = 343.5
Emb = 1.2

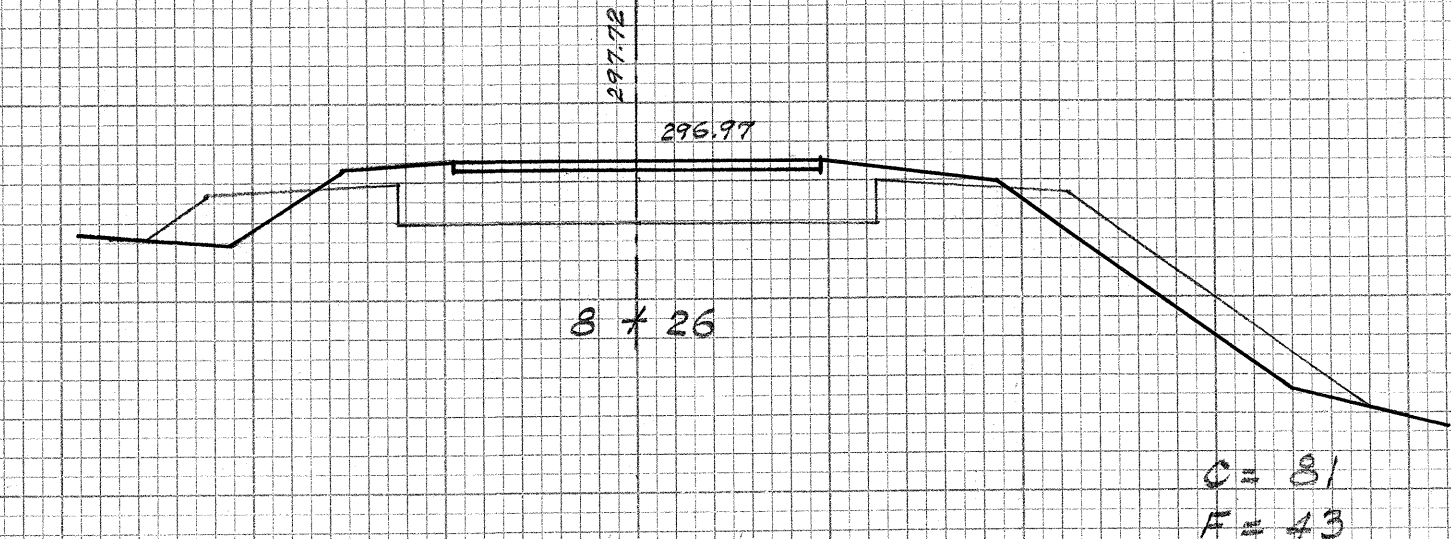

Exc = 190.7
Emb = 56.6

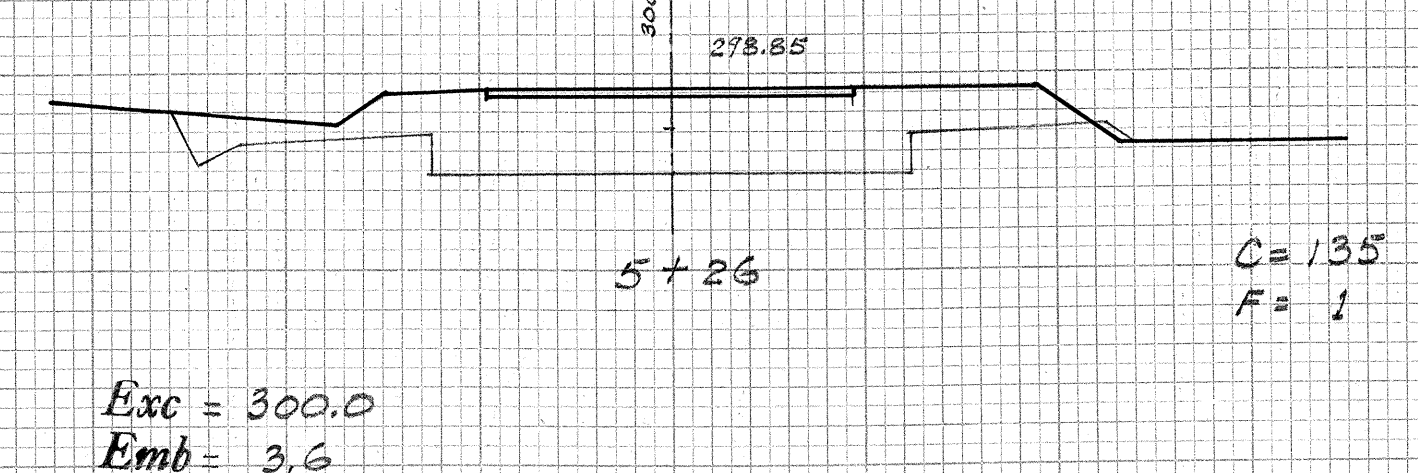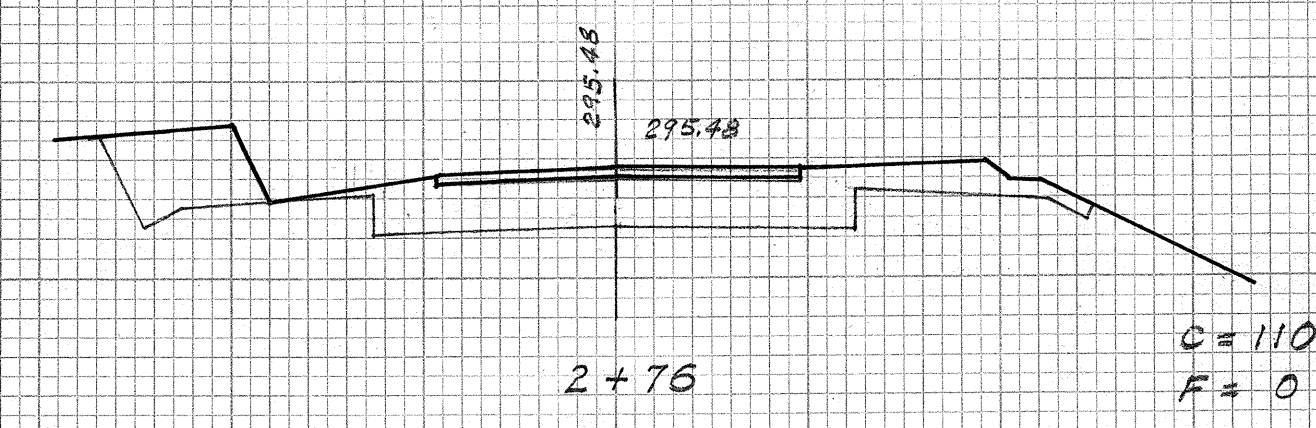

Exc = 300.0
Emb = 3.6

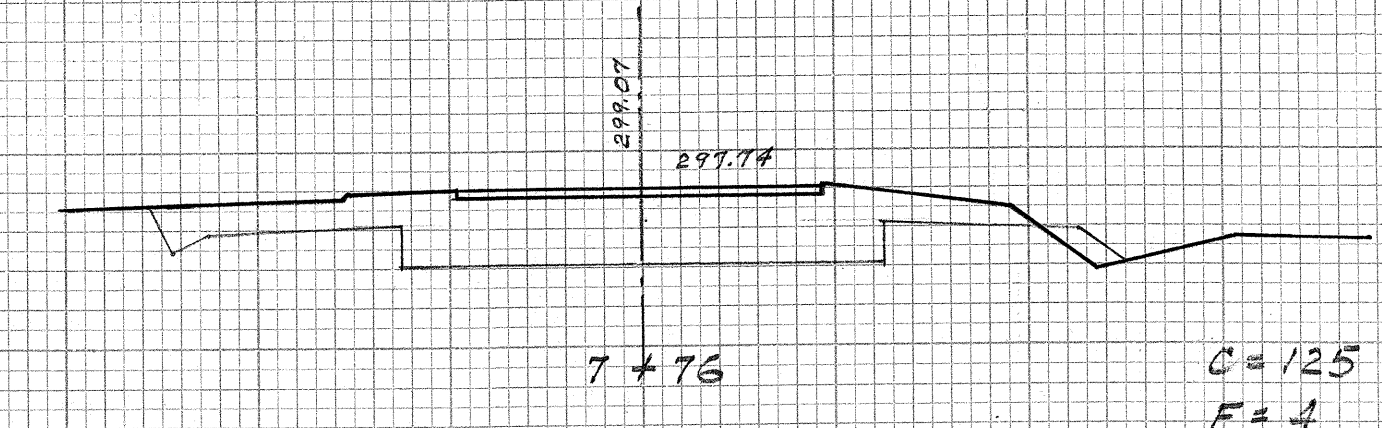

Exc = 279.6
Emb = 2.5

FED. ROAD DIST. NO.	STATE	FED. AID PROJ. NO.	FISCAL YEAR	SHEET NO.	TOTAL SHEETS
HAWAII	HAWAII	SDP3(3)	1968	7	7

DATE	BY	SURVEYED	BLOTTED	AREAS CHECKED
		FINAL	NO.	

DATE	BY	SURVEYED	BLOTTED	AREAS CHECKED
		ORIGINAL	NO.	

