


TYPICAL SECTION ON TANGENT
Scale: $\frac{3}{8}" = 1'-0"$

PROJECT NO. SDR 3(3)
From Sta. 5+95.54 To Sta. 9+76
From Sta. 72+44.44 To Sta. 73+26

PROJECT NO. SDR 3(22)
From Sta. 15+00 To Sta. 22+92.09

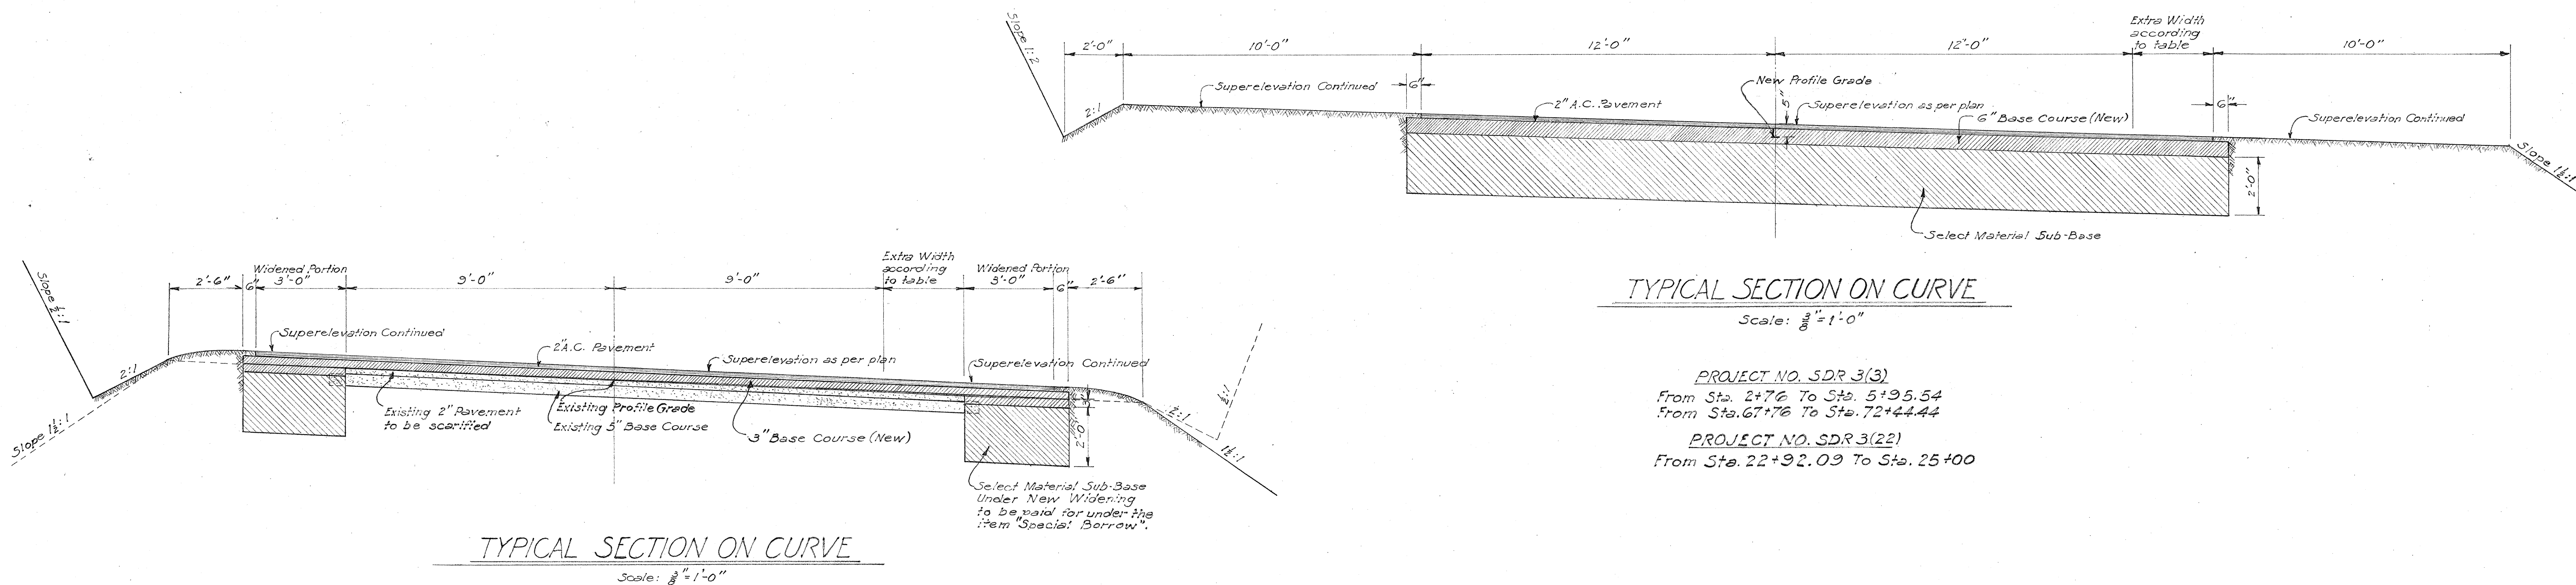

BASE COURSE: Shall be waterbound macadam base course 3" compacted thickness over the existing pavement (18" wide); shall be 6" compacted thickness laid in 2 layers in the new widened portions (3'-6" on each side of existing pavement).

SHEET No. OF SHEETS