


DATE	BY	NO.

FINAL SURVEY	NO.
NO. 1	


DATE	BY	NO.

ORIGINAL SURVEY	NO.
NO. 1	

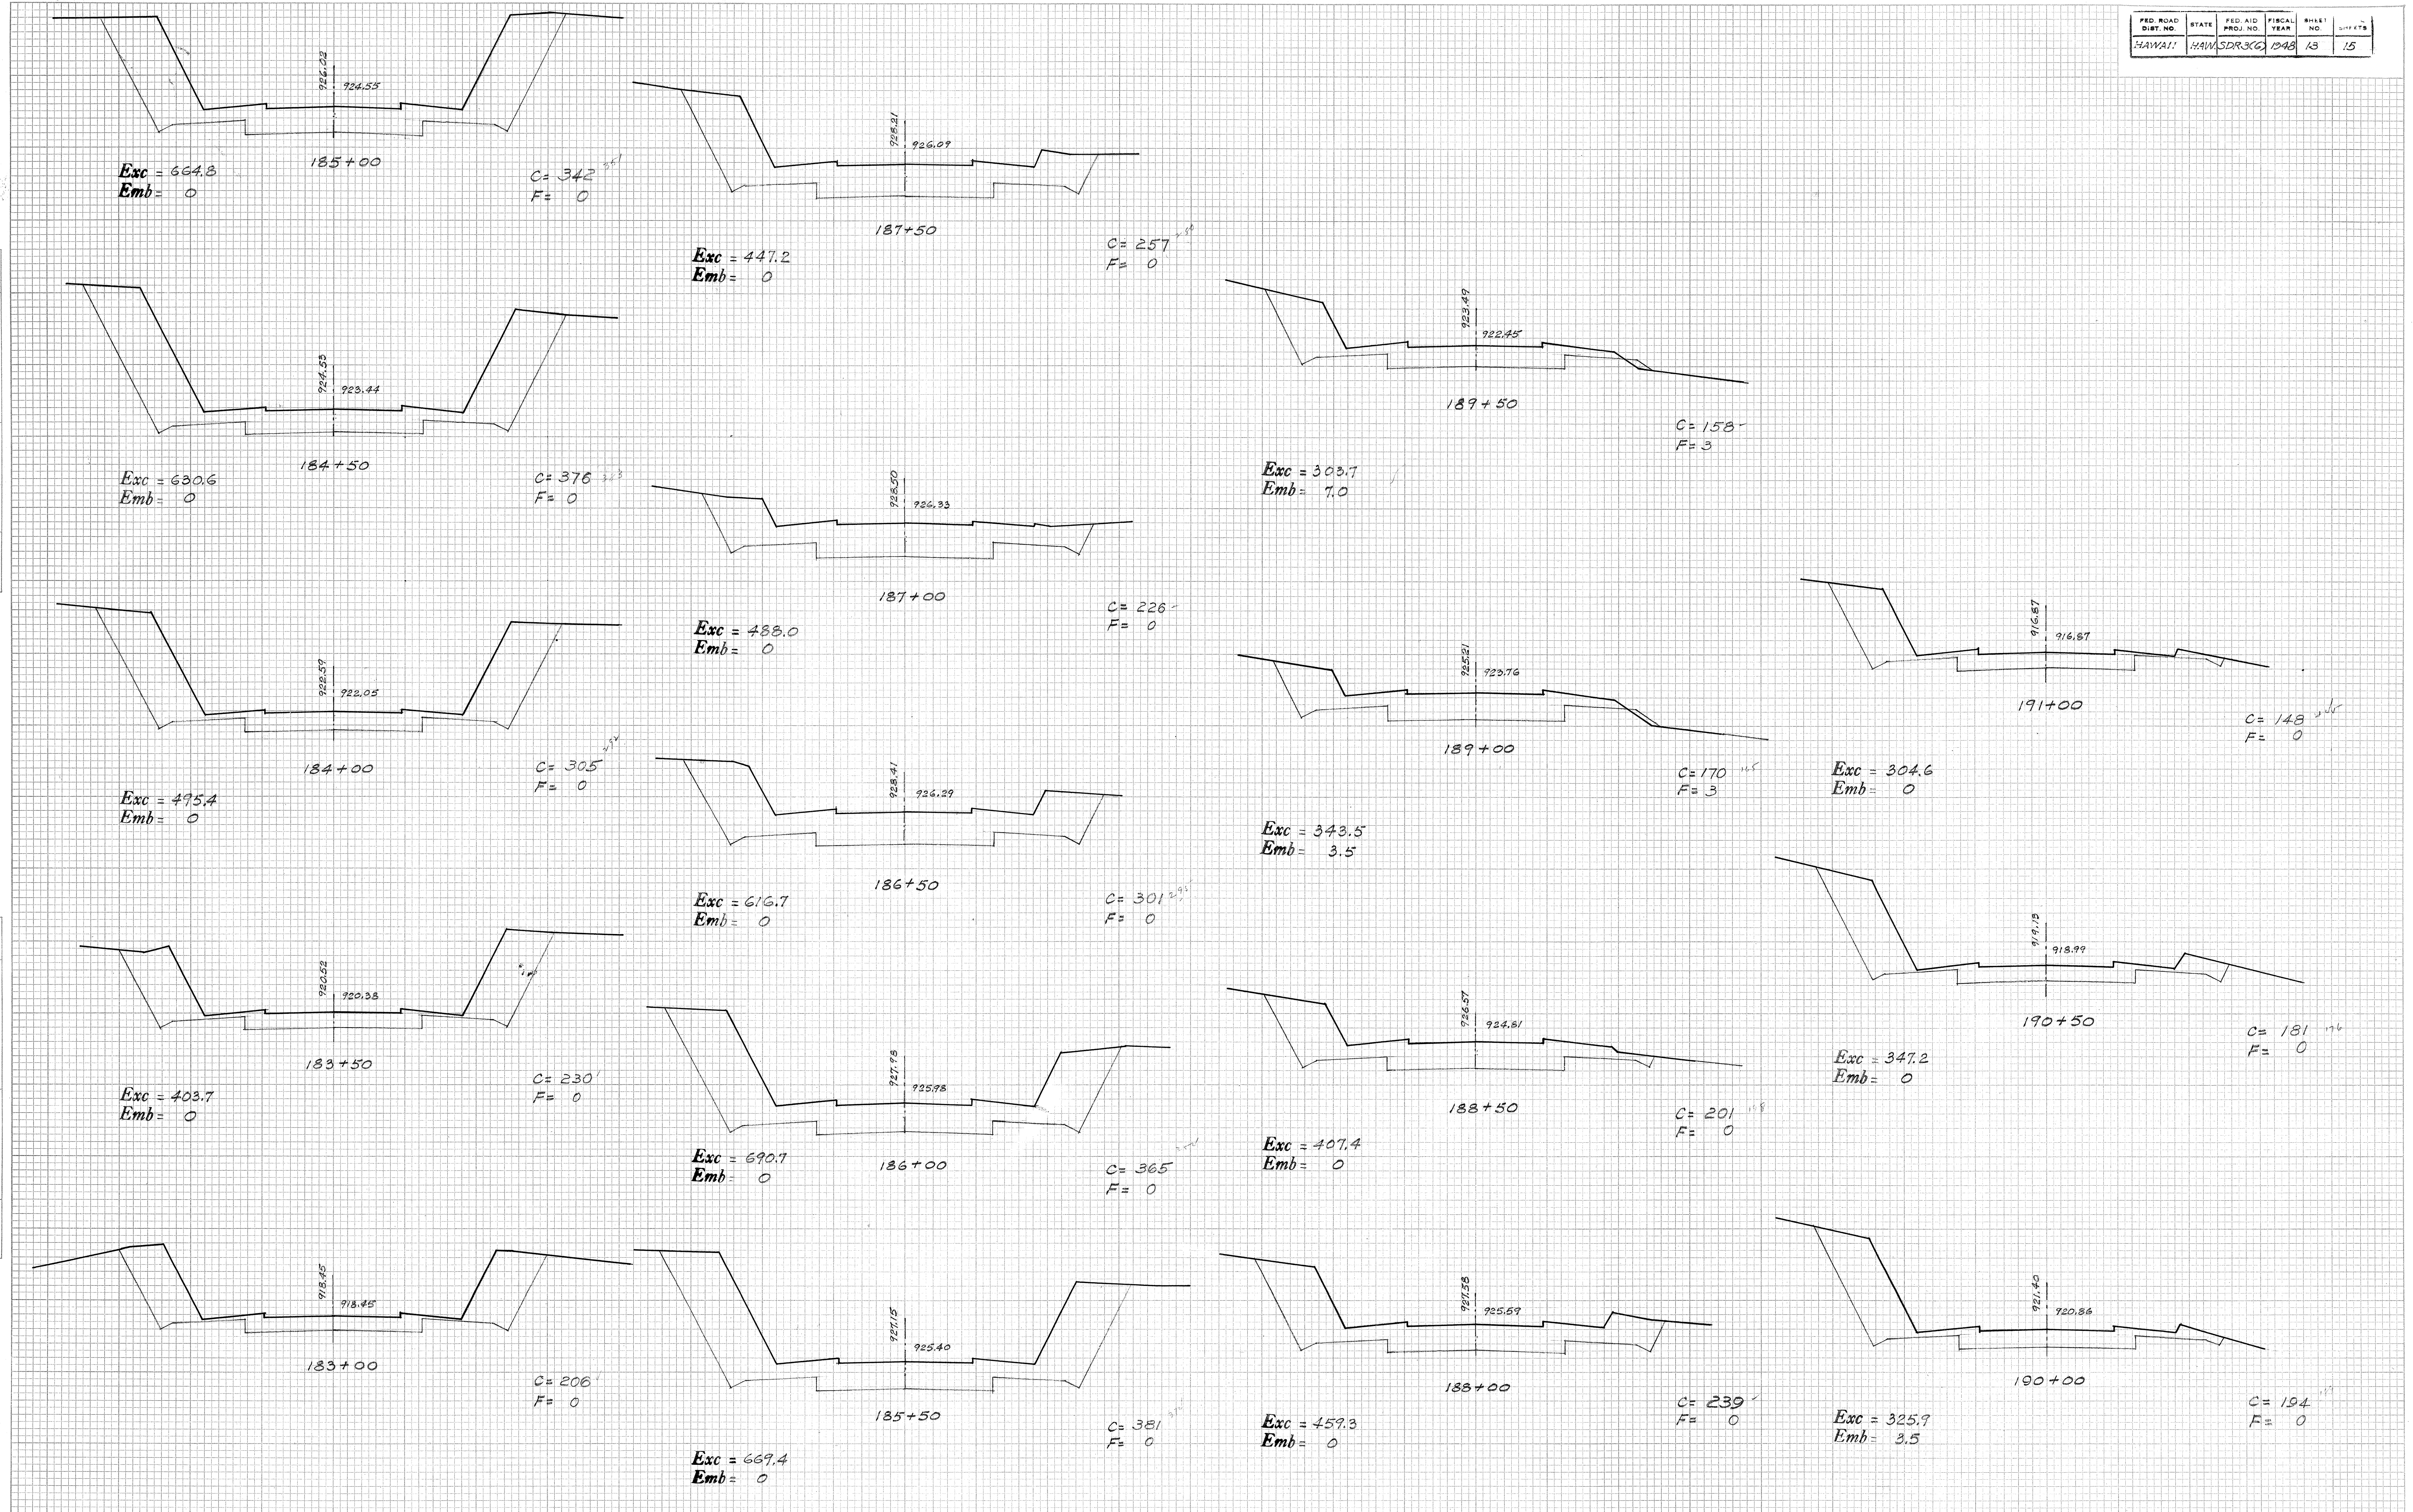

FINAL SURVEY	SURVEYED PLOTTED TEMPLATE AREAS AREAS CHECKED		BY _____	DATE _____
NOTE BOOK				
NO. _____				

ORIGINAL SURVEY		BY _____	DATE _____
NOTE BOOK		SURVEYED _____	
		PLOTTED _____	
		TEMPLATE _____	
		AREAS _____	
NO. _____		AREAS CHECKED _____	

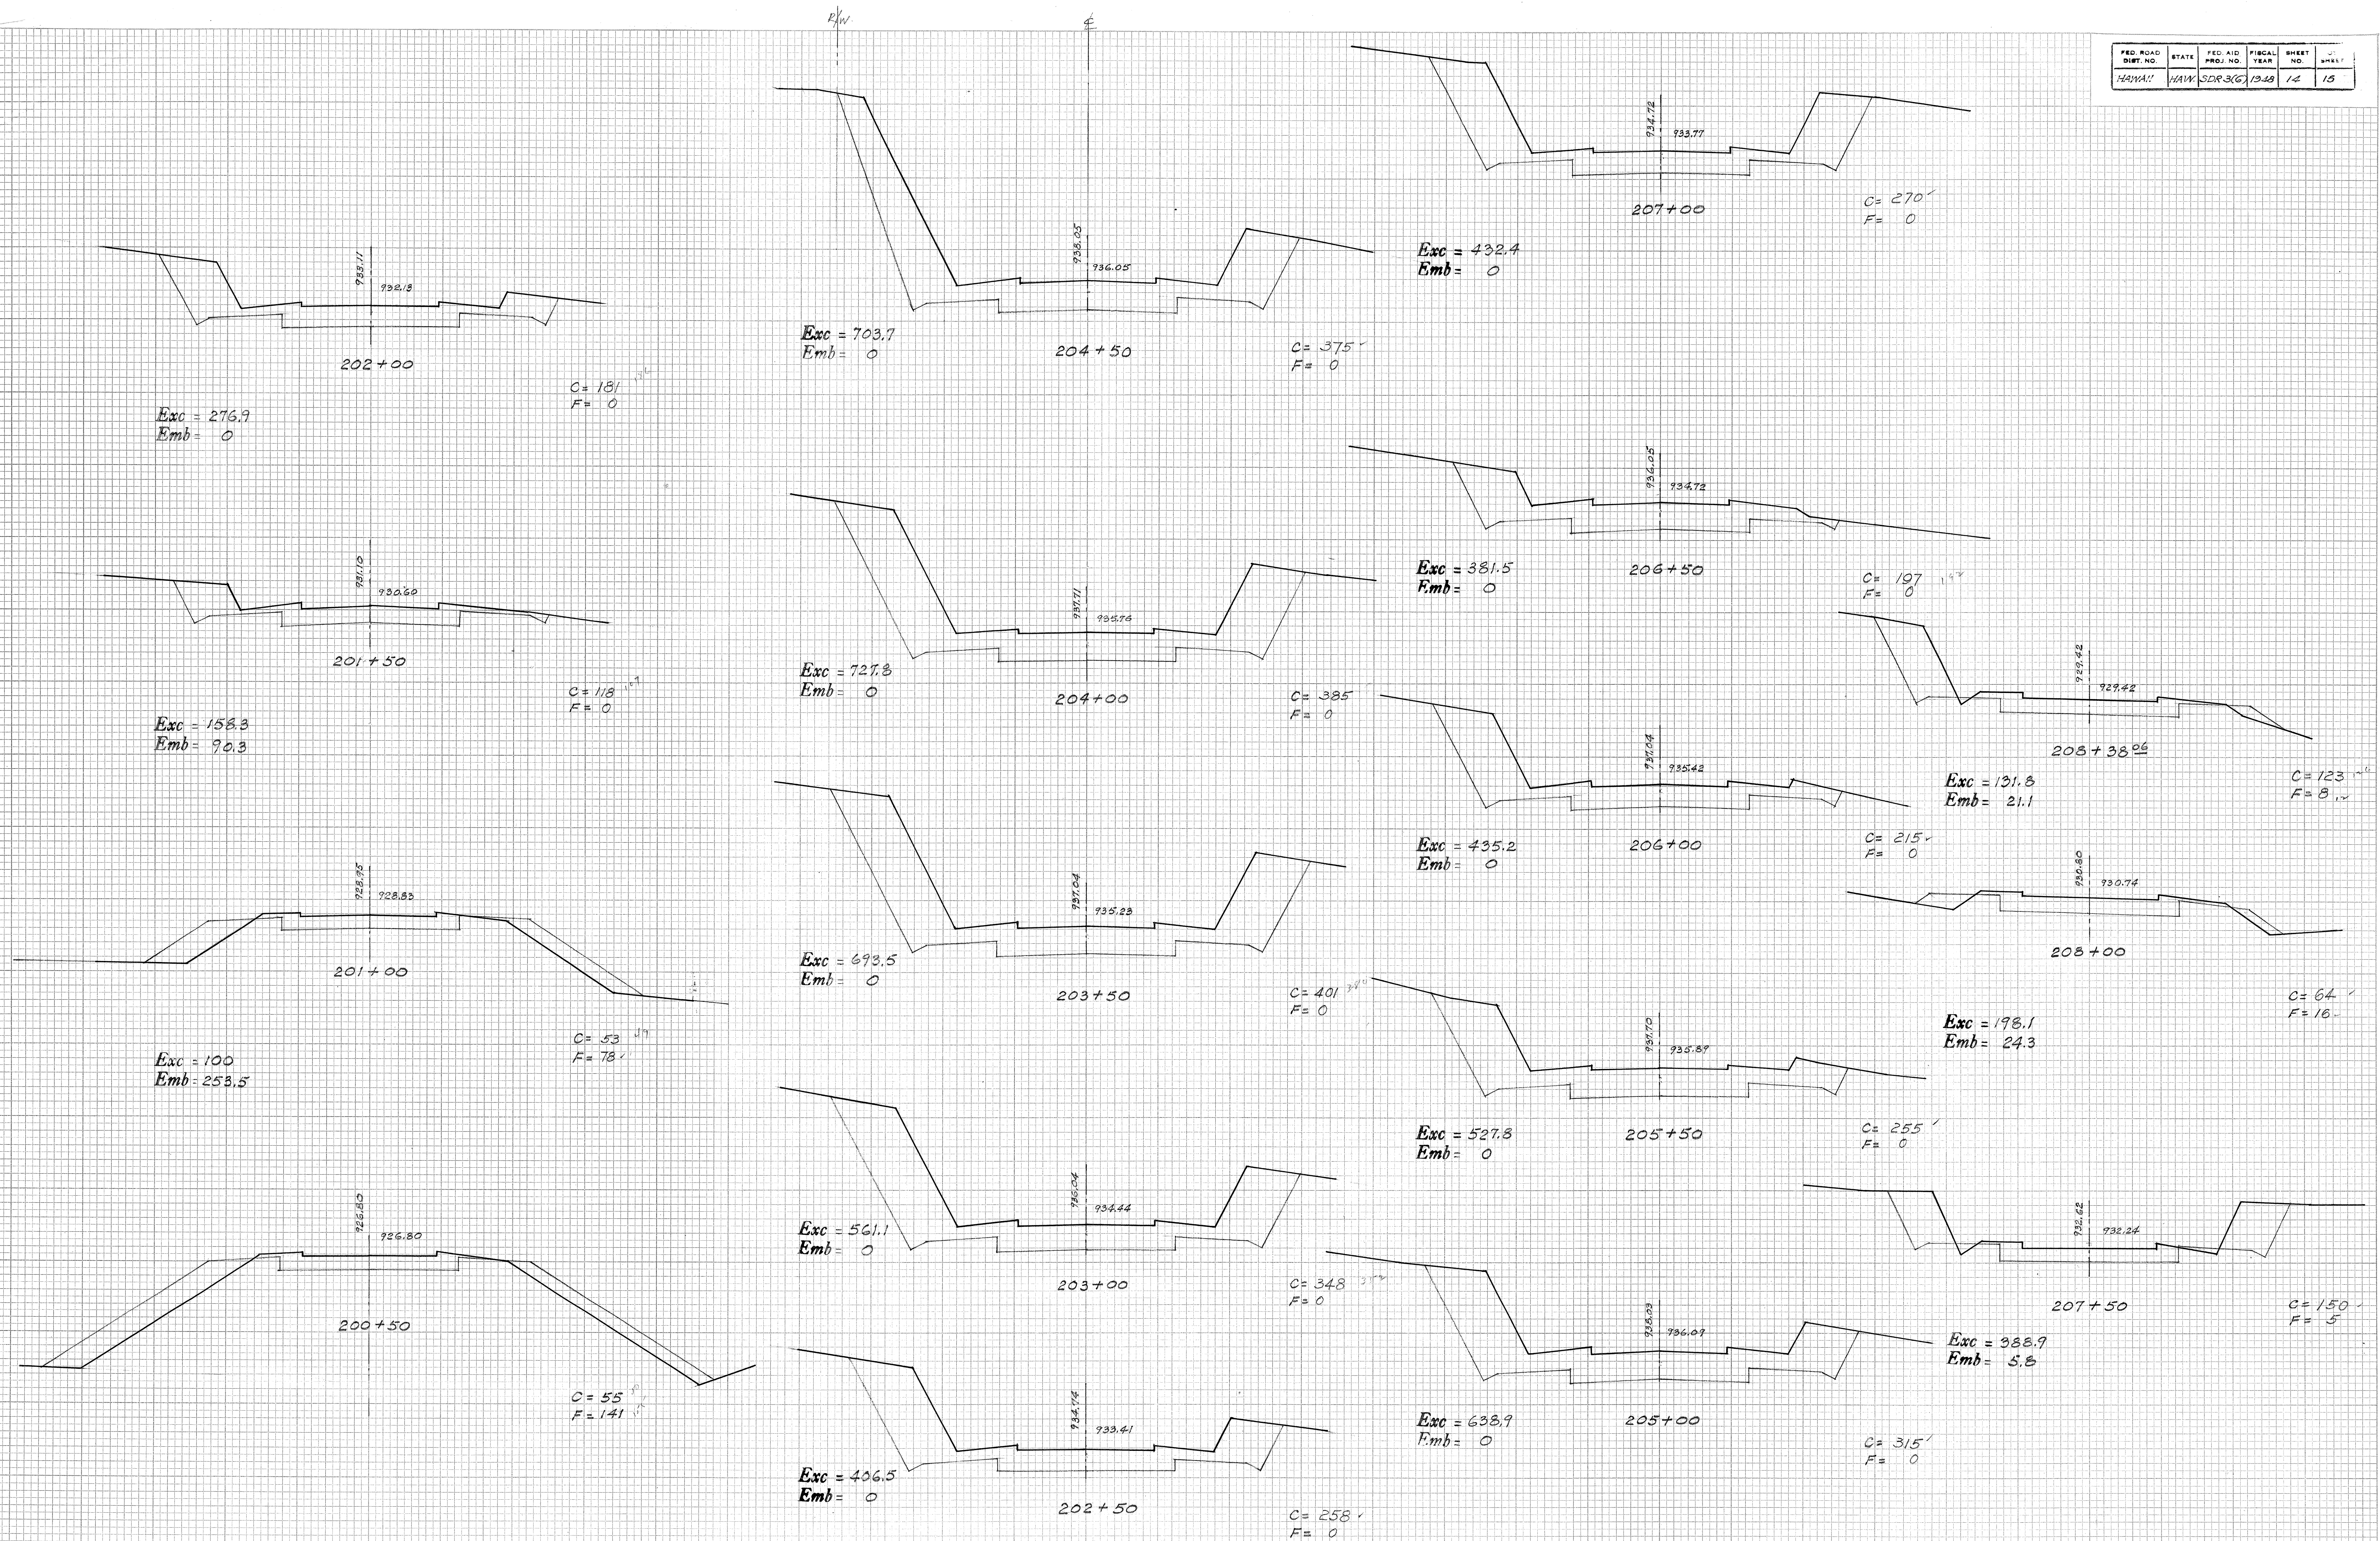

FED. ROAD DIST. NO.	STATE	FED. AID PROJ. NO.	FISCAL YEAR	SHEET NO.	TOTAL SHEETS
HAWAII	HAWAII	SDR 30/1948	15	15	

DATE	BY	FINAL SURVEY PLOTTED	NOTE BOOK NO.	AREAS CHECKED

DATE	BY	ORIGINAL SURVEY PLOTTED	NOTE BOOK NO.	AREAS CHECKED

