

INDEX TO DRAWINGS	
SHEET	DESCRIPTION
1	TITLE SHEET
2-2A	TYPICAL SECTIONS
3-11	PLAN & PROFILE
12	STANDARD DETAIL
13-15	CROSS SECTIONS

TERRITORY OF HAWAII
TERRITORIAL HIGHWAY DEPARTMENT
HONOLULU T.H.

PLANS OF

HAWAII BELT ROAD

SEISMIC WAVE DAMAGE REHABILITATION PROJ. NO. S.D.R. 3 (6)
(WIDENING OF FAGH,FAP 26A, 14F,14G,14H,14I.)


DISTRICT OF HAMAKUA
ISLAND OF HAWAII

SCALE

PLAN_____1 INCH=100 FEET

PROFILE_____HOR. 1 INCH=100 FEET
VER. 1 INCH= 10 FEET


CROSS SECTIONS_____HOR. 1 INCH= 10 FEET
VER. 1 INCH= 10 FEET

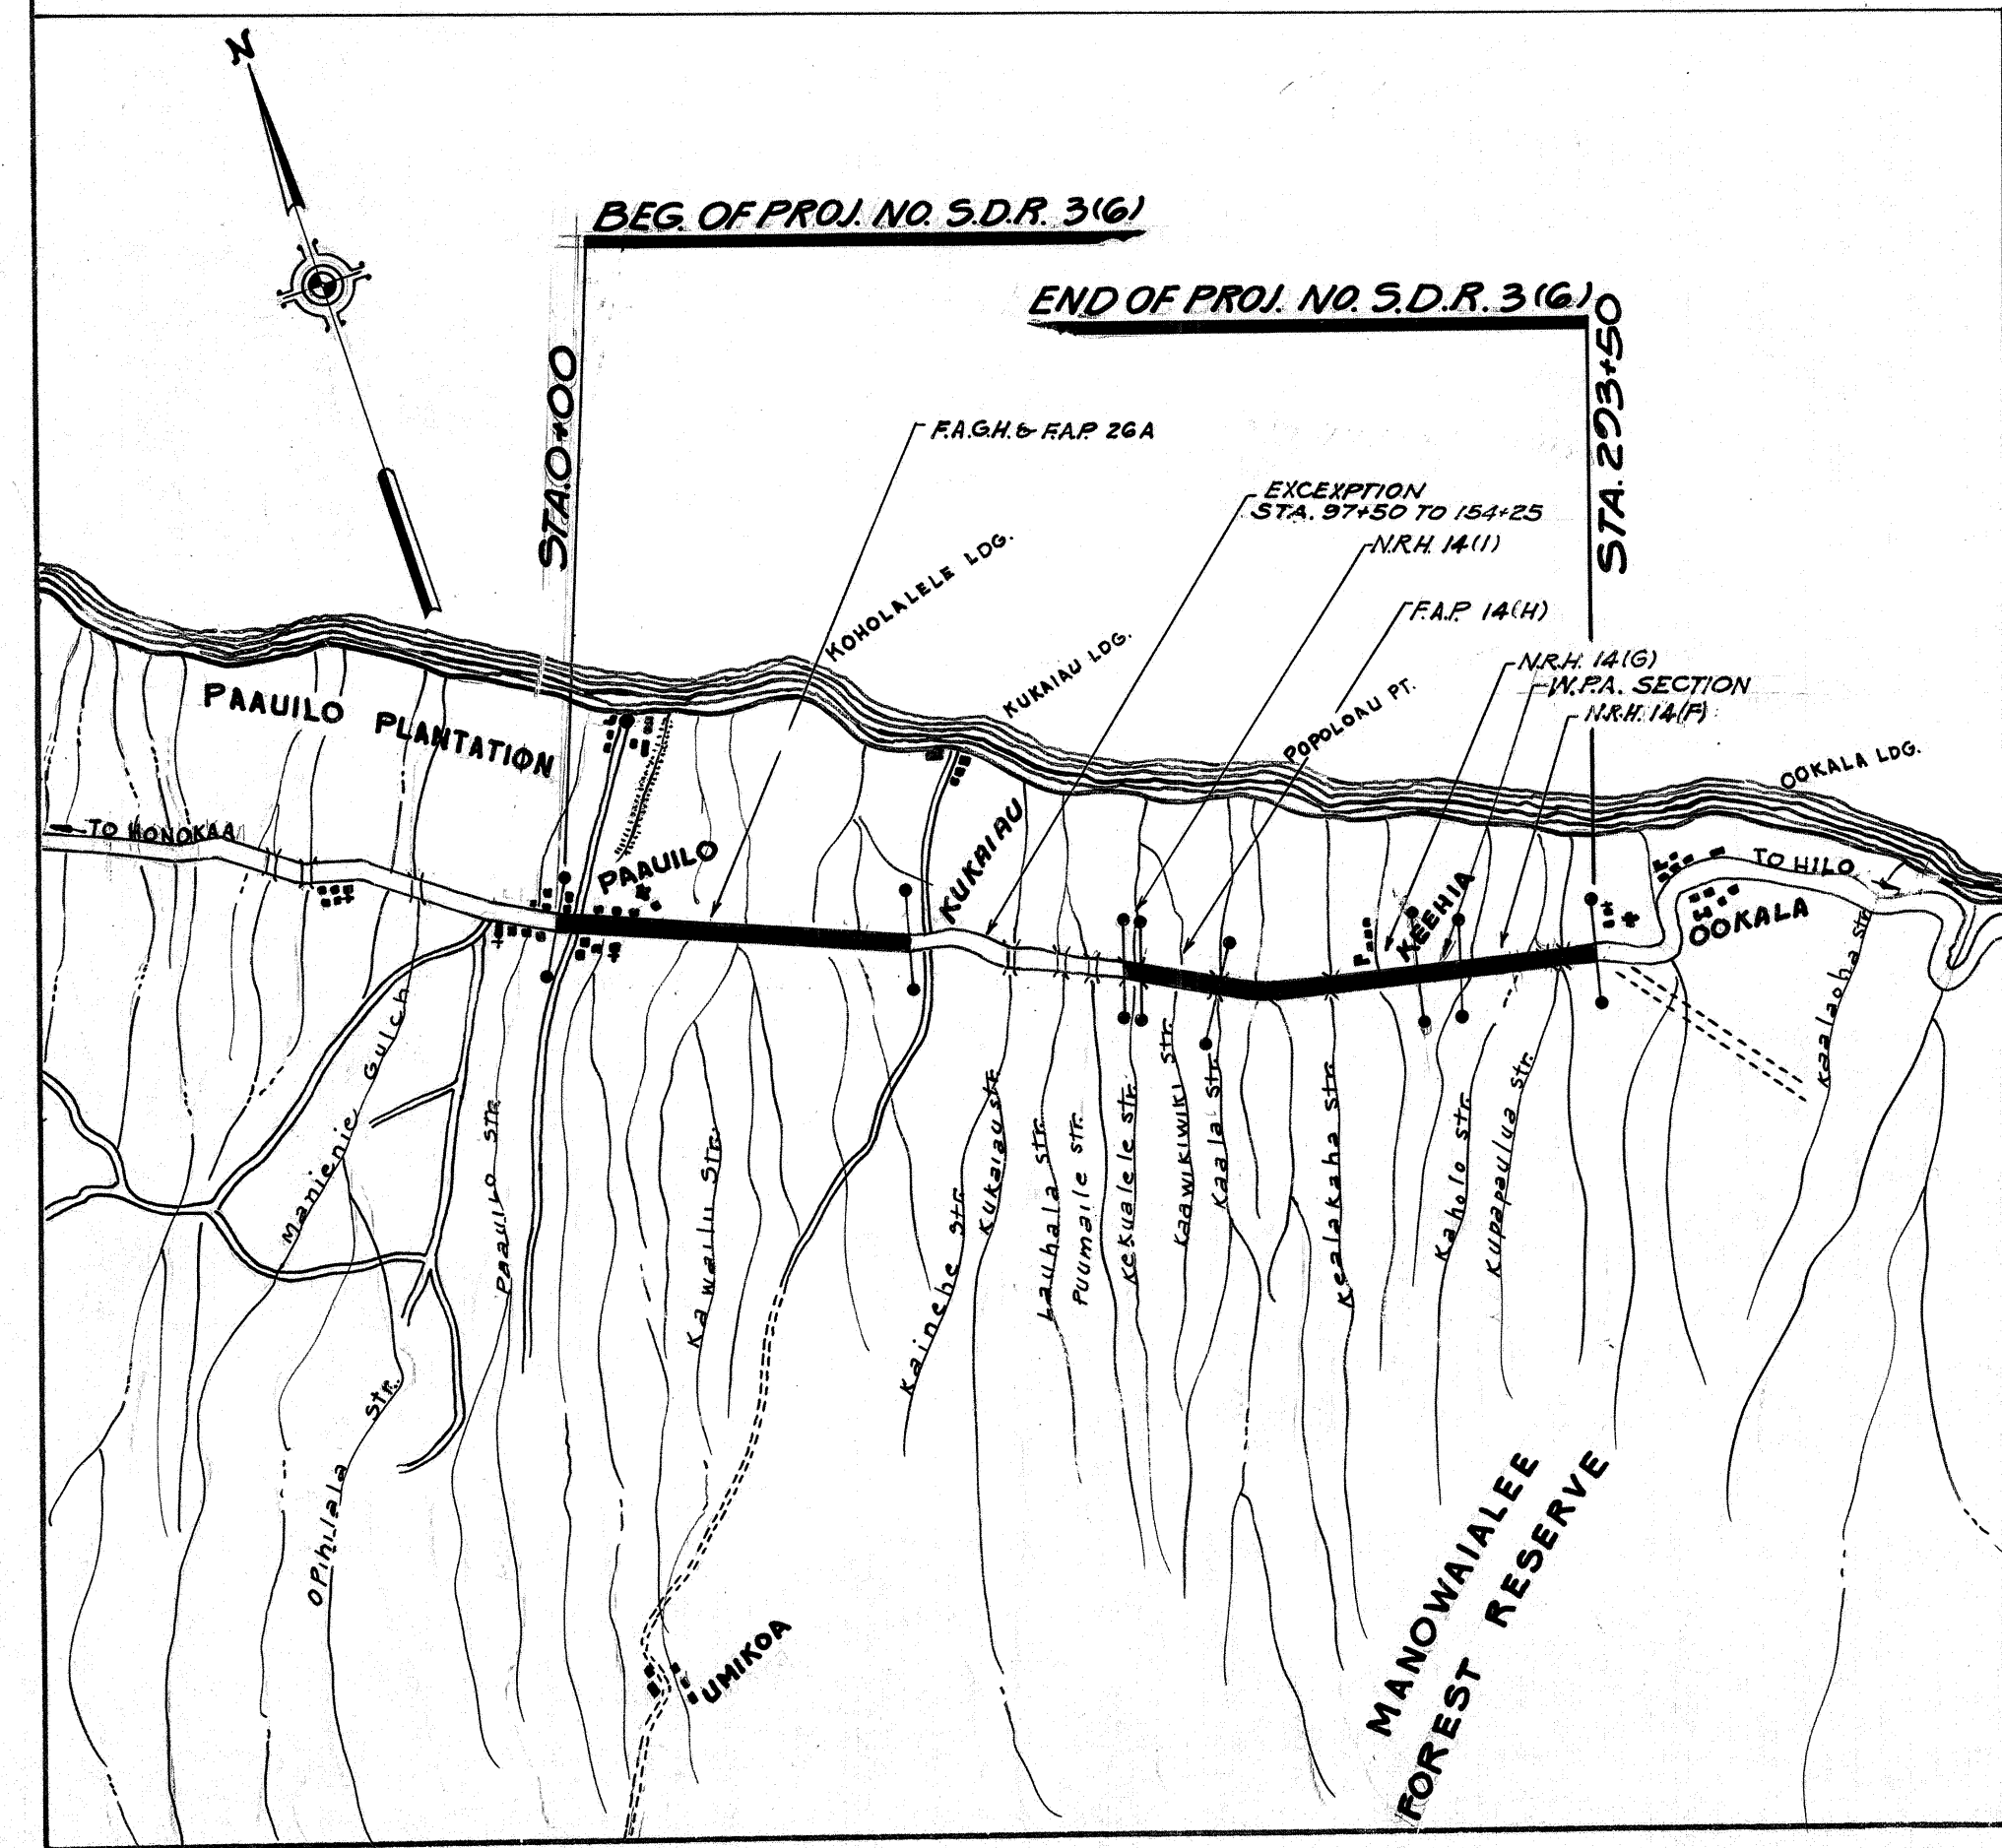

LAYOUT OF PROJECT

Scale: 1"= 1 mi.

GROSS LENGTH OF PROJECT	5.560 MI.
EXCEPTION	1.075 MI.
NET LENGTH OF PROJECT	4.485 MI.
BRIDGE OVER 20' SPAN	0.408 MI.
NET LENGTH OF ROADWAY	4.077 MI.

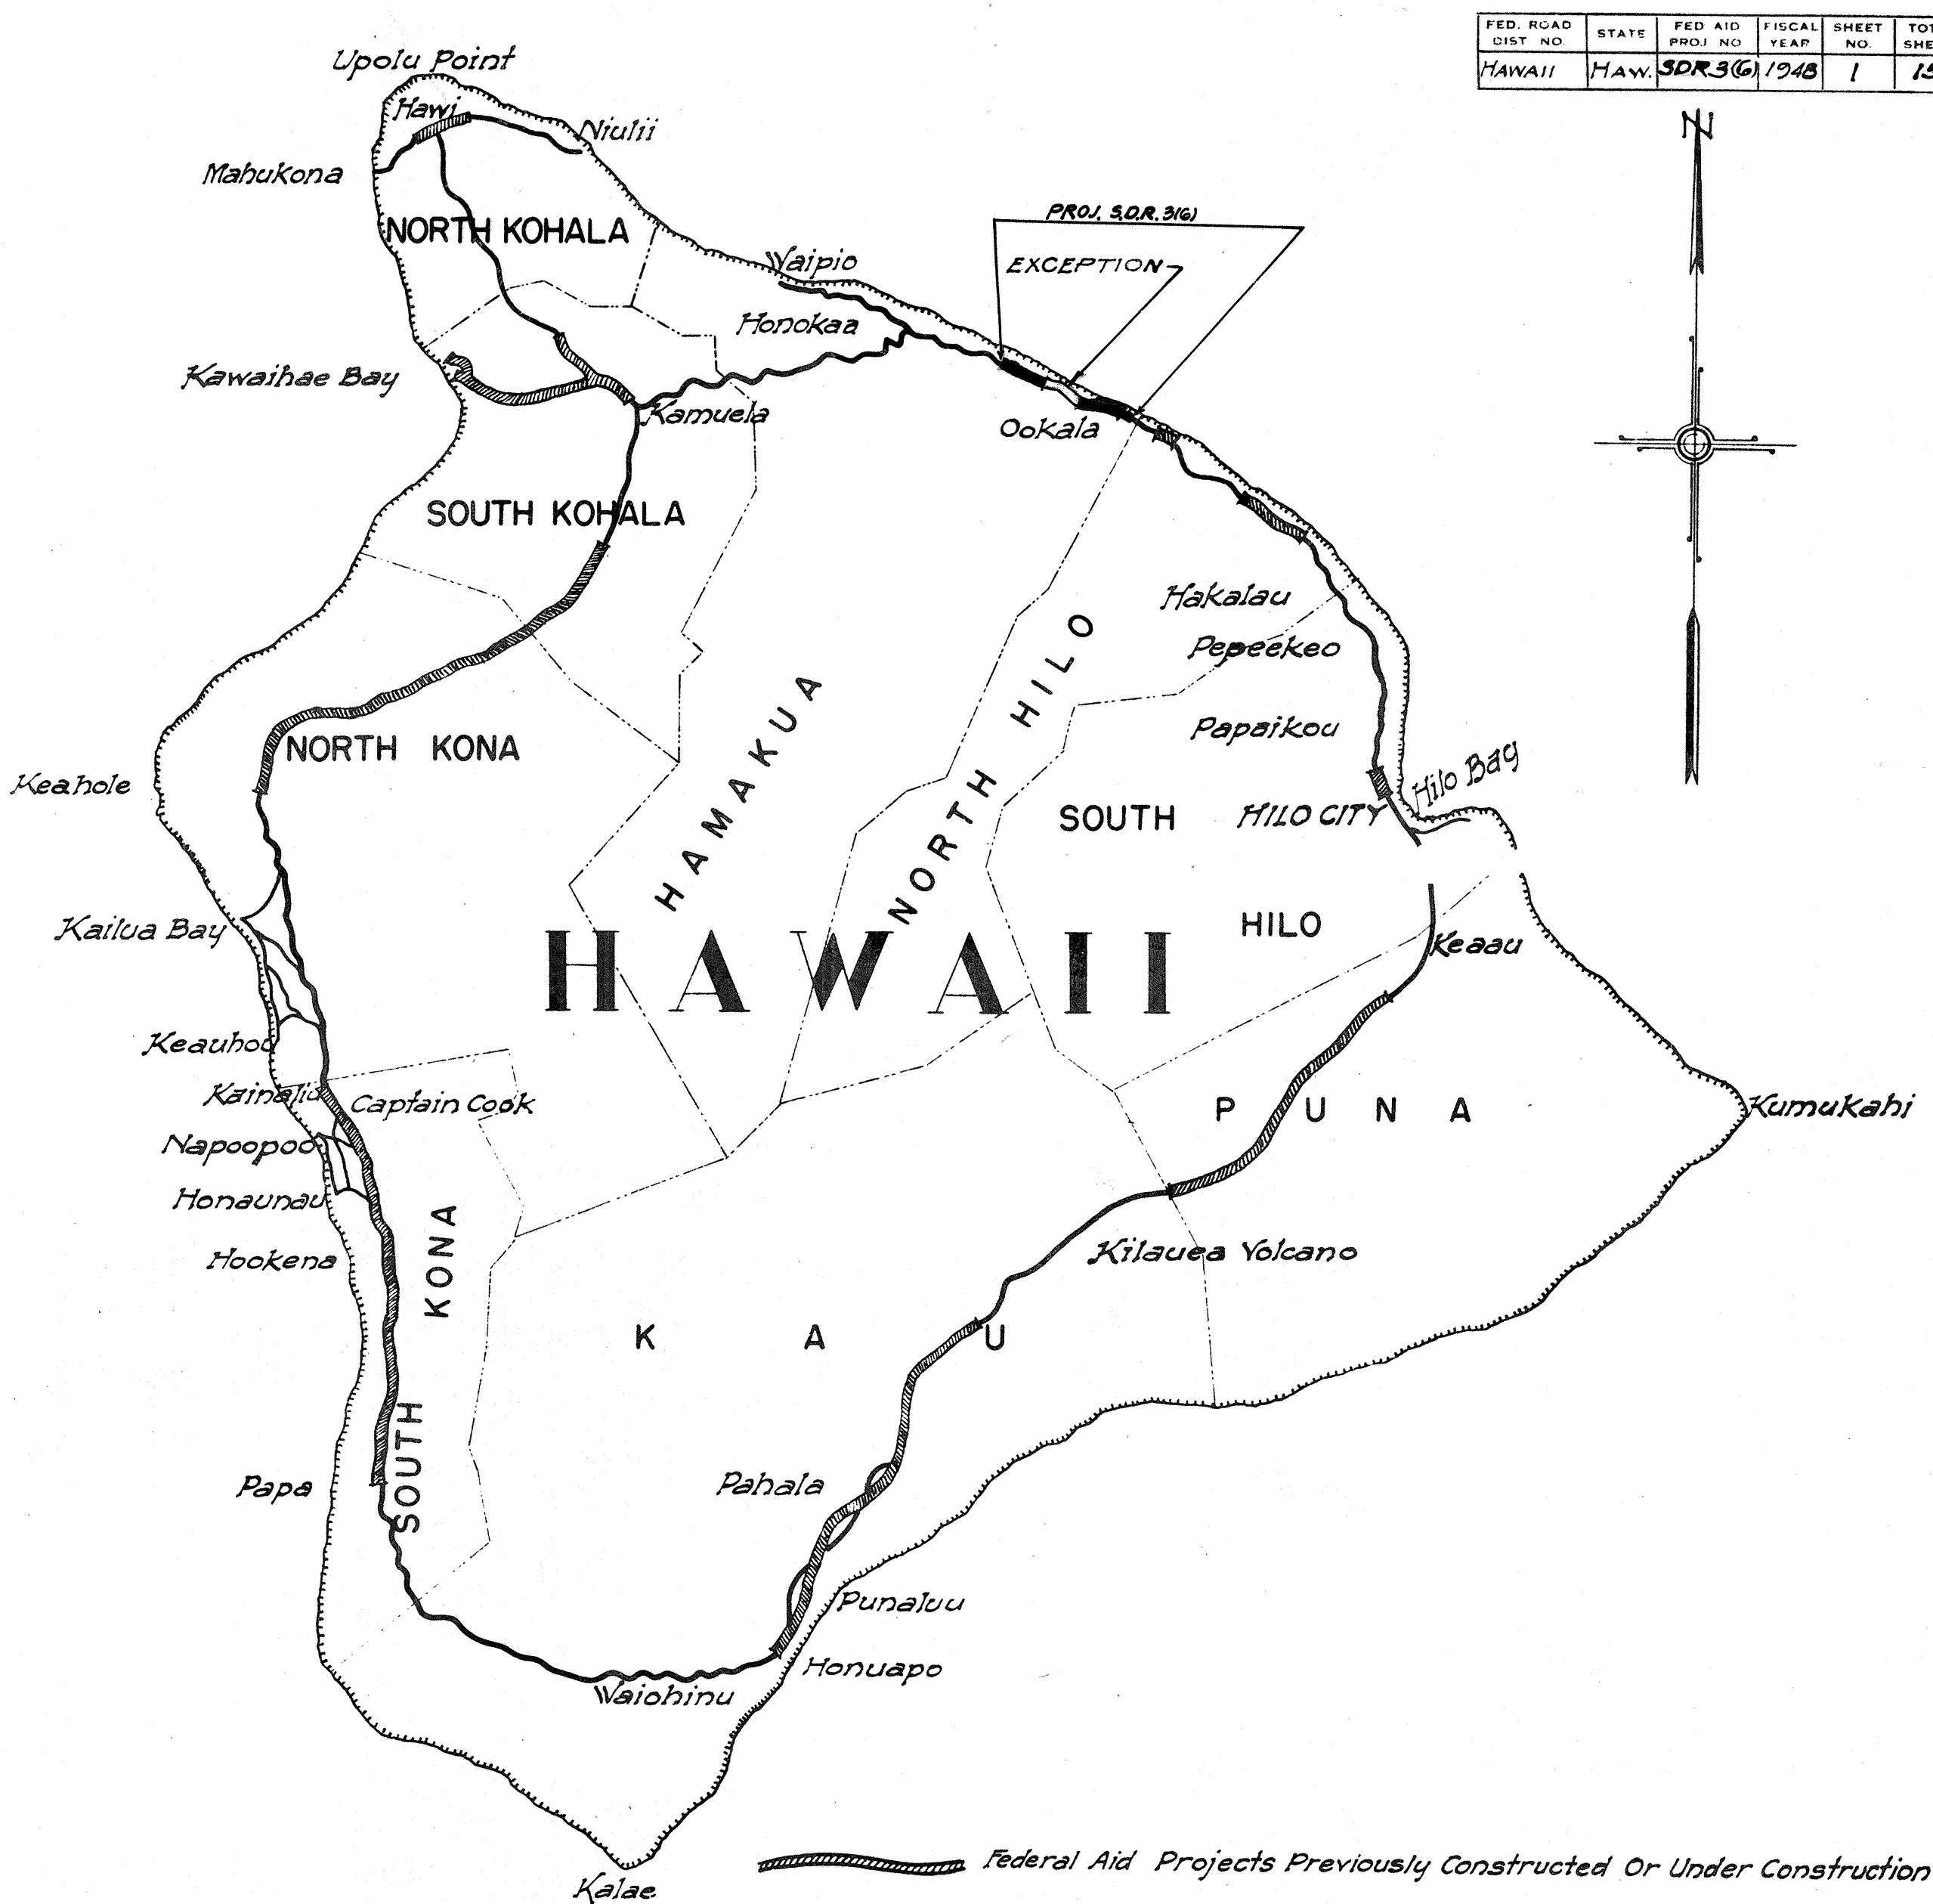

NOTE: All changes made during
Construction have been noted in red
on these tracings and checked by:

J. H. Moulton
Resident Engineer

Date Feb 3 1950

RECOMMENDED FOR APPROVAL: DATE: _____

DISTRICT ENGINEER
PUBLIC ROADS ADMINISTRATION
FEDERAL WORKS AGENCY

APPROVED: _____ DATE: 11-19-48

TERRITORIAL HIGHWAY ENGINEER

APPROVED: _____ DATE: _____

DIVISION ENGINEER
PUBLIC ROADS ADMINISTRATION
FEDERAL WORKS AGENCY