
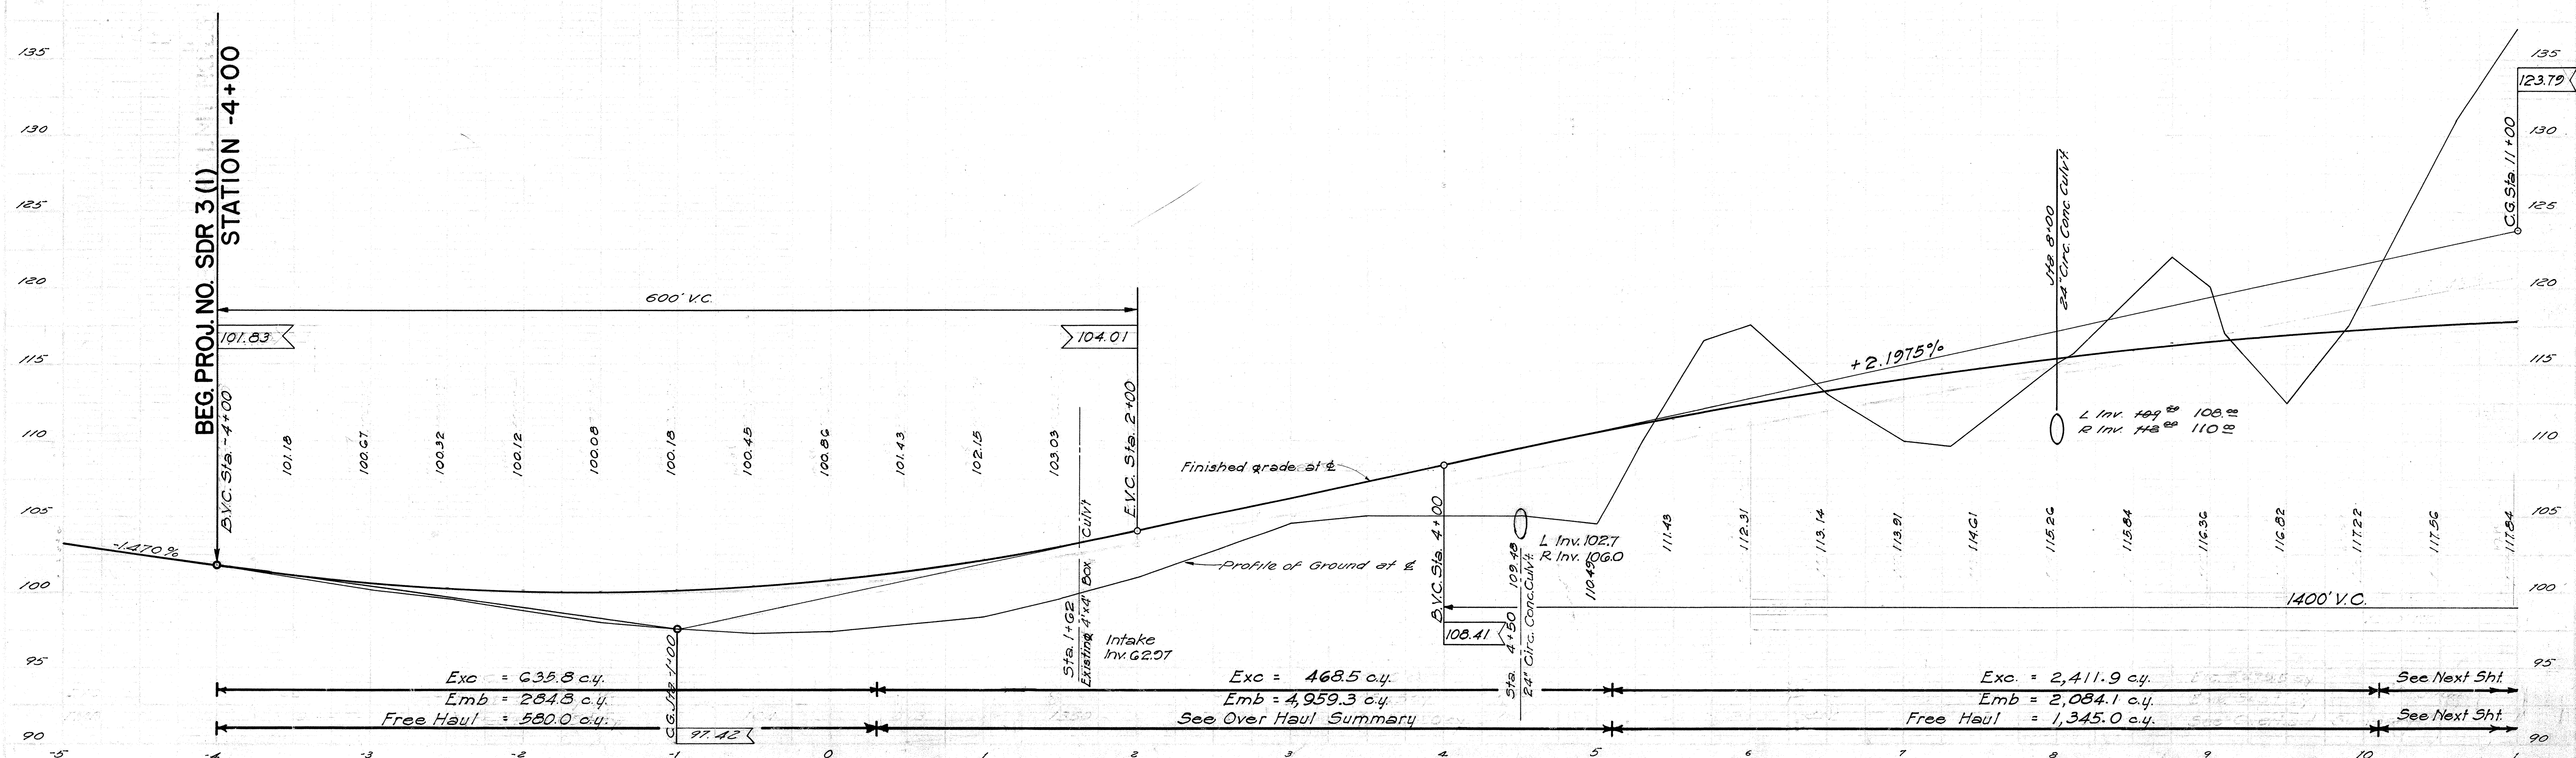


HAWAII	HAW	SDR301	1948	3	65
--------	-----	--------	------	---	----

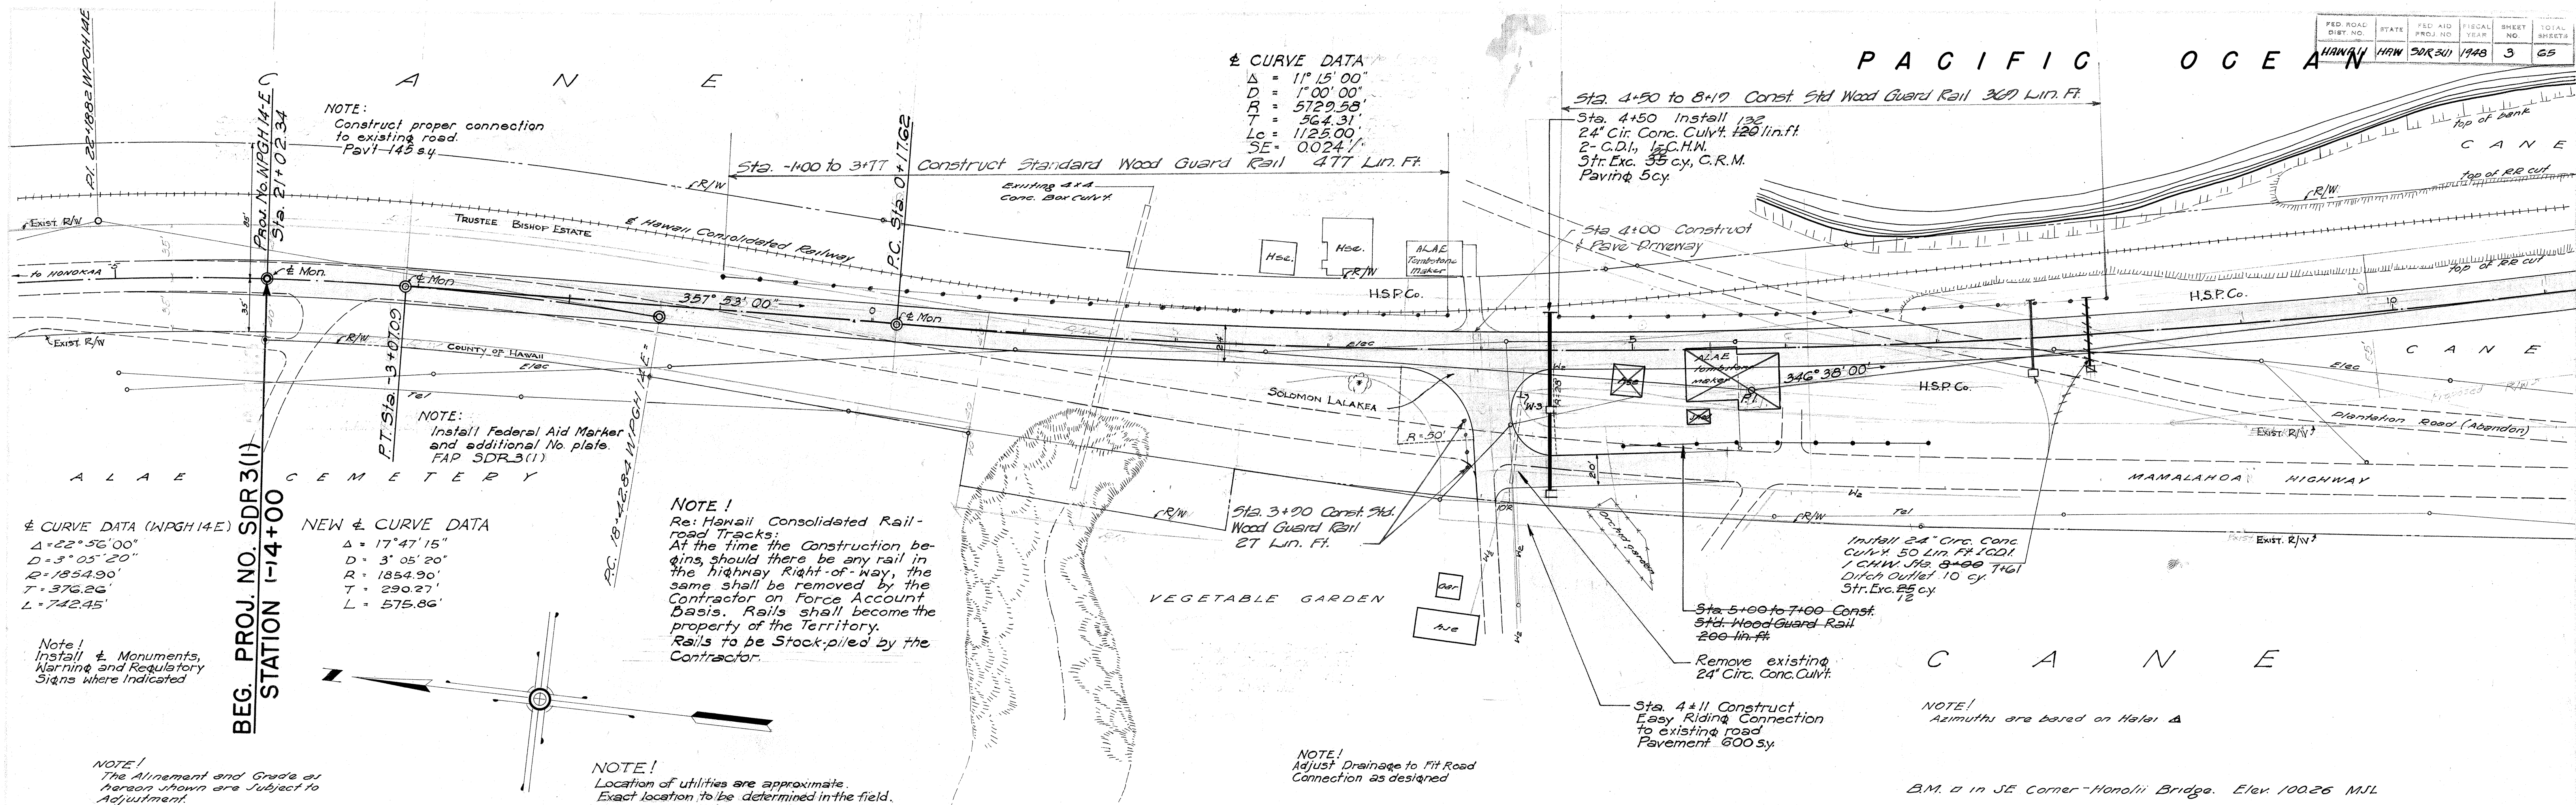



5 3 3 3 . 3

ED ROAD DIST. NO.	STATE	FED. AID PROJ. NO.	FISCAL YEAR	SHEET NO.	TOTAL SHEETS
1000	HAWAII	SDR 301	1948	4	65

$\Delta = 11^{\circ} 15' 00''$
 $D = 1^{\circ} 00' 00''$
 $R = 5720.58'$
 $T = 564.31'$
 $L_o = 1125.00'$
 $SE = 0.024\%$


P A C I F I C

O C E A N

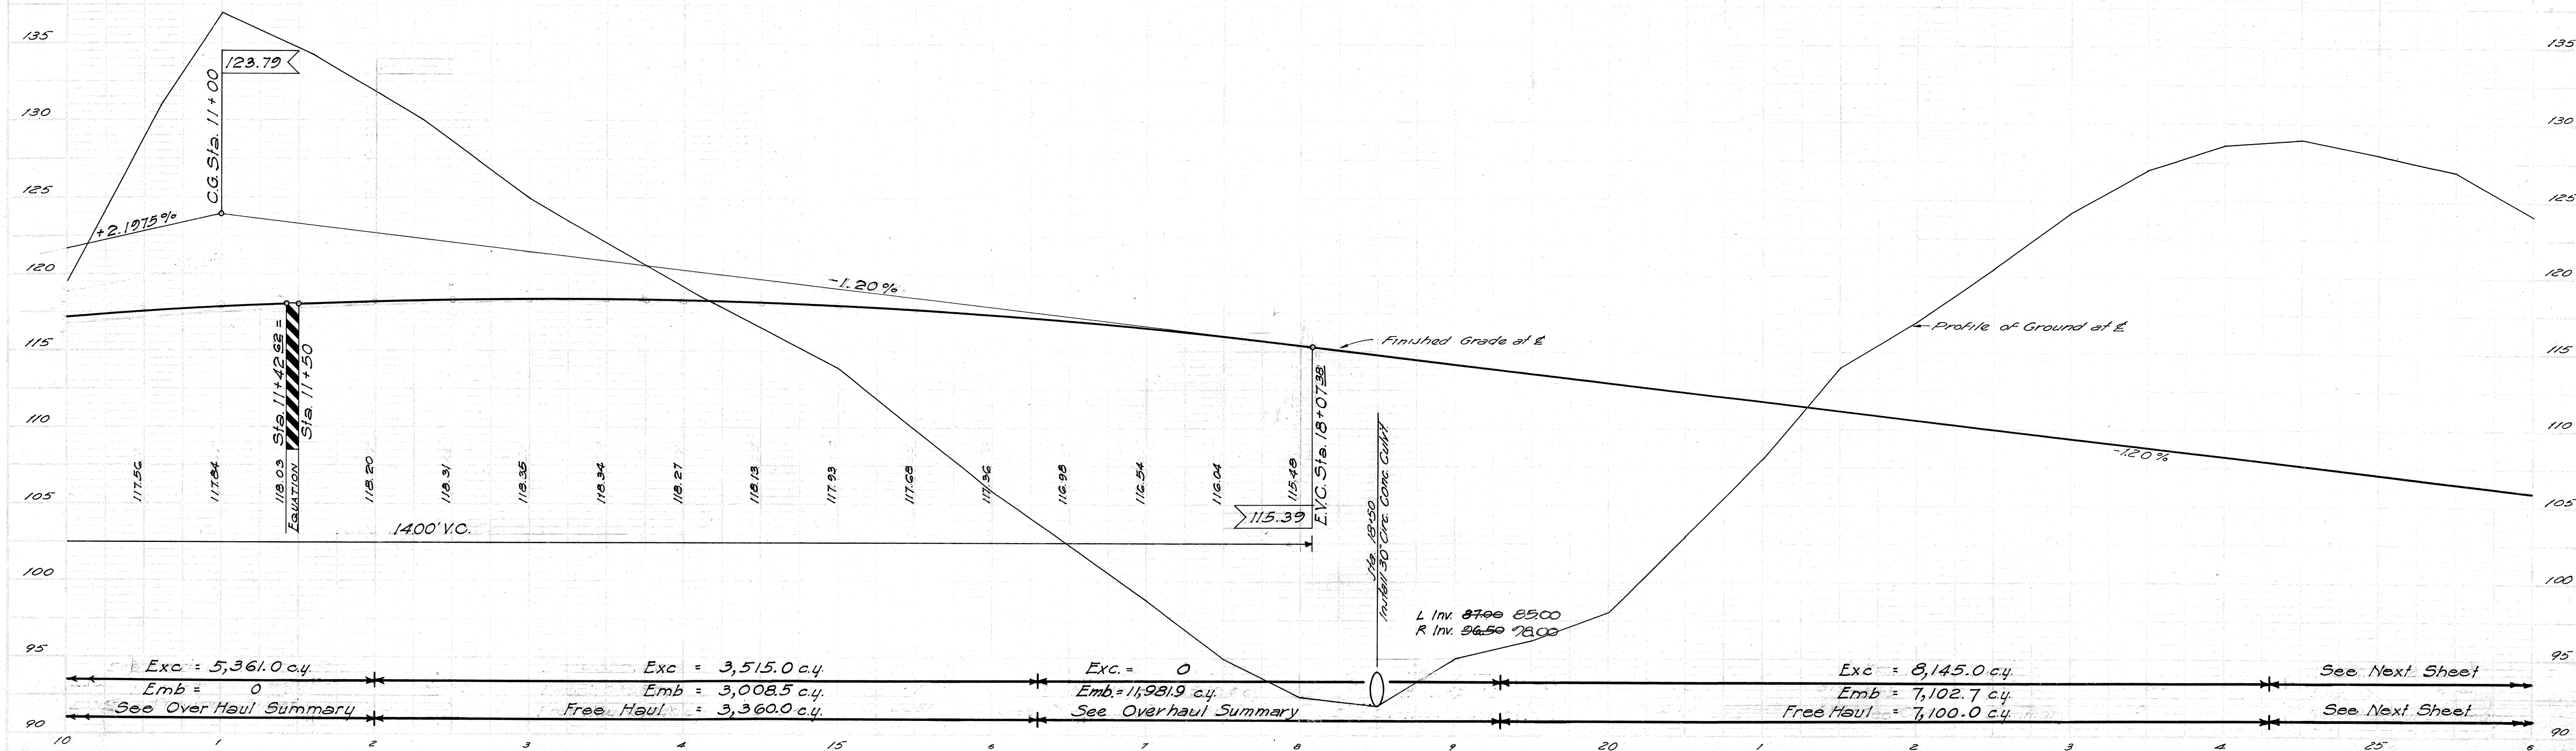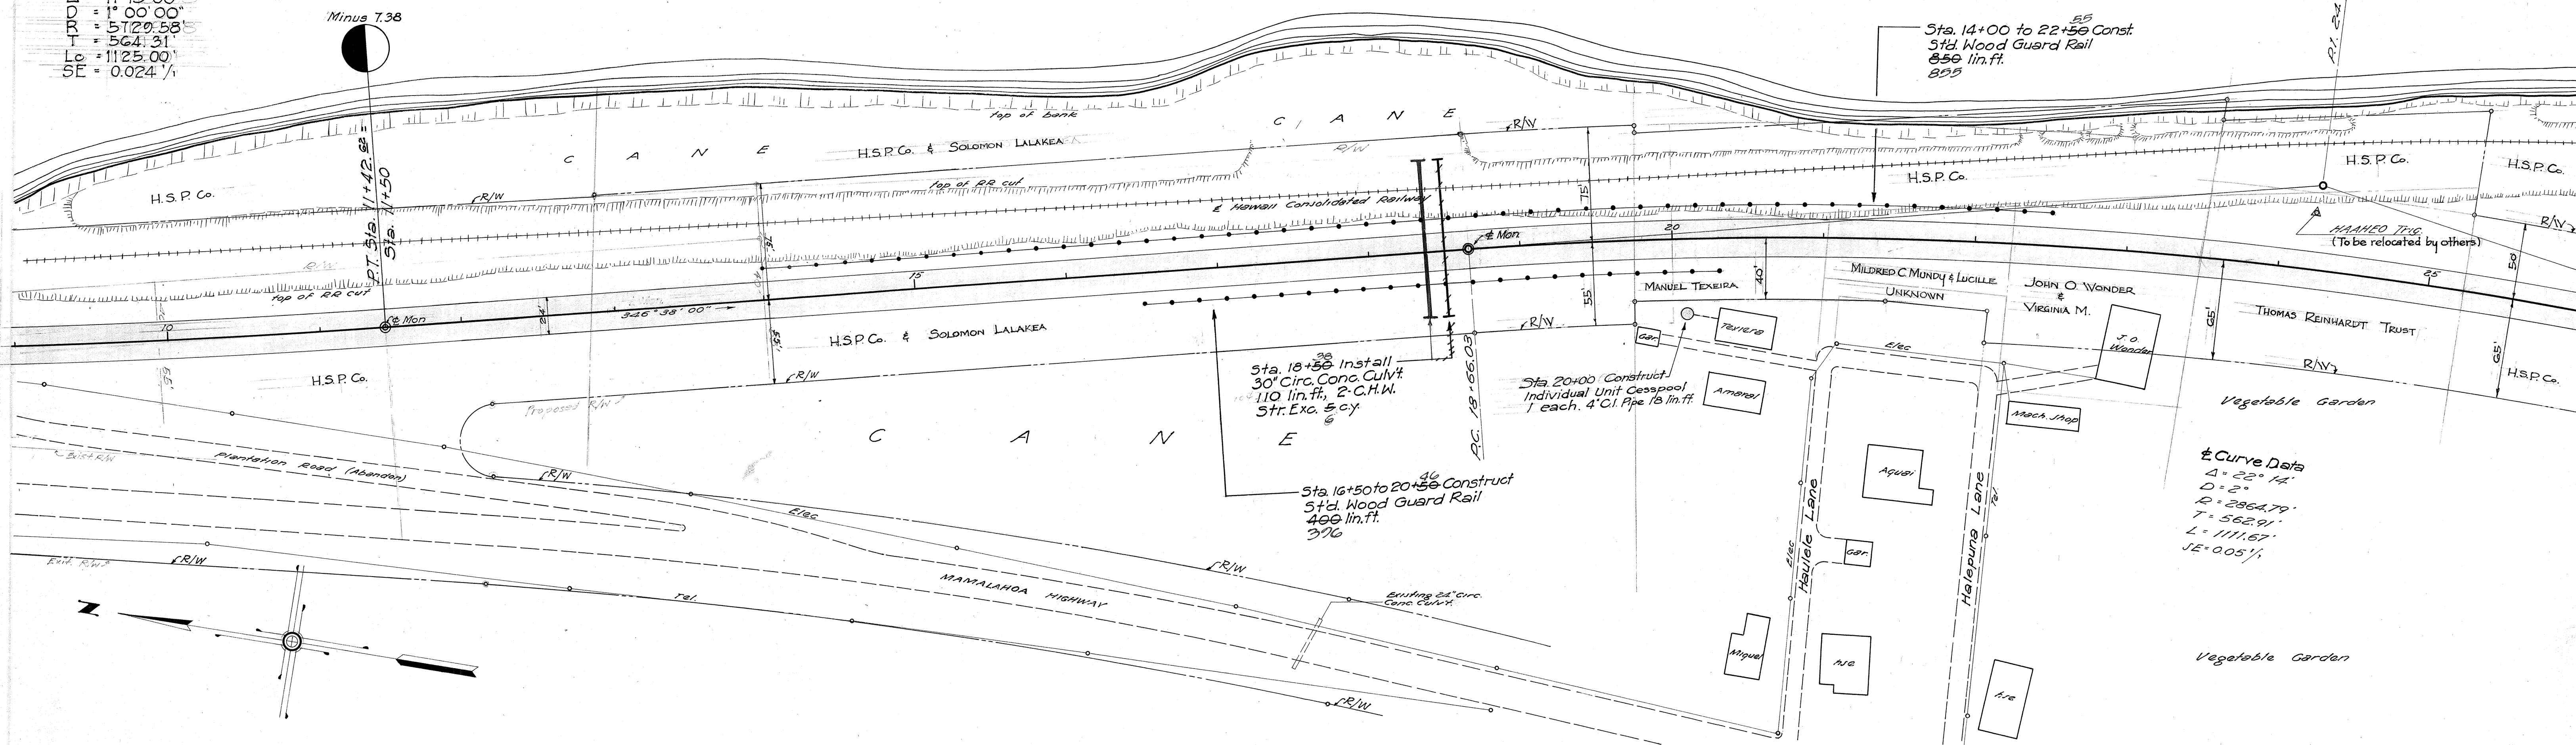

5 3 3 3.4



FED. ROAD DIST. NO.	STATE	FED. AID PROJ. NO.	FISCAL YEAR	SHEET NO.	TOTAL SHEETS
HAWAII	HAW	50R30	1948	5	65

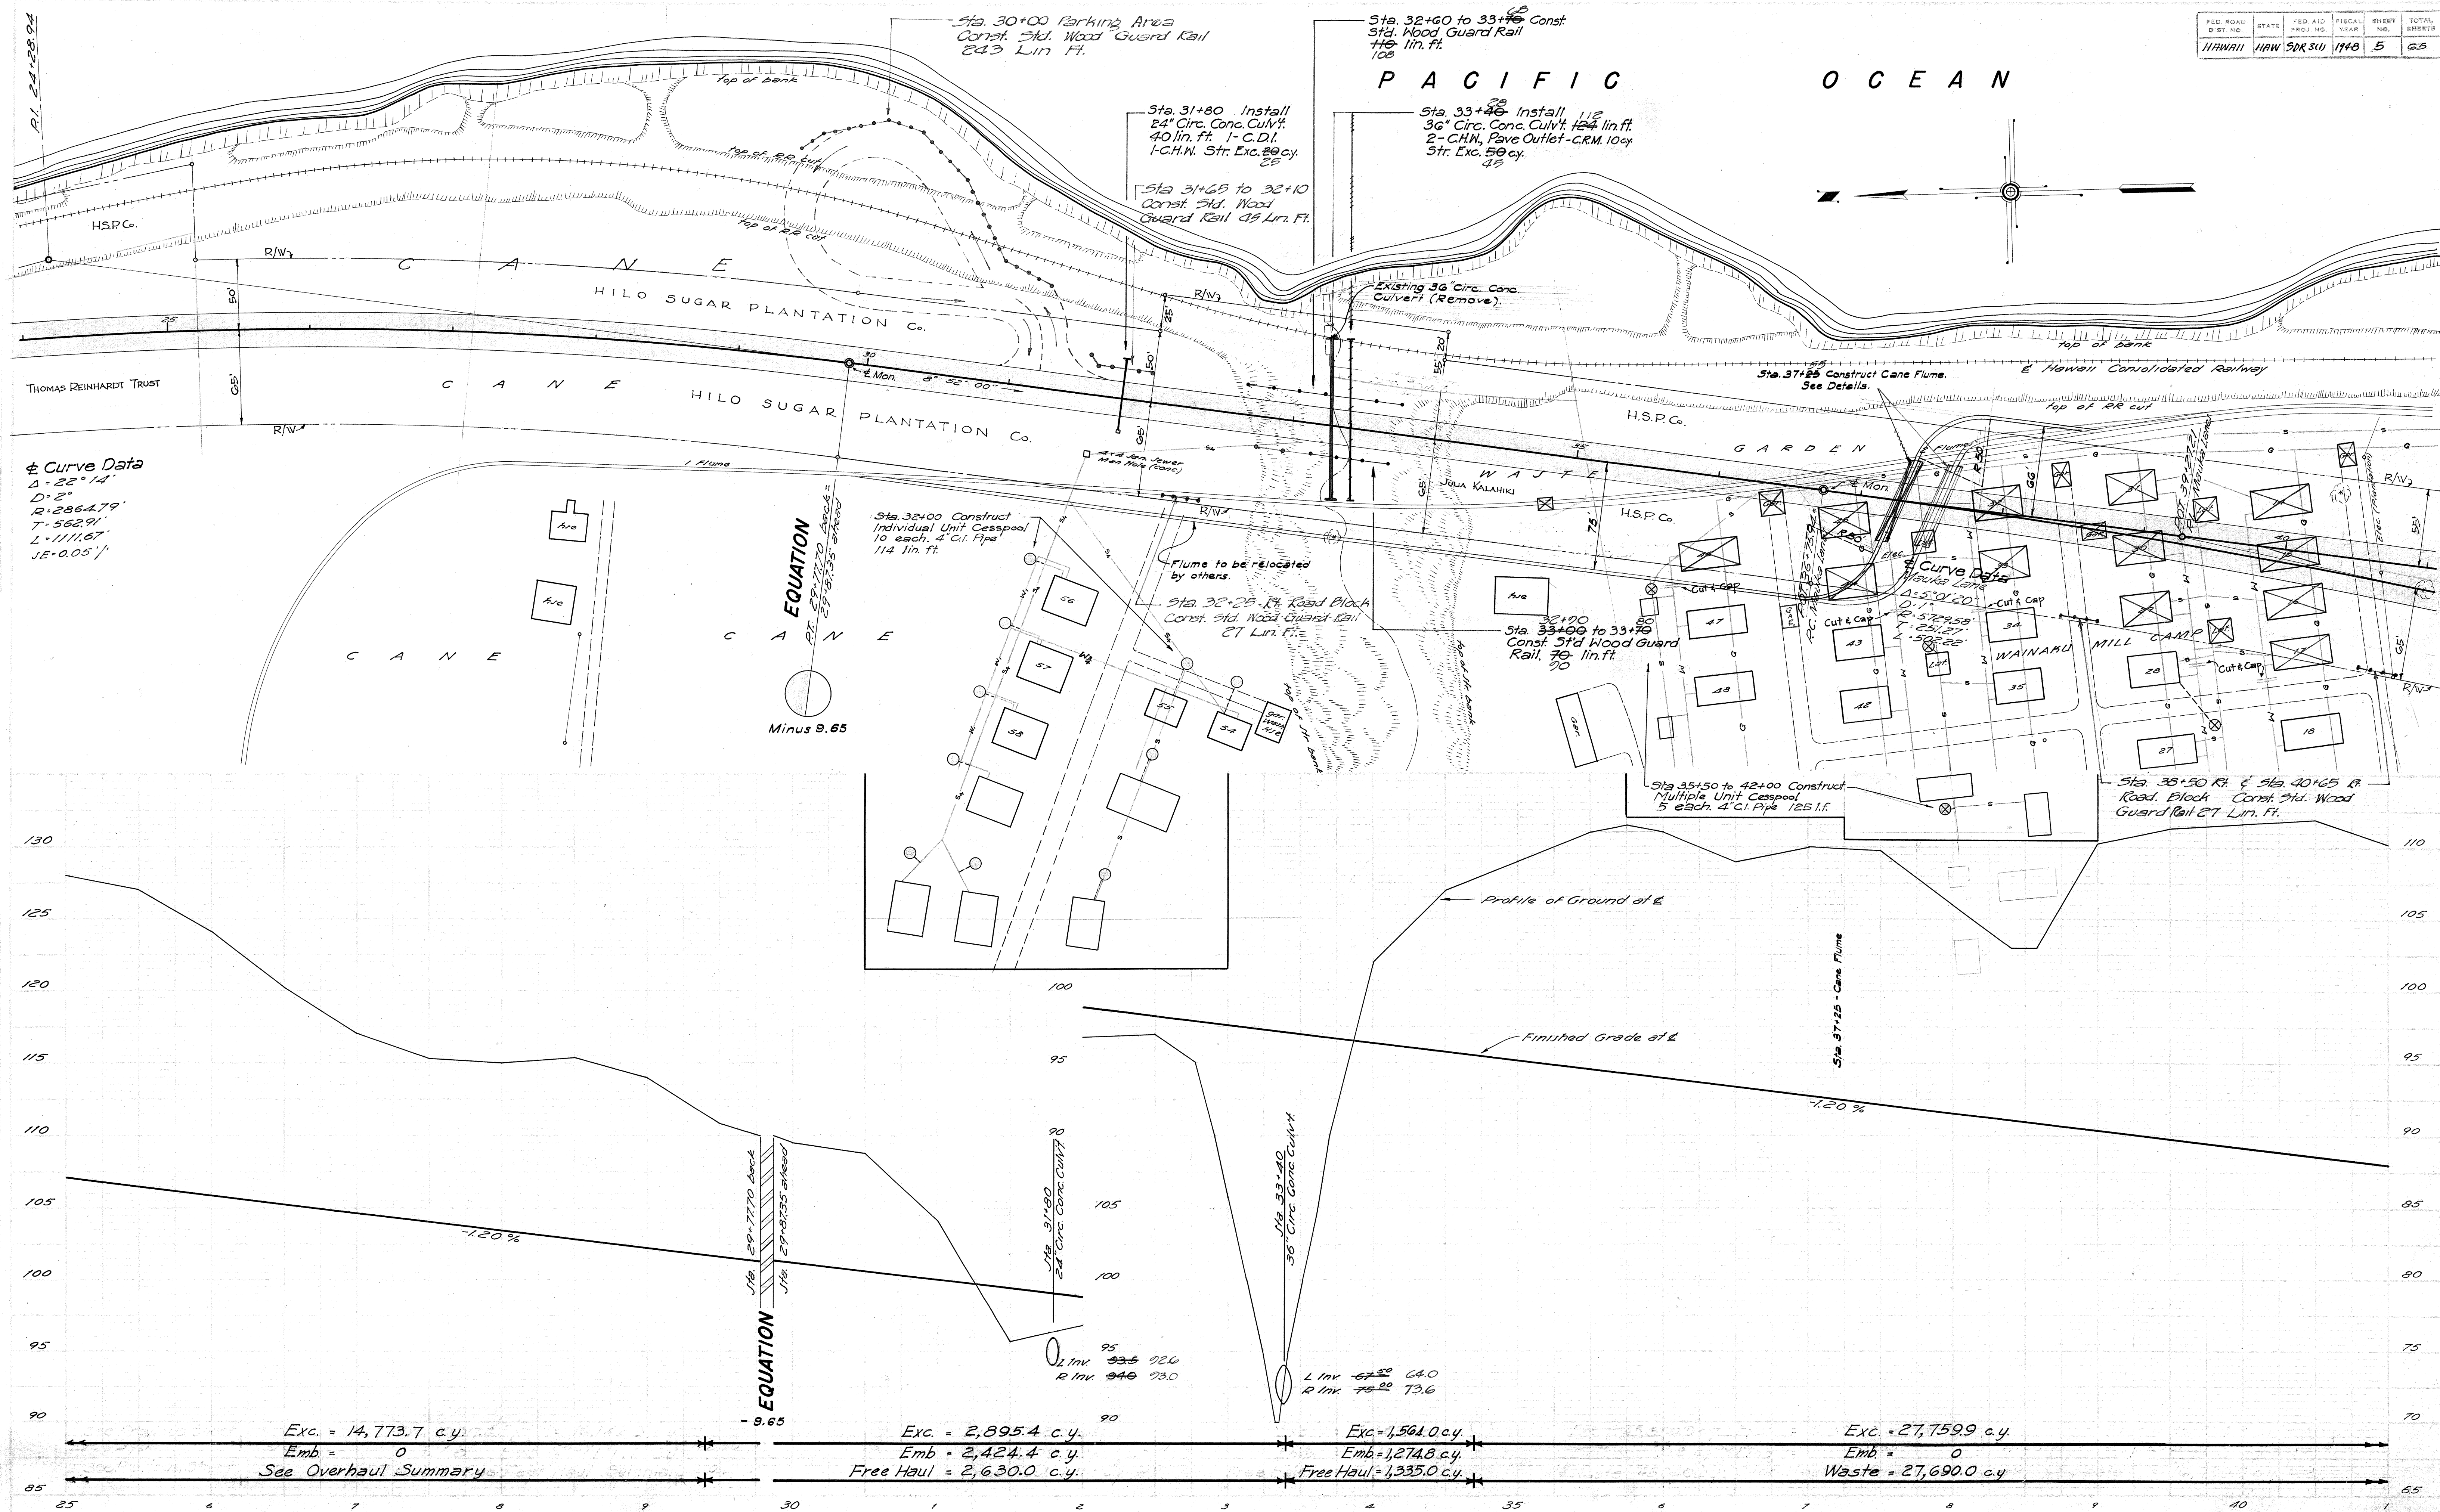


5333.5



FED. ROAD DIST. NO.	STATE	FED. AID PROJ. NO.	FISCAL YEAR	SHEET NO.	TOTAL SHEETS
Hawaii	Haw.	SDR 3(1)	1948	5A	65

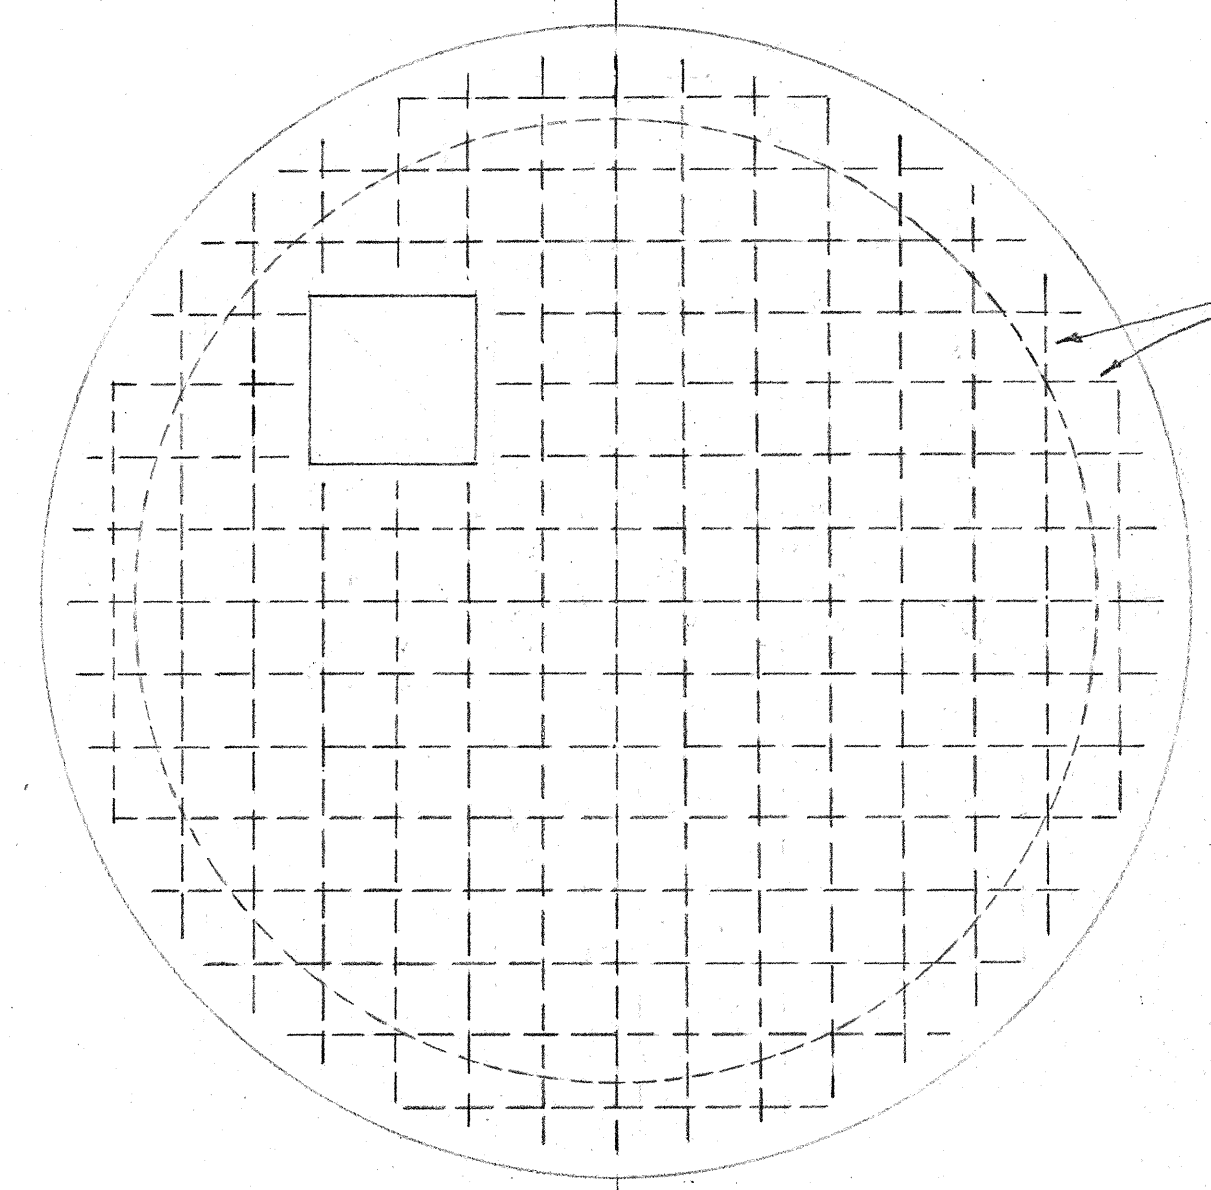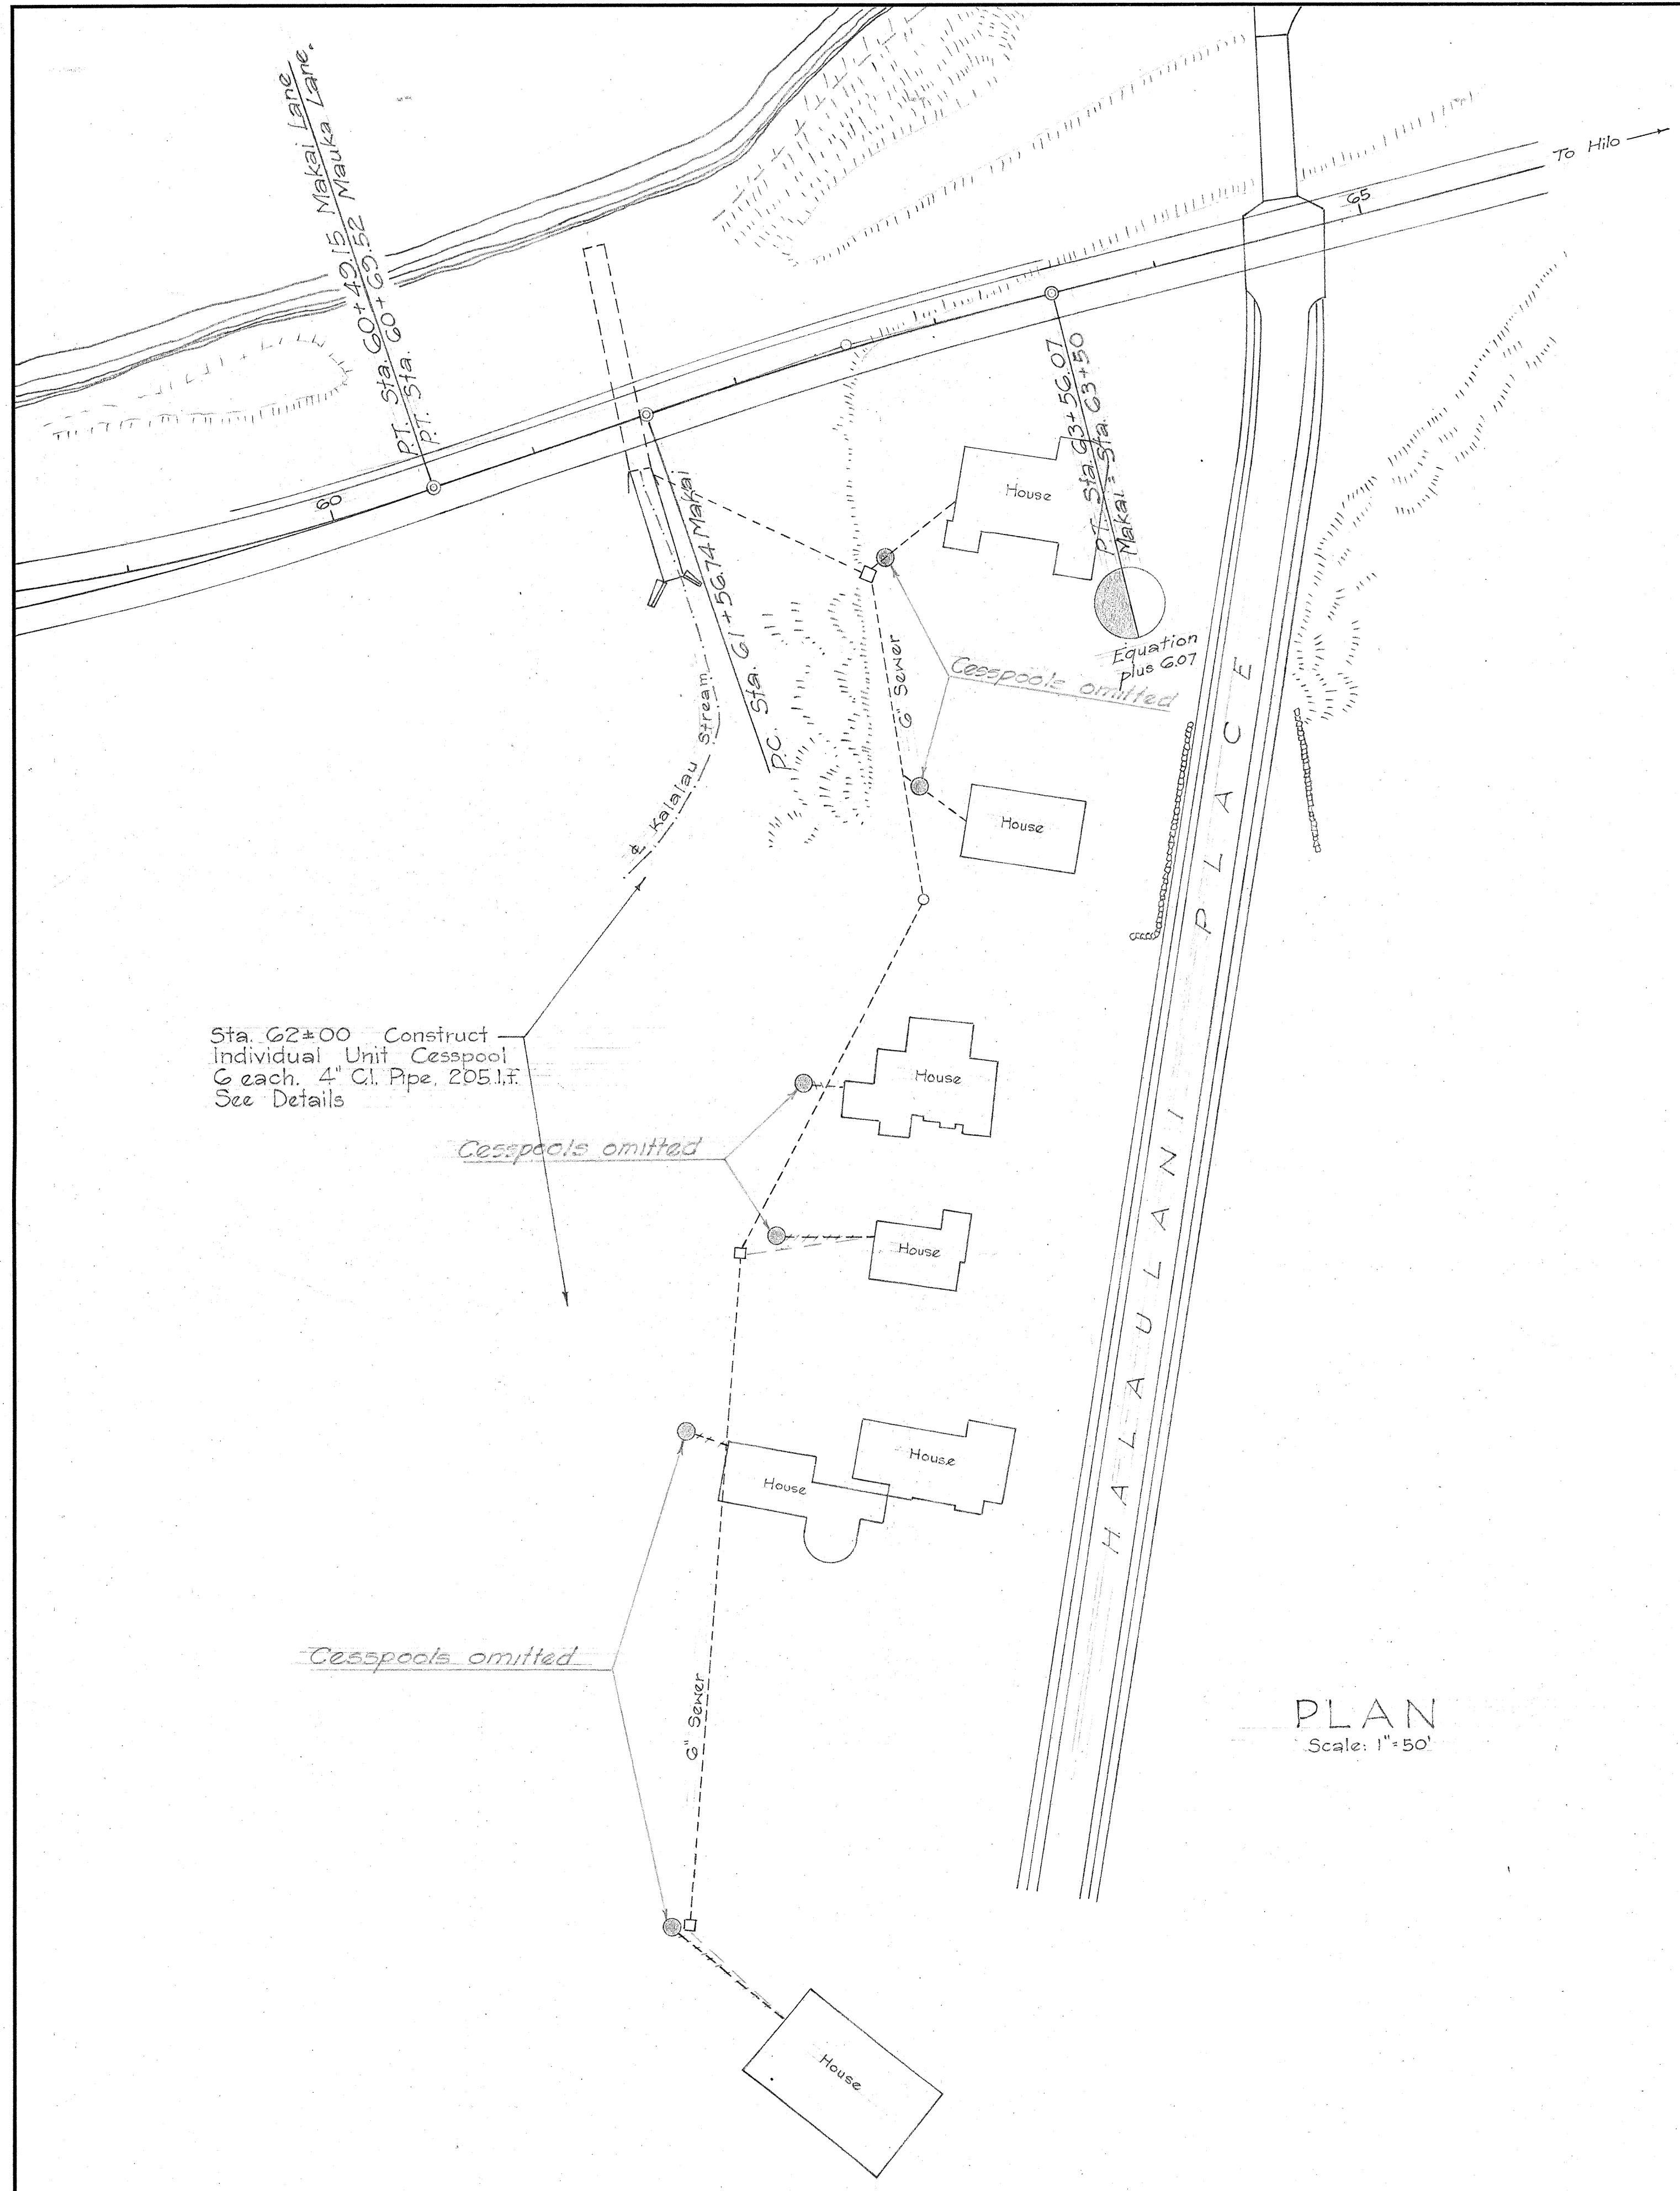

PLAN of SLAB REINFORCING

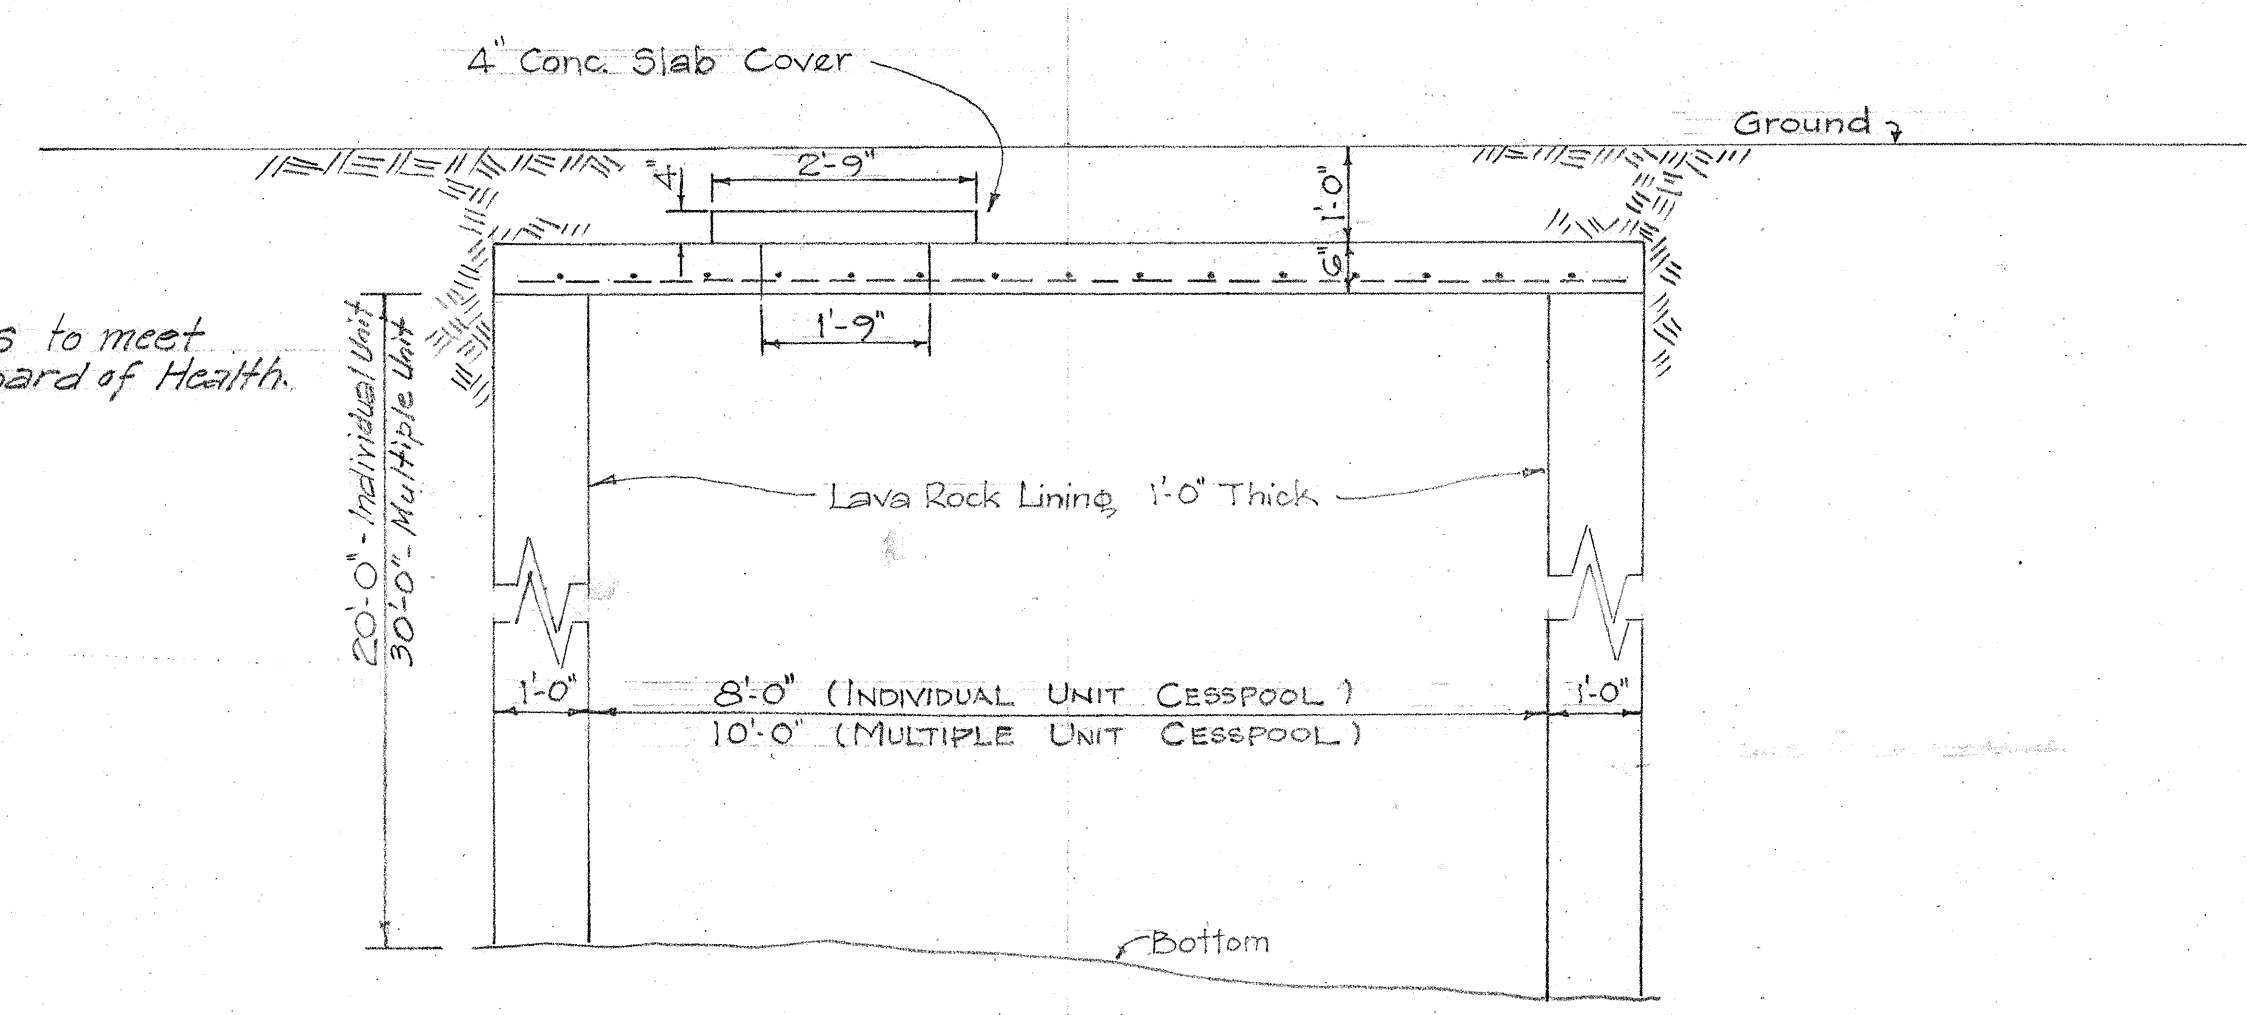

SECTION

CESSPOOL DETAILS
Scale: 1/2" = 1'-0"

TERRITORIAL HIGHWAY DEPARTMENT
TERRITORY OF HAWAII
CESSPOOL LOCATION & DETAILS
Hawaii Belt Road SDR 3(1)
Nov. 1948

SHEET No. OF SHEETS

5333.SA

ORIGINAL PLAN	DESIGNED BY	DATE
NOTE BOOK	TRACED BY	
No.	QUANTITIES BY	
	CHECKED BY	

5333.8B