


FED. ROAD DIST. NO.	STATE	FED. AID PROJ. NO.	FISCAL YEAR	SHEET NO.	TOTAL SHEETS
HAW	HAW	SDR 30	1948	9	65

DATE	BY	FINAL SURVEY	NOTES
		PLOTTED	NO.
		TEMPLATE	
		AREAS CHECKED	

DATE	BY	ORIGINAL SURVEY	NOTES
		PLOTTED	NO.
		TEMPLATE	
		AREAS CHECKED	

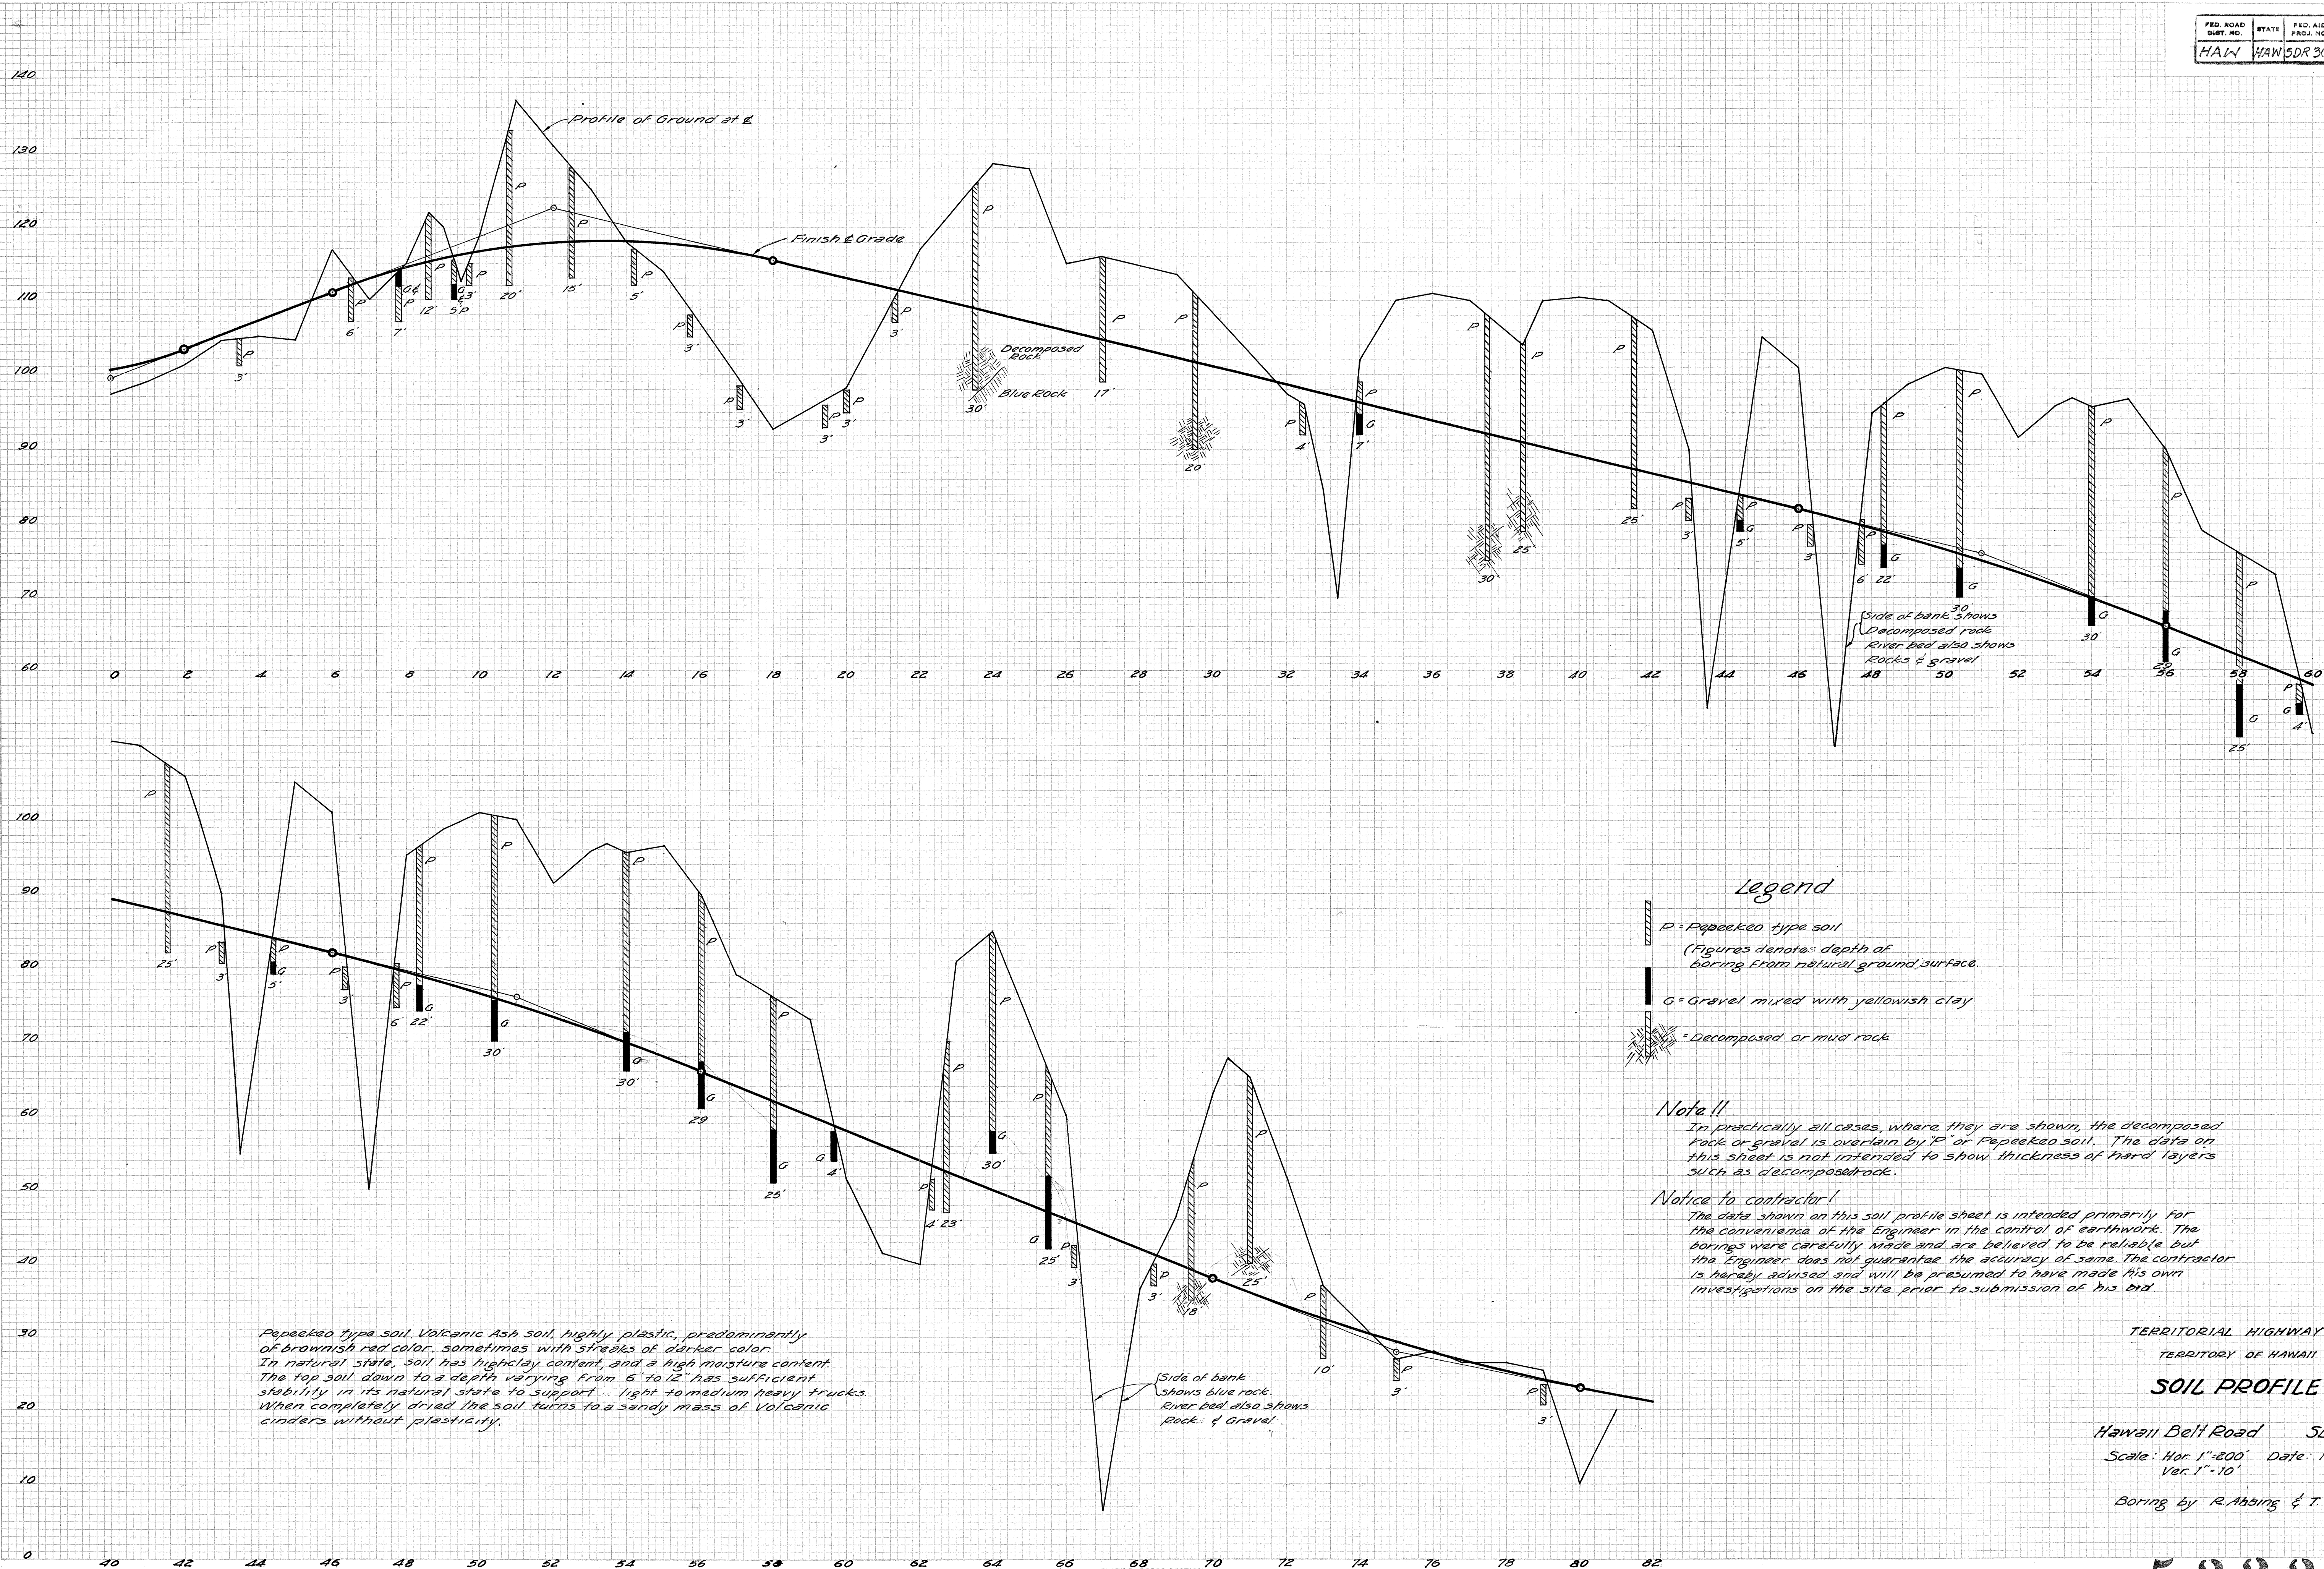

5333.9