

INDEX TO DRAWINGS	
SHEET	DESCRIPTION
1	TITLE SHEET
2	PLAN AND PROFILE
3-22	BRIDGE DETAILS
23	CROSS SECTIONS

TERRITORY OF HAWAII

TERRITORIAL HIGHWAY DEPARTMENT

HONOLULU T.H.

PLANS OF

HAWAII BELT ROAD

(WAILUKU RIVER BRIDGE)

SEISMIC WAVE DAMAGE REHABILITATION

PROJECT NO. SDR 3 (8)

DISTRICT OF SOUTH HILO

ISLAND OF HAWAII

PLAN

SCALE

1 INCH = 50 FT.

PROFILE



HOR. 1 INCH = 50 FT.

VER. 1 INCH = 5 FT.

X-SECTION

HOR. 1 INCH = 10 FT.

VER. 1 INCH = 5 FT.

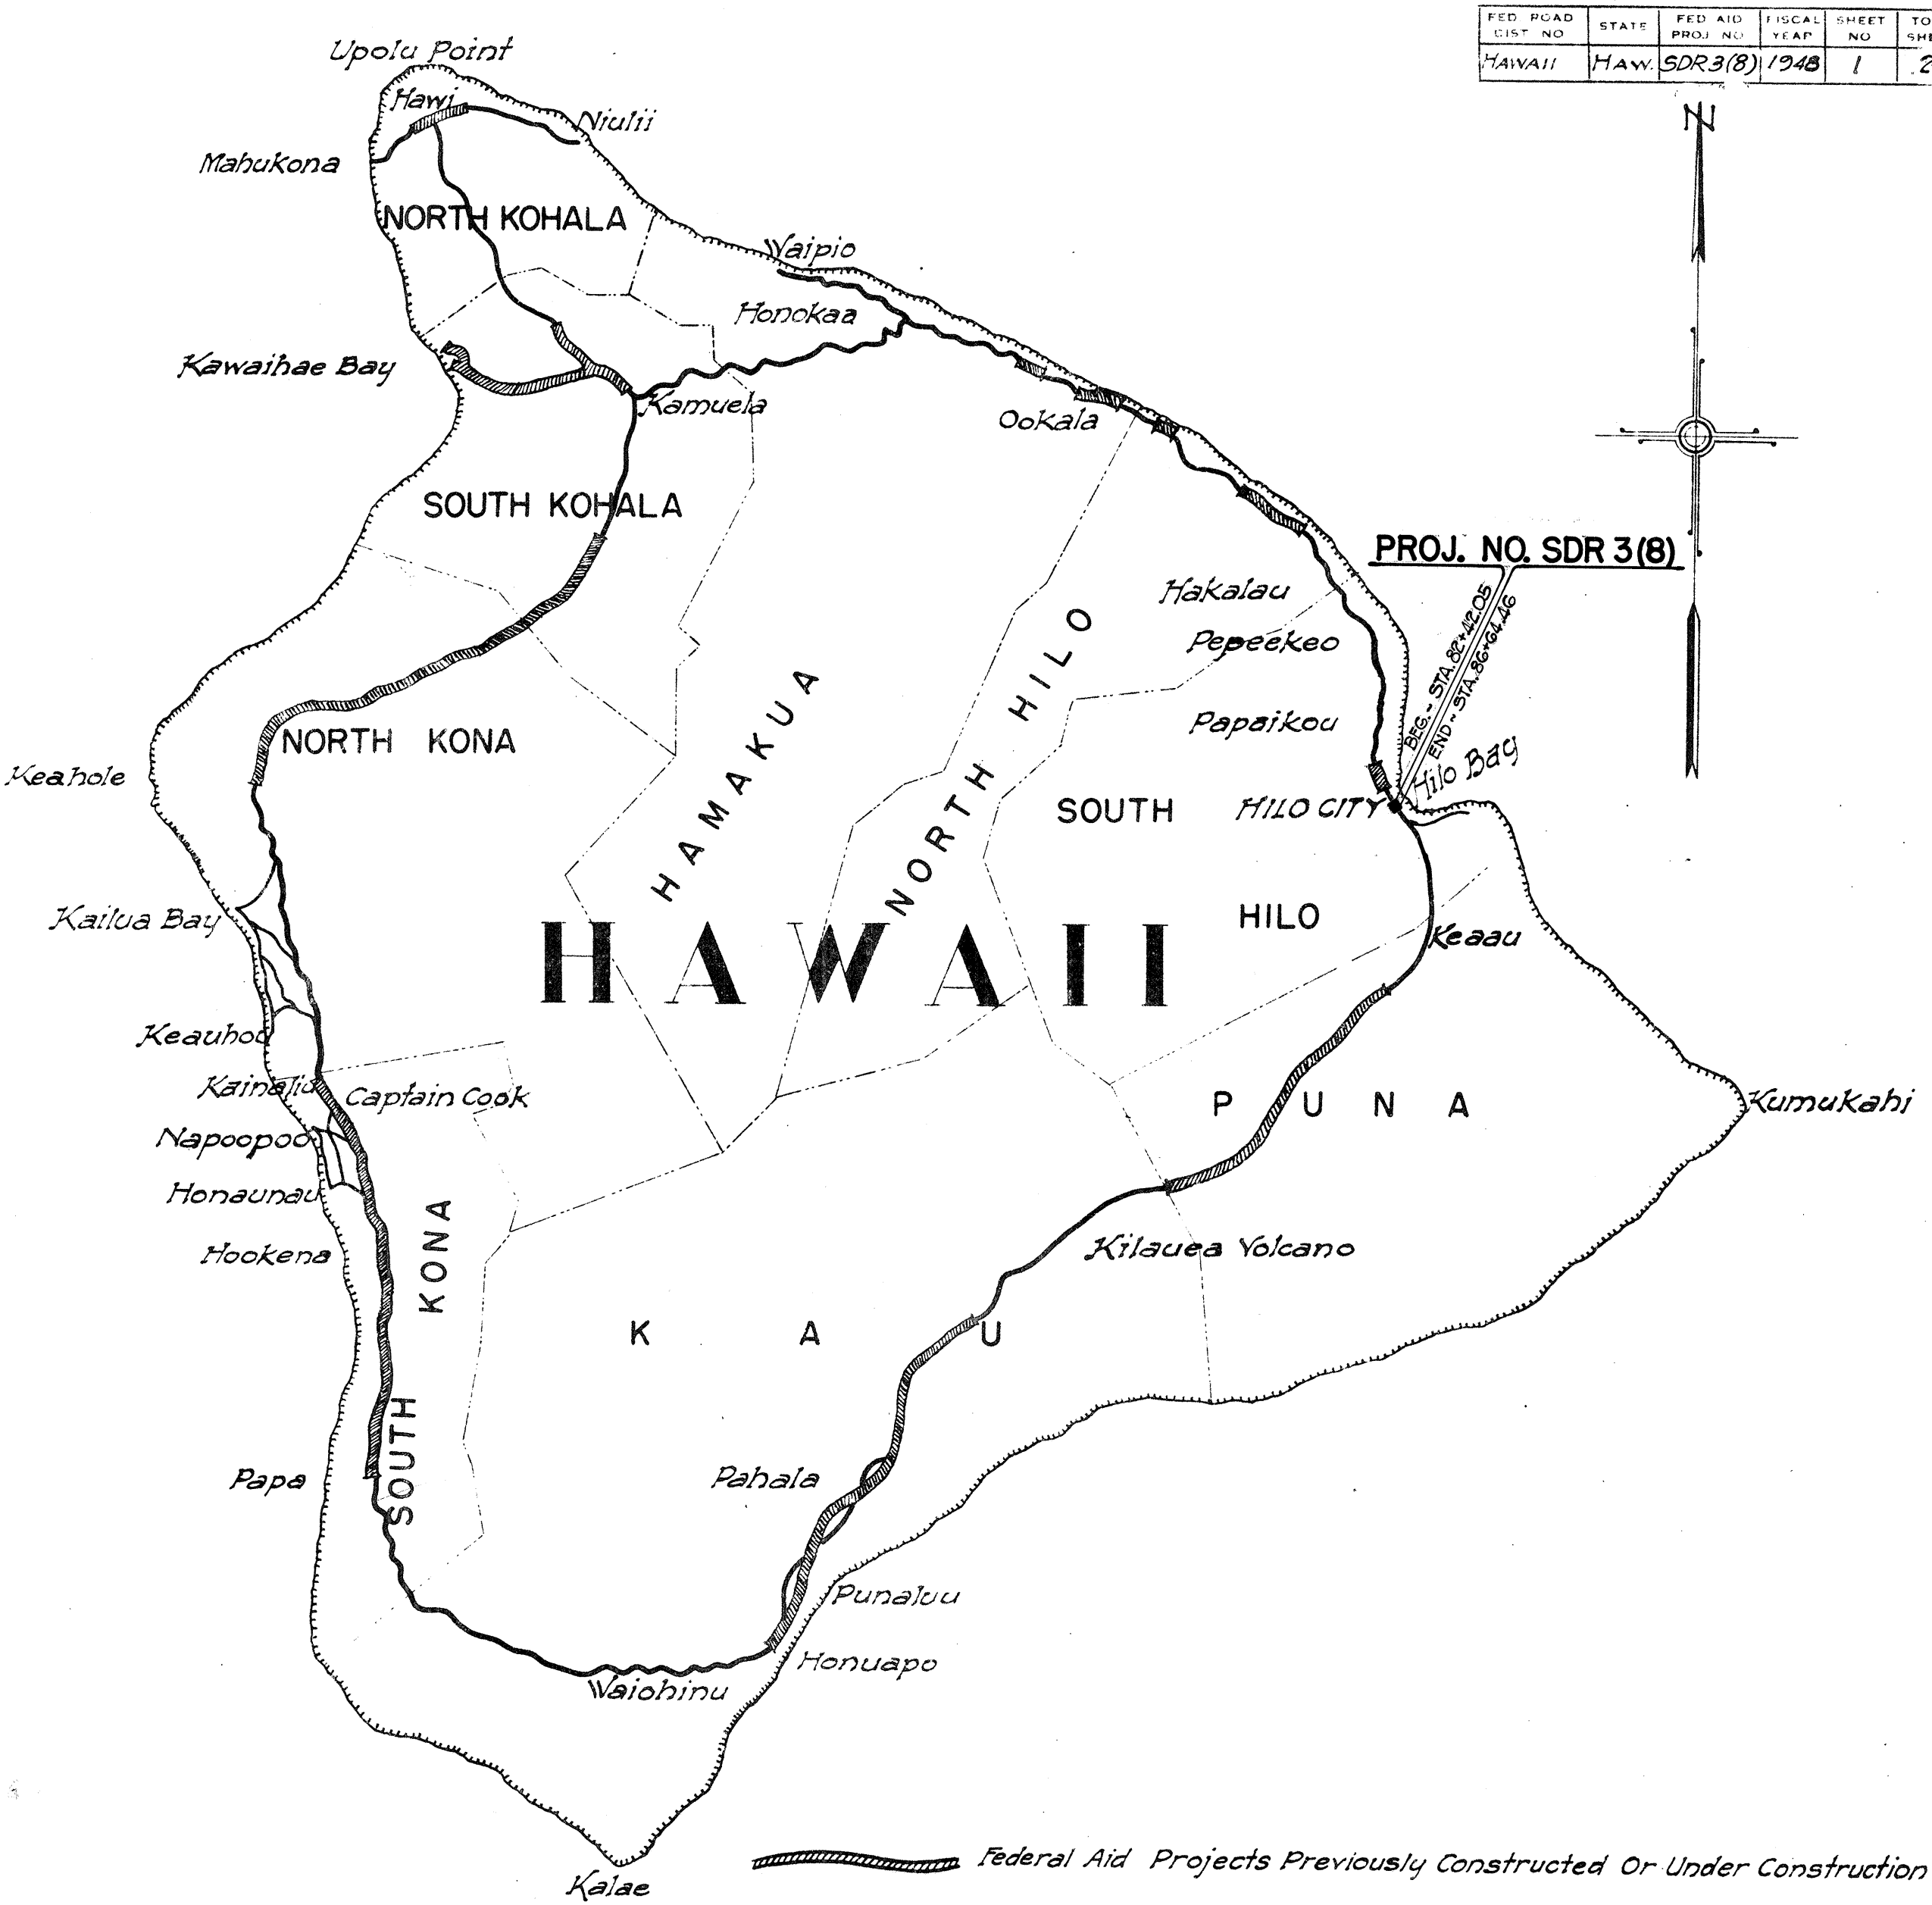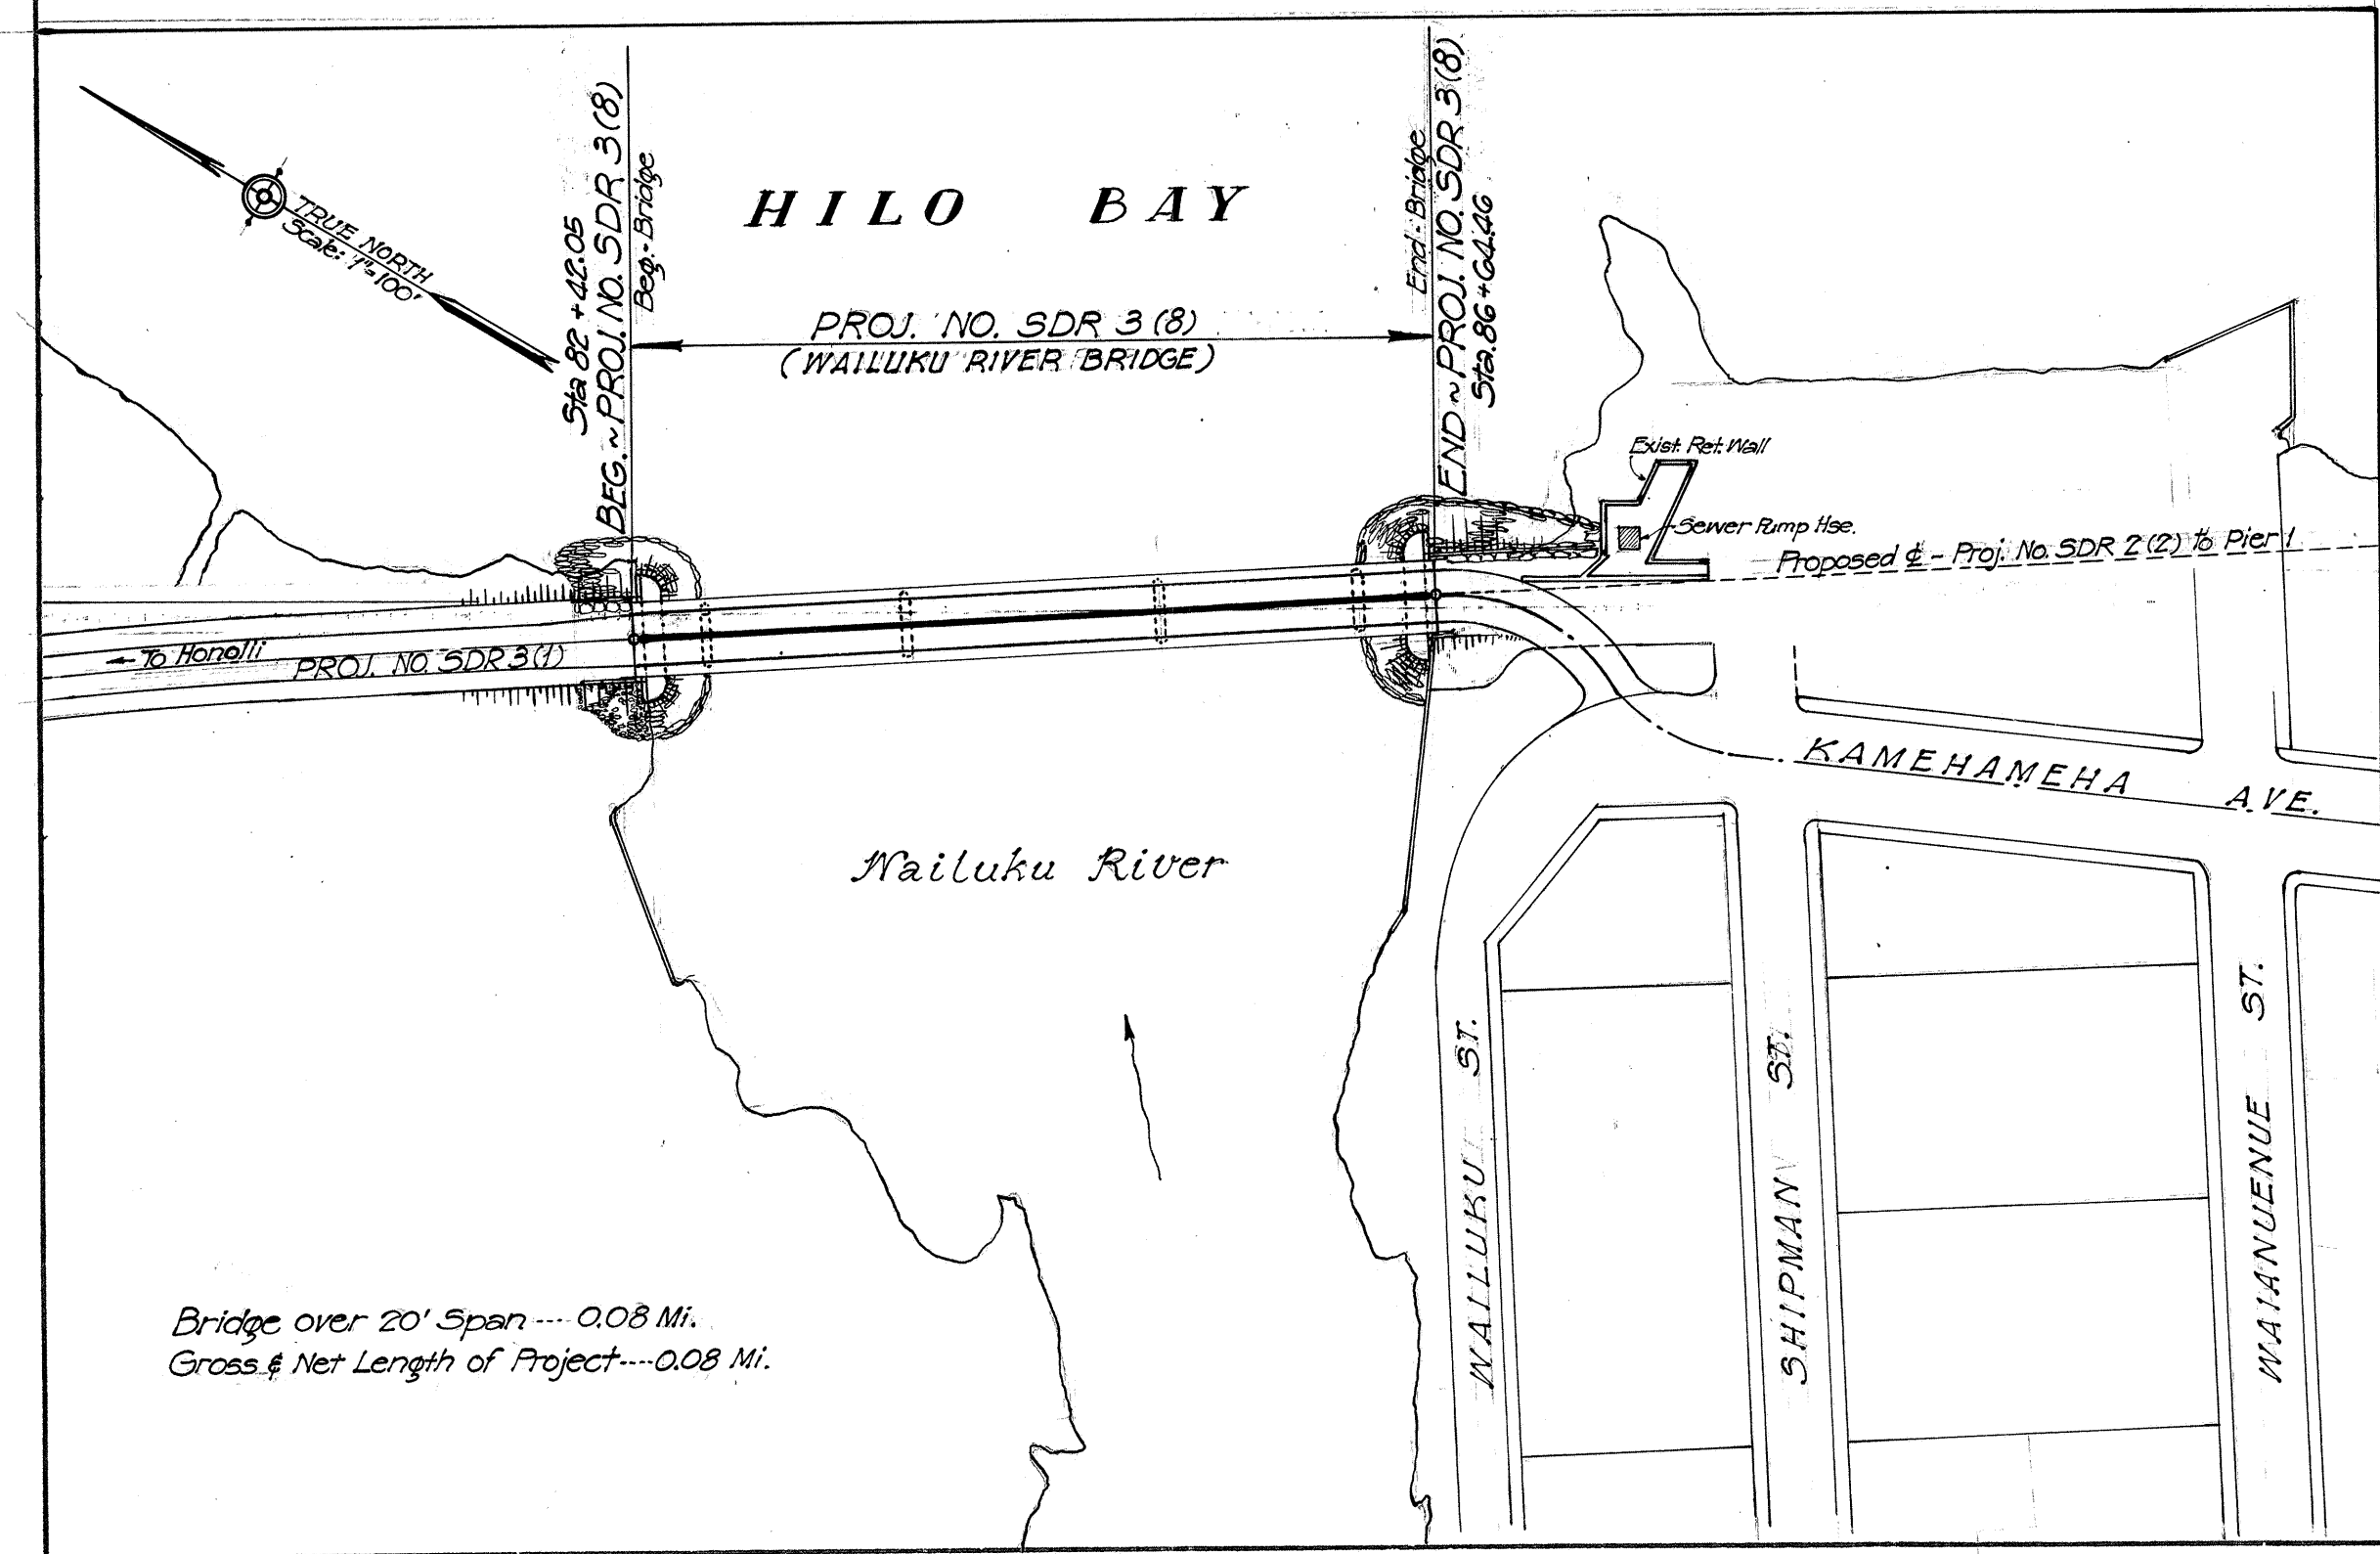

NOTE:

ALL CHANGES MADE DURING CONSTRUCTION

HAVE BEEN NOTED IN RED ON THESE

TRACINGS AND CHECKED BY:

[Signature]

RESIDENT ENGINEER

May 9 1957

DATE

RECOMMENDED FOR APPROVAL: DATE:

DISTRICT ENGINEER

PUBLIC ROADS ADMINISTRATION

FEDERAL WORKS AGENCY

APPROVED: DATE: 12-28-48

[Signature]

TERRITORIAL HIGHWAY ENGINEER

APPROVED: DATE:

DIVISION ENGINEER

PUBLIC ROADS ADMINISTRATION

FEDERAL WORKS AGENCY