


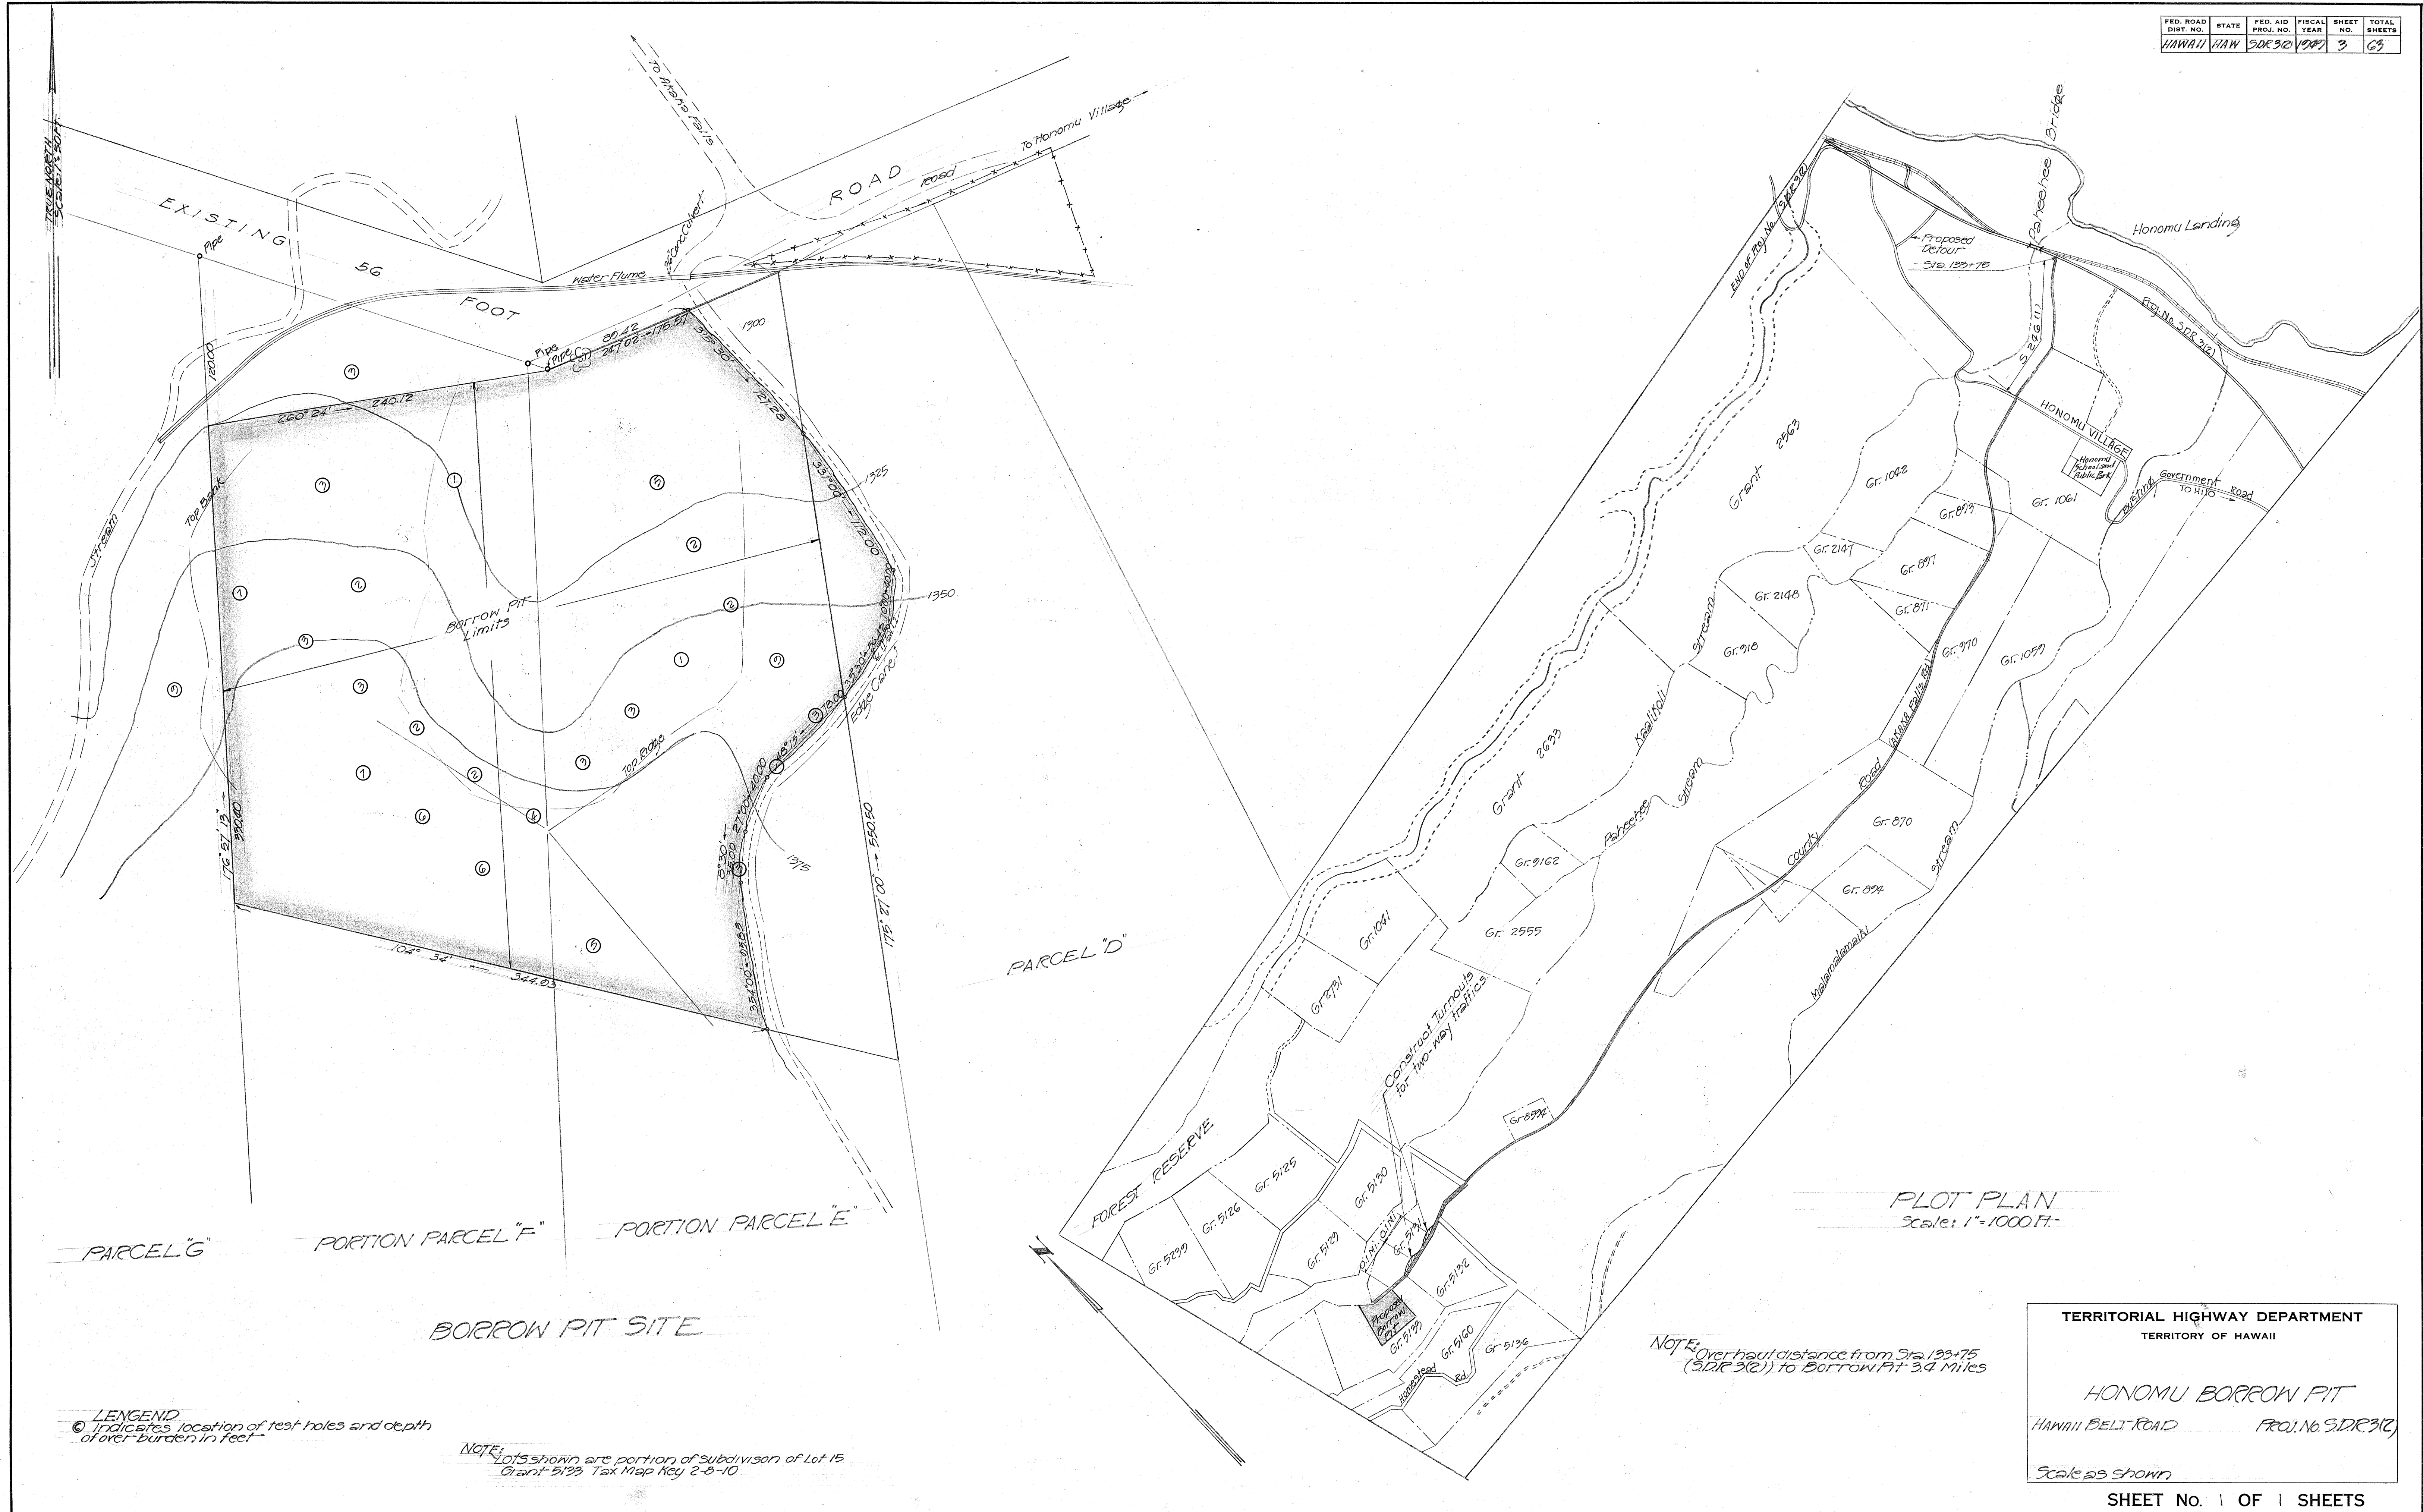

SURVEY PLOTTED BY	DATE
DESIGNED BY	
DRAWN BY	
QUANTITIES CHECKED BY	
CHECKED BY	
ORIGINAL PLAN	
NOTE BOOK	
NO.	

LEGEND
 (C) indicates location of test holes and depth of over-burden in feet.

NOTE: Lots shown are portion of subdivision of Lot 15 Grant 5139 Tax Map Key 2-6-10

PLOT PLAN
 Scale: 1"=1000 FT.

NOTE: Over haul distance from Sta 133+75 (S.D.R. 3(2)) to Borrow Pit 3.4 Miles

TERRITORIAL HIGHWAY DEPARTMENT
TERRITORY OF HAWAII

HONOLULU BORROW PIT
HAWAII BELT ROAD
Scale as shown

PROJ. No. 5DR312