

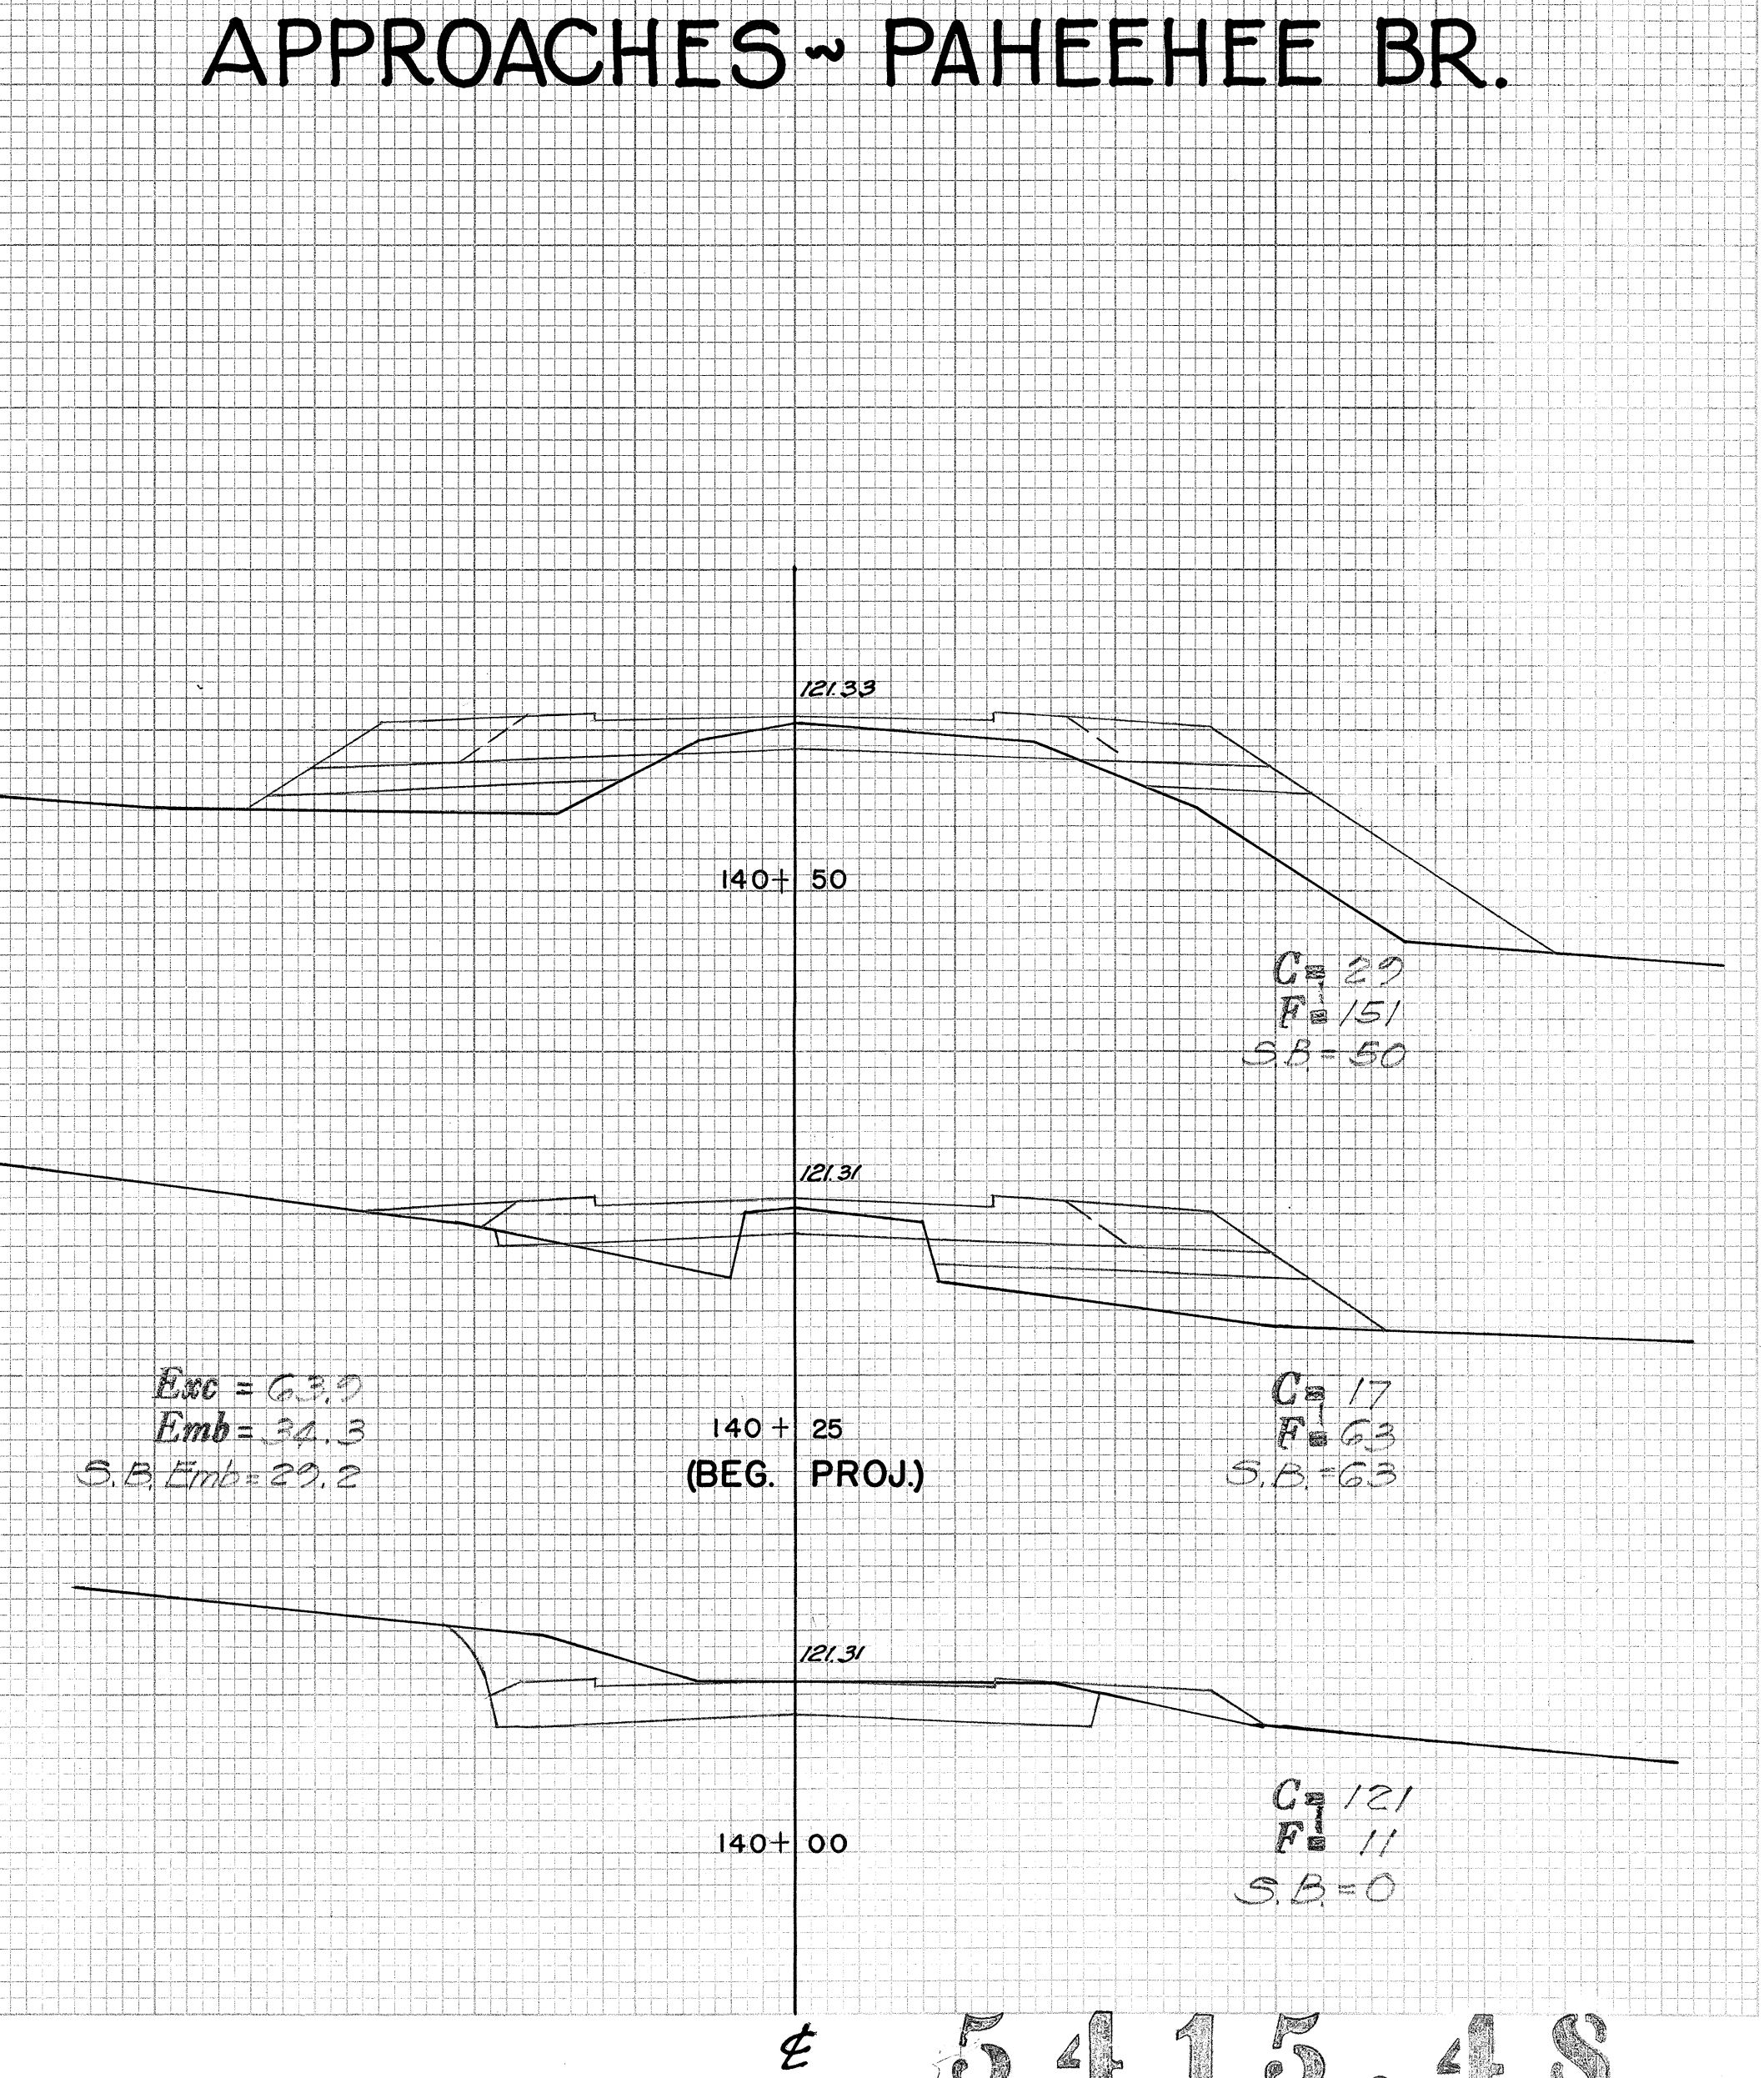


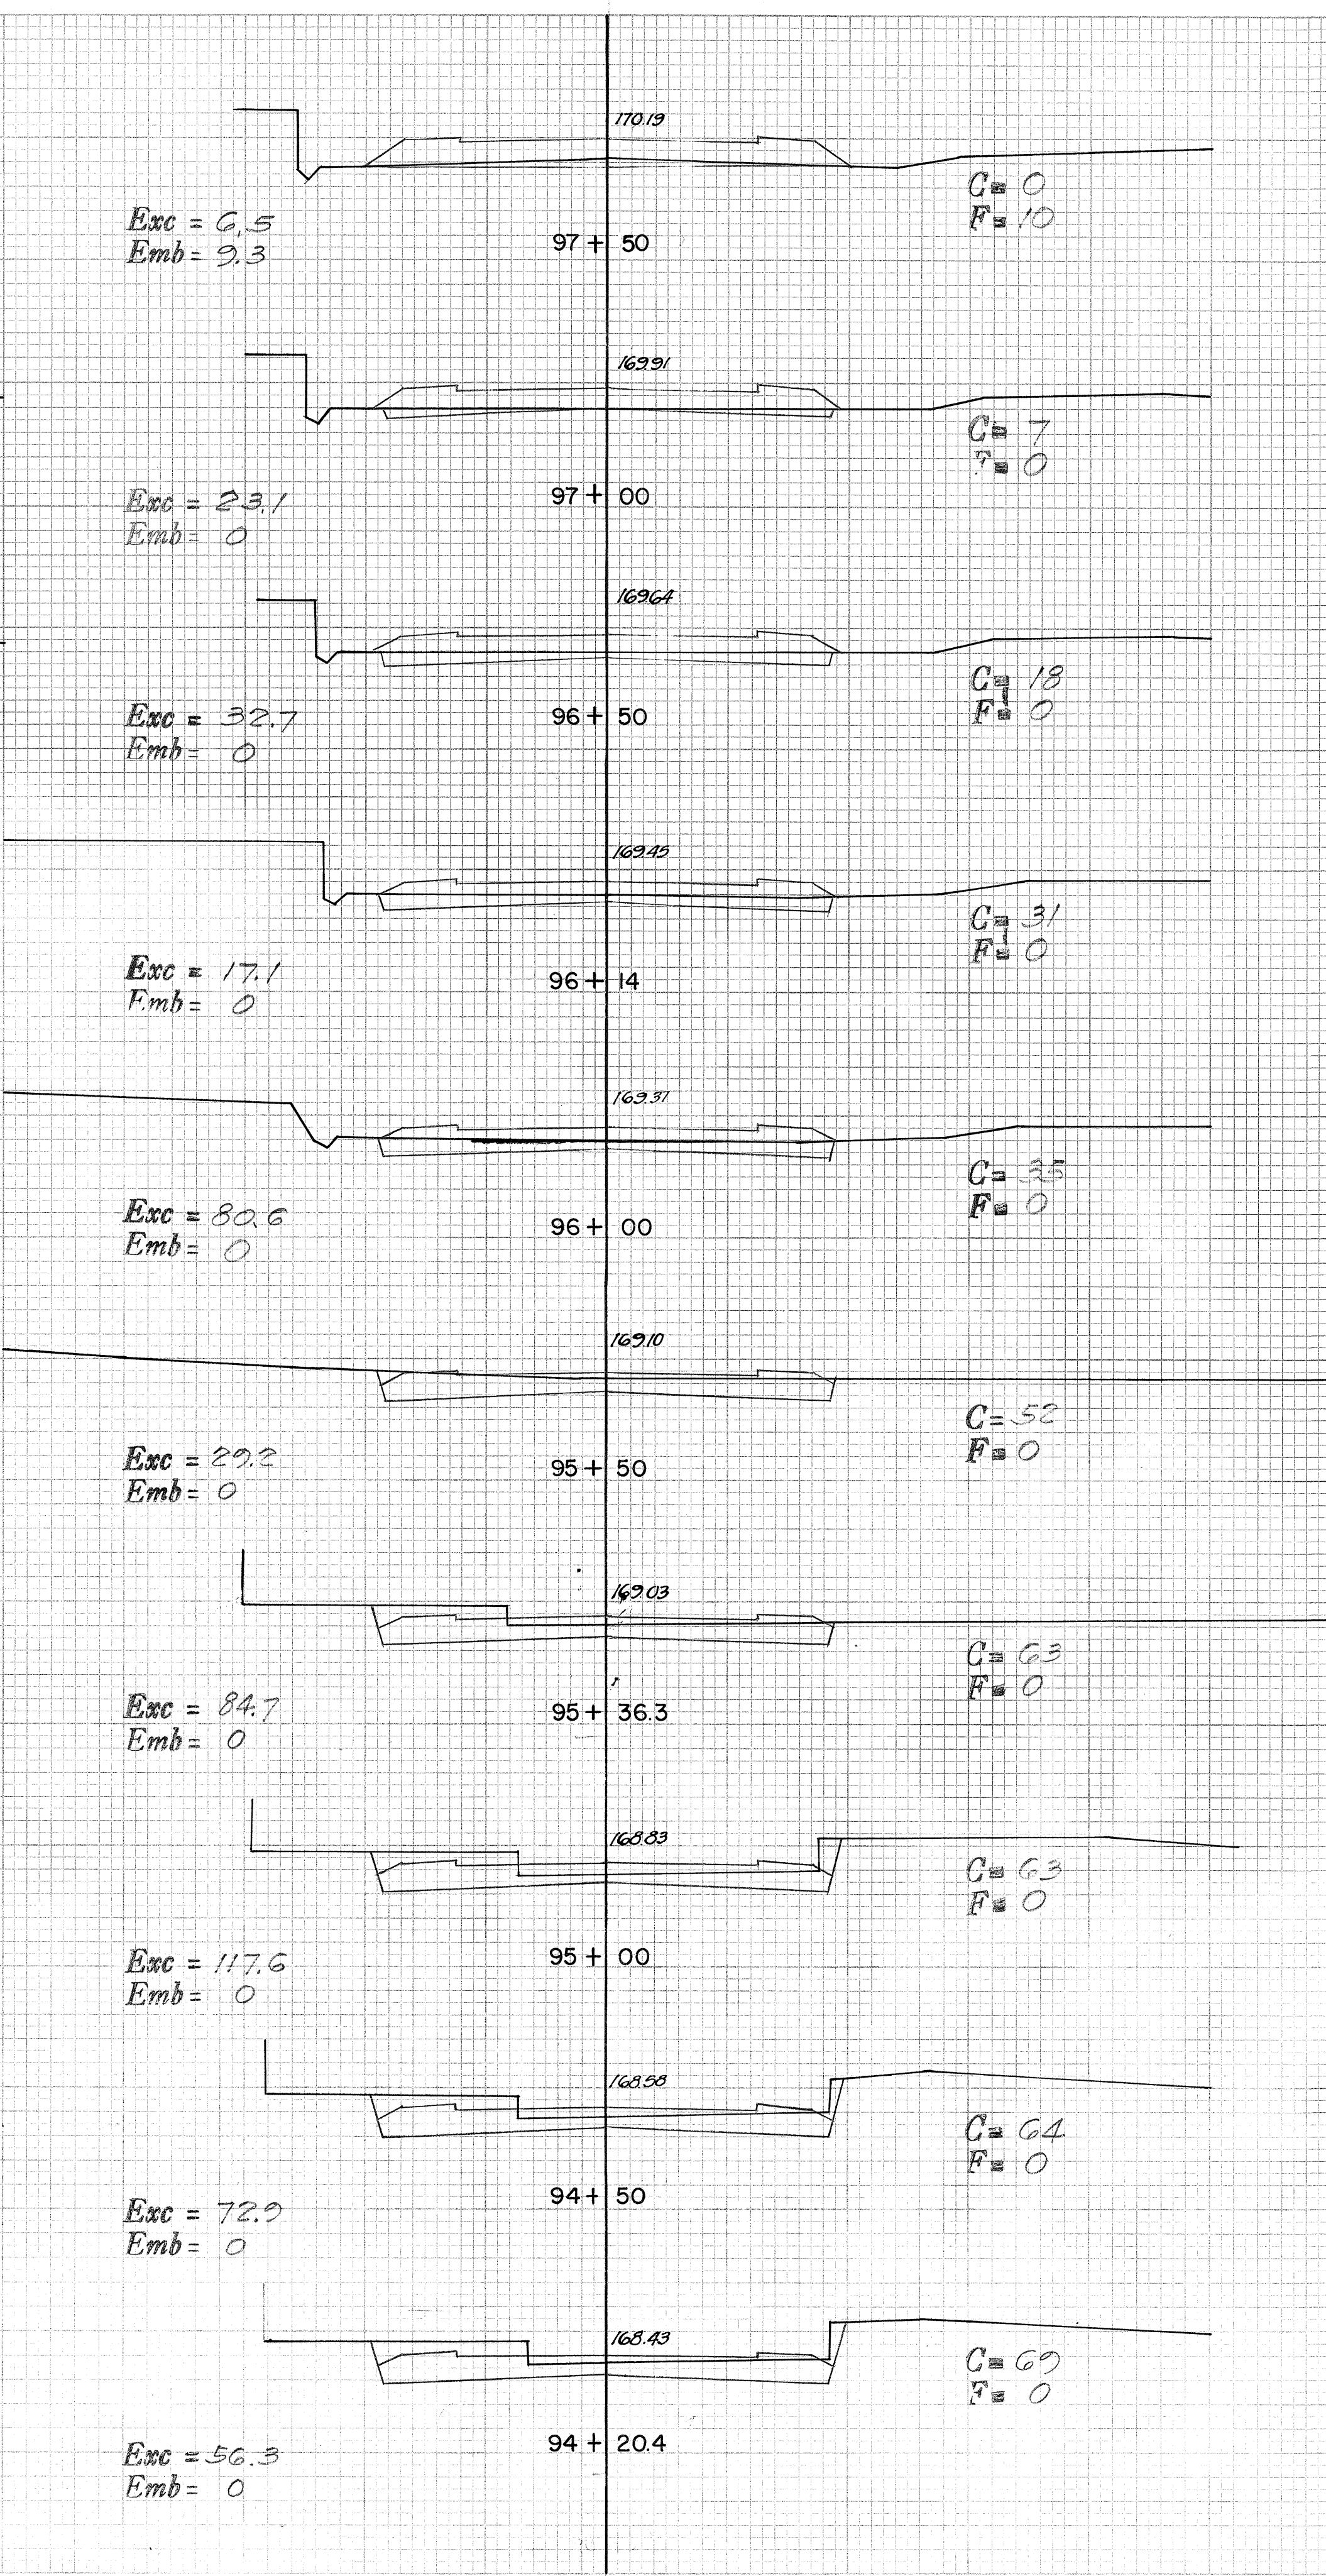

| FED. ROAD DIST. NO. | STATE  | FED. AID PROJ. NO. | FISCAL YEAR | SHEET NO. | TOTAL SHEETS |
|---------------------|--------|--------------------|-------------|-----------|--------------|
| HAWAII              | HAWAII | SDR 3(6) 1740      | 47          | 47        | 47           |
| 1ST UNIT            |        |                    |             |           |              |

FINAL SURVEY PLOTTED  
NOTE BOOK NO. 1740  
DATE 1/24/47  
BY [signature]  
AREAS CHECKED

ORIGINAL SURVEY PLOTTED  
NOTE BOOK NO. 1740  
DATE 1/24/47  
BY [signature]  
AREAS CHECKED

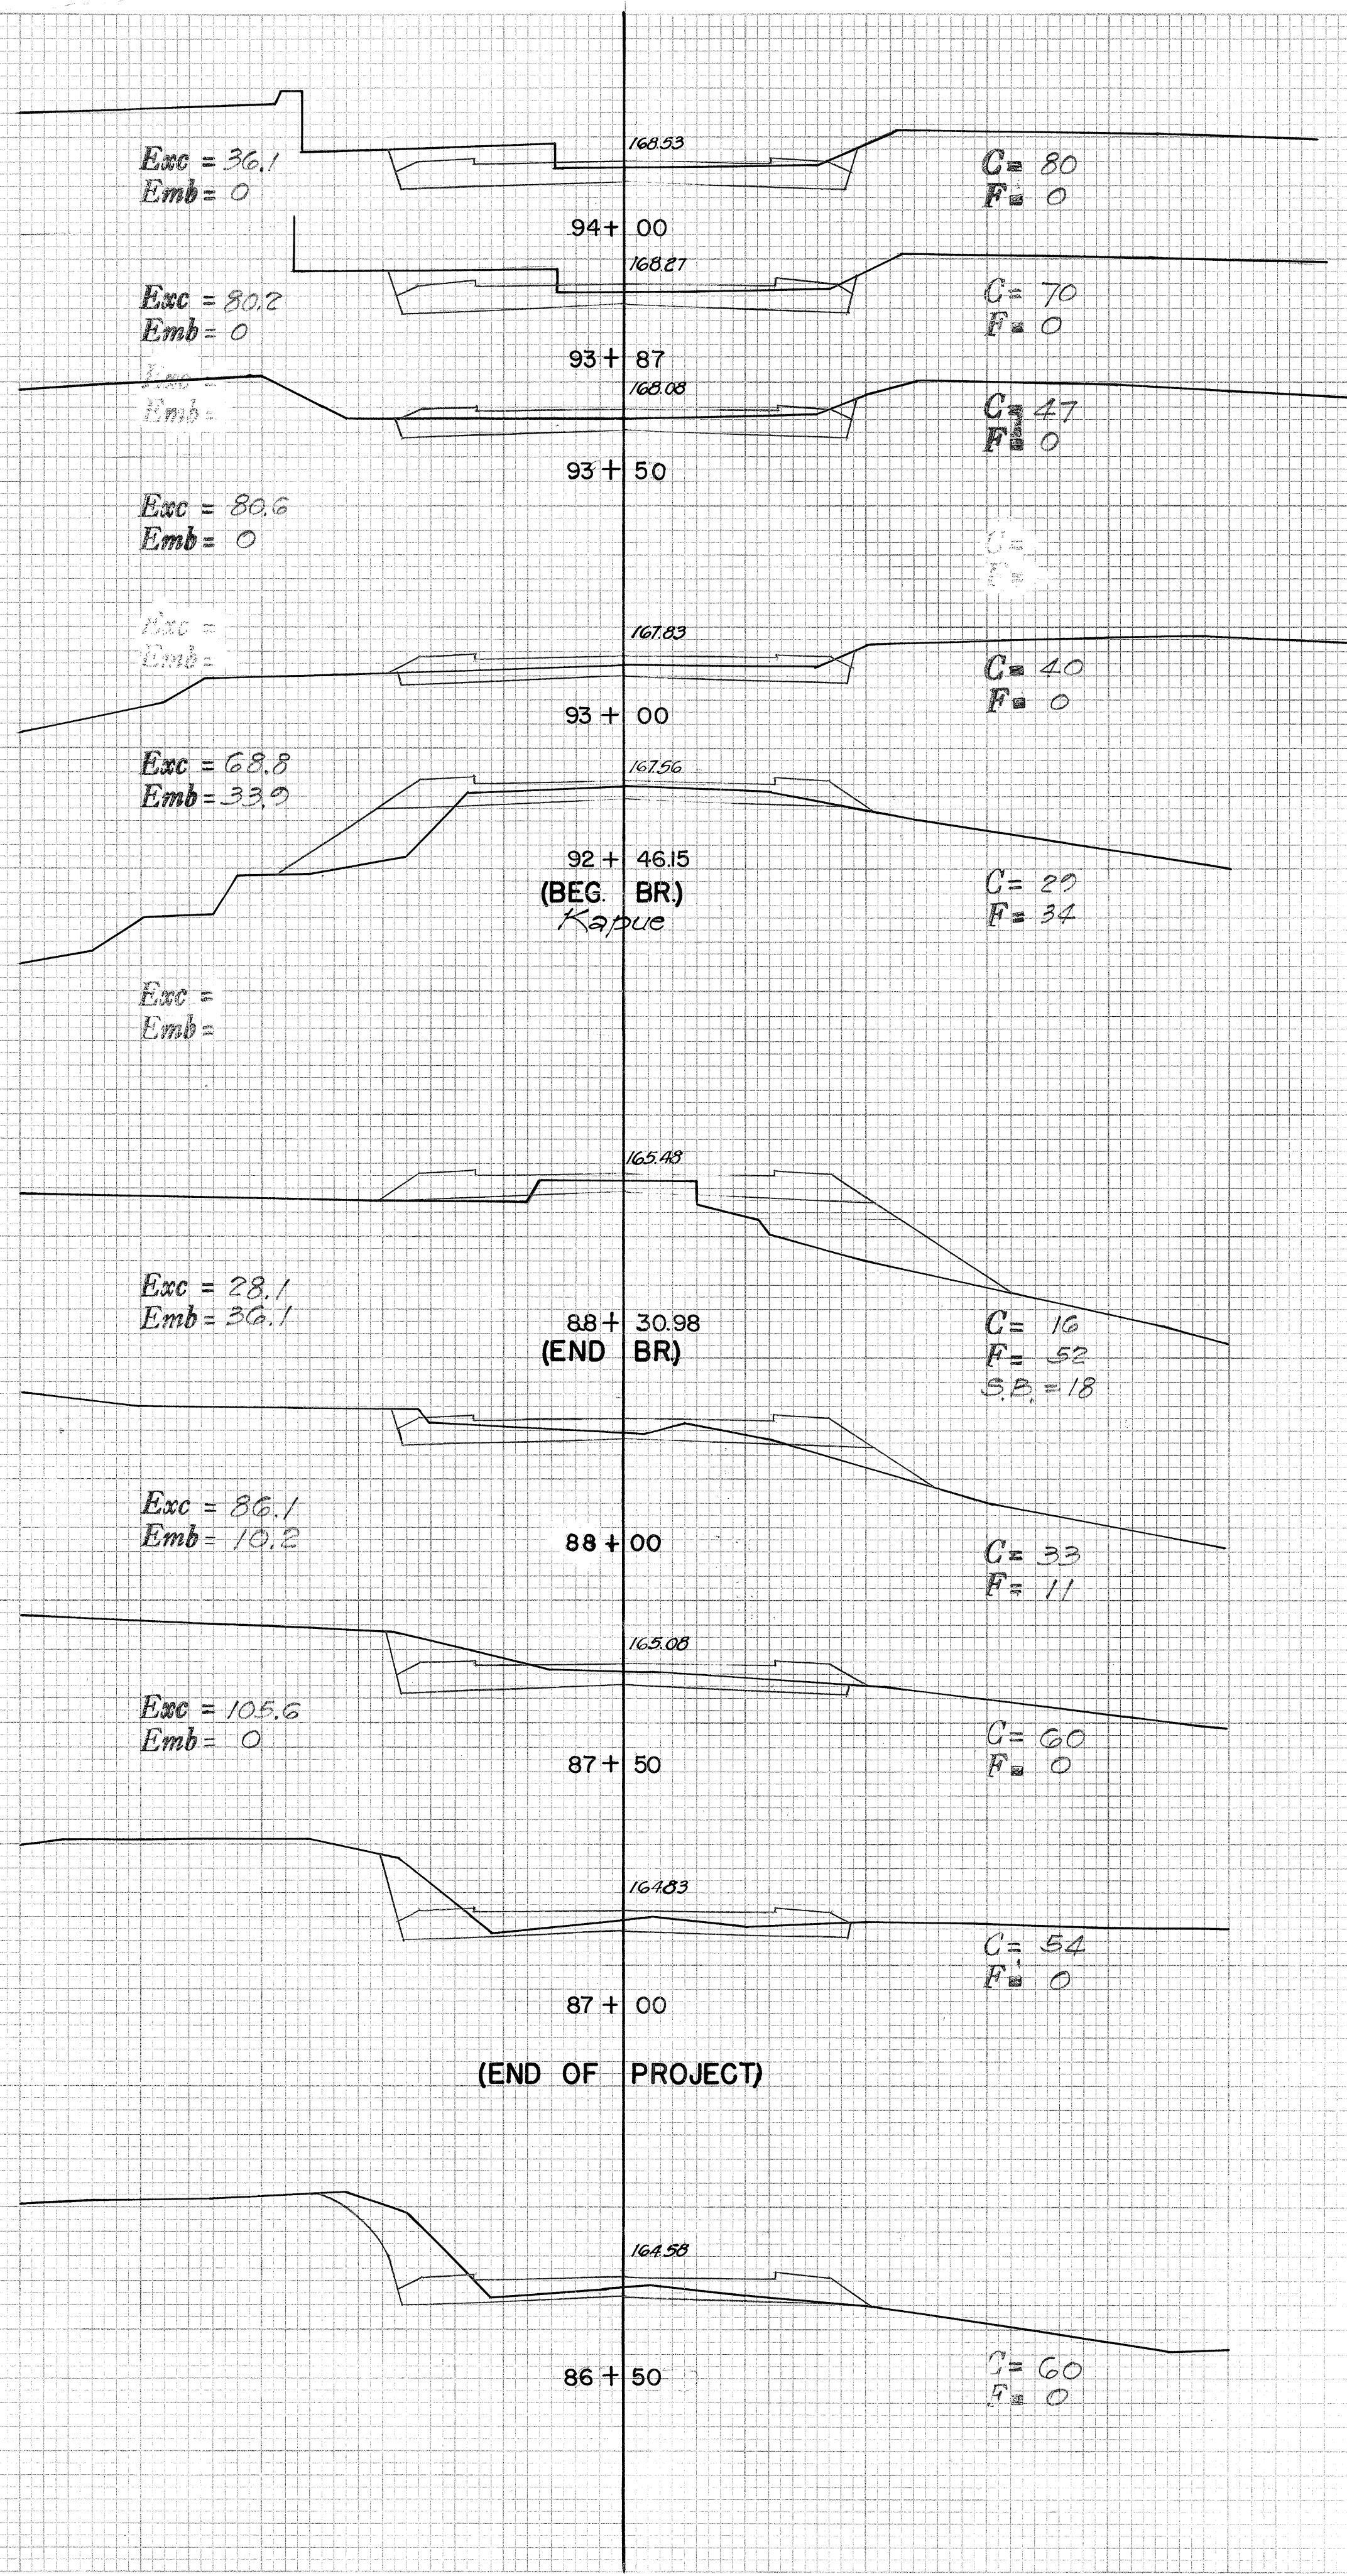

APPROACHES ~ KAPUE BR.

