

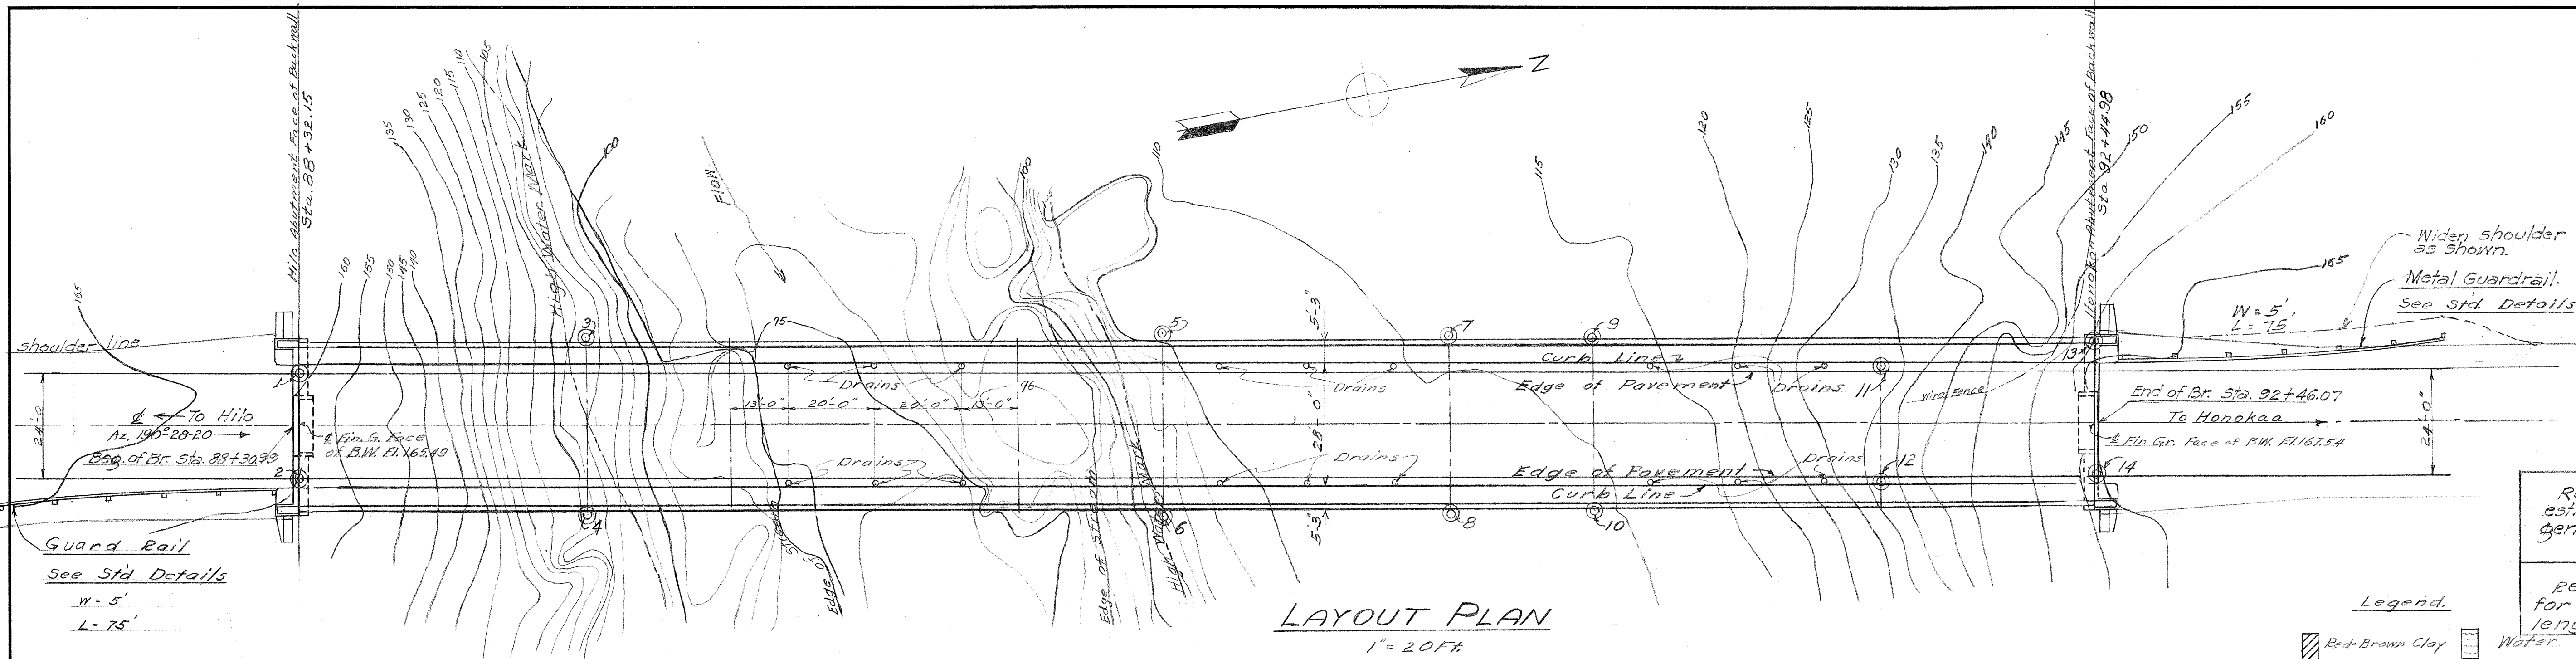
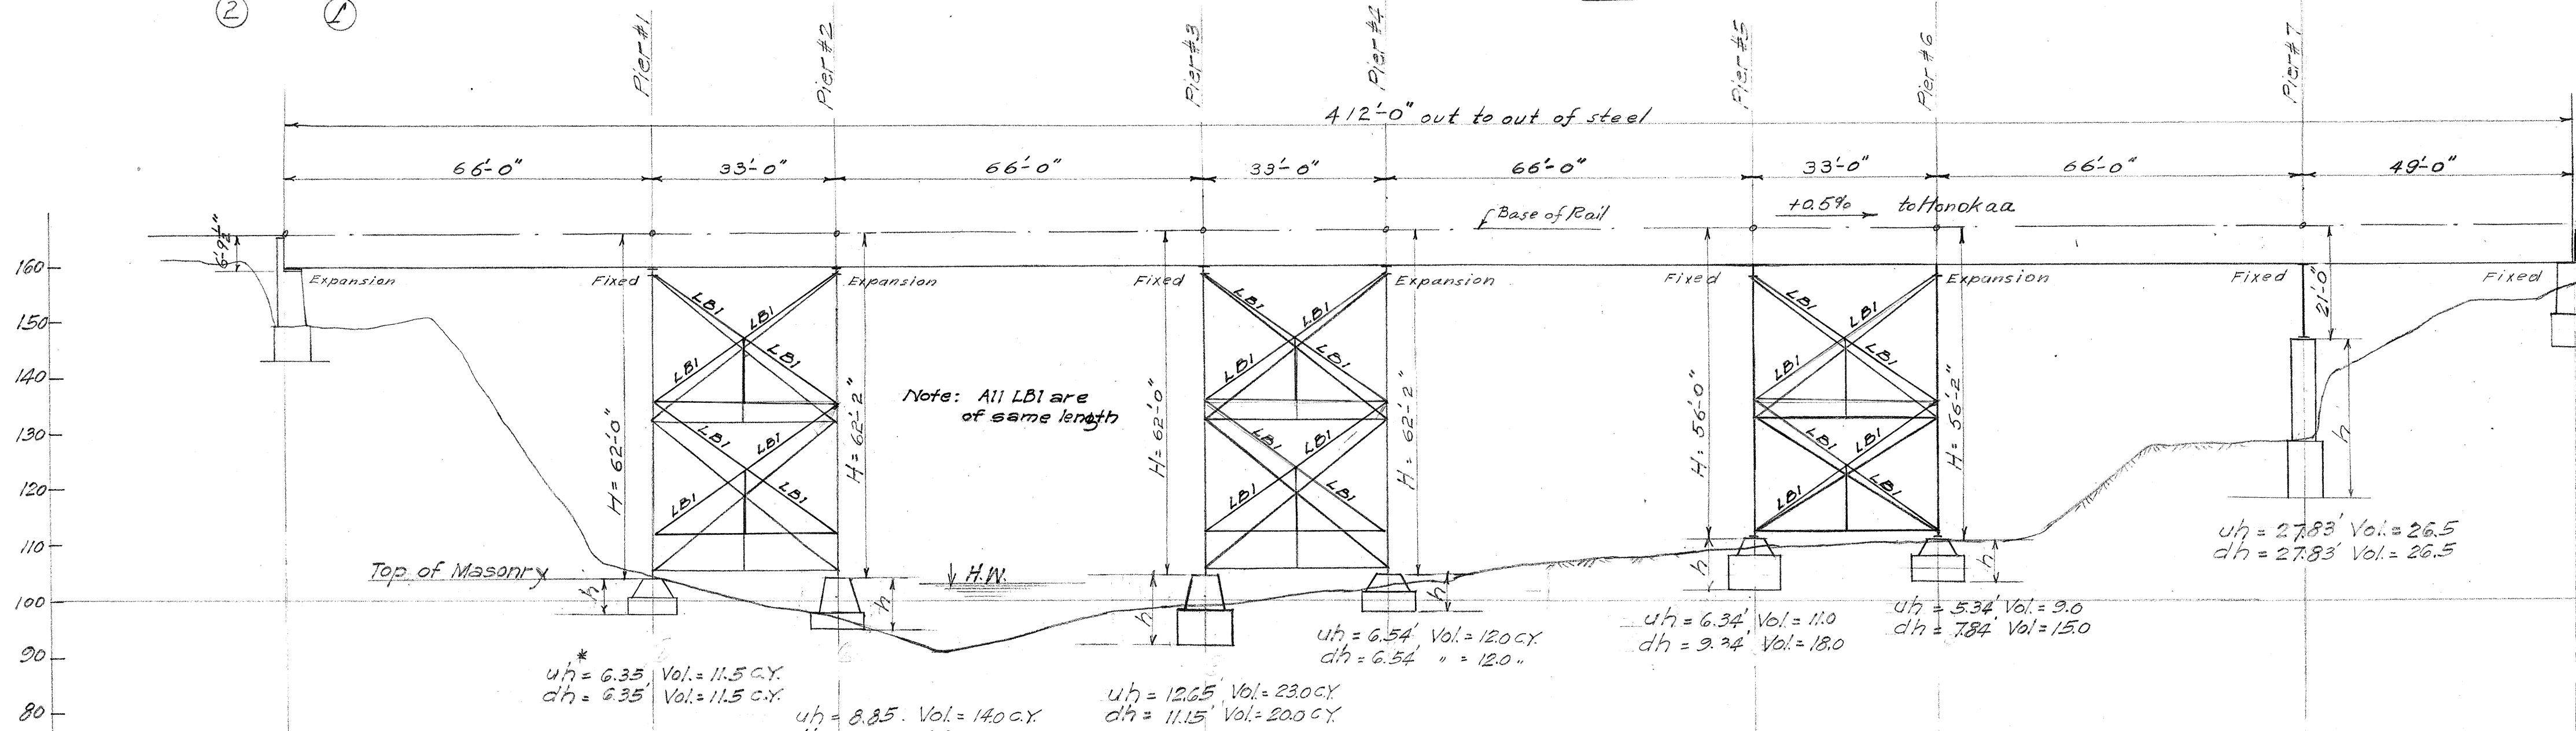
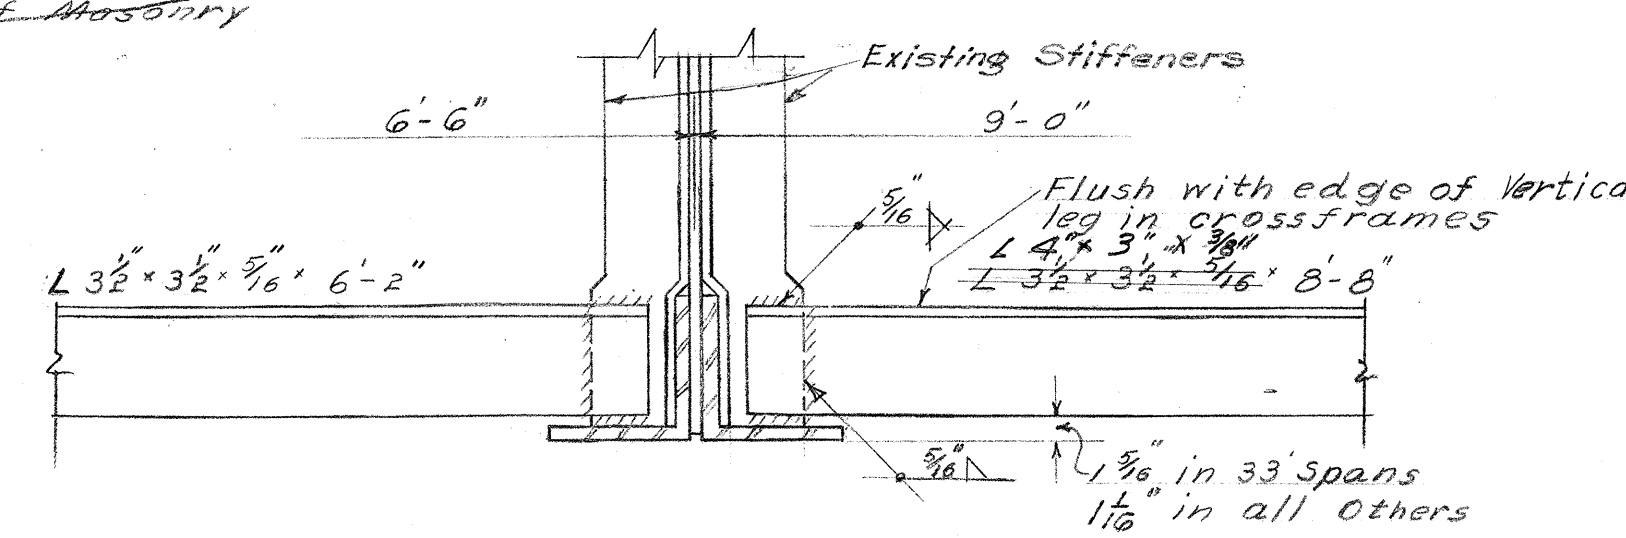


Legend.

- Red-Brown Clay
- Dark Brown Clay
- Loose Rock
- Water
- Boulders

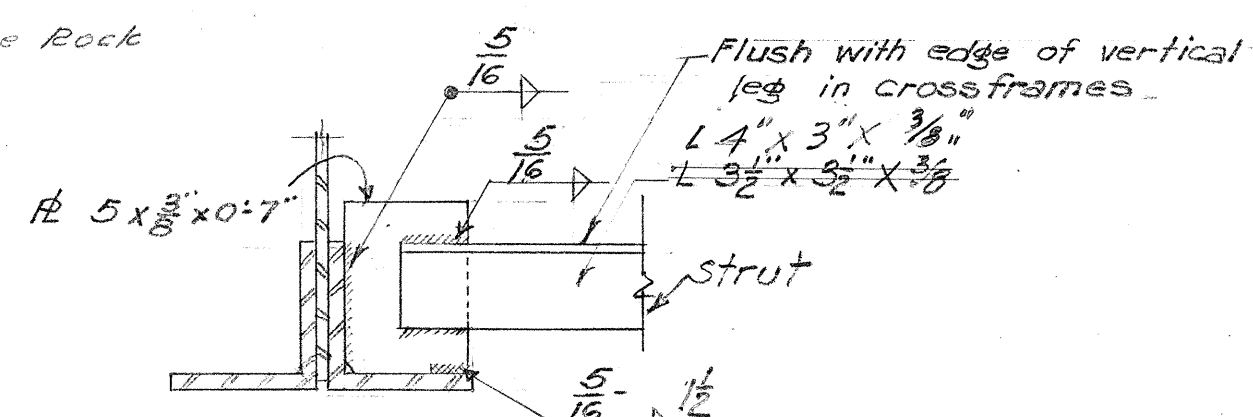

* u_h = Upstream fig. height.
* d_h = Downstream " "

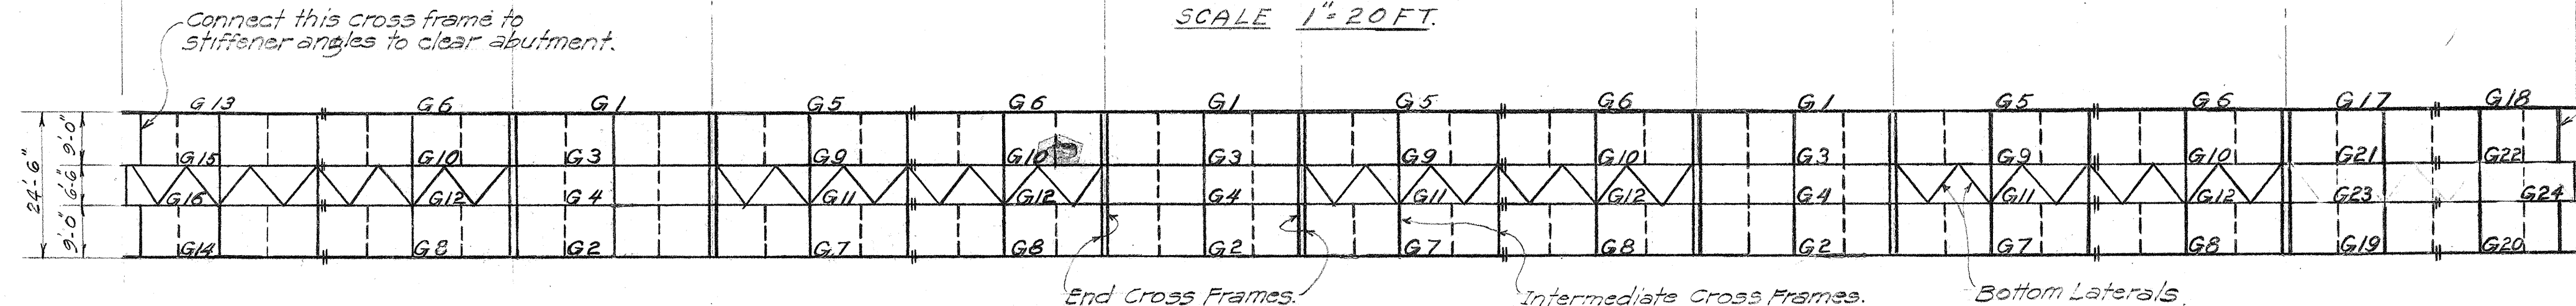


— : Cross Frame
--- : Strut
Note: Struts are for maintenance purposes only.
All Struts — $2 \times 3 \times 3/8$
All angles in End Cross Frames — $3 \times 3 \times 3/8$
" " " Intermediate C.F. — $3 \times 3 \times 3/8$

All outside girders available at Honolulu Bridge.
All sole plates and column caps in present R.R. Bridge must be duplicated in transferred portion.

TERRITORIAL HIGHWAY DEPARTMENT
TERRITORY OF HAWAII
KAPUE BRIDGE
Sta 88+30.99 to 92+46.07
Hawaii Belt Road
March 1949
SDR-3(9)
1ST. UNIT.

SHEET No. 9 OF 13 SHEETS

5415.16

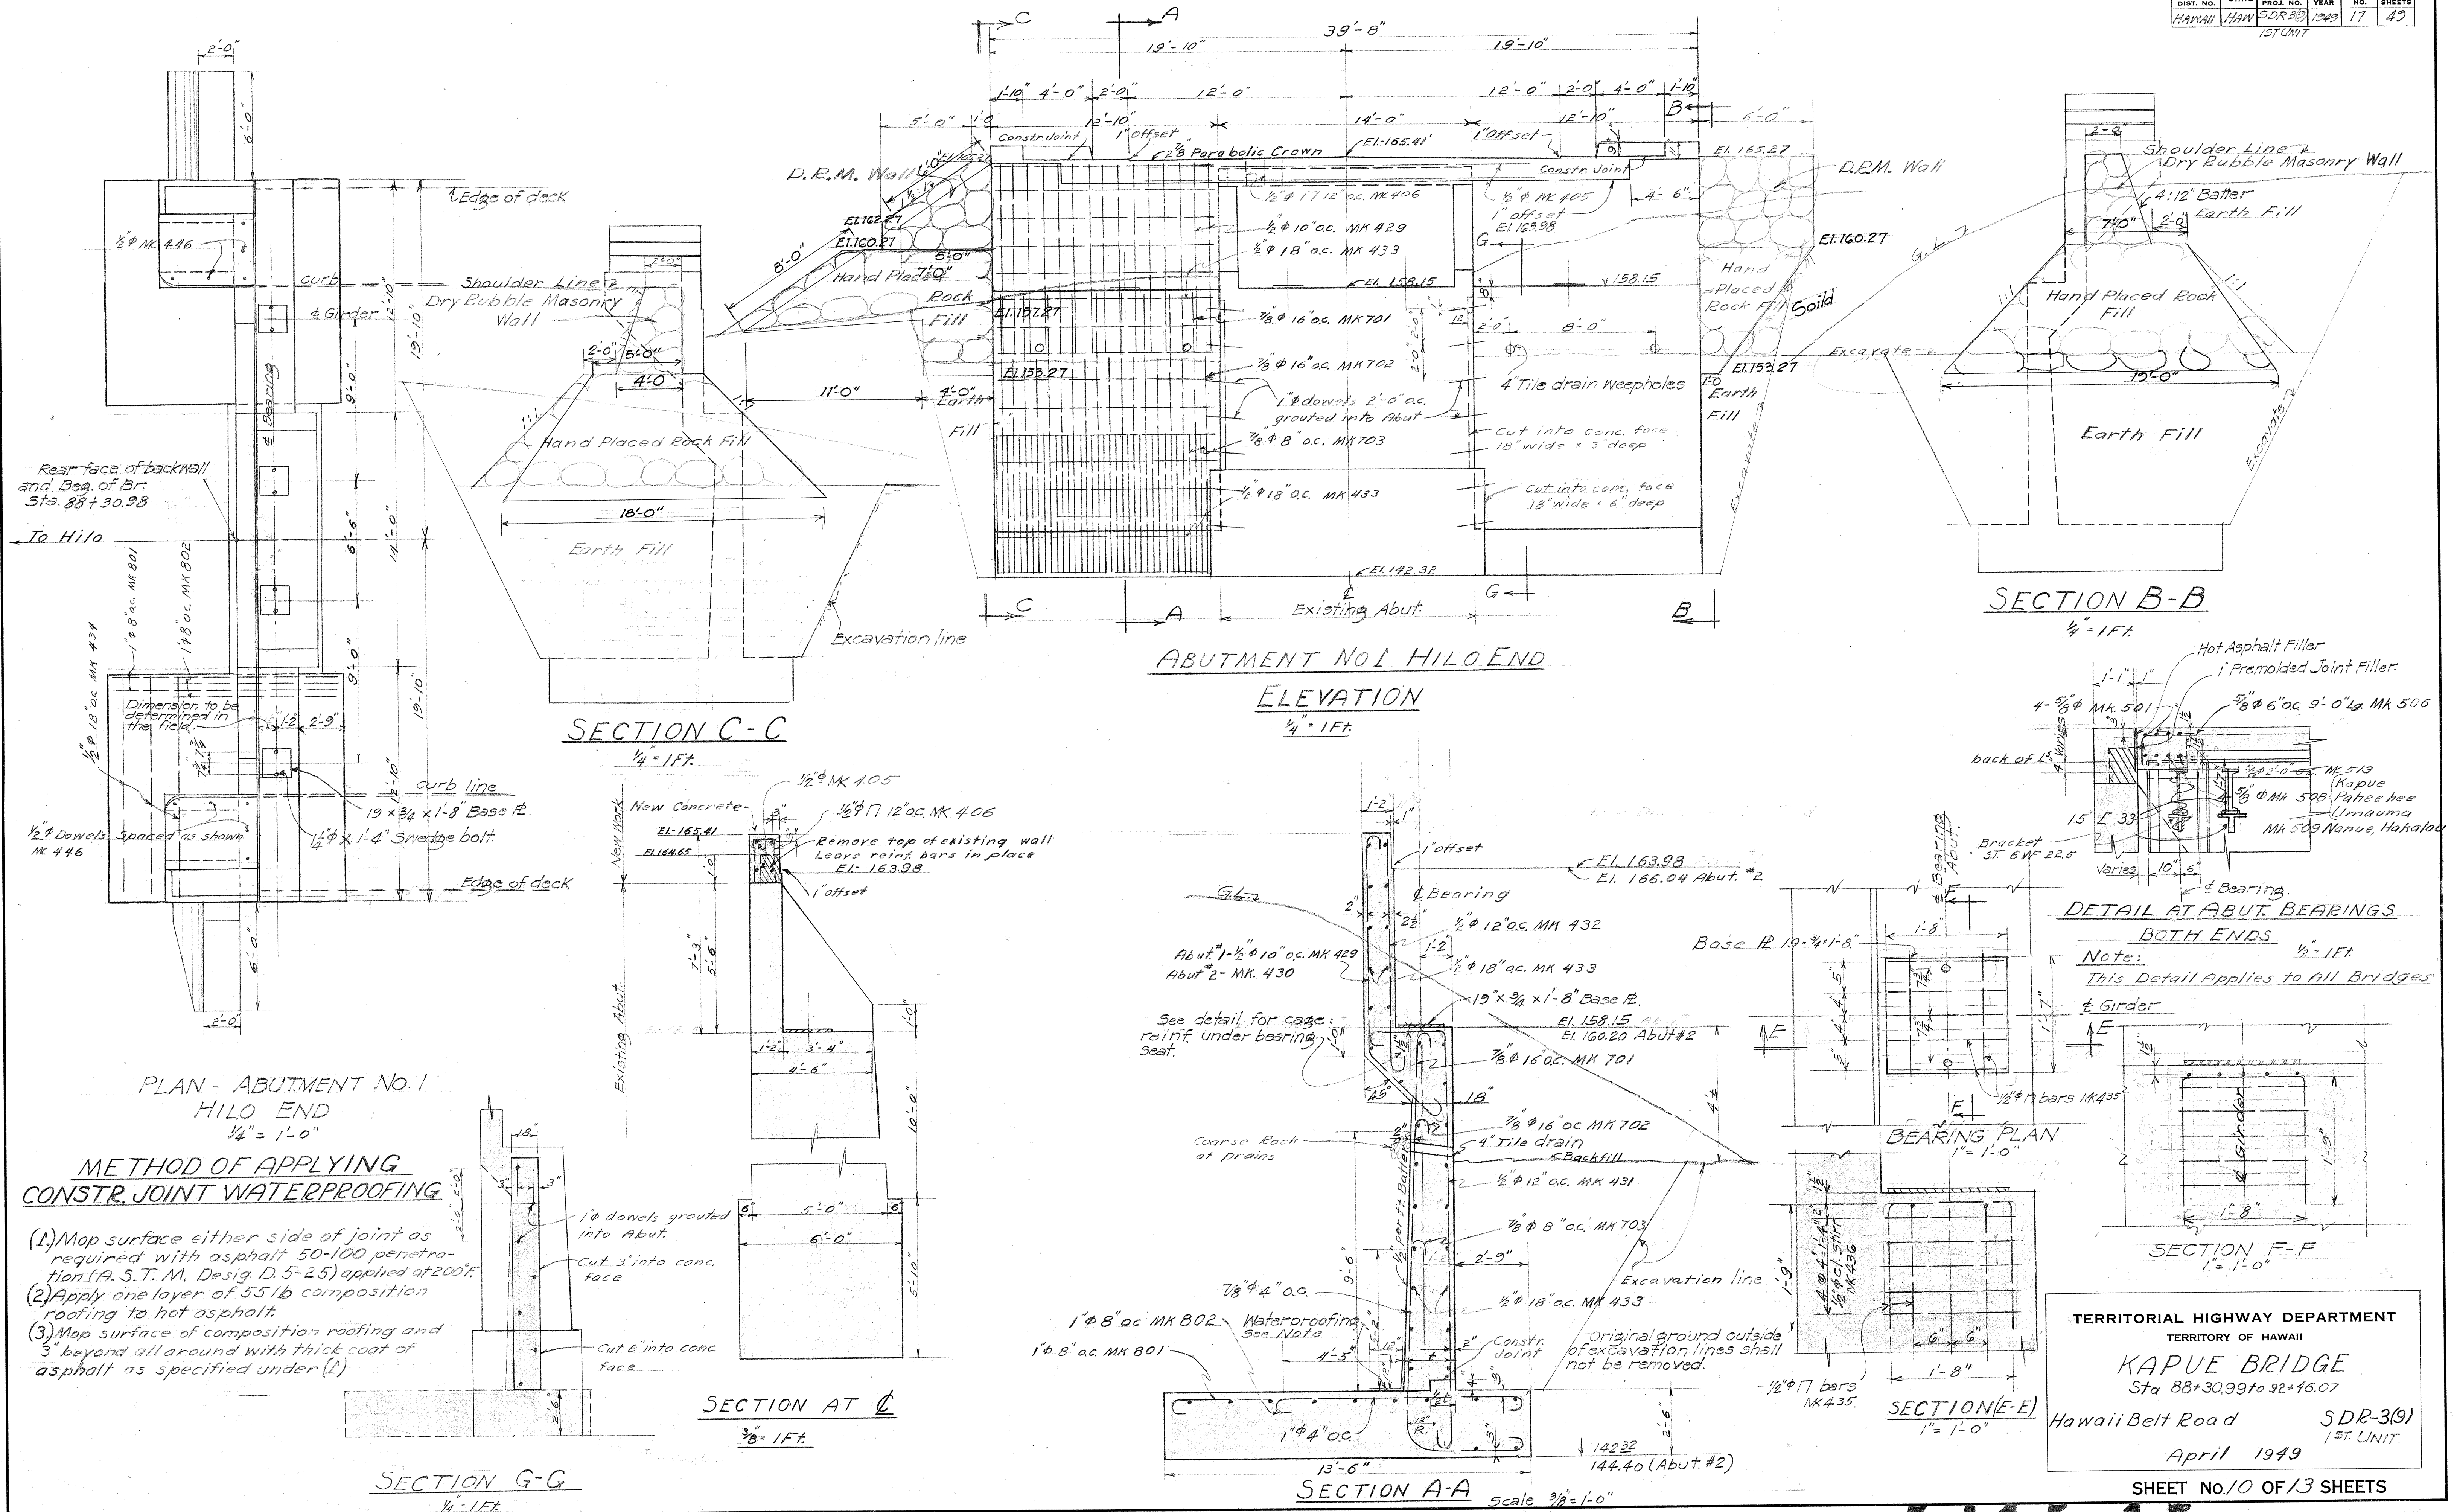


TERRITORIAL HIGHWAY DEPARTMENT
TERRITORY OF HAWAII
KAPUE BRIDGE
Sta 88+30.99 to 92+46.07
Hawaii Belt Road
April 1949
SDR-3(9)
1ST UNIT
SHEET NO. 10 OF 13 SHEETS



5415.17

FED. ROAD DIST. NO.	STATE	FED. AID PROJ. NO.	FISCAL YEAR	SHEET NO.	TOTAL SHEET
HAWAII	HAW.	SDR 3(9)	1949	18	49


1ST UNIT

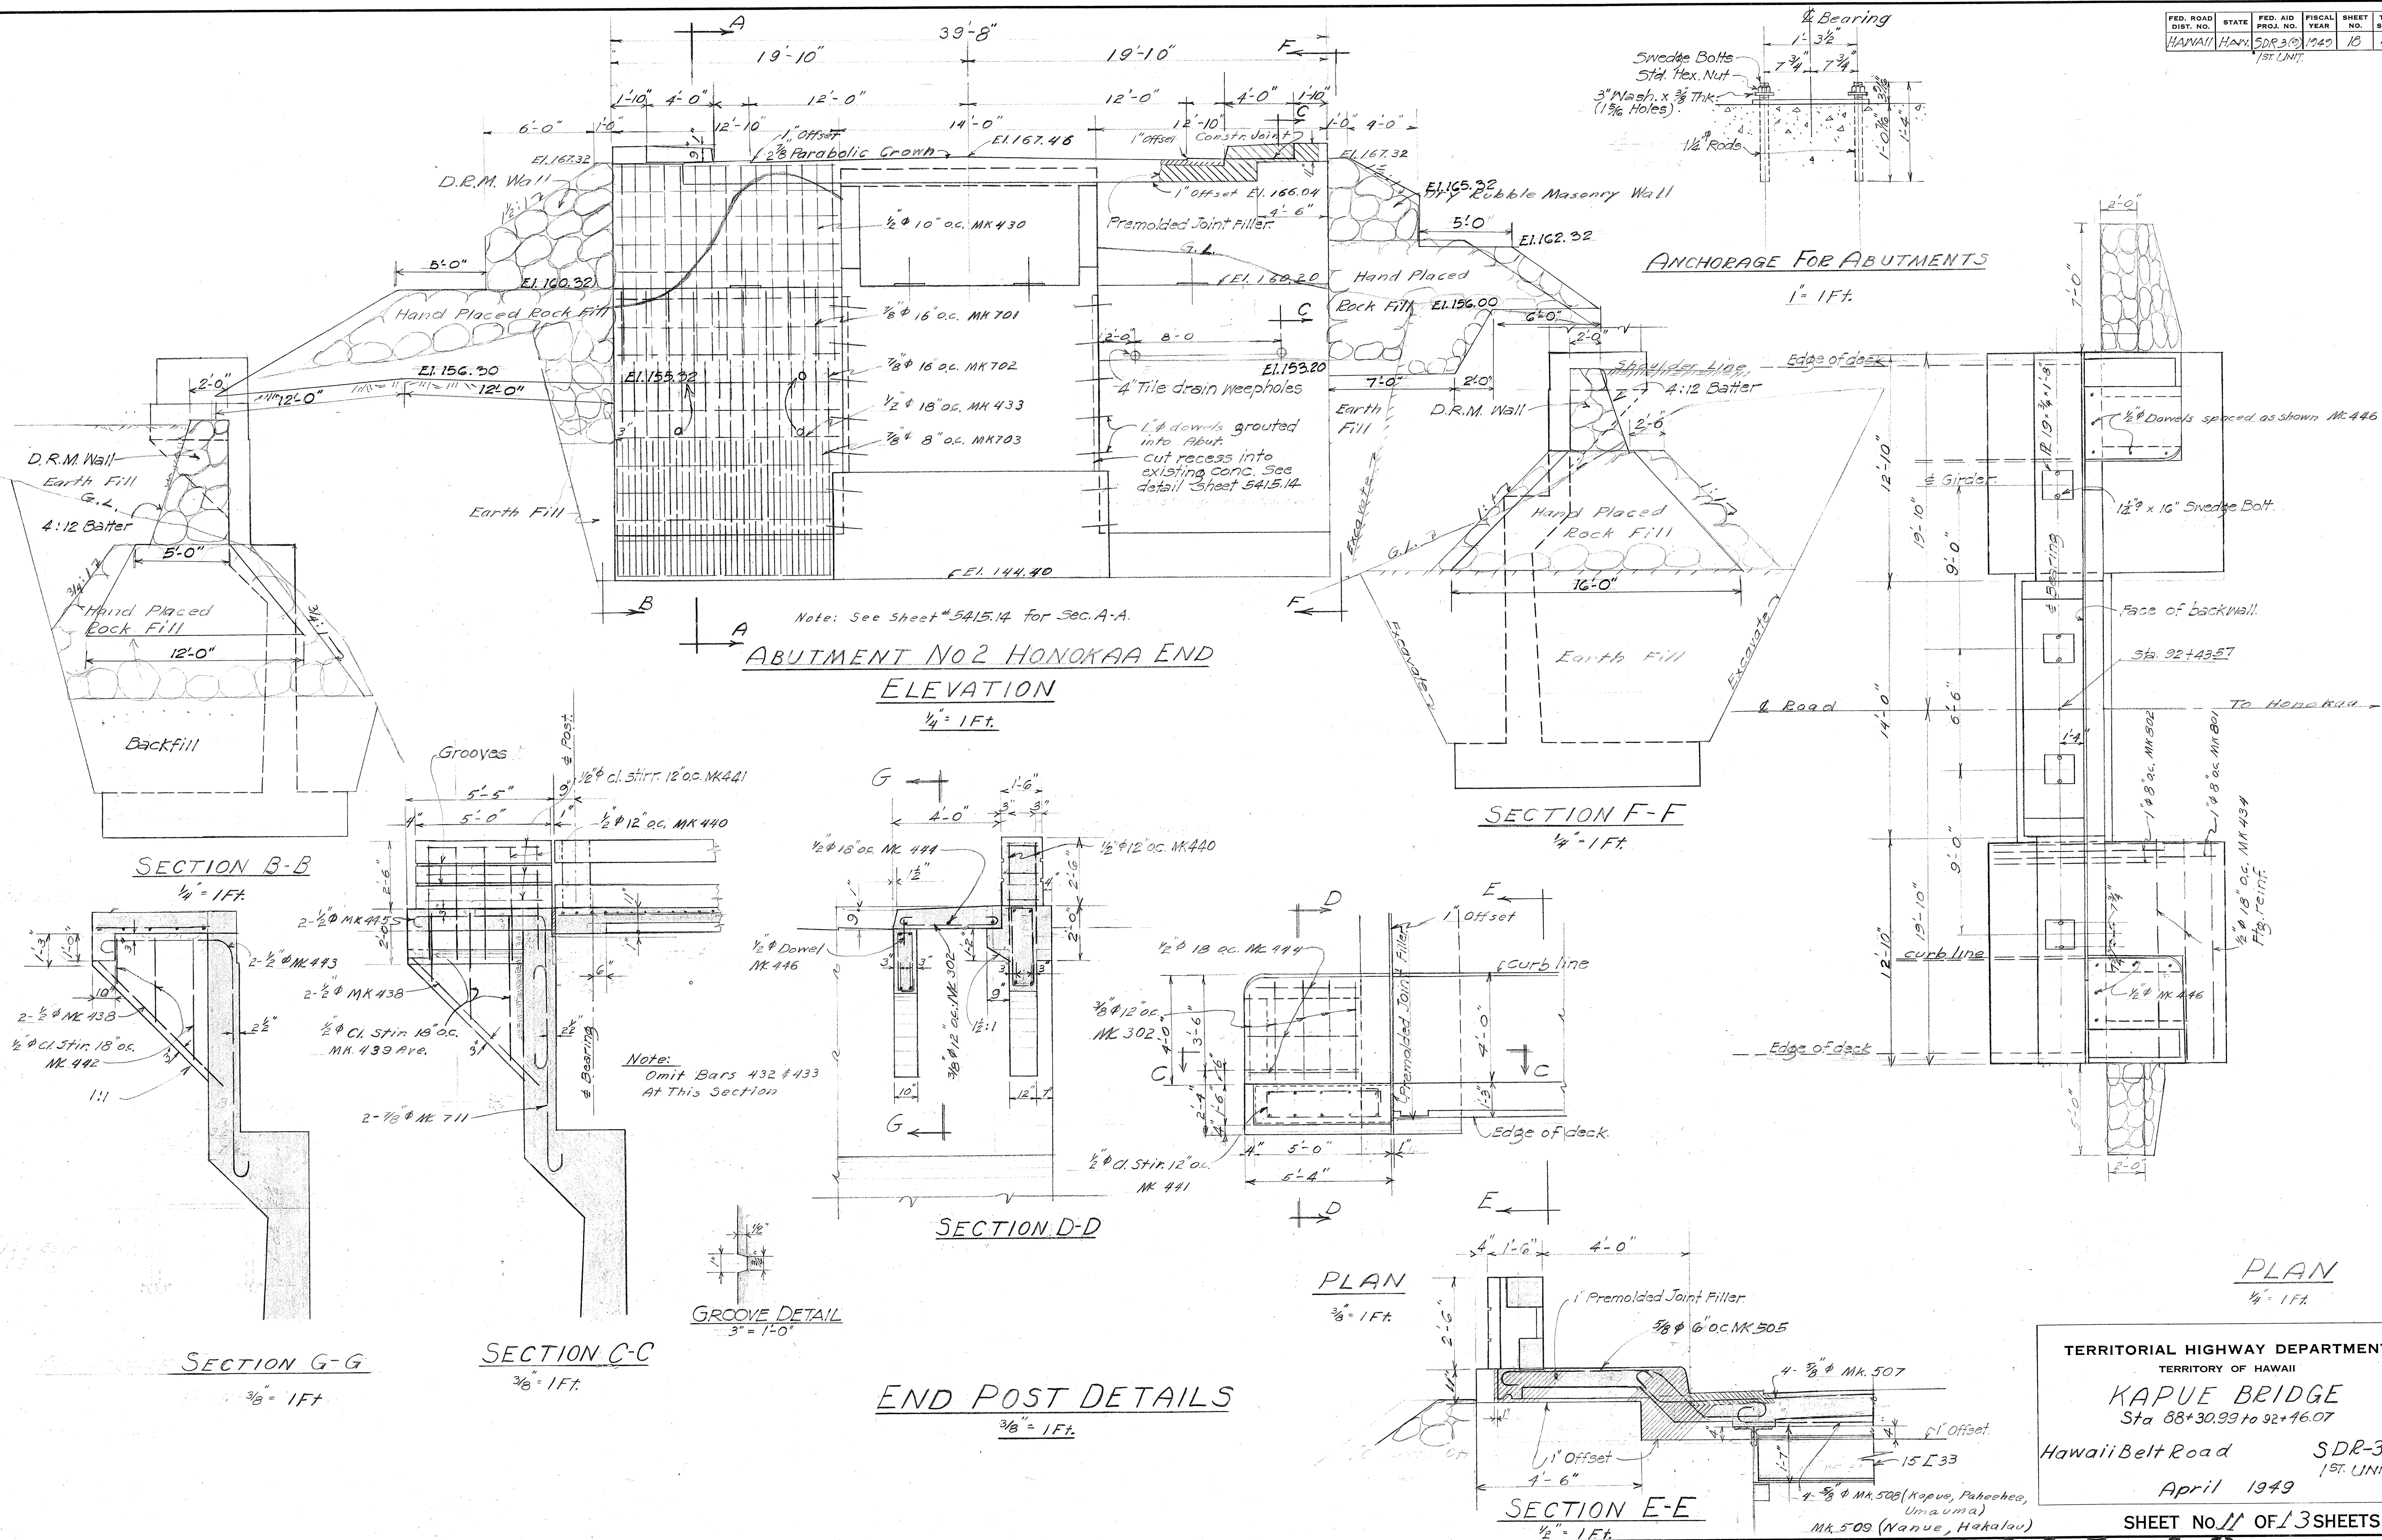

5415.18

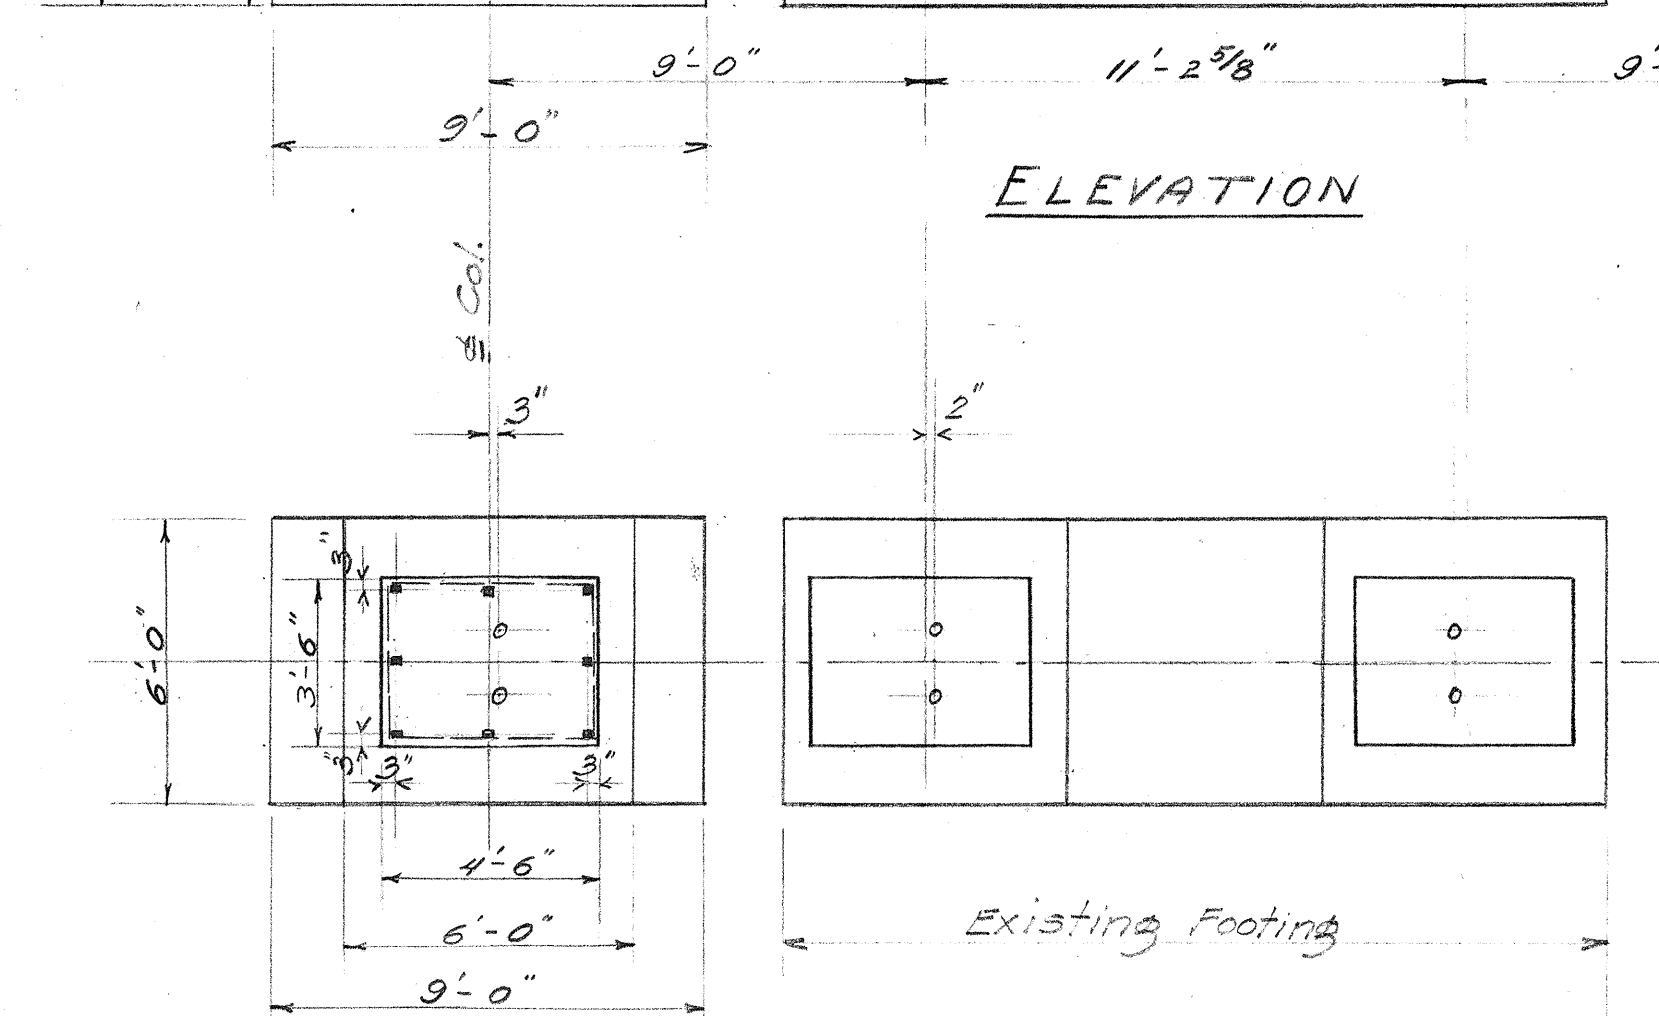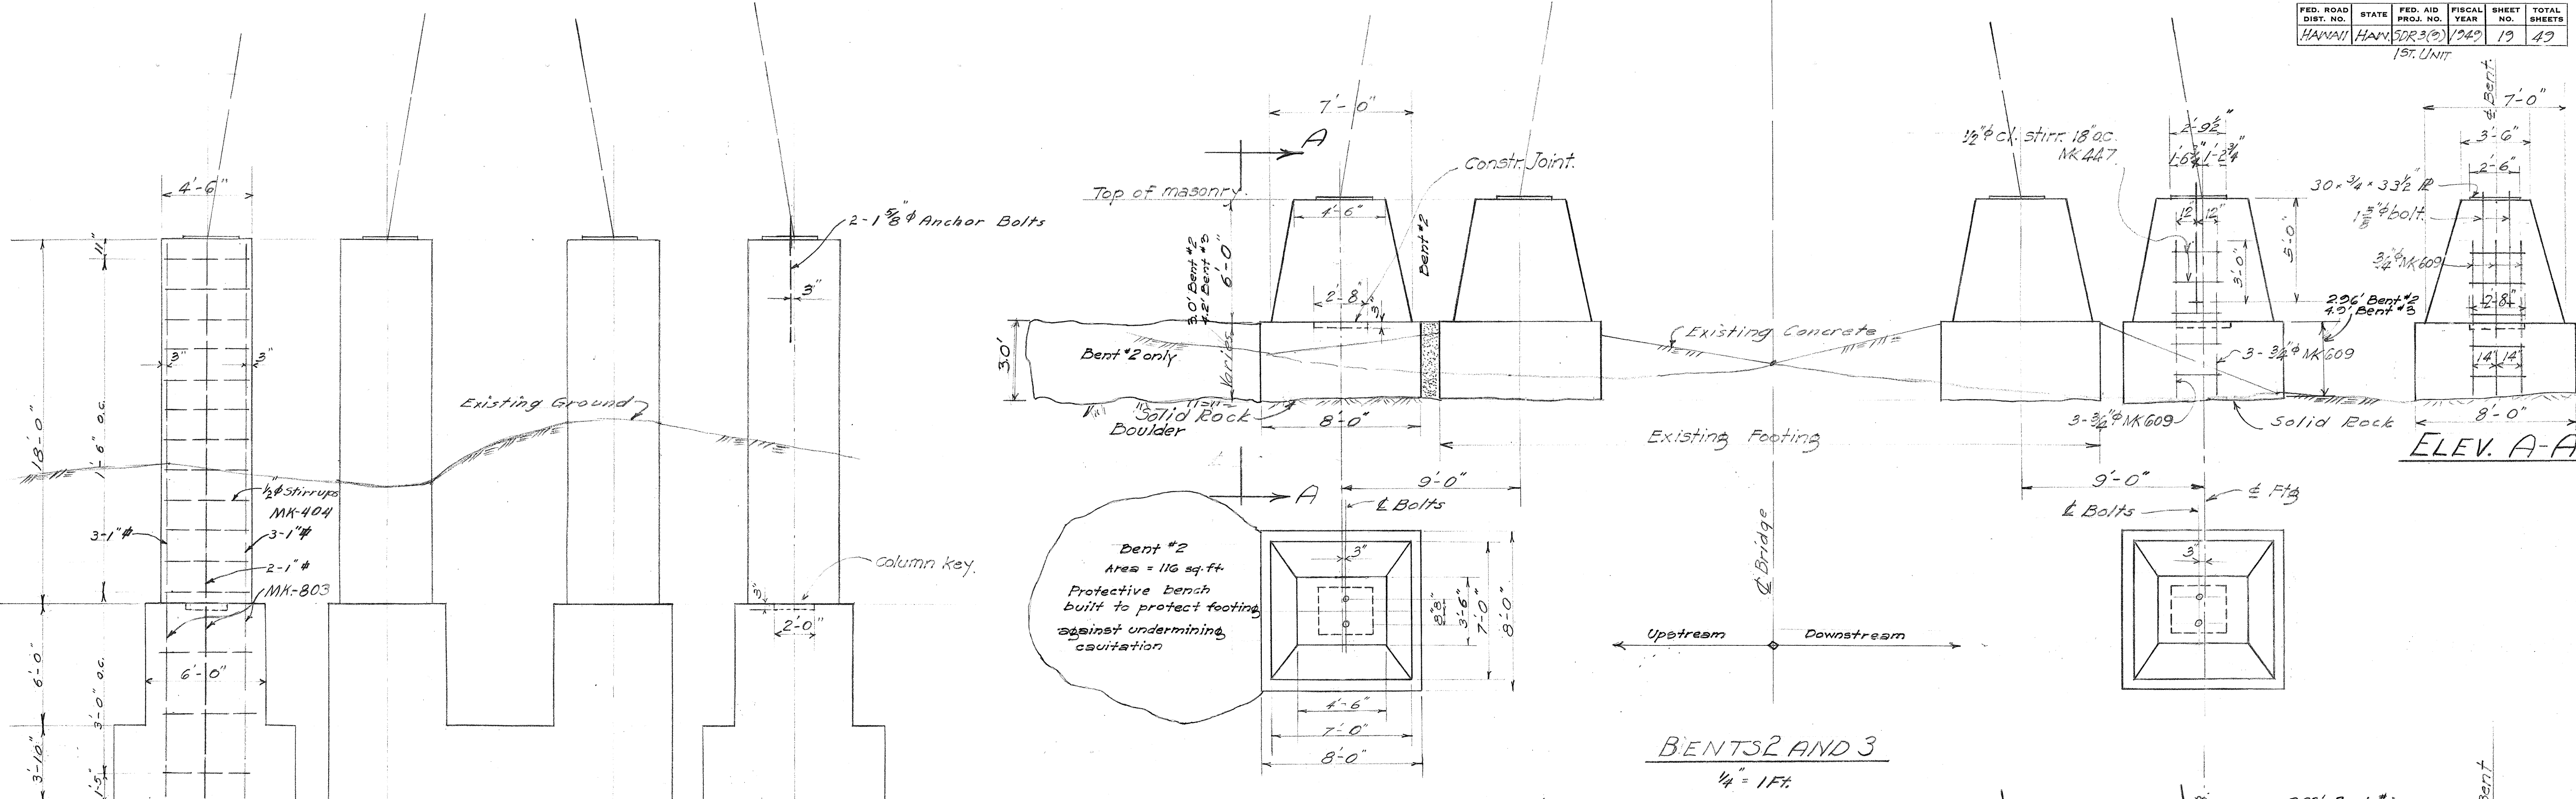

PLAN
FOOTING BENT NO. 7
1/4" = 1 Ft.

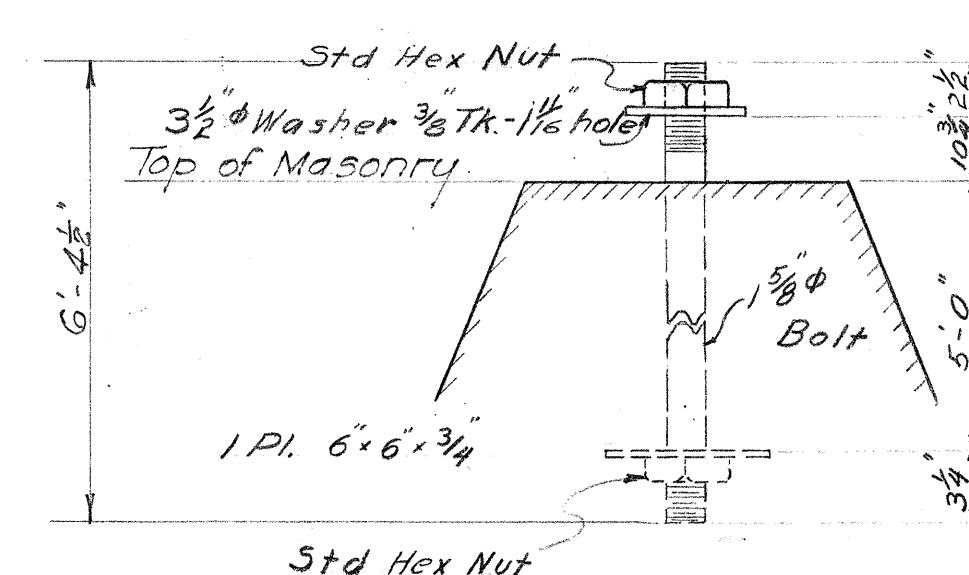

ANCHORAGE FOR ALL PIERS

ESTIMATED QUANTITIES						
	Super-structure	Railing & End Posts	Abutments		Bents	Totals
			No. 1	No. 2		
Class A-1 Conc.	449 cu. yd.	53 cu. yd.	68 cu. yd.	58 cu. yd.		638 cu. yd.
Class B-2 Conc.					224 cu. yd.	224 cu. yd.
Struct. Excav.			360 cu. yd.	320 cu. yd.	458 cu. yd.	1138 cu. yd.
Reinf. steel	86453 #	9784 #	710 #	7130 #	2672 #	113162 #
	86453 #	9784 #	710 #	7130 #	2672 #	113162 #
Dry Rubble Masonry			5 cu. yd.	6 cu. yd.		11 cu. yd.
Hand. Placed Rock Fill			39 cu. yd.	46 cu. yd.		85 cu. yd.
Fabricating, and erecting steel.						41,465 #
Cleaning and erecting steel.						11,162 #
Applying 1st Coat of existing R.R. Bridges.						11,162 #
Painting entire structure with two coats (832,000 #)						418,426 #
Replacing 3/4" x 2 3/8" (Ave) lower bracing system.						112,800 #
Replacing 7/8" x 3 7/8" (Ave) girders.						5200 #
Replacing brace bars, stay plates etc.						2,553 #
A.C. Pavement.	64.34 Tons					57.3 #
						64.34 Tons

GENERAL NOTES.

Design Data:
H-20-44 Loading
 $f_c = 1000 \text{ #}$
 $f_s = 20,000 \text{ #}$
 $n = 10$
 $f_s (\text{str. steel}) = 12,000 \text{ #}$

Materials:
Concrete: All concrete except in Pier Footings - Class A-1.
Concrete in Pier Footings - Class B-2.
Premolded Joint Filler: Premolded Joint Filler shall be rubber type.
Specification for Asphalt Filler: Softening Point - 167-185°F (ASTM D46-20). Penetration - 30-45 (ASTM D5-25). Flash Point Min. - 446°F (ASTM D22-46).
Reinf. Steel: Reinf. steel shall be intermediate grade.
Construction Methods: All surfaces of railings, posts and and posts above top of curb shall have Class 1 surface finish.
Brush coat waterproofing of structure required in accordance with Specifications, Pamphlet N Sec. 34.

TERRITORIAL HIGHWAY DEPARTMENT
TERRITORY OF HAWAII
KAPUE BRIDGE
Sta 88+30.99 to 92+46.07
Hawaii Belt Road
March 1949
SDR-3(9)
1st Unit

DATE: 10/12/49
DESIGNED BY: H. S. Dyer
CHECKED BY: H. S. Dyer
QUANTITIES BY: A. D. M. M. M.
CHECKED BY: H. S. Dyer

ORIGINAL PLAN	SURVEY PLOTTED BY DESIGNED BY DRAWN BY TRACED BY	DATE
	<i>N. R. Bartels</i>	<i>3-29</i>
	<i>A. Van Der Horst</i>	<i>9-29</i>
NOTE BOOK No.	QUANTITIES BY QUANTITIES CHECKED BY	
	<i>A. V. D. W.</i>	<i>4</i>
	<i>R. K. Manning</i>	<i>9</i>
	<i>R. Vaineshilov</i>	<i>4</i>

RAILING LAYOUT (RIGHT)

RAILING LAYOUT (RIGHT)

RAILING LAYOUT (RIGHT)

(Left Railing similar)





SECTION A-A
1" = 15'

SECTION B-B
1" = 1 Ft.

SECTION C-C

$$1'' = 1Ft.$$

5415.20

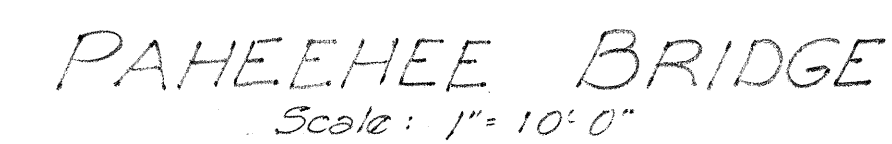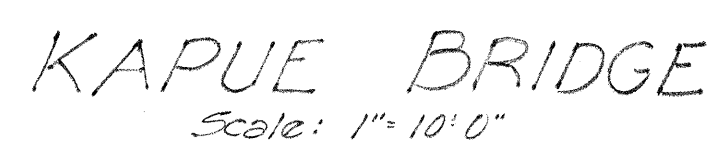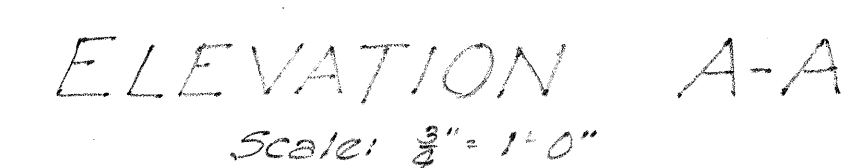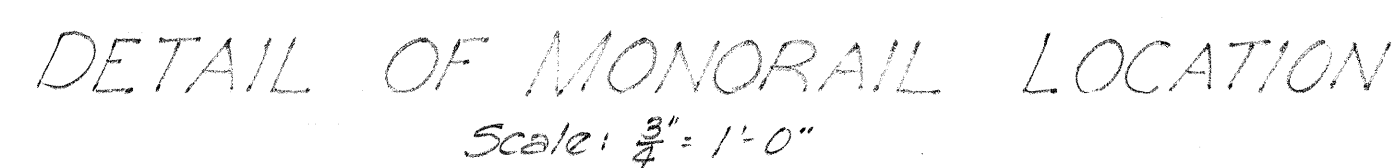

LIST OF G.I. 125*		
No. of pieces	Length	Total Length
26	40' 0"	1040.0'
2	37' 9"	73.5'
2	34' 0"	68.0'
4	18' 11"	72.7'
2	17' 7"	35.2'
2	11' 9"	23.5'
Total		1317.9' ----- 16,474 lbs.
172 Hangers ($3 \times \frac{1}{2} \times 140$) @ 5.1" -----		877 lbs.
172 Lugs ($3 \times \frac{1}{2} \times 0.362$) @ 1.5" -----		258 lbs.
344 Side Plates ($3 \times \frac{3}{8} \times 0.64$) @ 2.0" -----		688 lbs.
26 Alignment Pl. ($2 \times \frac{1}{2} \times 0.4$) @ 0.7" -----		18 lbs.
344 Plates for hangers ($\frac{3}{8} \times \frac{1}{2} \times 140$) @ 1.91" -----		657 lbs.

MONORAIL

HAWAII BELT ROAD
August 1950

SHEET No. / OF / SHEETS

5415.20A