

INDEX TO DRAWINGS	
SHEET	DESCRIPTION
1	TITLE SHEET
2-3	LOCATION PLAN
4-5	BORROW PIT
6	ST'D. BRIDGE DETAILS
7	ST'D. DETAILS
8-11	PAHEEHEE BRIDGE
12-15	GENERAL BRIDGE DETAILS
16-20	KAPUE BRIDGE
21-47	SHOP DRAWINGS
48-49	CROSS SECTIONS

TERRITORY OF HAWAII

TERRITORIAL HIGHWAY DEPARTMENT

HONOLULU T.H.

PLANS OF

HAWAII BELT ROAD

(KAPUE AND PAHEEHEE BRIDGES)

SEISMIC WAVE DAMAGE REHABILITATION

PROJECT NO. SDR 3(9)

DISTRICT OF SOUTH HILO


ISLAND OF HAWAII

SCALES

PLAN-----1 INCH= 100 FT.


PROFILE-----HOR. 1 INCH= 100 FT.

VER. 1 INCH= 10 FT.

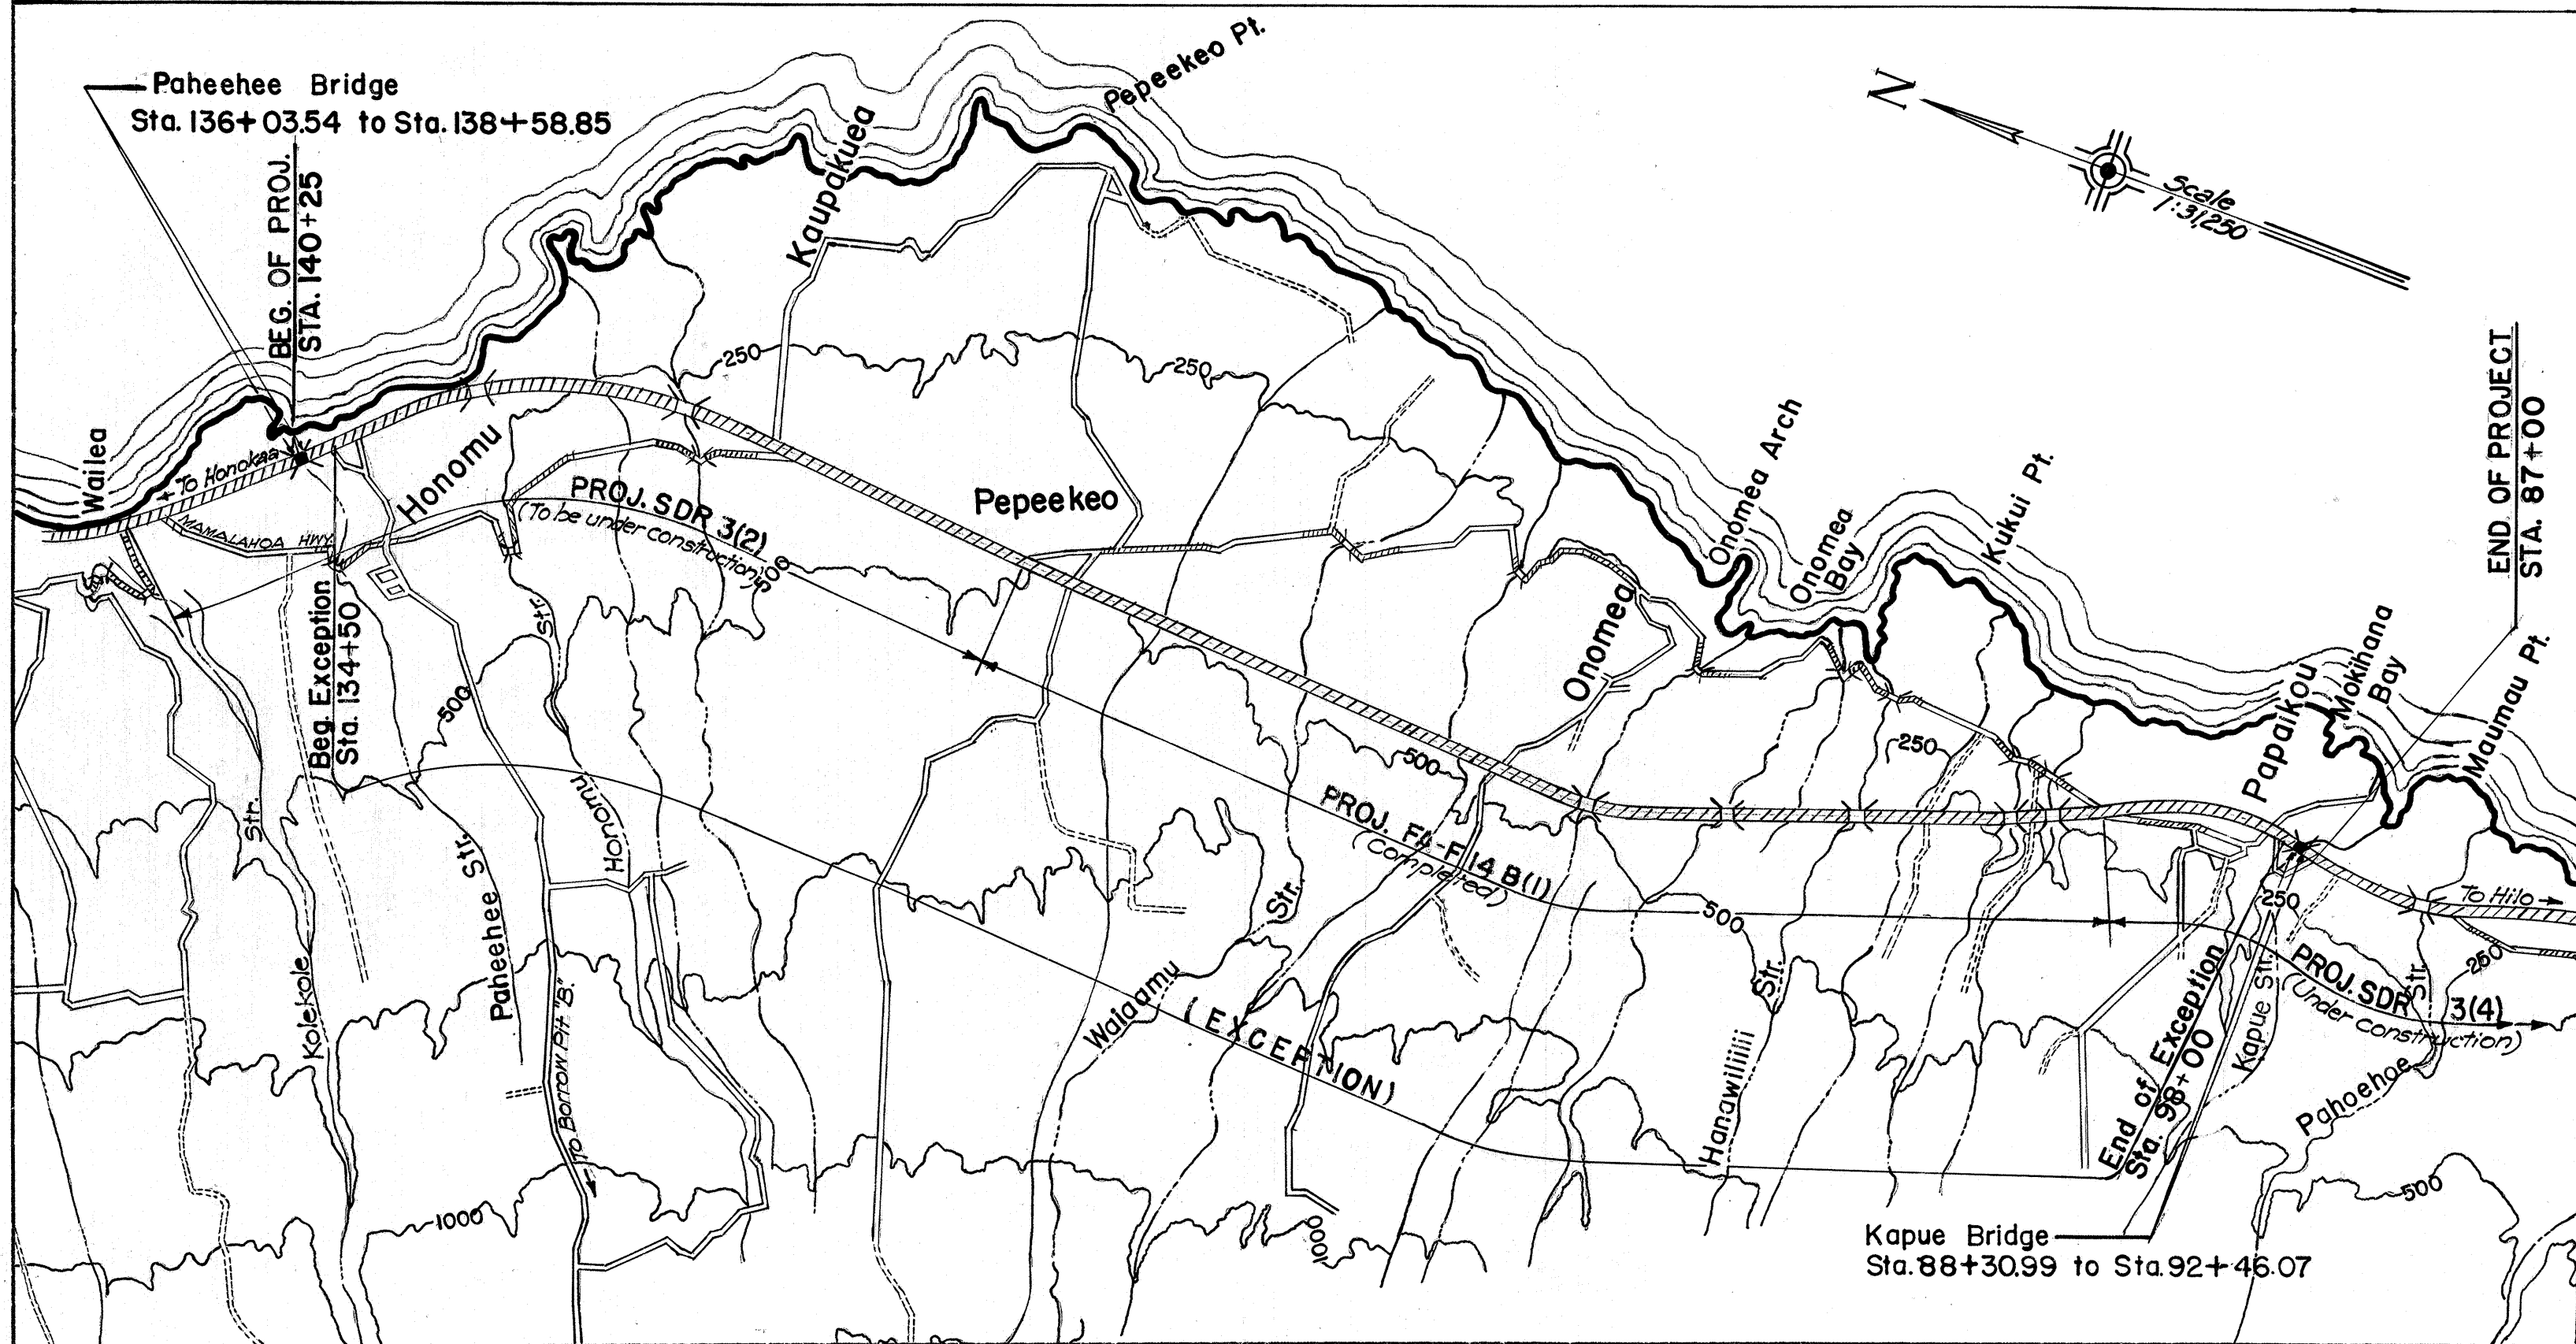

LAYOUT OF PROJECT

Gross Length Of Project	7.126 Mi.
Exception	6.809 Mi.
Net Length Of Project	0.317 Mi.
Bridges Over 20 ft. Span	0.127 Mi.
Net Length Of Roadway	0.190 Mi.

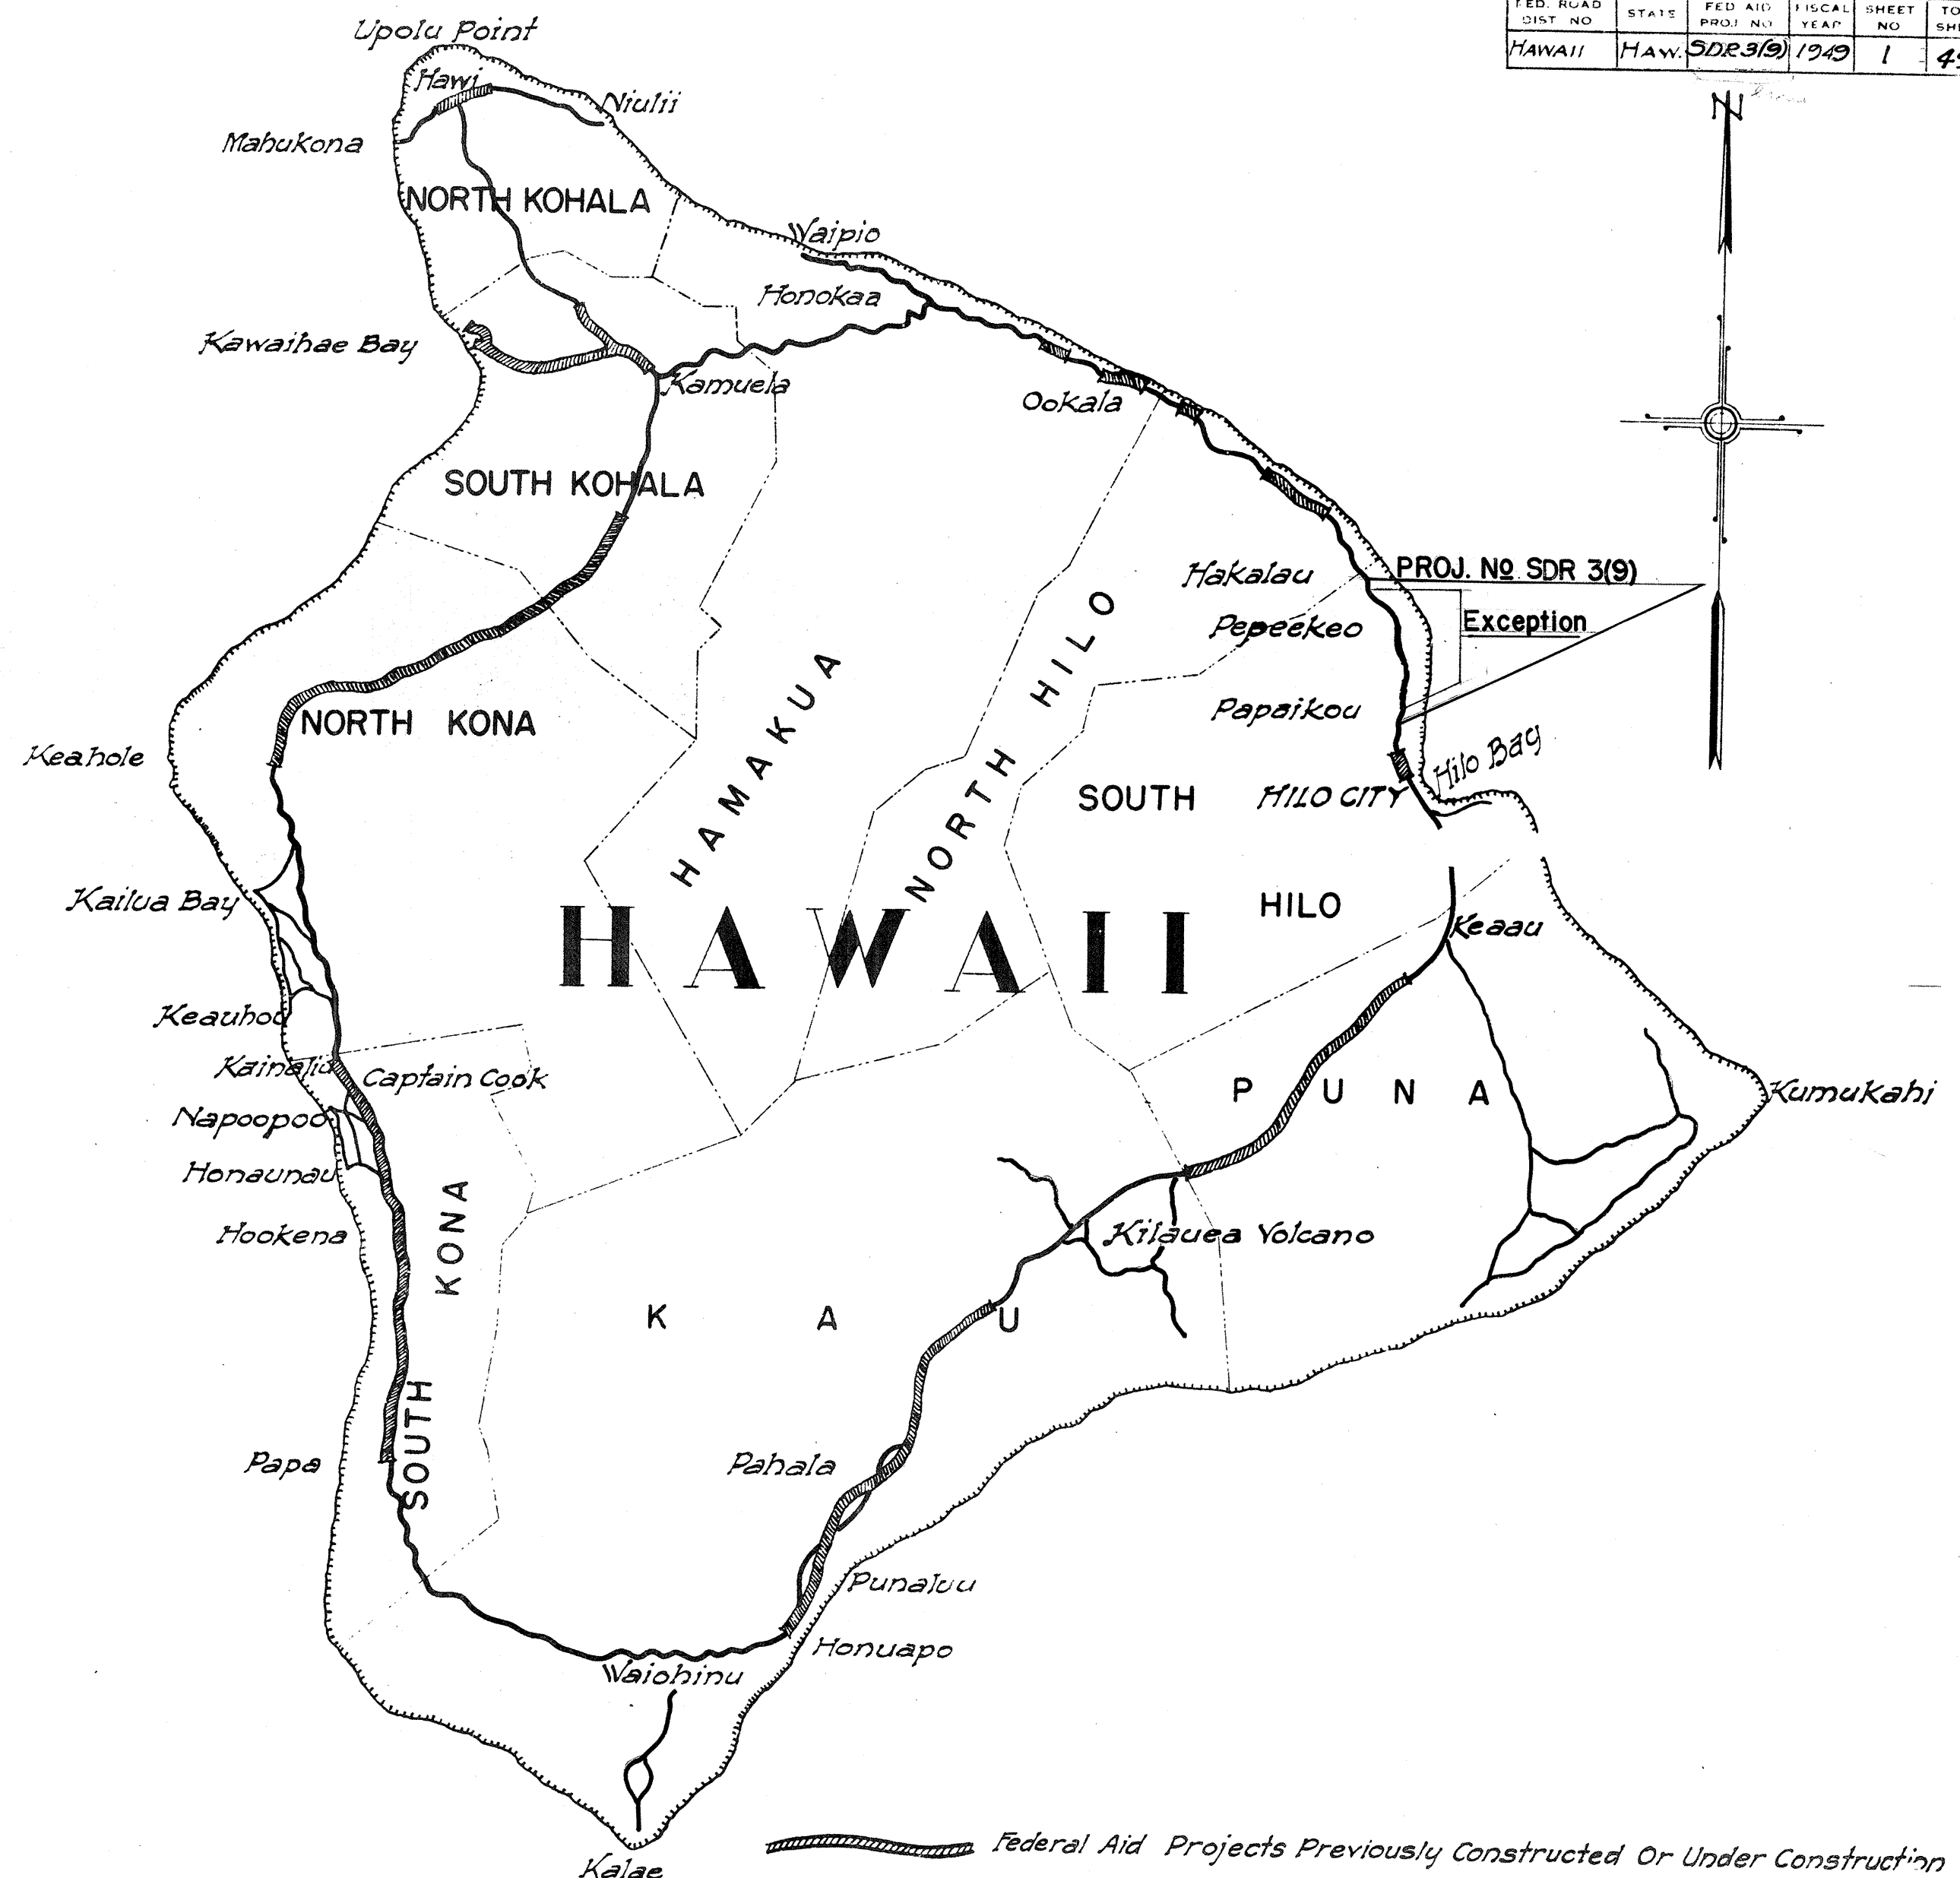

NOTE:

ALL CHANGES MADE DURING CONSTRUCTION

HAVE BEEN NOTED IN RED ON THESE

TRACINGS AND CHECKED BY:

*[Signature]*

RESIDENT ENGINEER

April 18, 1951

DATE

RECOMMENDED FOR APPROVAL: DATE:

DISTRICT ENGINEER

PUBLIC ROADS ADMINISTRATION

FEDERAL WORKS AGENCY

APPROVED: DATE: 12-7-49

*[Signature]*

TERRITORIAL HIGHWAY ENGINEER

APPROVED: DATE:

DIVISION ENGINEER

PUBLIC ROADS ADMINISTRATION

FEDERAL WORKS AGENCY