


INDEX TO DRAWINGS	
SHEET	DESCRIPTION
1	TITLE SHEET
2	LOCATION PLAN
3	ST'D. DETAILS
4	ST'D. BRIDGE DETAILS
5-23	KOLEKOLE BRIDGE

CONVENTIONAL SIGNS	
Centerline	125
Boundary Line	
Fences (Named)	
Existing Roadways	
Circular Culverts	
Box Culvert	
Bridge	
Telephone Pole	T.P.
Electric Power Pole	E.P.
Water Main	W ₂ (W ₄ , 8, 12, etc.)
Storm Drain	S ₁₂ (S ₁₈ , 24, etc.)
Concrete Drop Intake	C.D.I.
Standard Catch Basin	SCB
Standard Manhole	SMH
Sewer Manhole	SMH
Telephone Manhole	TMH
Fire Hydrant	F.H.
Tree (Large, named)	Mango
Railroad	

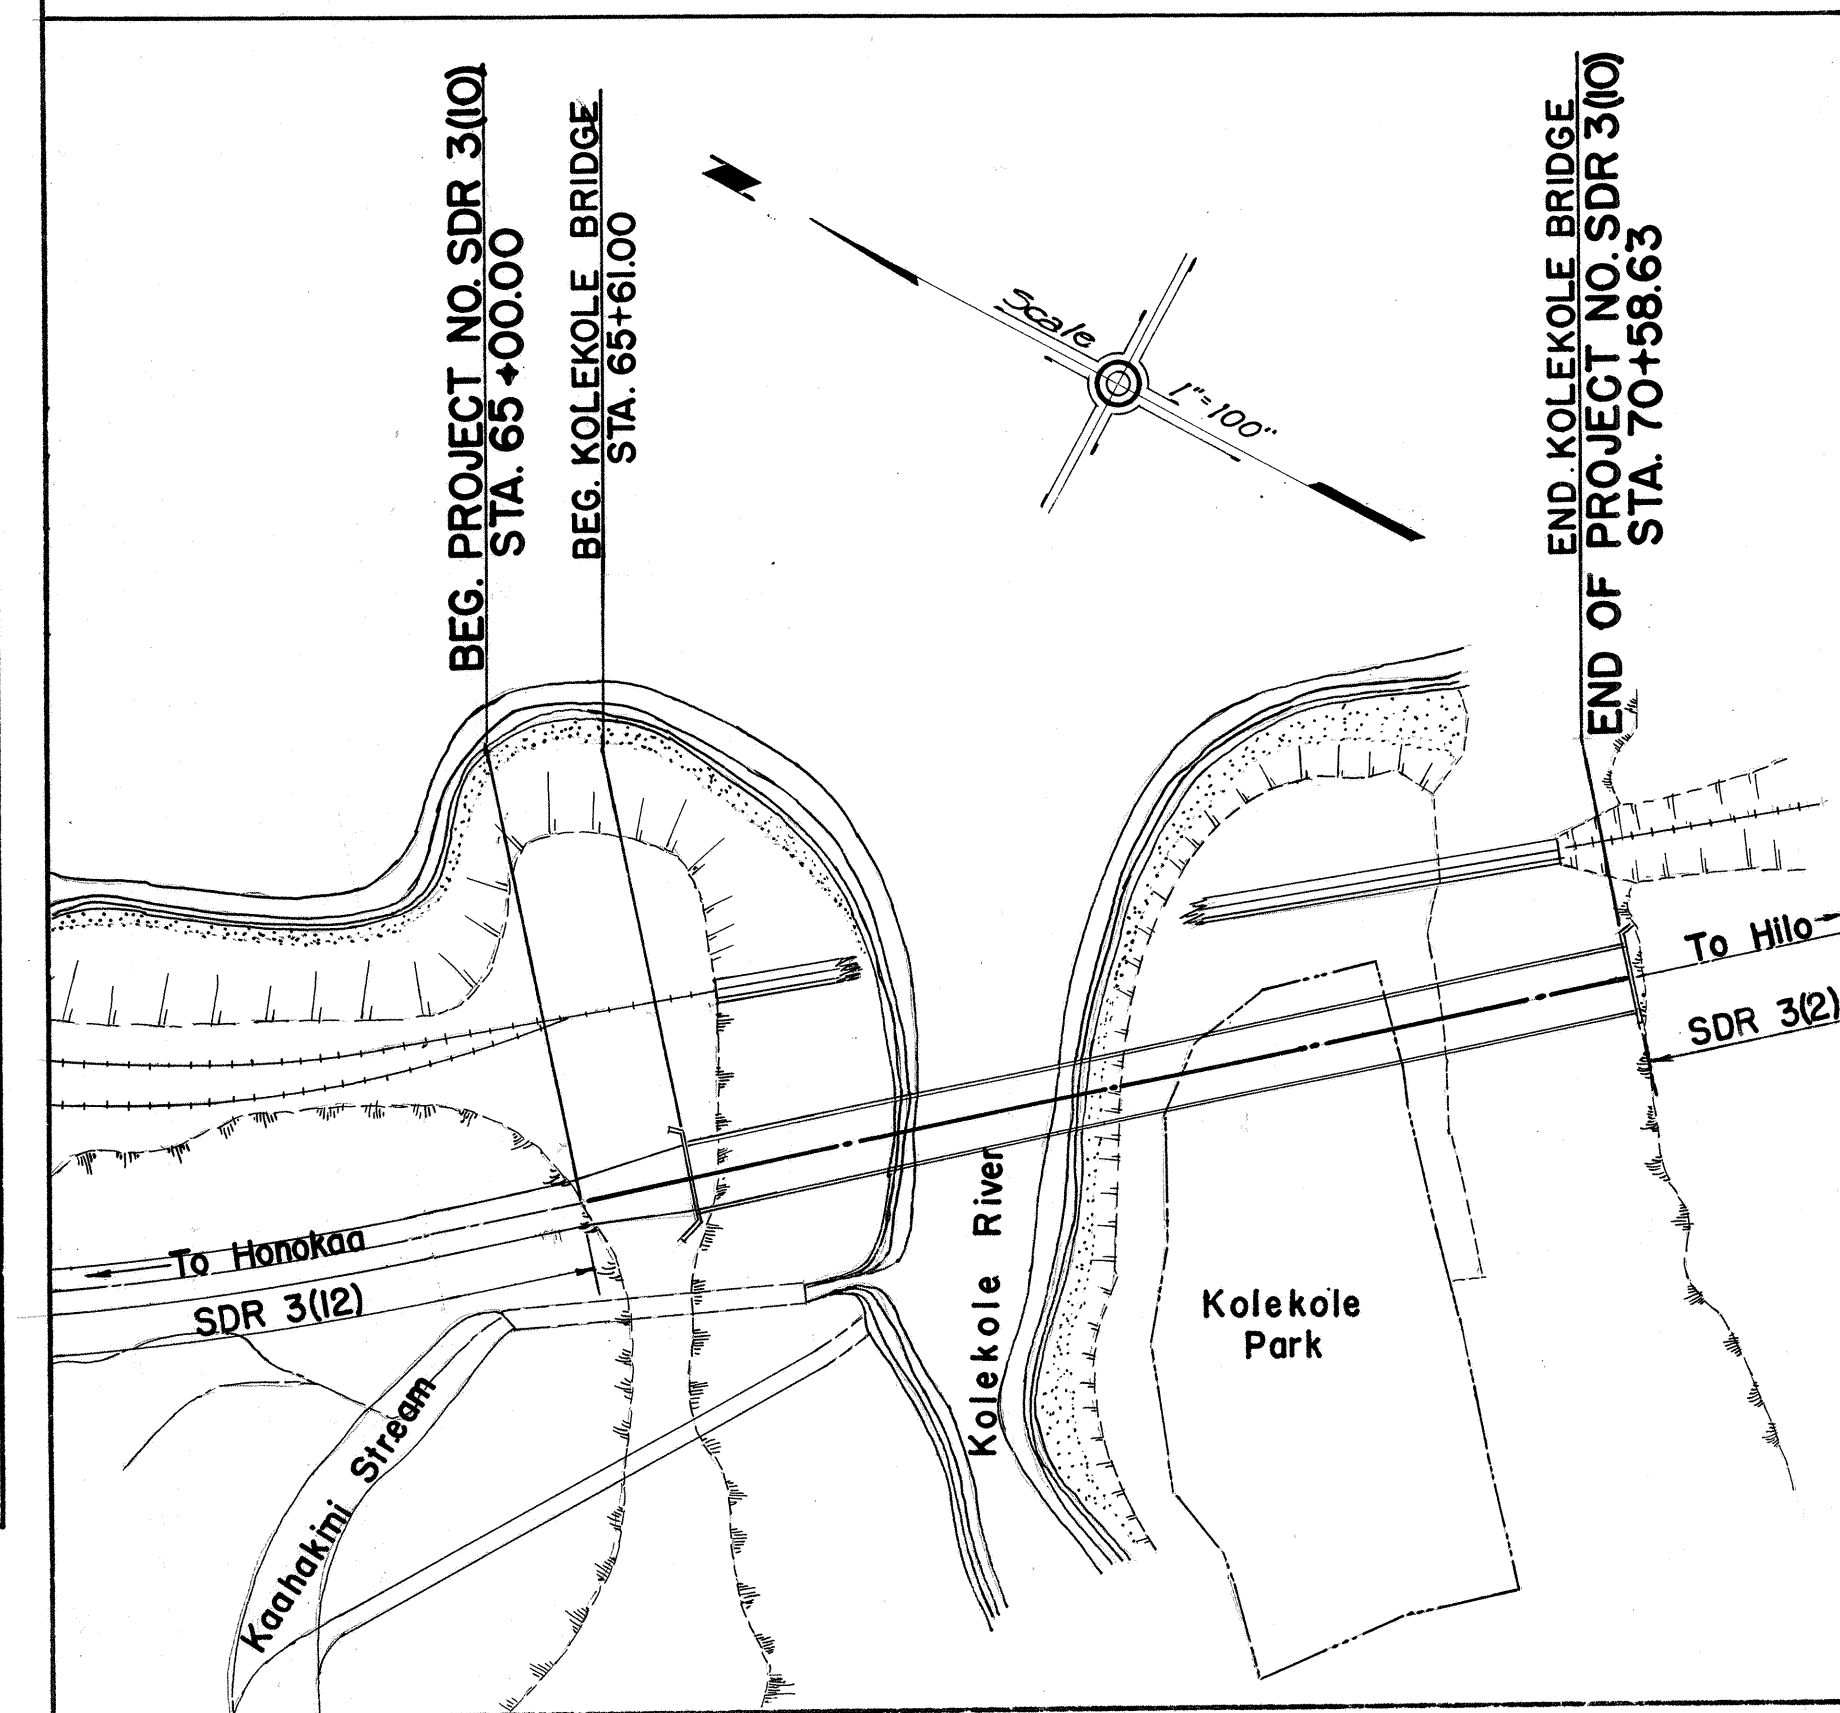

LAYOUT OF PROJECT	
Gross Length of Project	0.106 Mi.
Bridge Over 20 feet Span	0.094 Mi.
Net Length of Roadway	0.012 Mi.

TERRITORY OF HAWAII
TERRITORIAL HIGHWAY DEPARTMENT
HONOLULU T.H.

PLANS OF

HAWAII BELT ROAD

(KOLEKOLE BRIDGE)


SEISMIC WAVE DAMAGE REHABILITATION

PROJECT NO. SDR 3(10)

DISTRICT OF SOUTH HILO
ISLAND OF HAWAII

SCALES

PLAN ——— 1 INCH = 100 FT.
PROFILE ——— HOR. 1 INCH = 100 FT.
VER. 1 INCH = 10 FT.

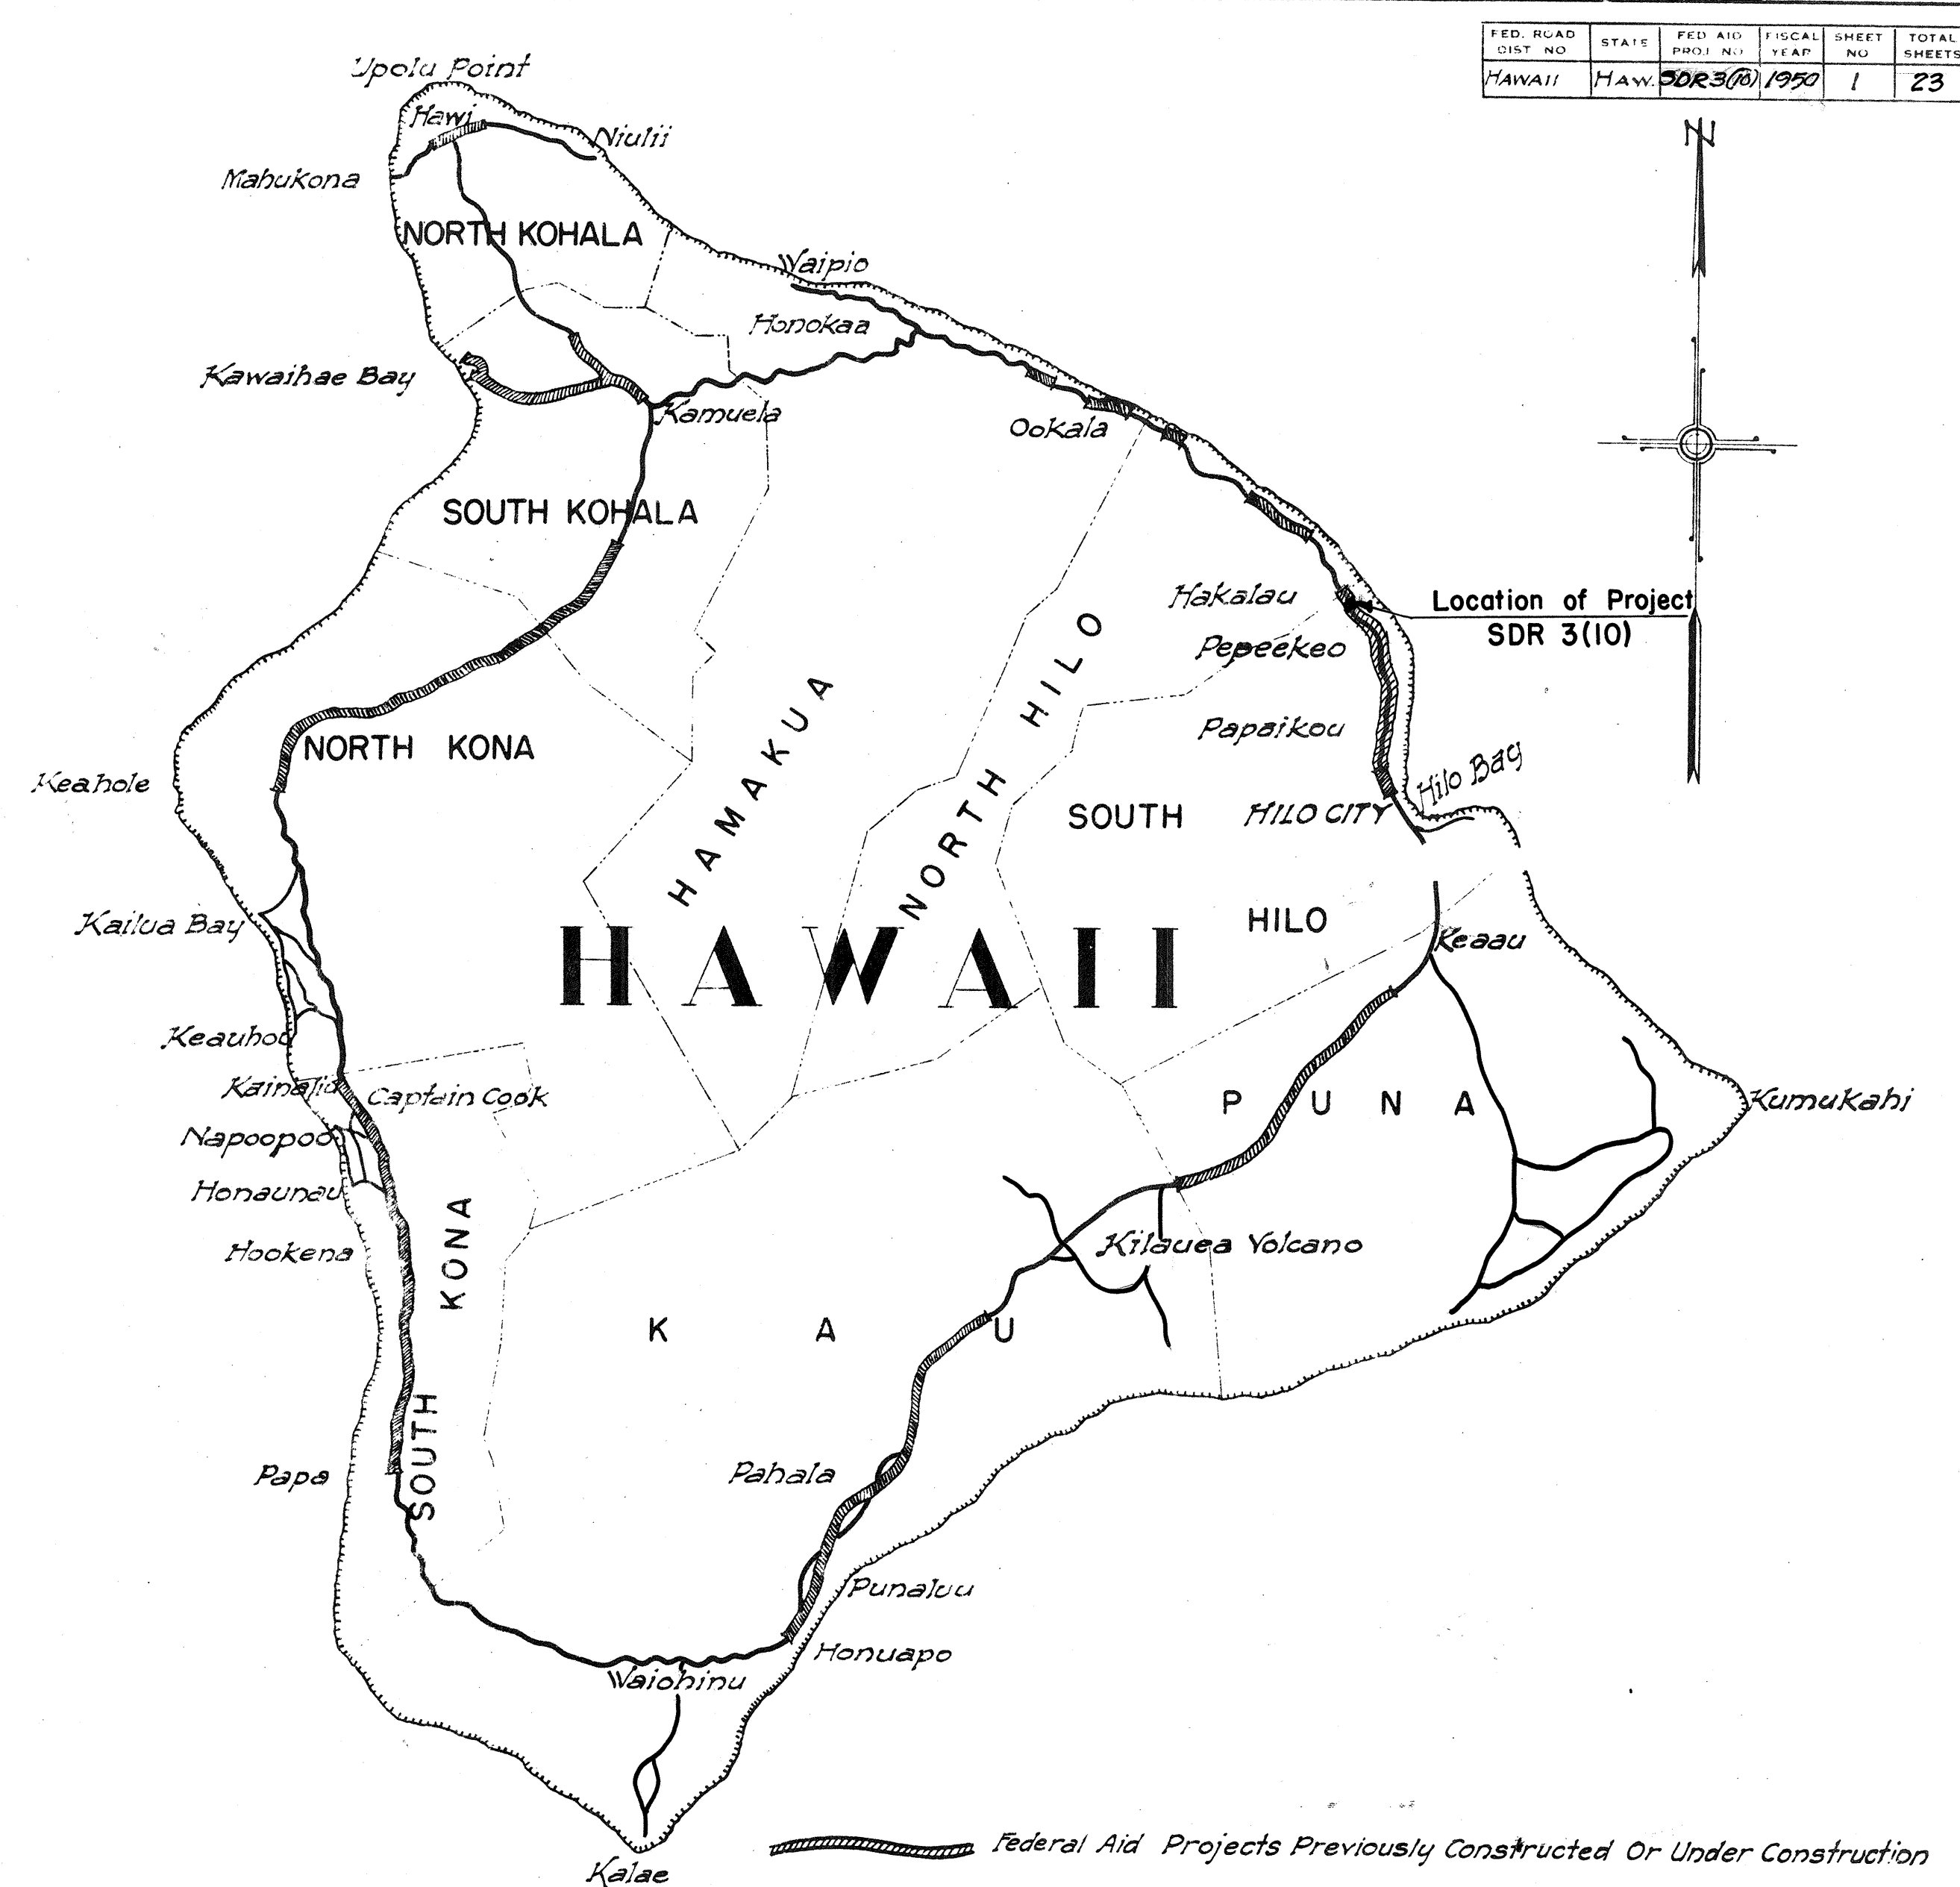

NOTE:
ALL CHANGES MADE DURING CONSTRUCTION
HAVE BEEN NOTED IN RED ON THESE
TRACINGS AND CHECKED BY:

Alphonso
RESIDENT ENGINEER
April 18, 1951
DATE

APPROVED: *[Signature]* DATE: 2-23-50
TERRITORIAL HIGHWAY ENGINEER

RECOMMENDED FOR APPROVAL: DATE: _____
DISTRICT ENGINEER
PUBLIC ROADS ADMINISTRATION
FEDERAL WORKS AGENCY

APPROVED: _____ DATE: _____
DIVISION ENGINEER
PUBLIC ROADS ADMINISTRATION
FEDERAL WORKS AGENCY