


FED. ROAD DIST. NO.	STATE	FED. AID PROJ. NO.	FISCAL YEAR	SHEET NO.	TOTAL SHEETS
Hawaii	Haw	SDR 3(15)	1950	4	99

5-8-50
5-25-50

6-15-50
6-16-50

NOTE:

All buildings within Highway R/W to be moved by others.

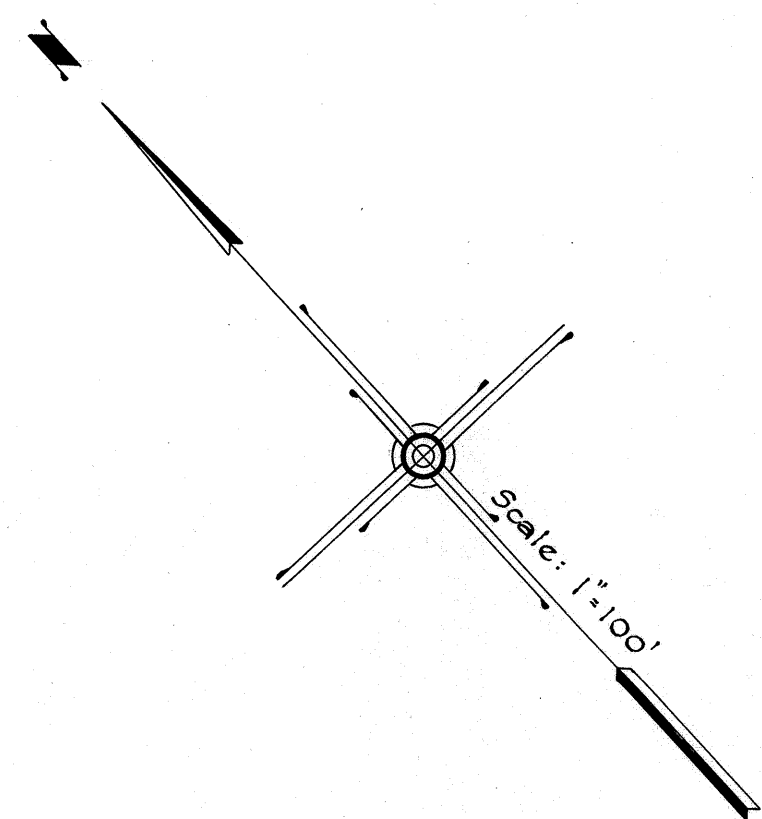


BEG. PROJ. NO. SDR 3(15)
STATION 0+00

Additional No. Plate for F.A. Marker SDR 3(15)

B.M. Δ on Abutment SW Corner of Akole Bridge E.I. 255.61




B.M. "O" Circle on SE Corner of Retaining Wall 125' left of Sta. 16+55 E.I. 245.66

Origin of Azimuth is HAIKU Δ

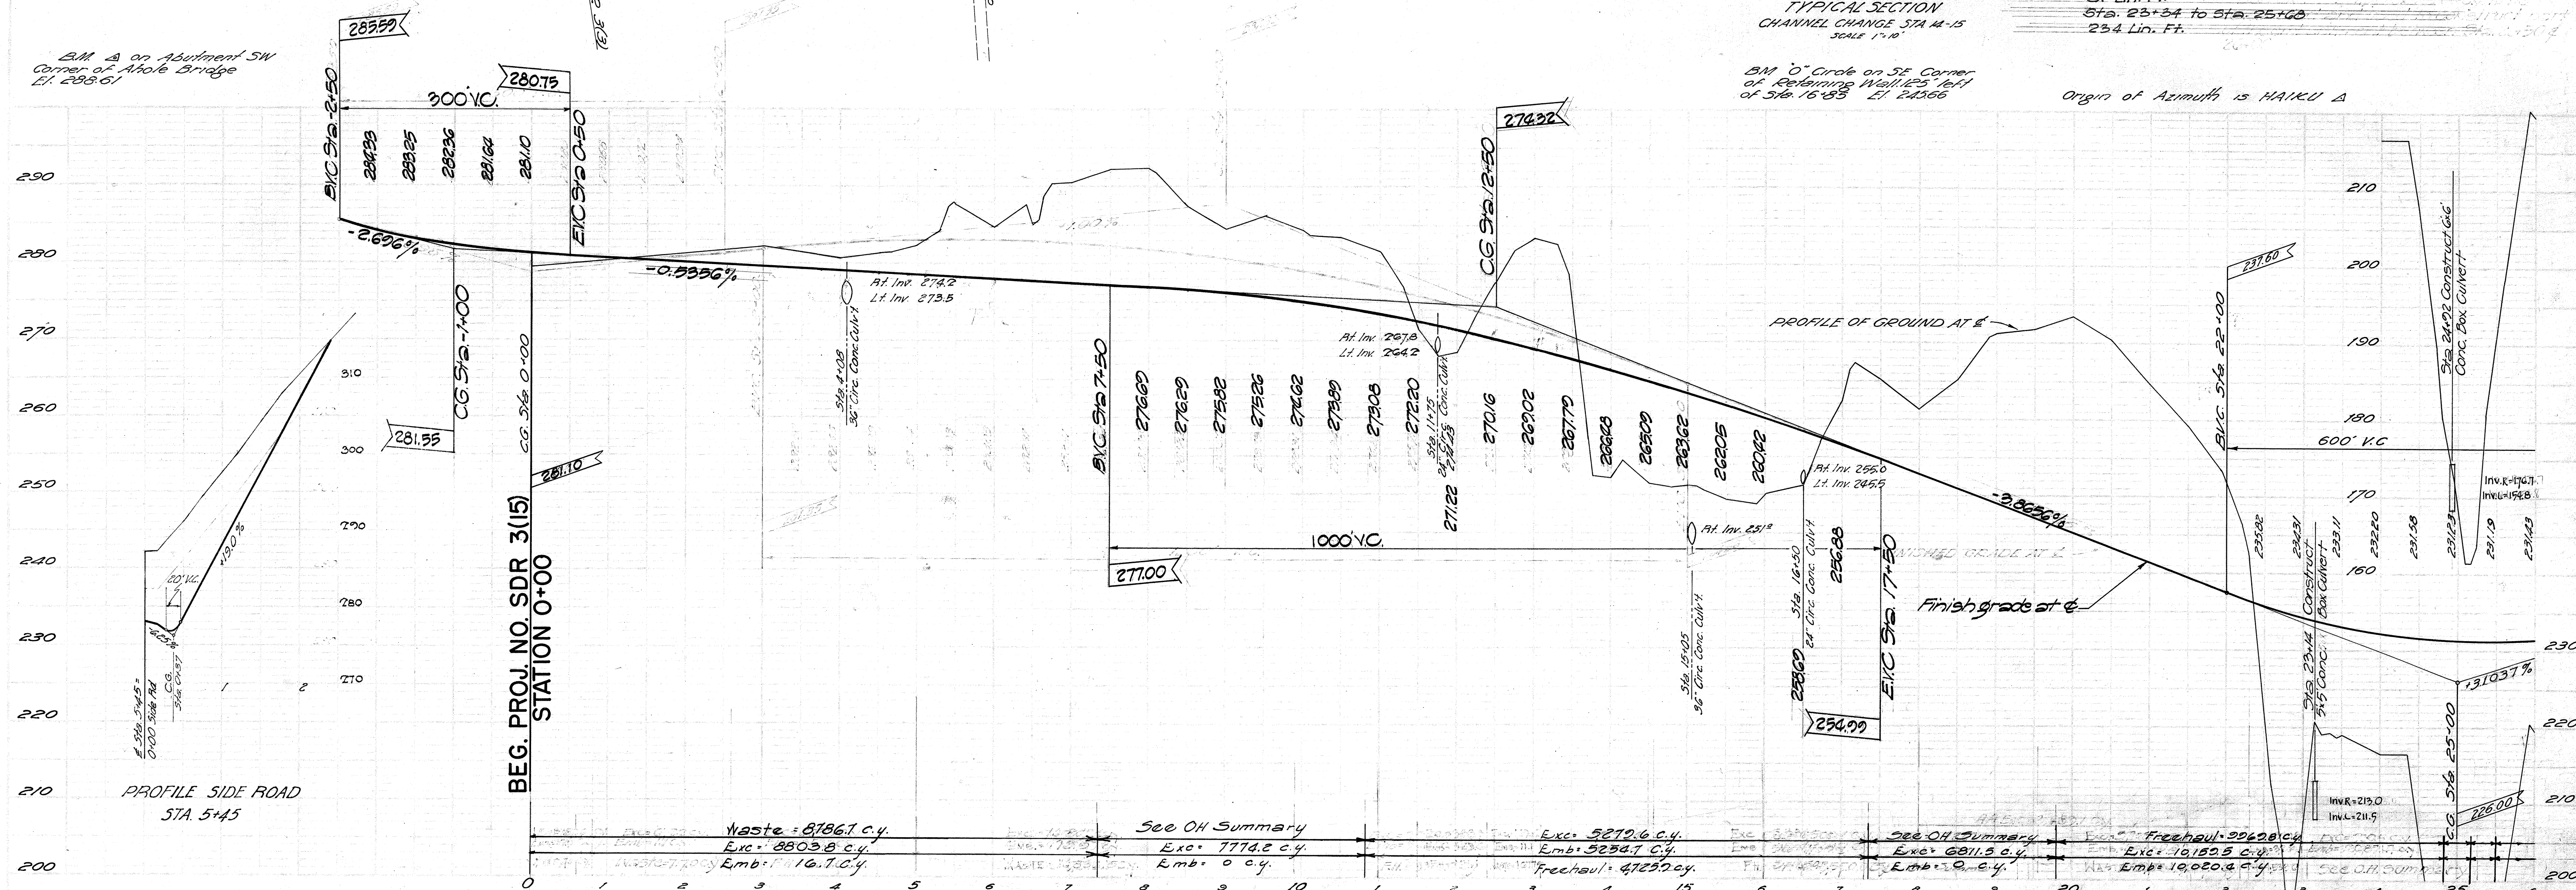

5401.4

Grades Revised 9.8.50
 Revised Grade
 Date 3/1/50

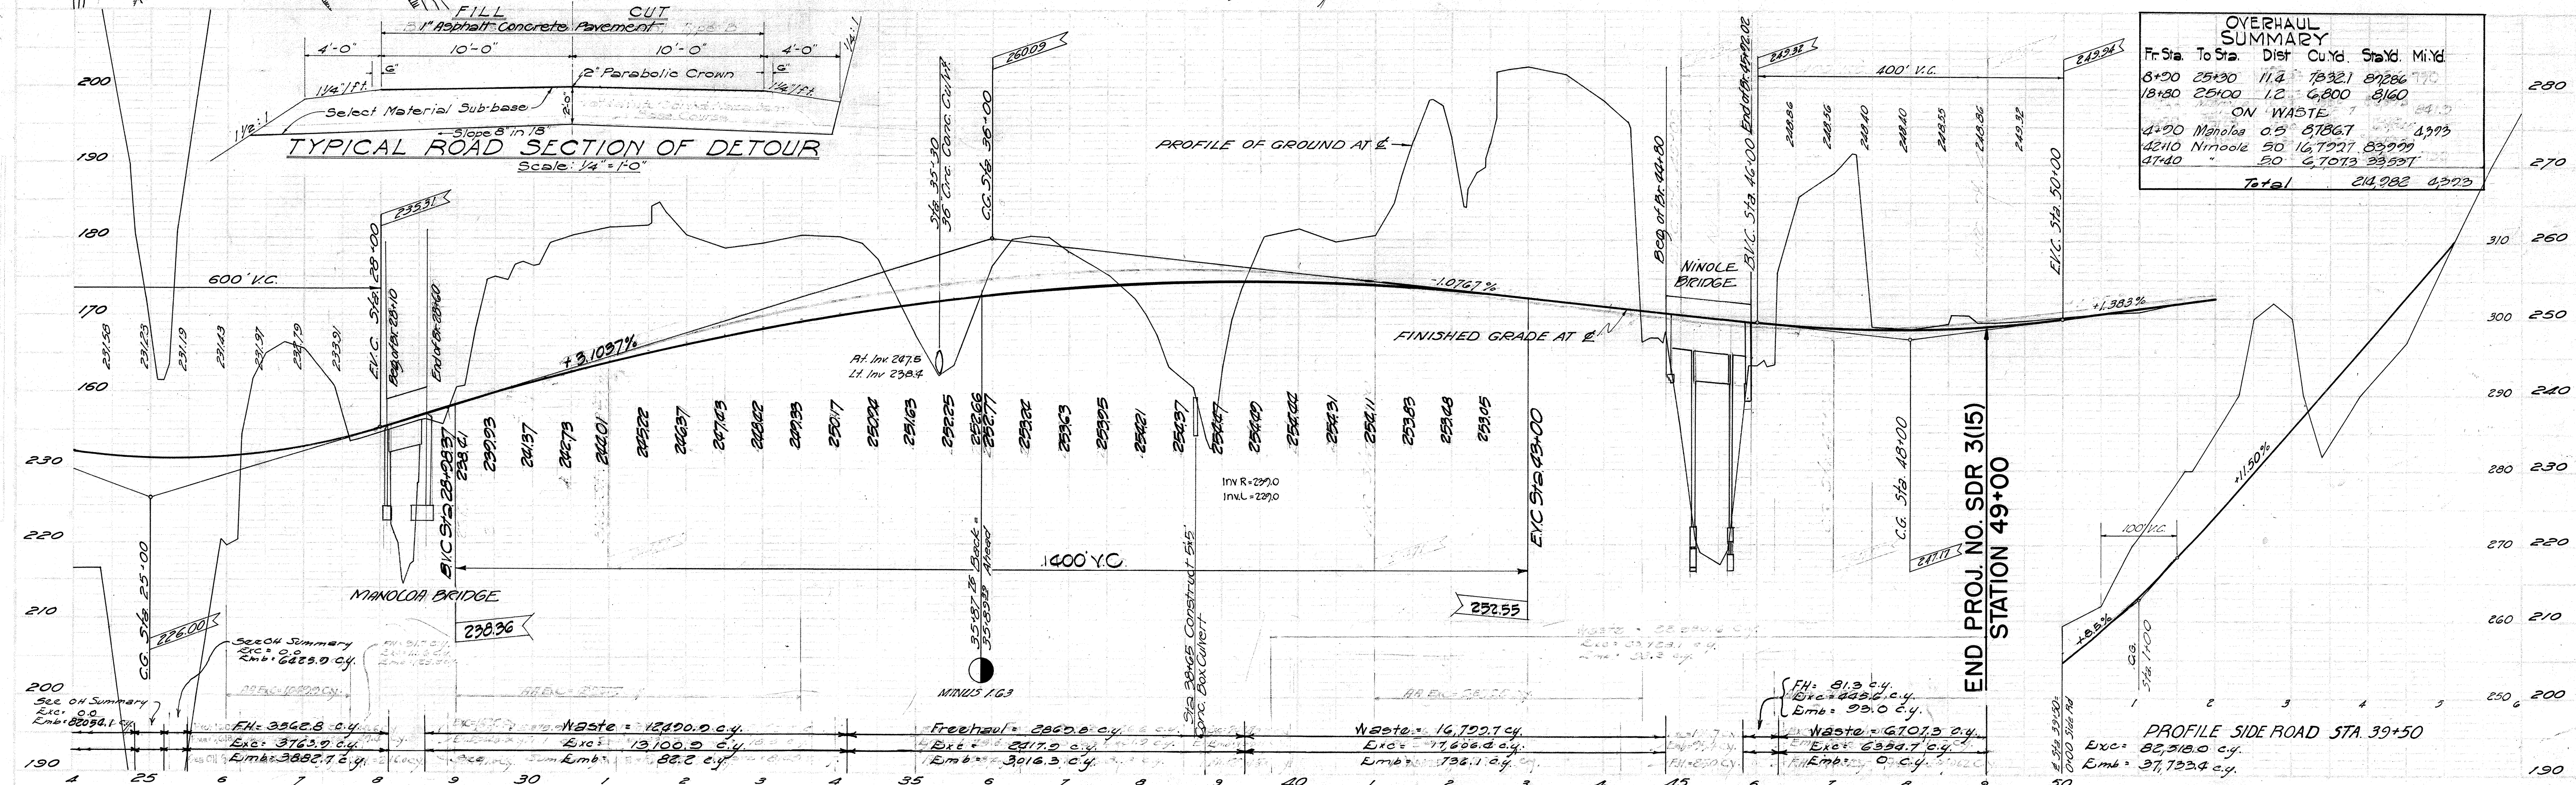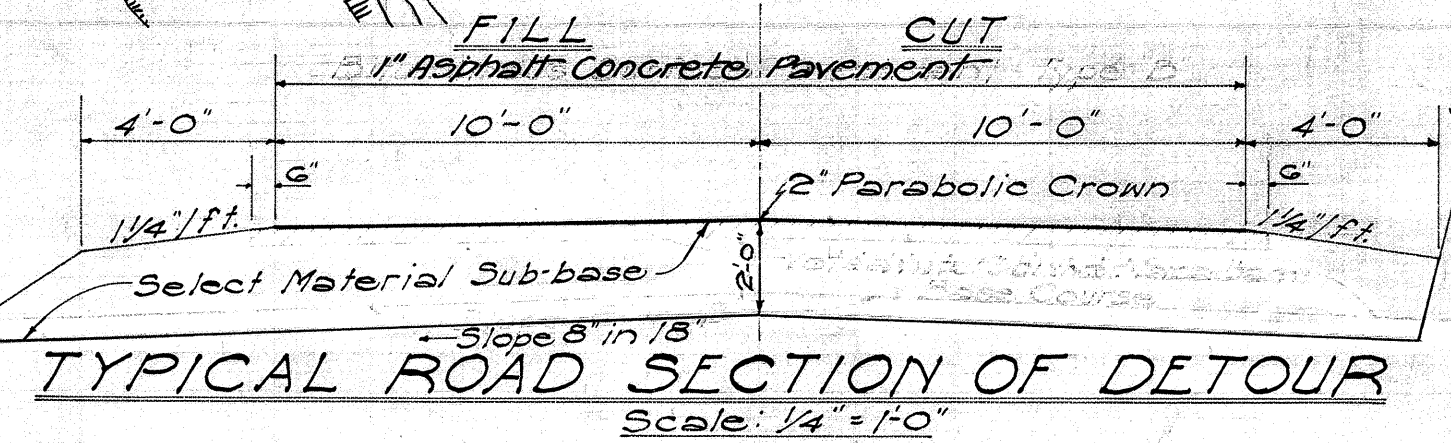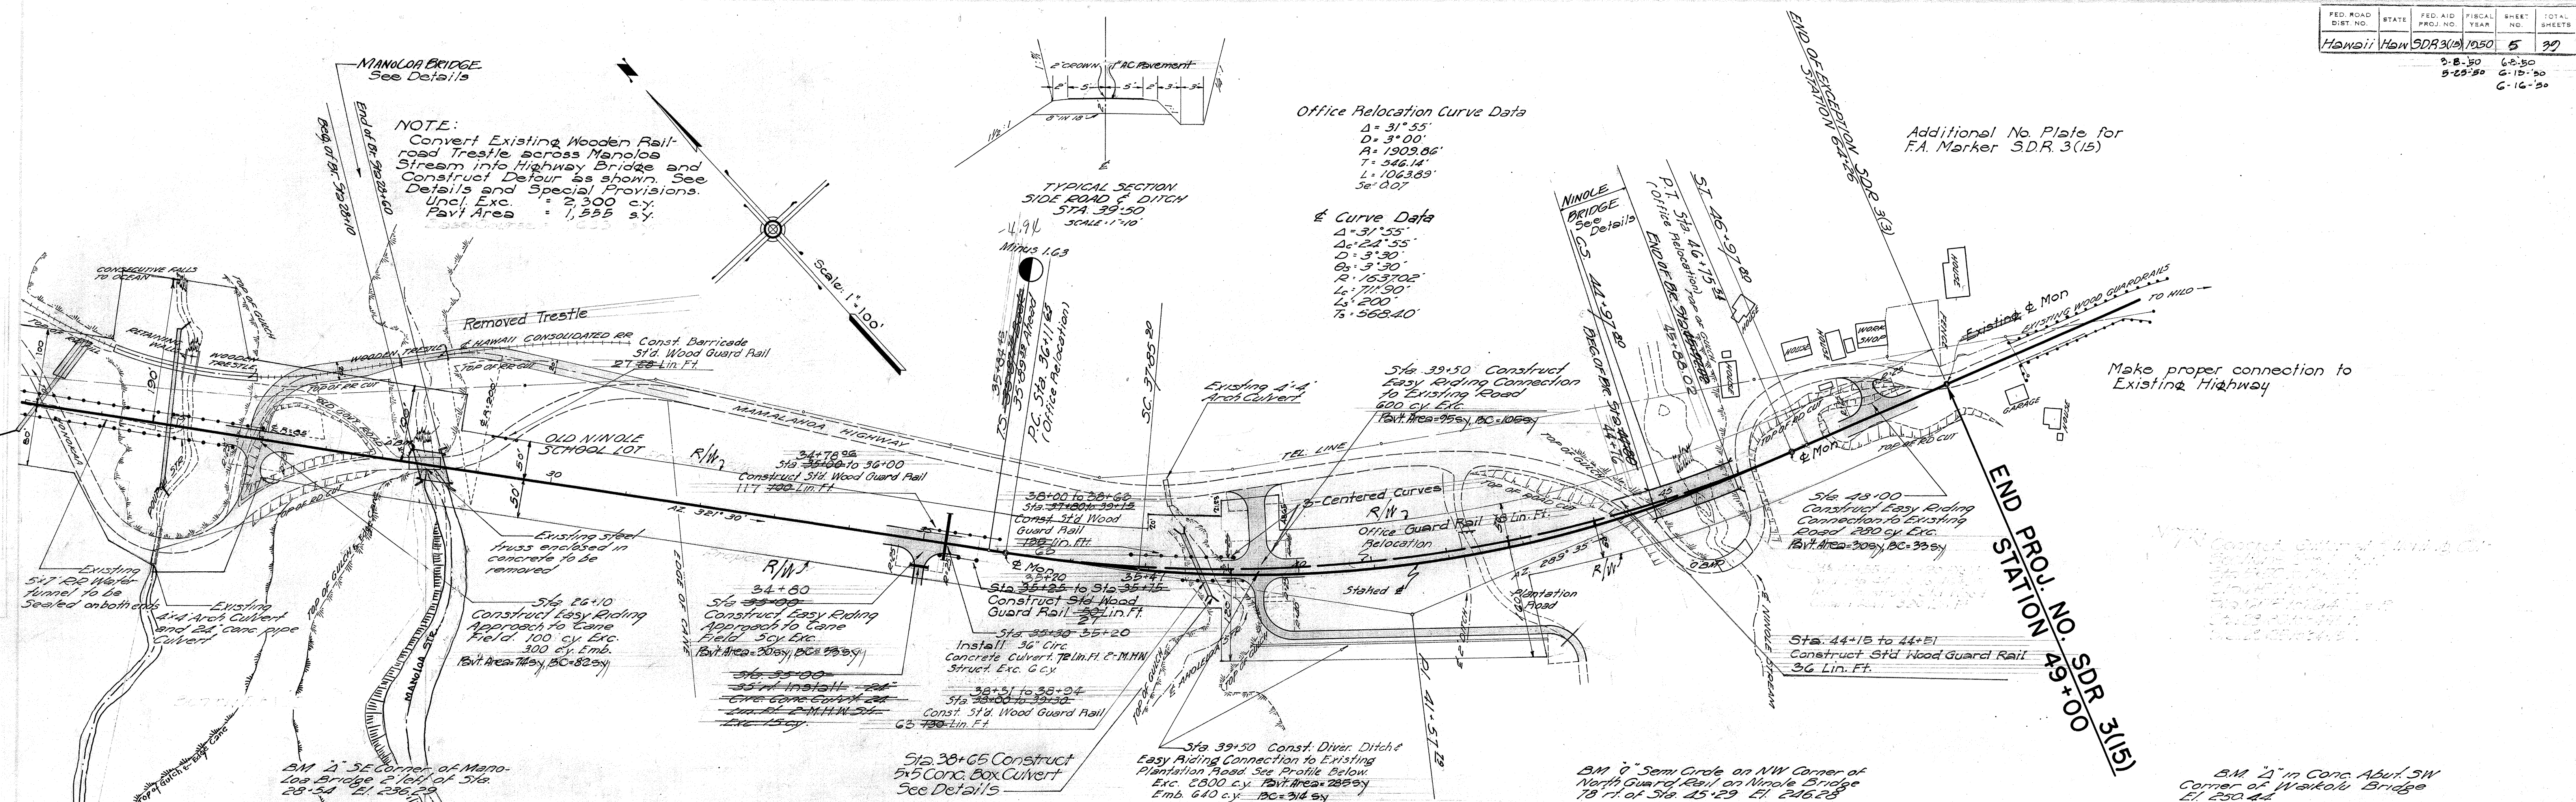

OVERHAUL SUMMARY

Fr. Sta.	To Sta.	Dist.	Cu. Yd.	Sta. Yd.	Mi. Yd.
8+50	25+30	11.4	7832.1	87286	170
18+30	25+00	1.2	6,800	8,160	
ON WASTE					
4+20	Manoloa	0.5	878.7	1,373	
42+10	Ninole	50	16,752.7	83,999	
47+40		50	6,701.2	33,507	
Total			214,282	6,273	

5401.5