
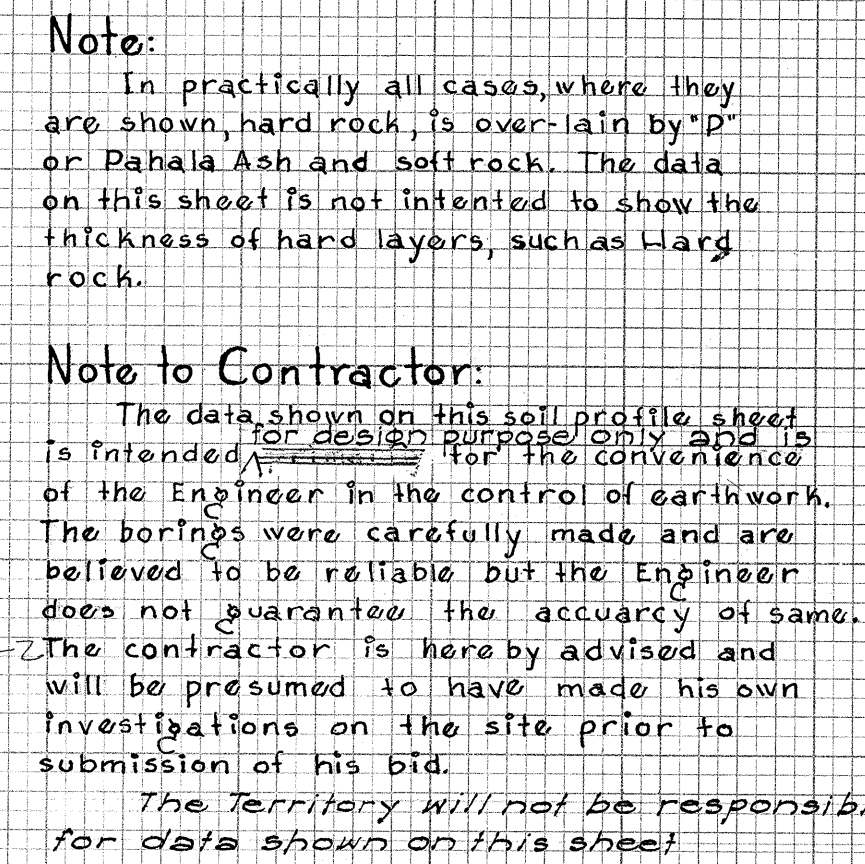


|                         |                                                                                         |          |            |
|-------------------------|-----------------------------------------------------------------------------------------|----------|------------|
| <b>FINAL<br/>SURVEY</b> | SURVEYED _____<br>PLOTTED _____<br>TEMPLATE _____<br>AREAS _____<br>AREAS CHECKED _____ | BY _____ | DATE _____ |
| <b>NOTE BOOK</b>        |                                                                                         |          |            |
| <b>NO.</b> _____        |                                                                                         |          |            |

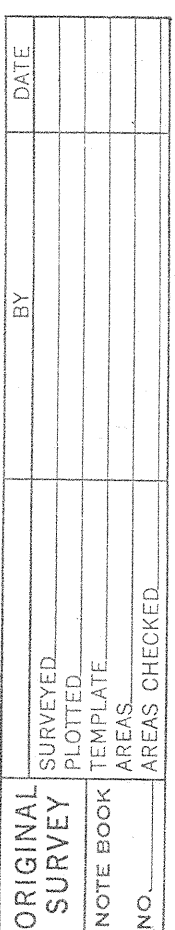

TERRITORIAL HIGHWAY DEPARTMENT  
TERRITORY of HAWAII  
SOIL PROFILE  
Hawaii Belt Road SDR 3(15)  
Scale: Hor. 1"=100' Nov. 1948  
Ver. 1"=100'  
Borings by = R. Ahing