
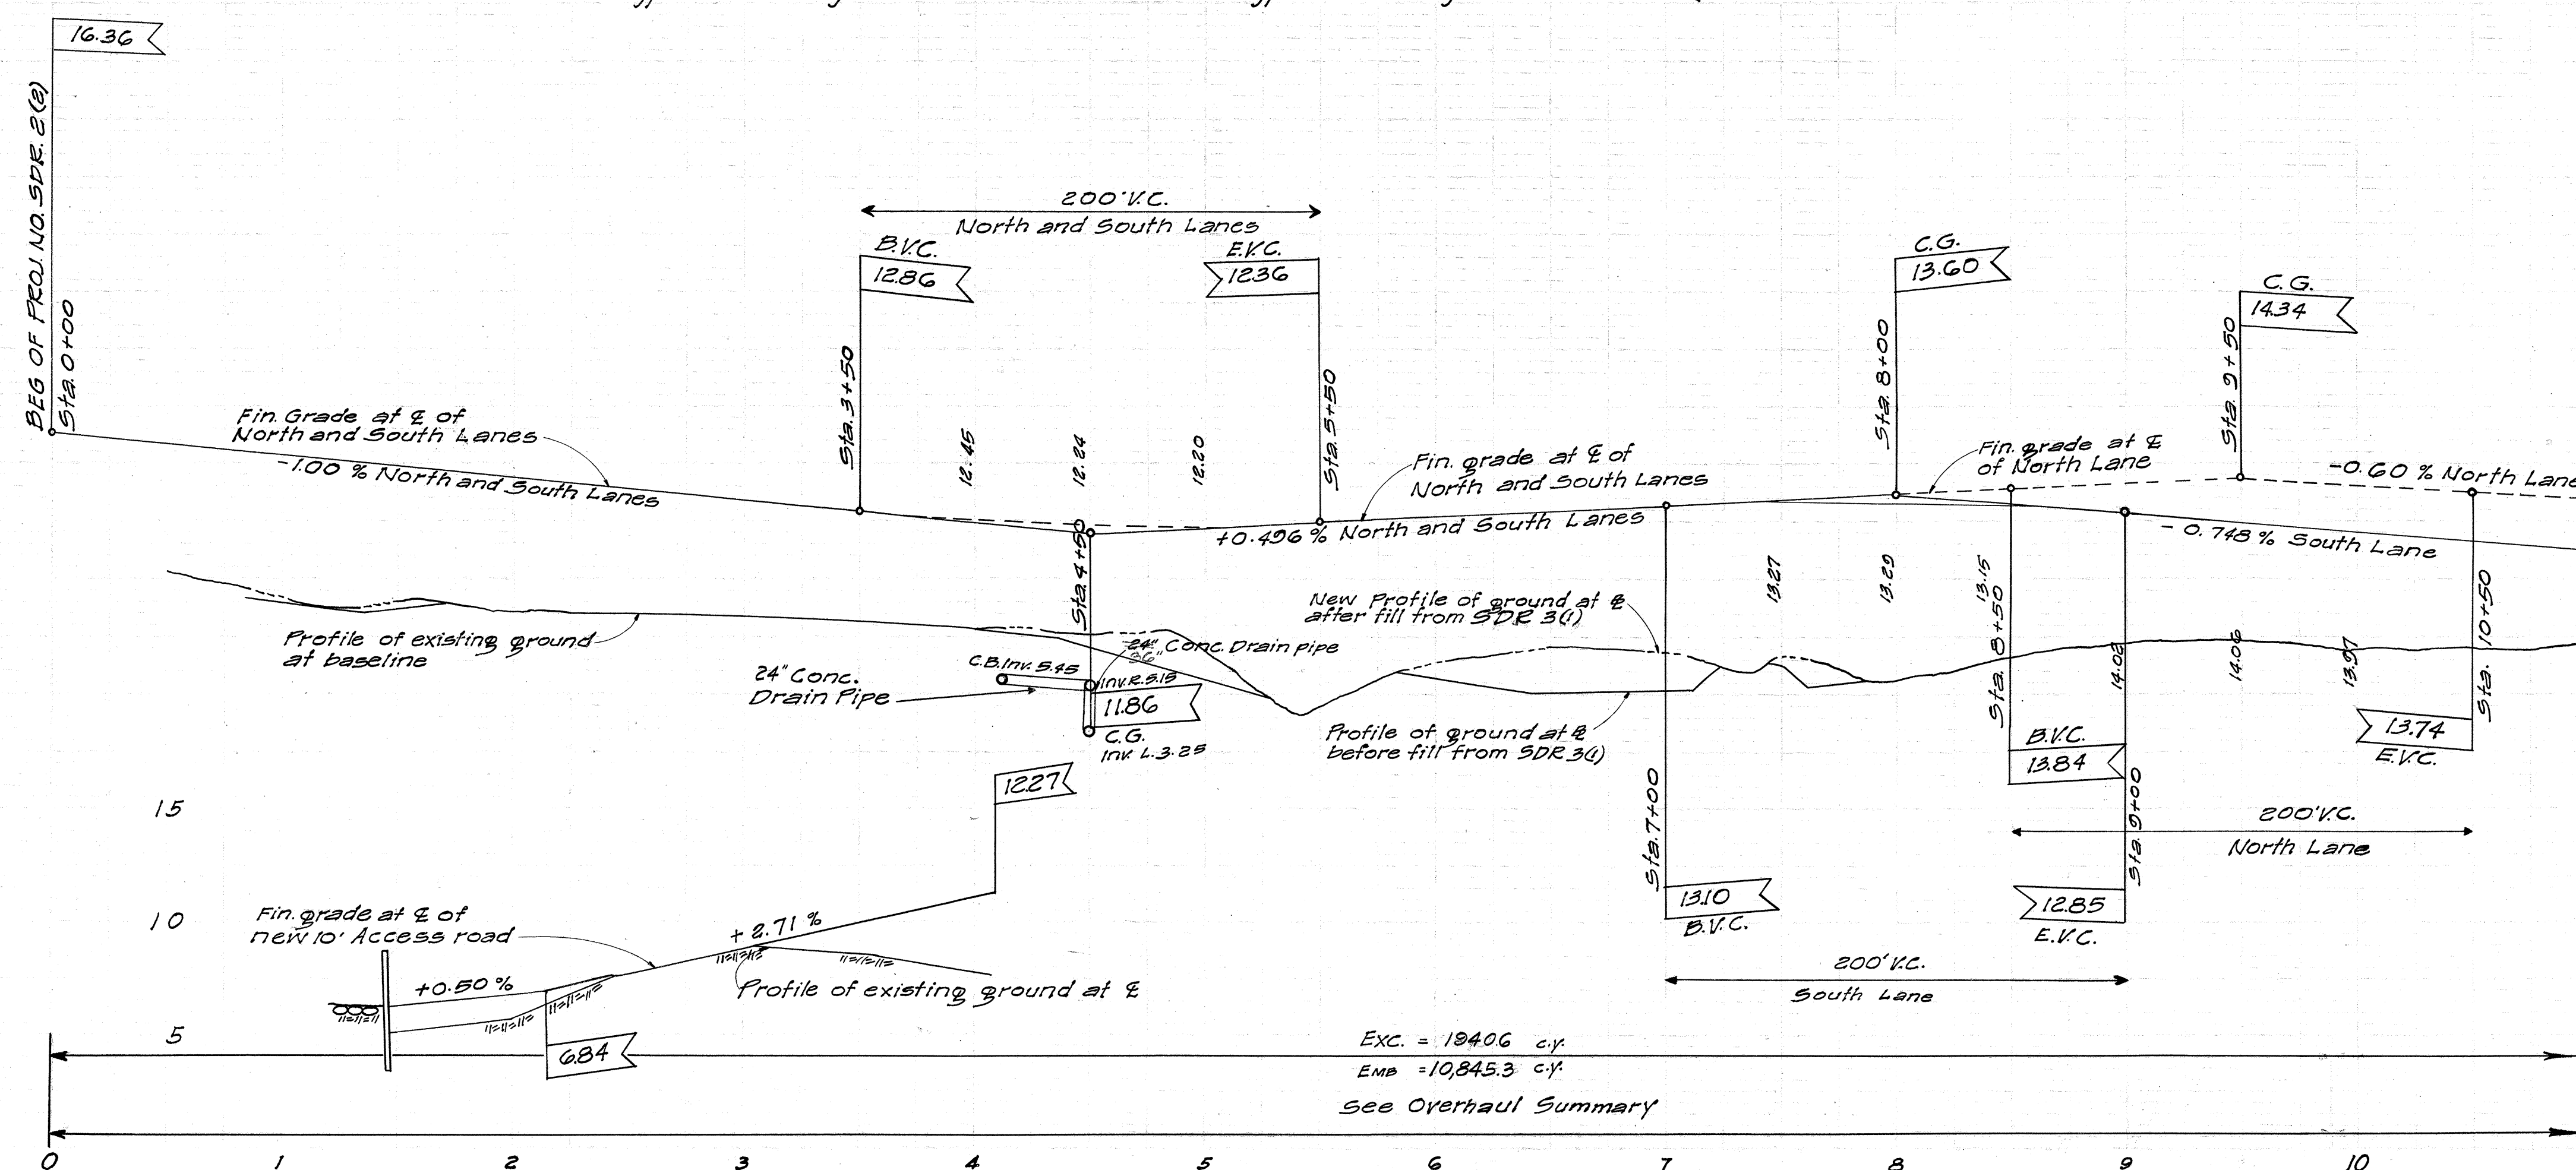
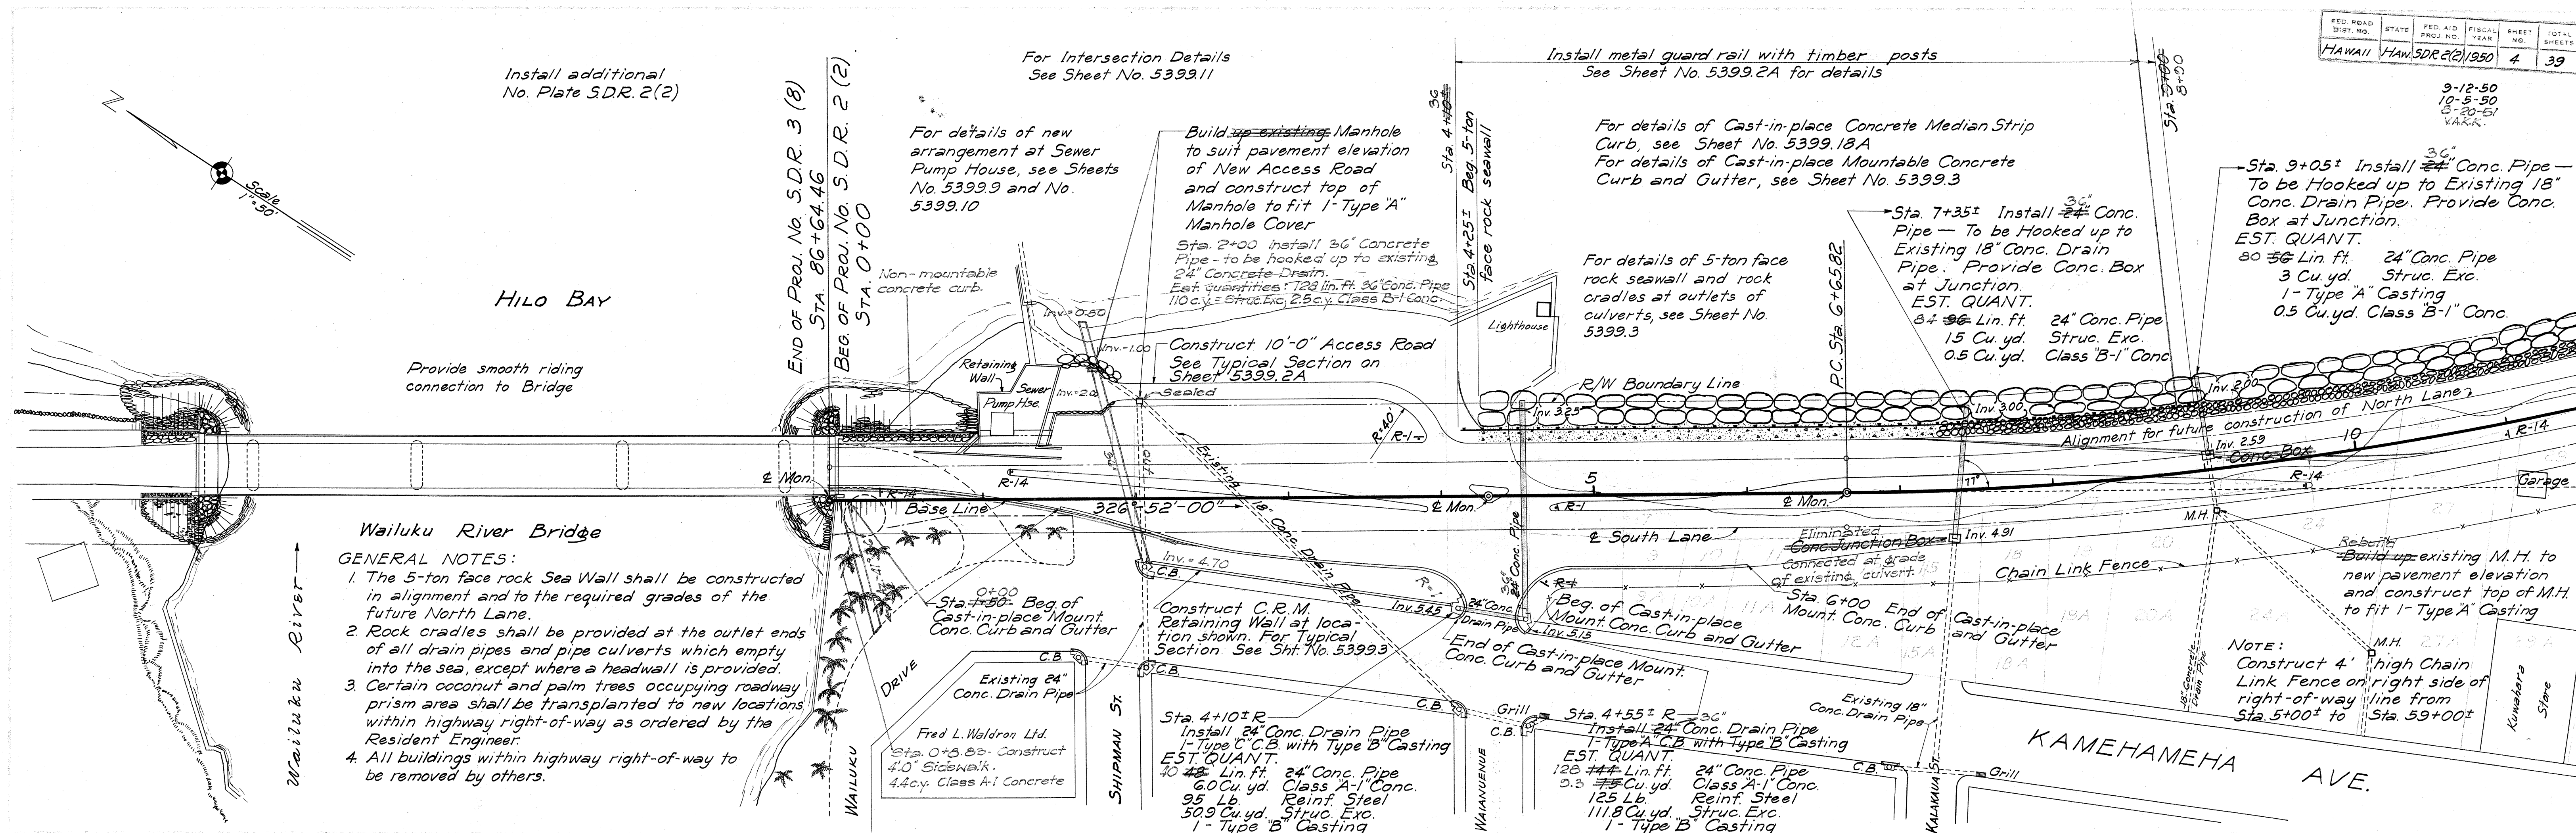
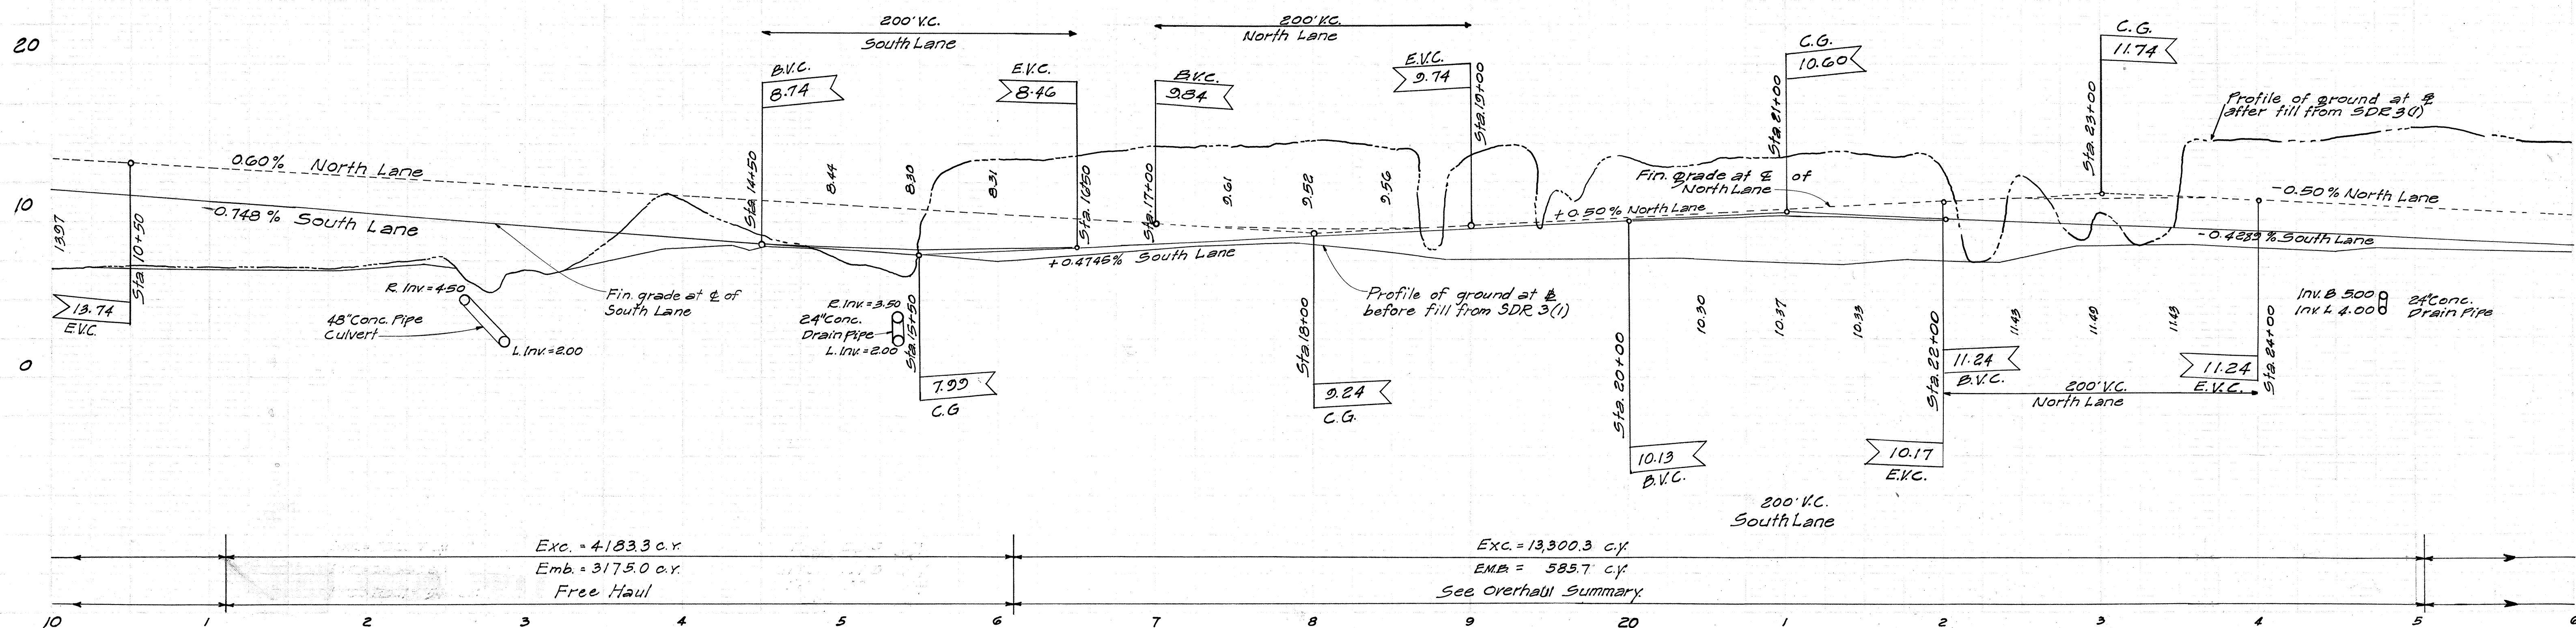


9-12-50
19-5-50
8-20-51
V.A.K.K.


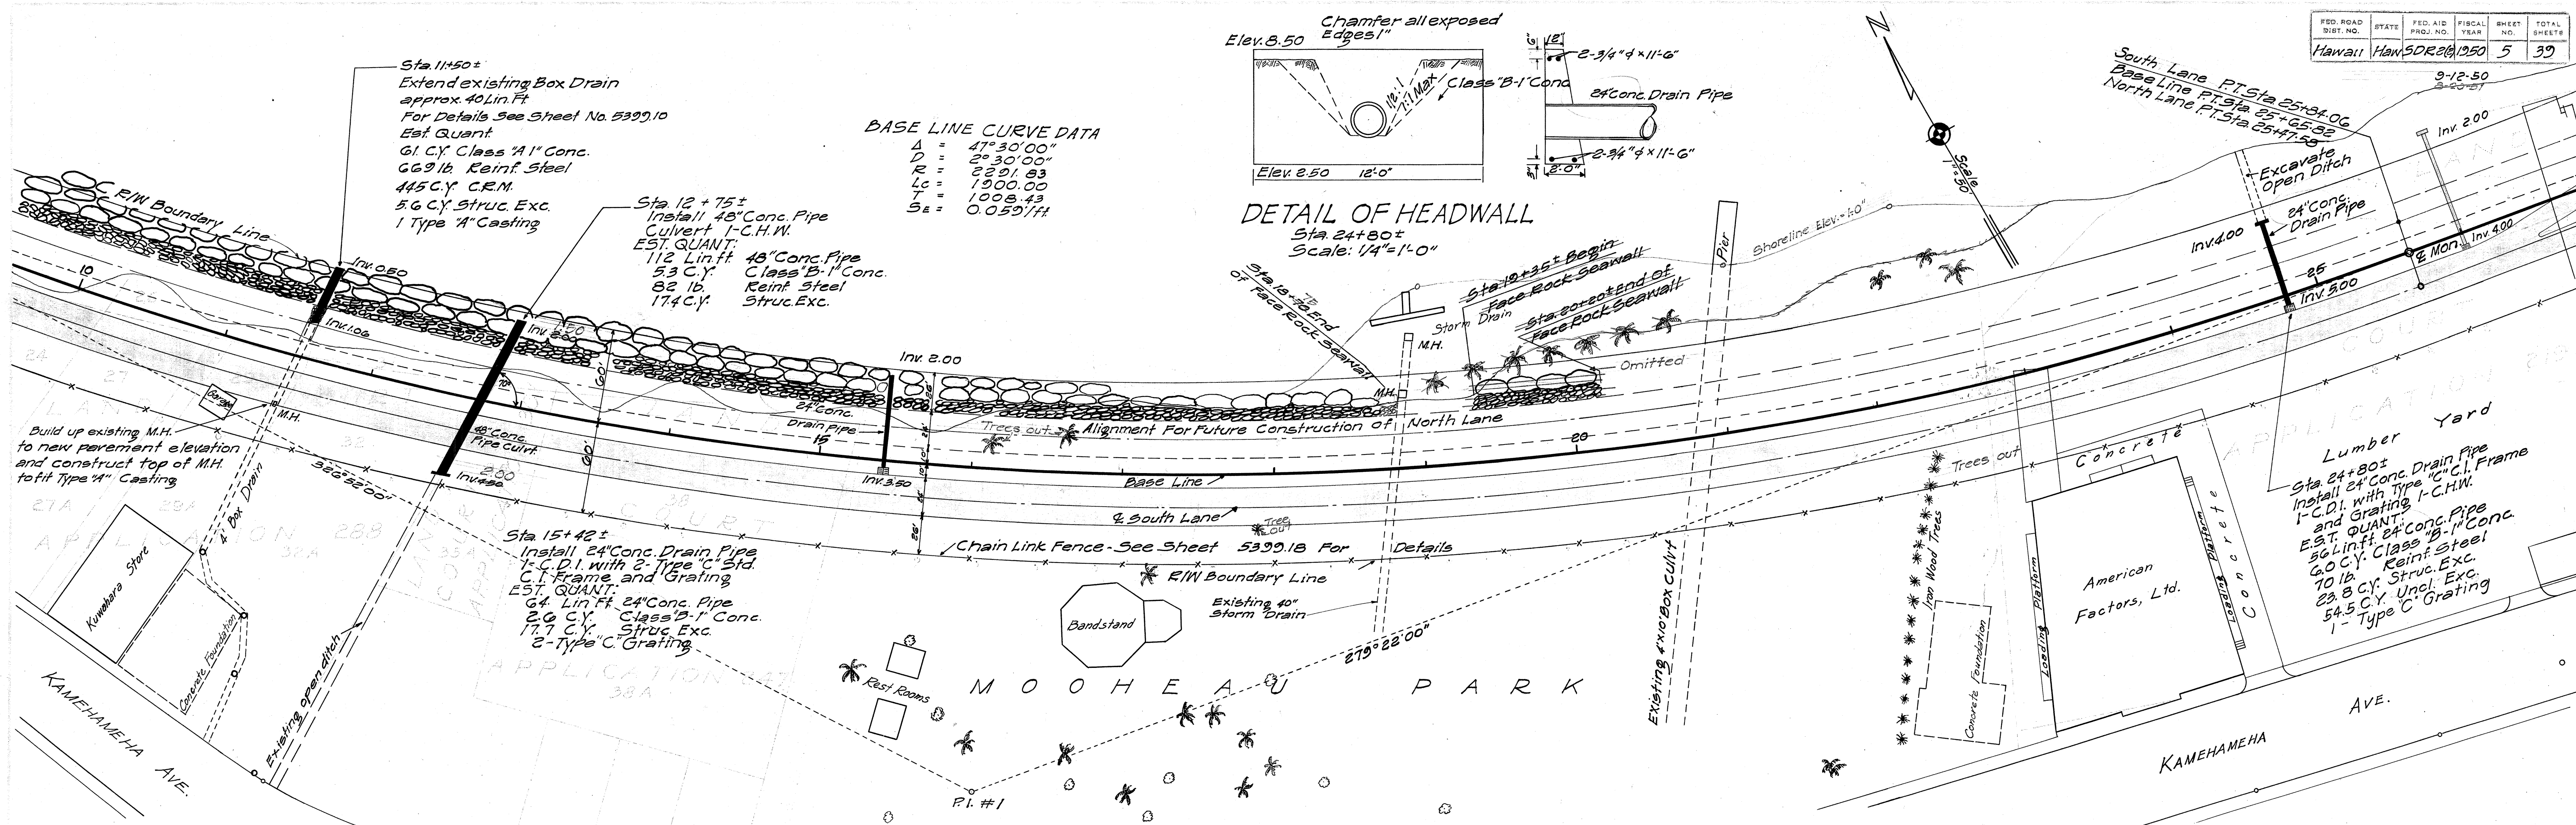


Note: The stations shown on the Profile are taken independently. That is stations shown for the North Lane profile are North Lane stations and stations shown for the South Lane profile are South Lane stations



FED. ROAD DIST. NO.	STATE	FED. AID PROJ. NO.	FISCAL YEAR	SHEET NO.	TOTAL SHEETS
Hawaii	Haw	SDR 26	1950	5	39




$$\overset{4}{5} \overset{5}{3} 9 9 . 5$$

9-12-50
10-5-50

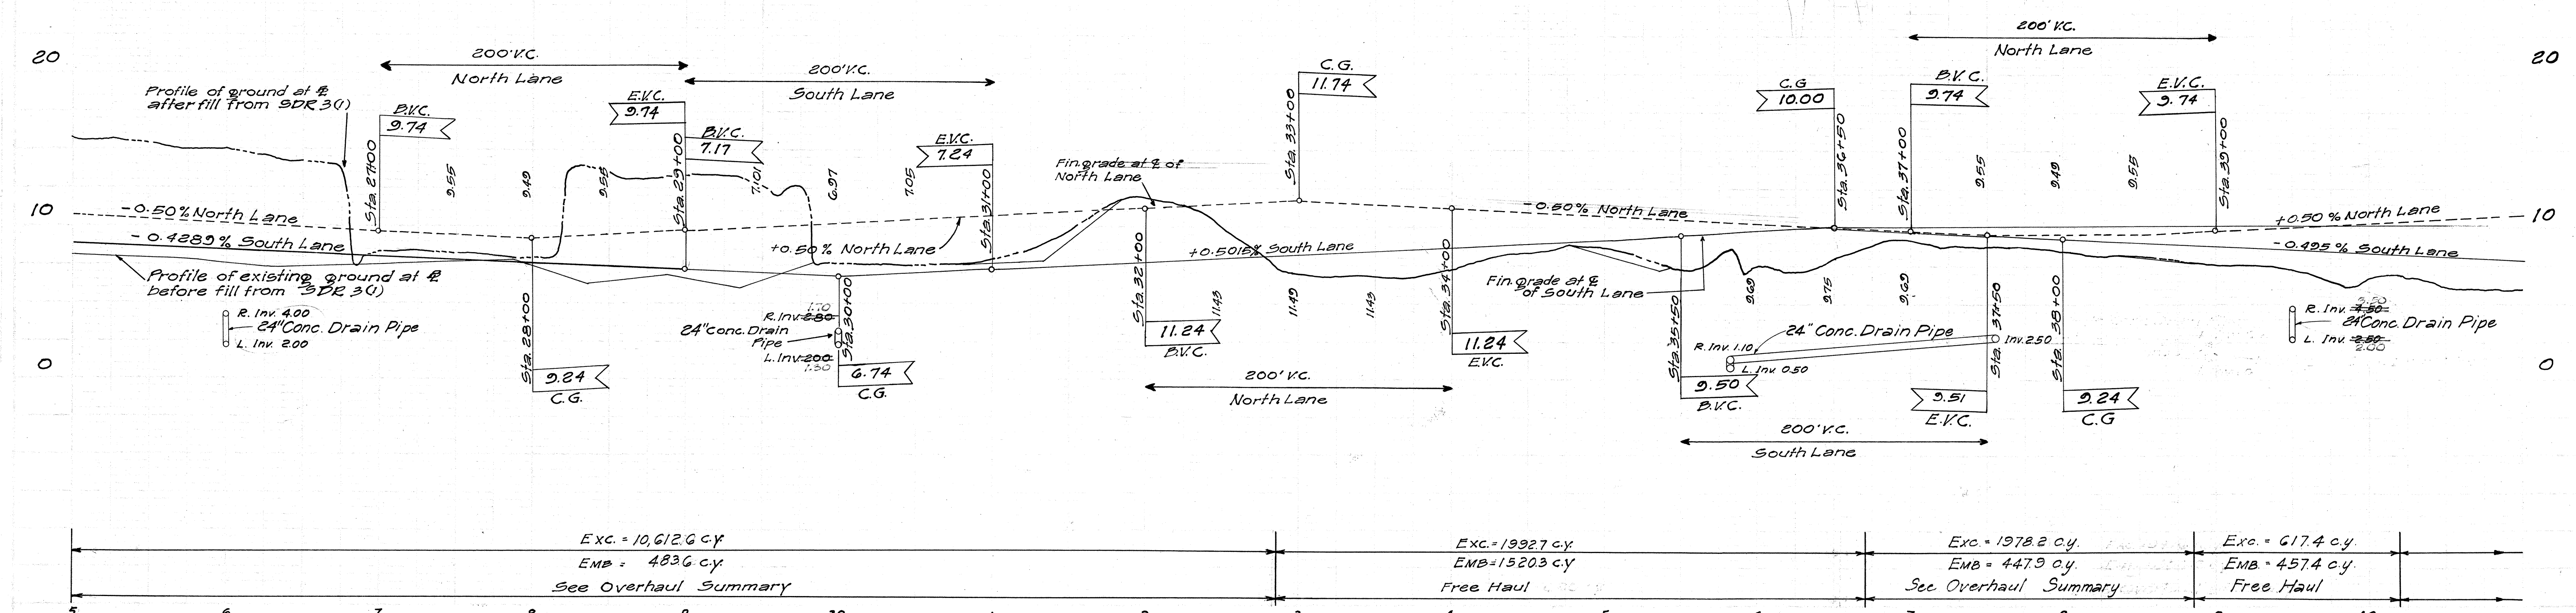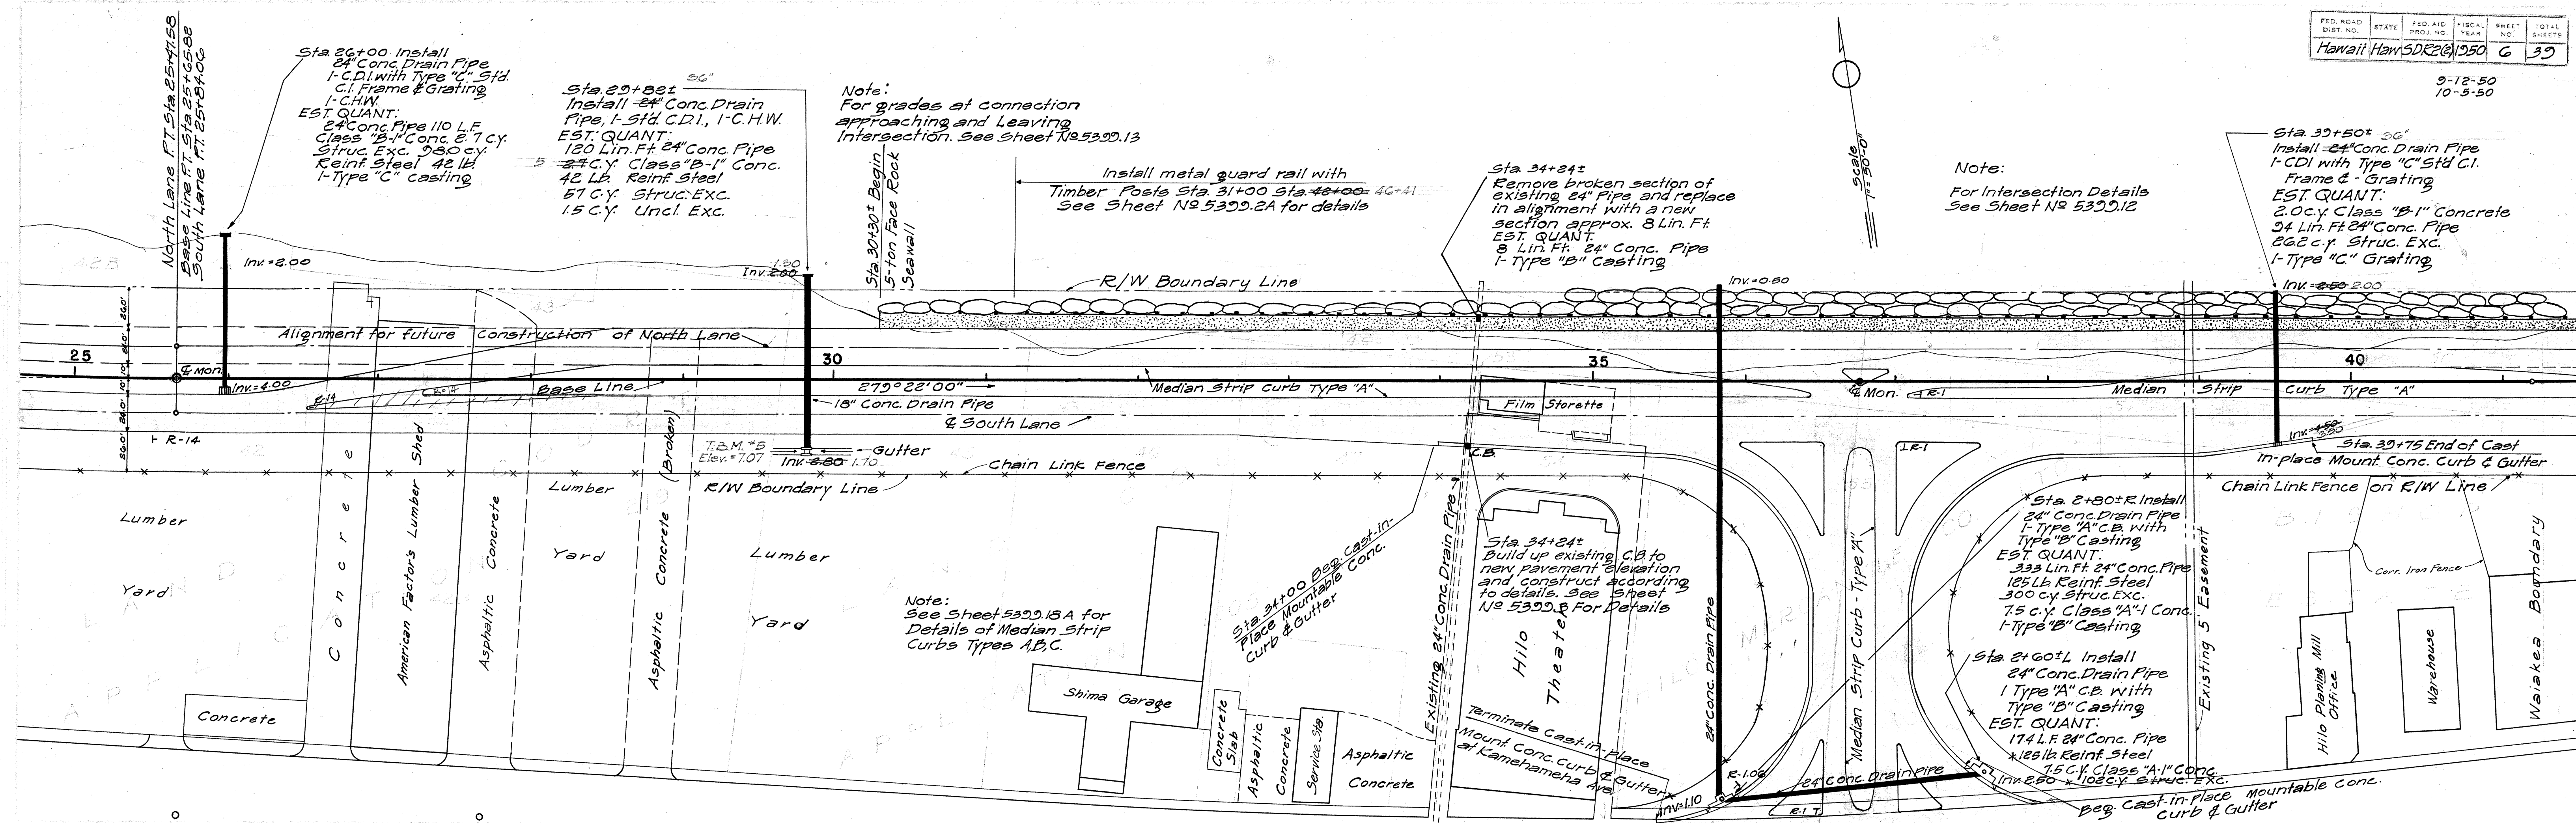

5399.6

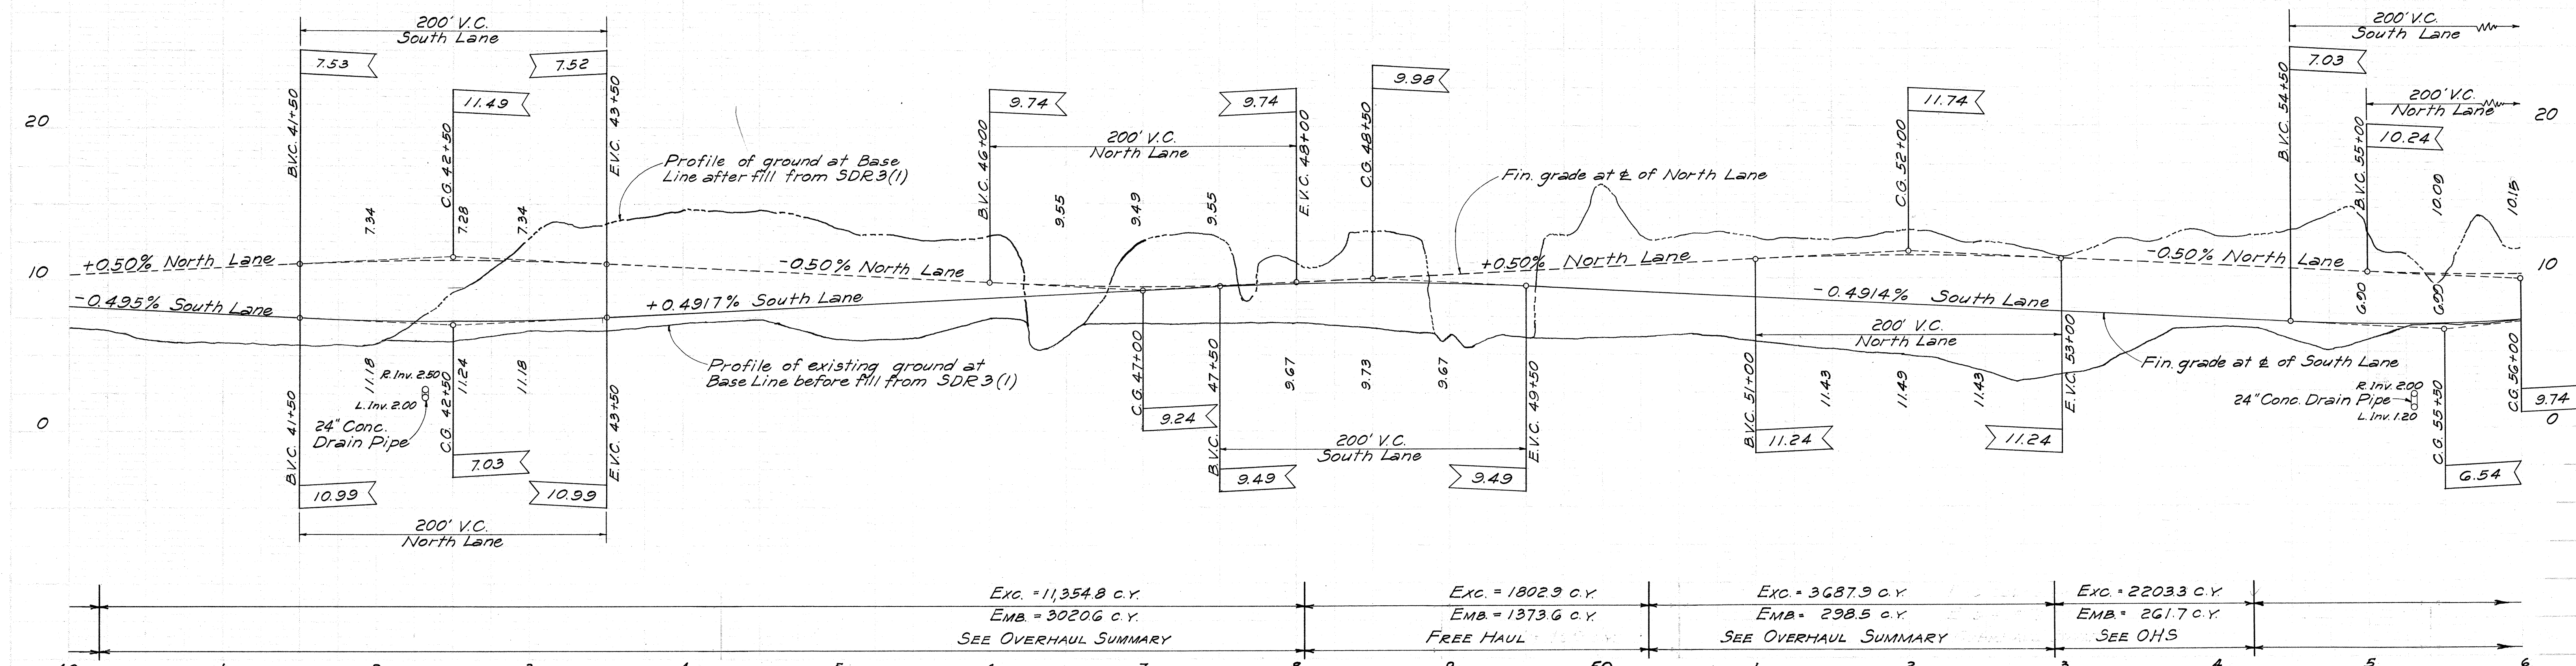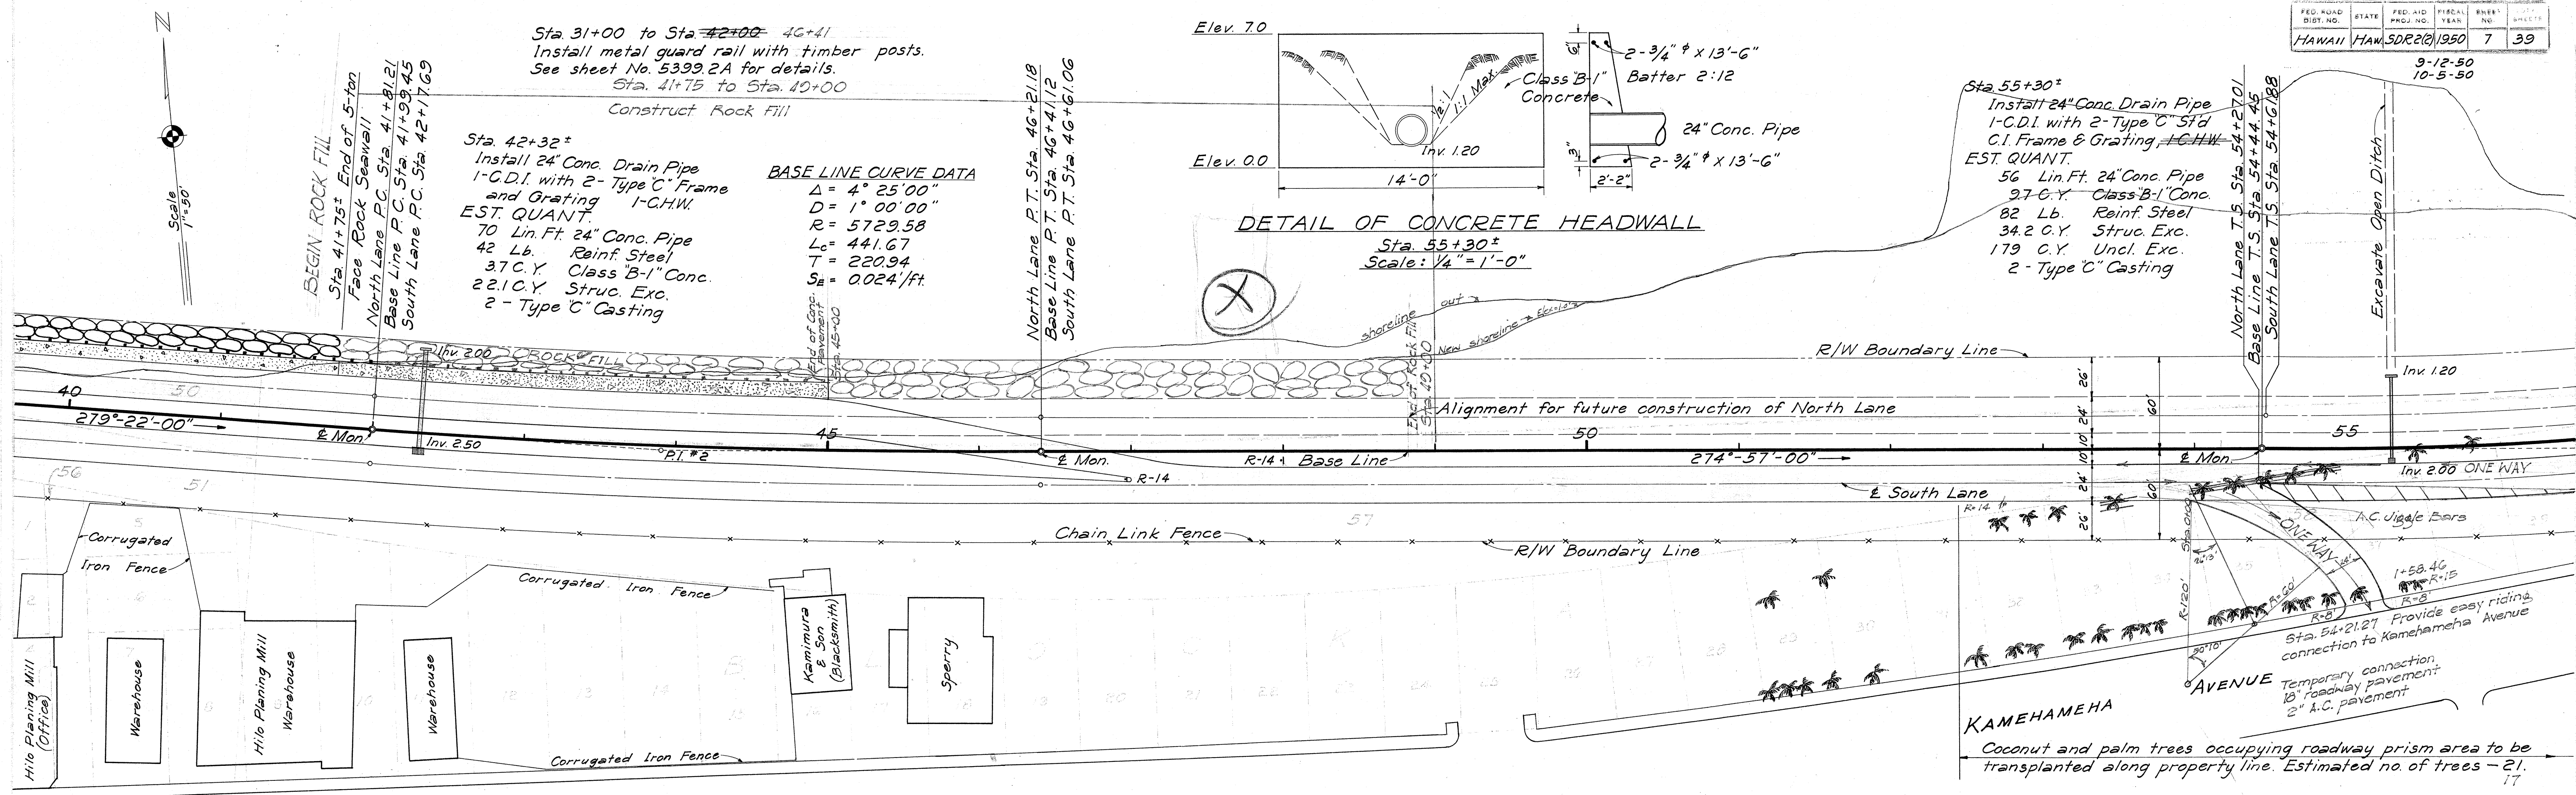

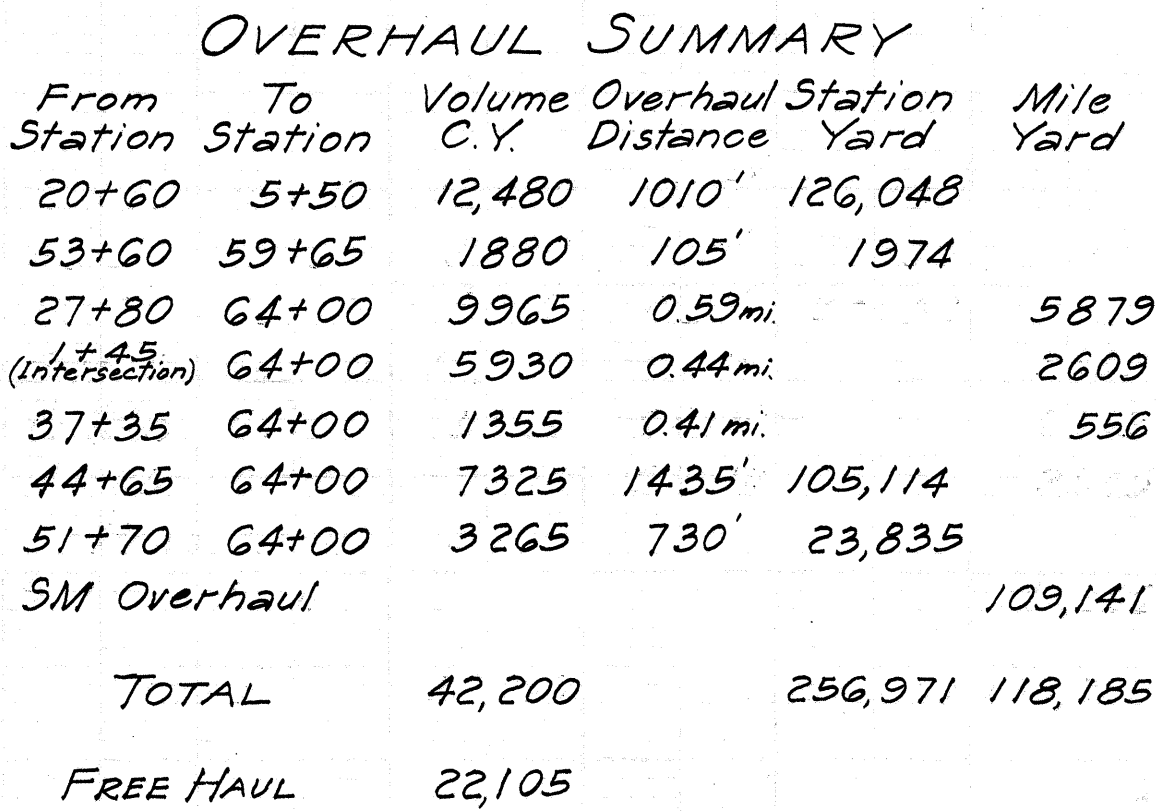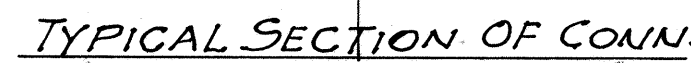

5399.8