
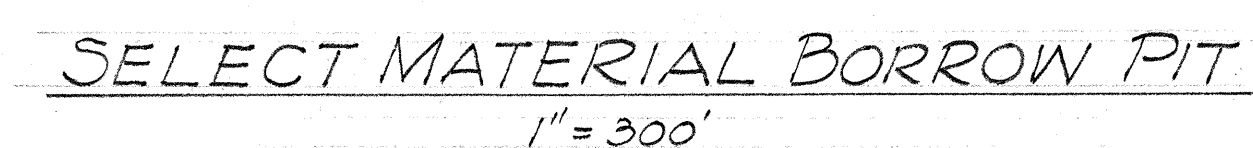
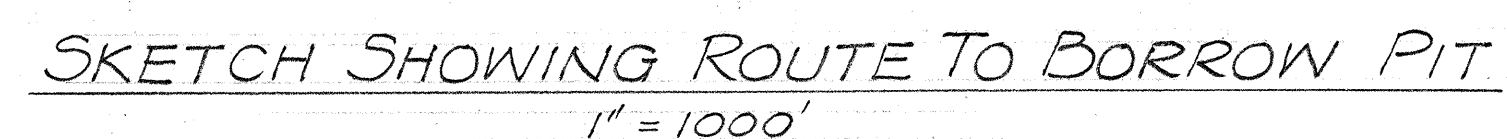
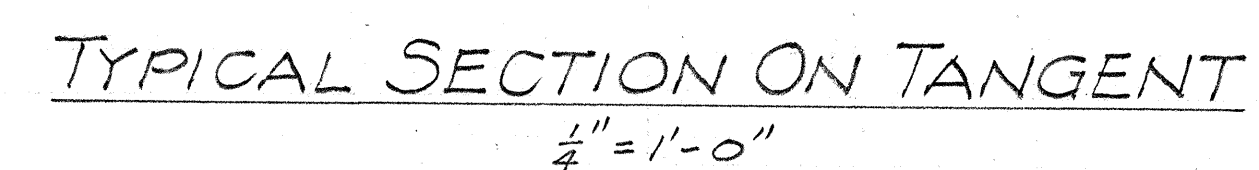


Note: Shoulder width shall be 10 feet on fill and 9 feet on cut.

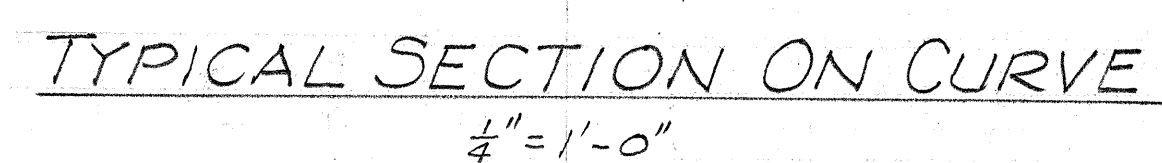

TERRITORIAL HIGHWAY DEPARTMENT
TERRITORY OF HAWAII
TYPICAL SECTION AND
BORROW PIT SITE
SDR3(1) Unit 2
Oct. 25, 1950 Honolulu T.H.