


FED. ROAD DIST. NO.	STATE	FED. AID PROJ. NO.	FISCAL YEAR	SHEET NO.	TOTAL SHEETS
Hawaii	Haw	SDR 3(13)	1950	3B	304

Inserted 1/22/51

SHEET No. 2 OF 2 SHEETS

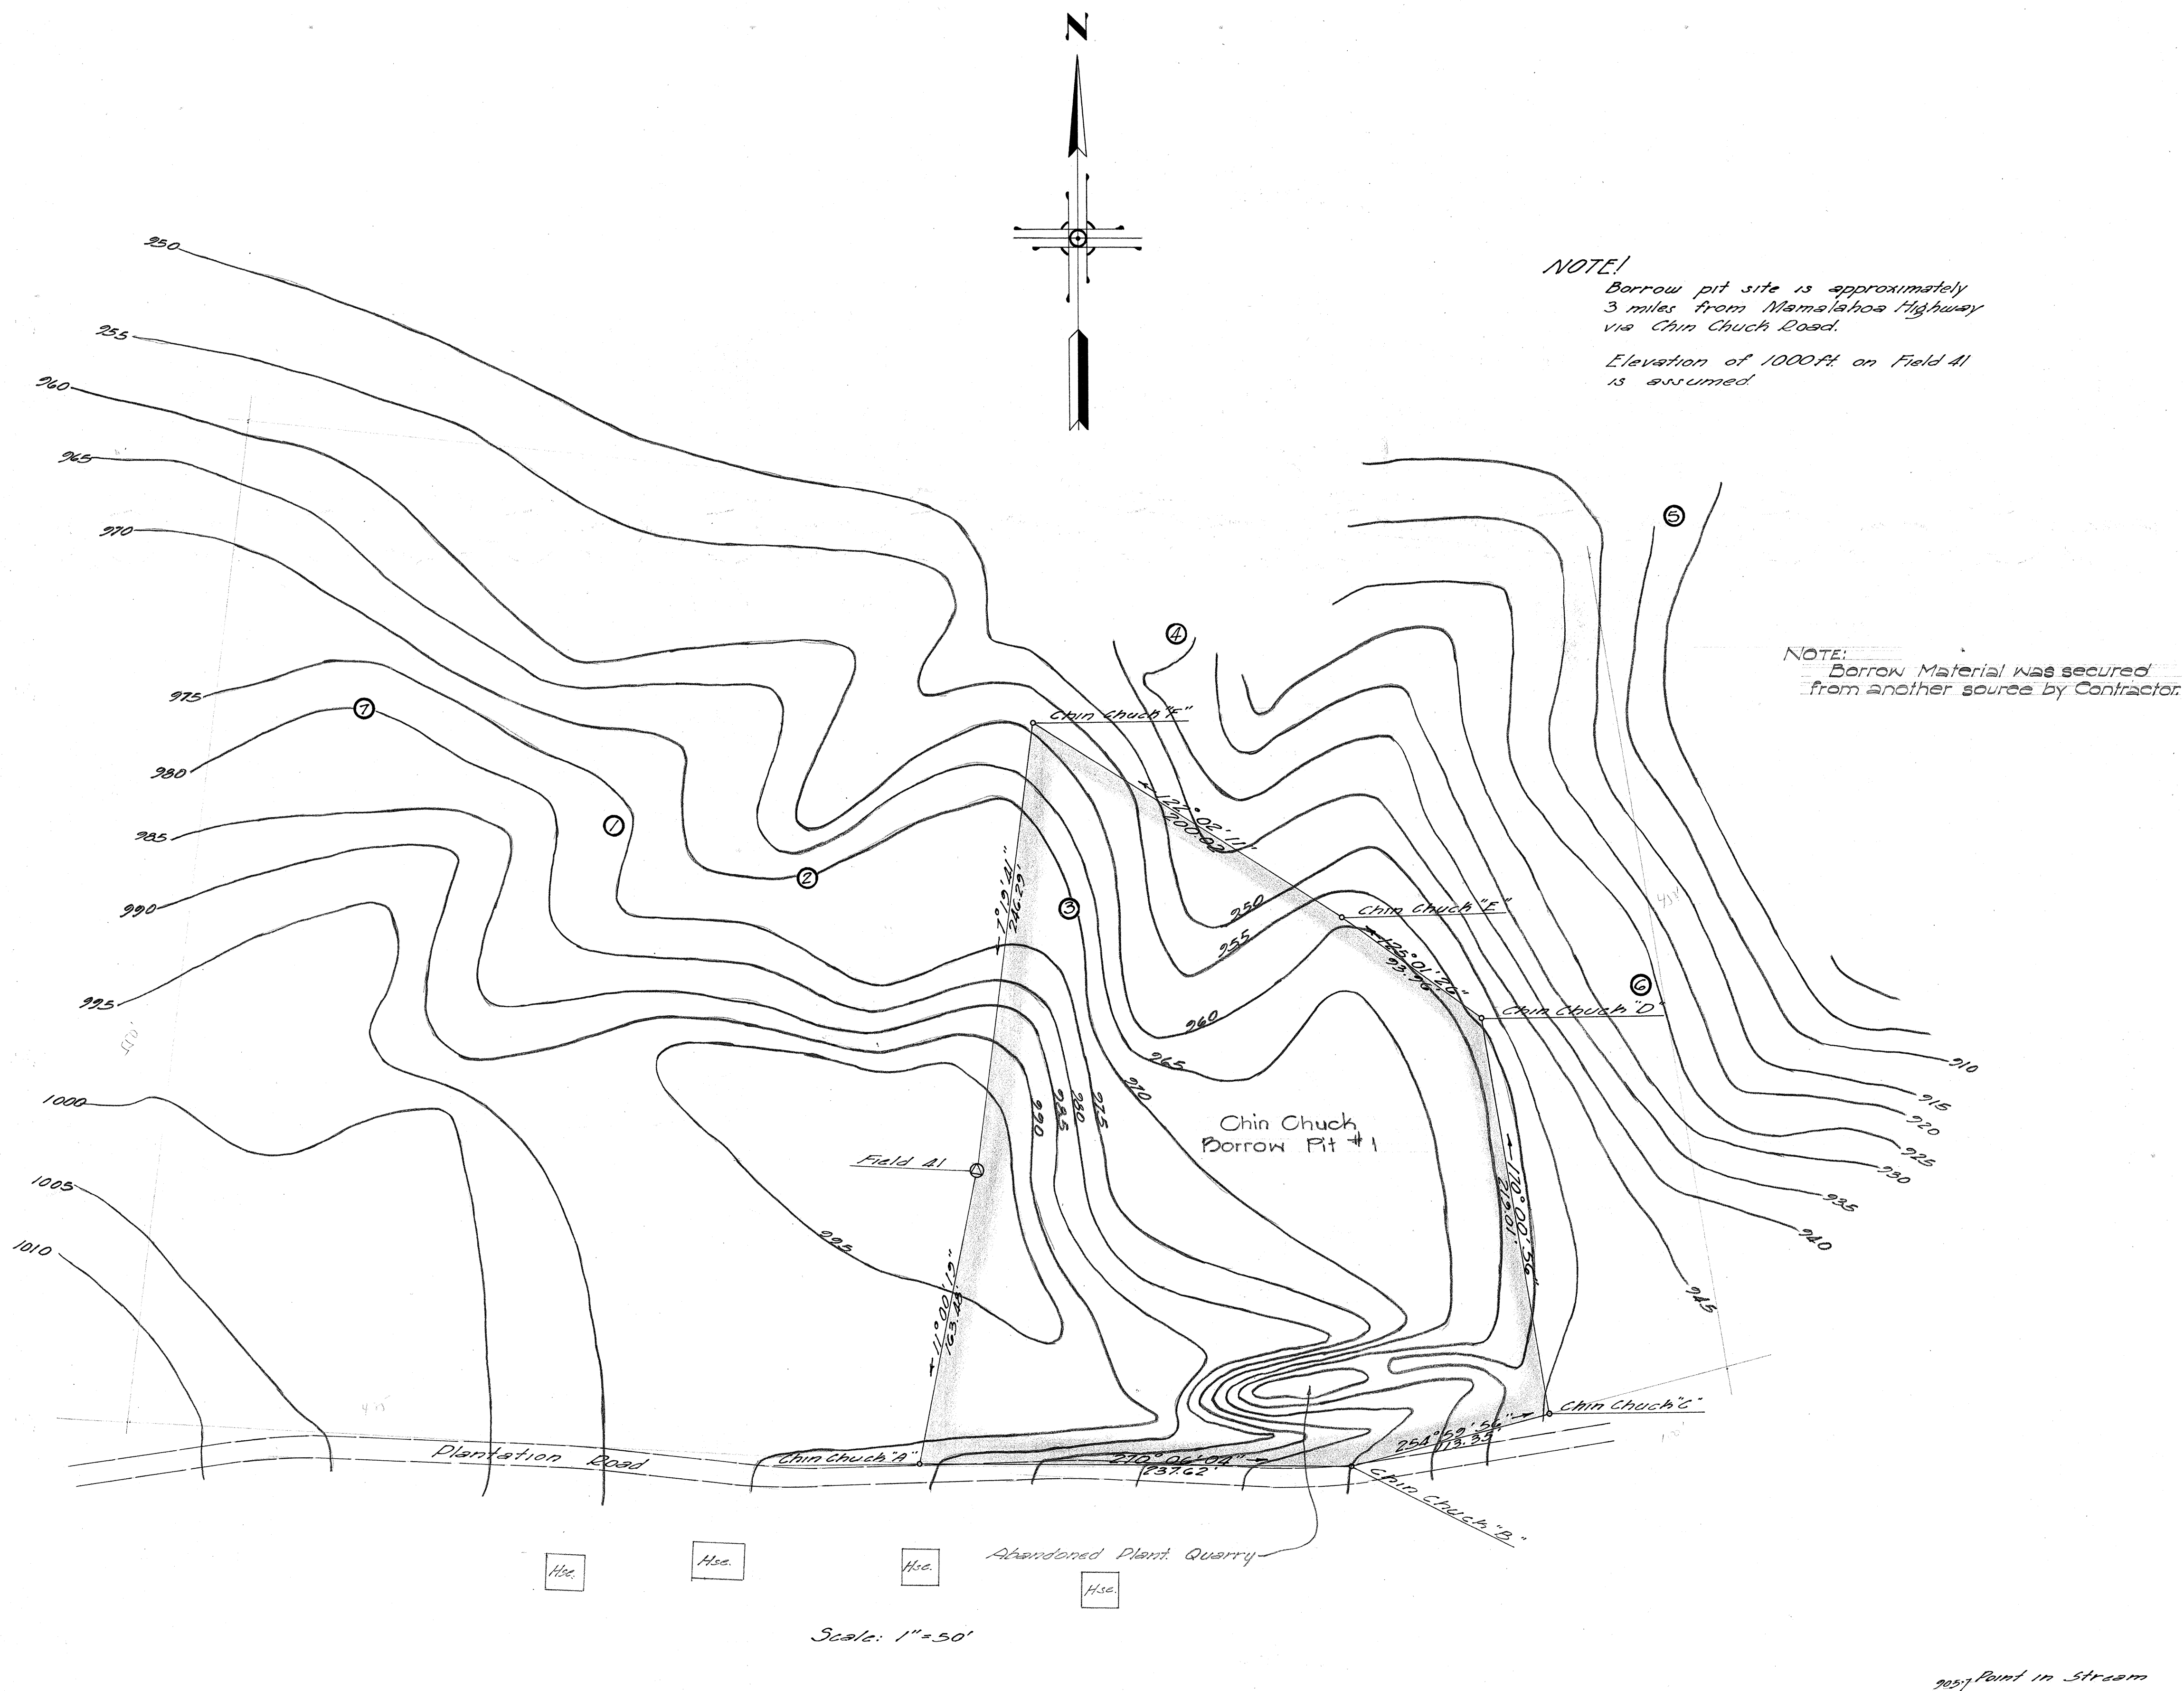

Scale: Vert. 1" = 10'

- 

 No gravel & Volcanic Ash
 Volcanic Ash
 Clinker
 Mud rock & Clinker

ORIGINAL PLAN	SURVEY PLOTTED BY.....	DATE.....
NOTE BOOK	DESIGNED BY.....	"
	DRAWN BY.....	"
	TRACED BY.....	"
	QUANTITIES BY.....	"
No.	CHECKED BY.....	"
	CHECKED BY.....	"