




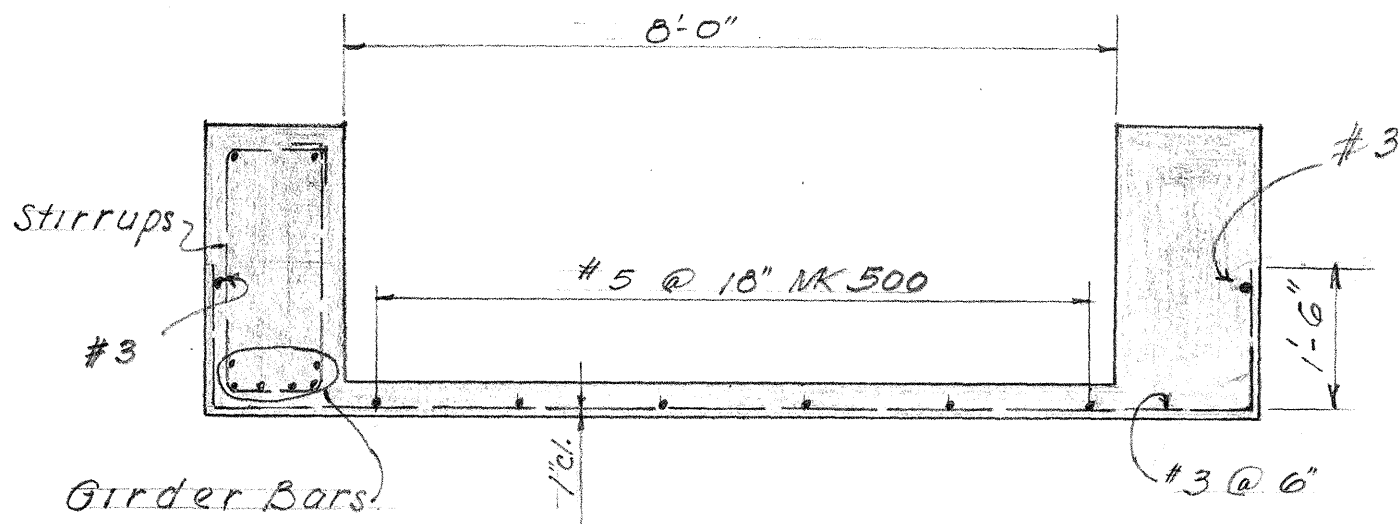

# REINFORCING DETAIL

## FLUME SECTION

Scale: 1/2" = 1'-0"

NOTE! #3 Bars Substituted For 72#/100#  
Wire Fabric.


FLUME OVER CROSSING

Sta. 128+00


HAWAII BELT ROAD

SDR 3(13)


Nov. 1951

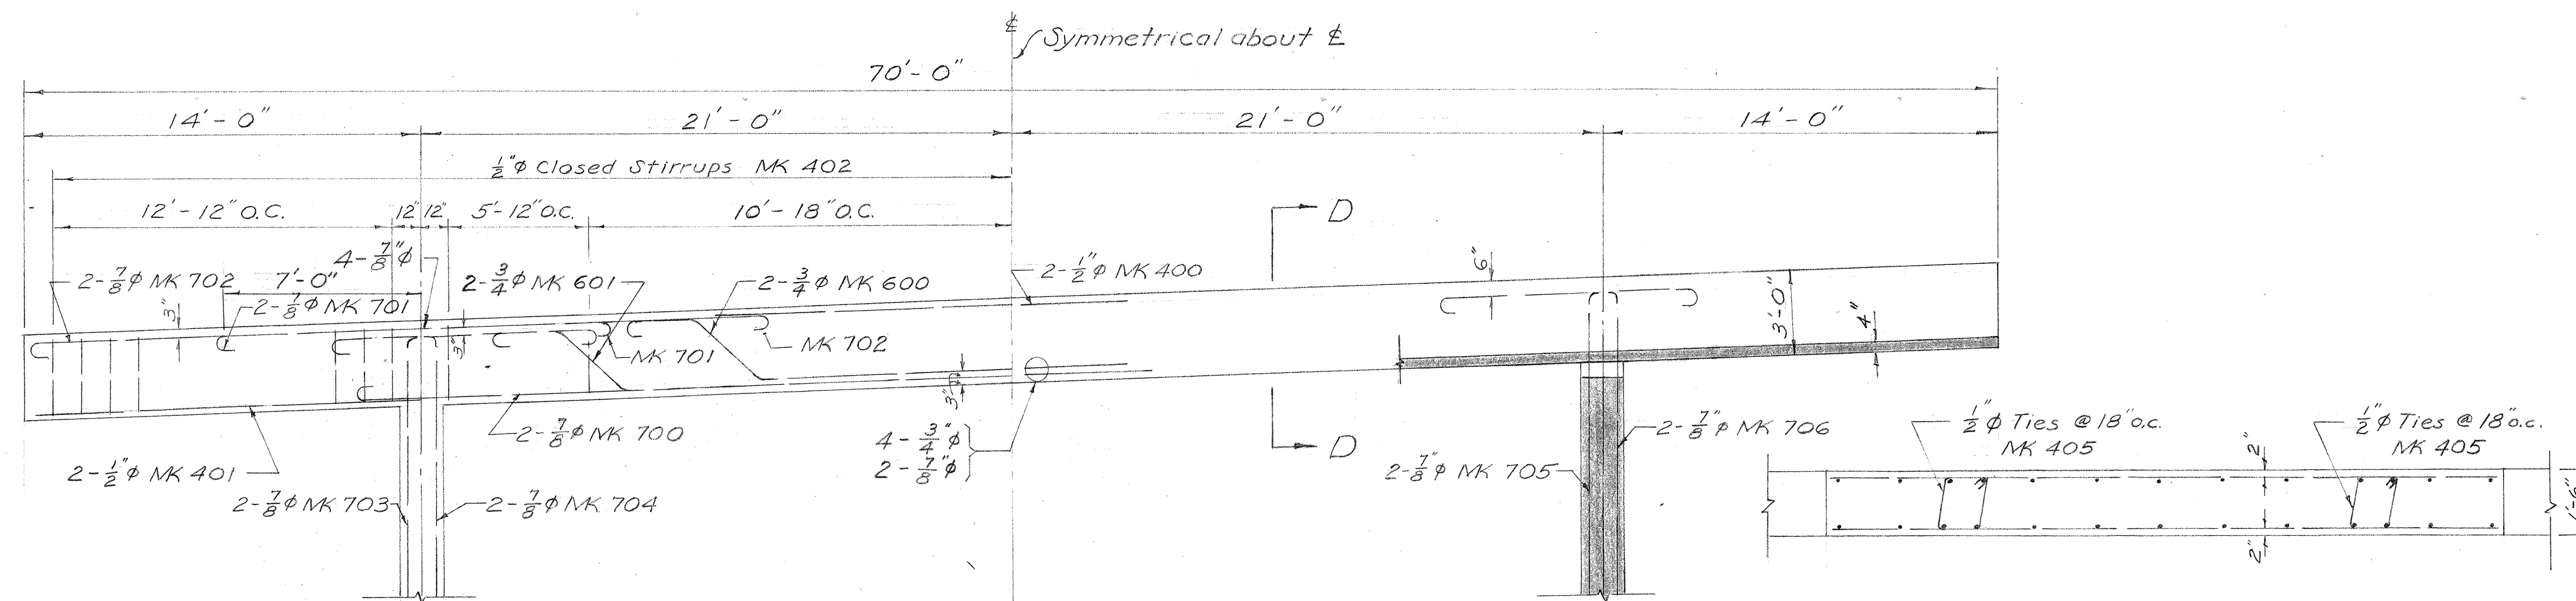

GIRDER REINFORCING

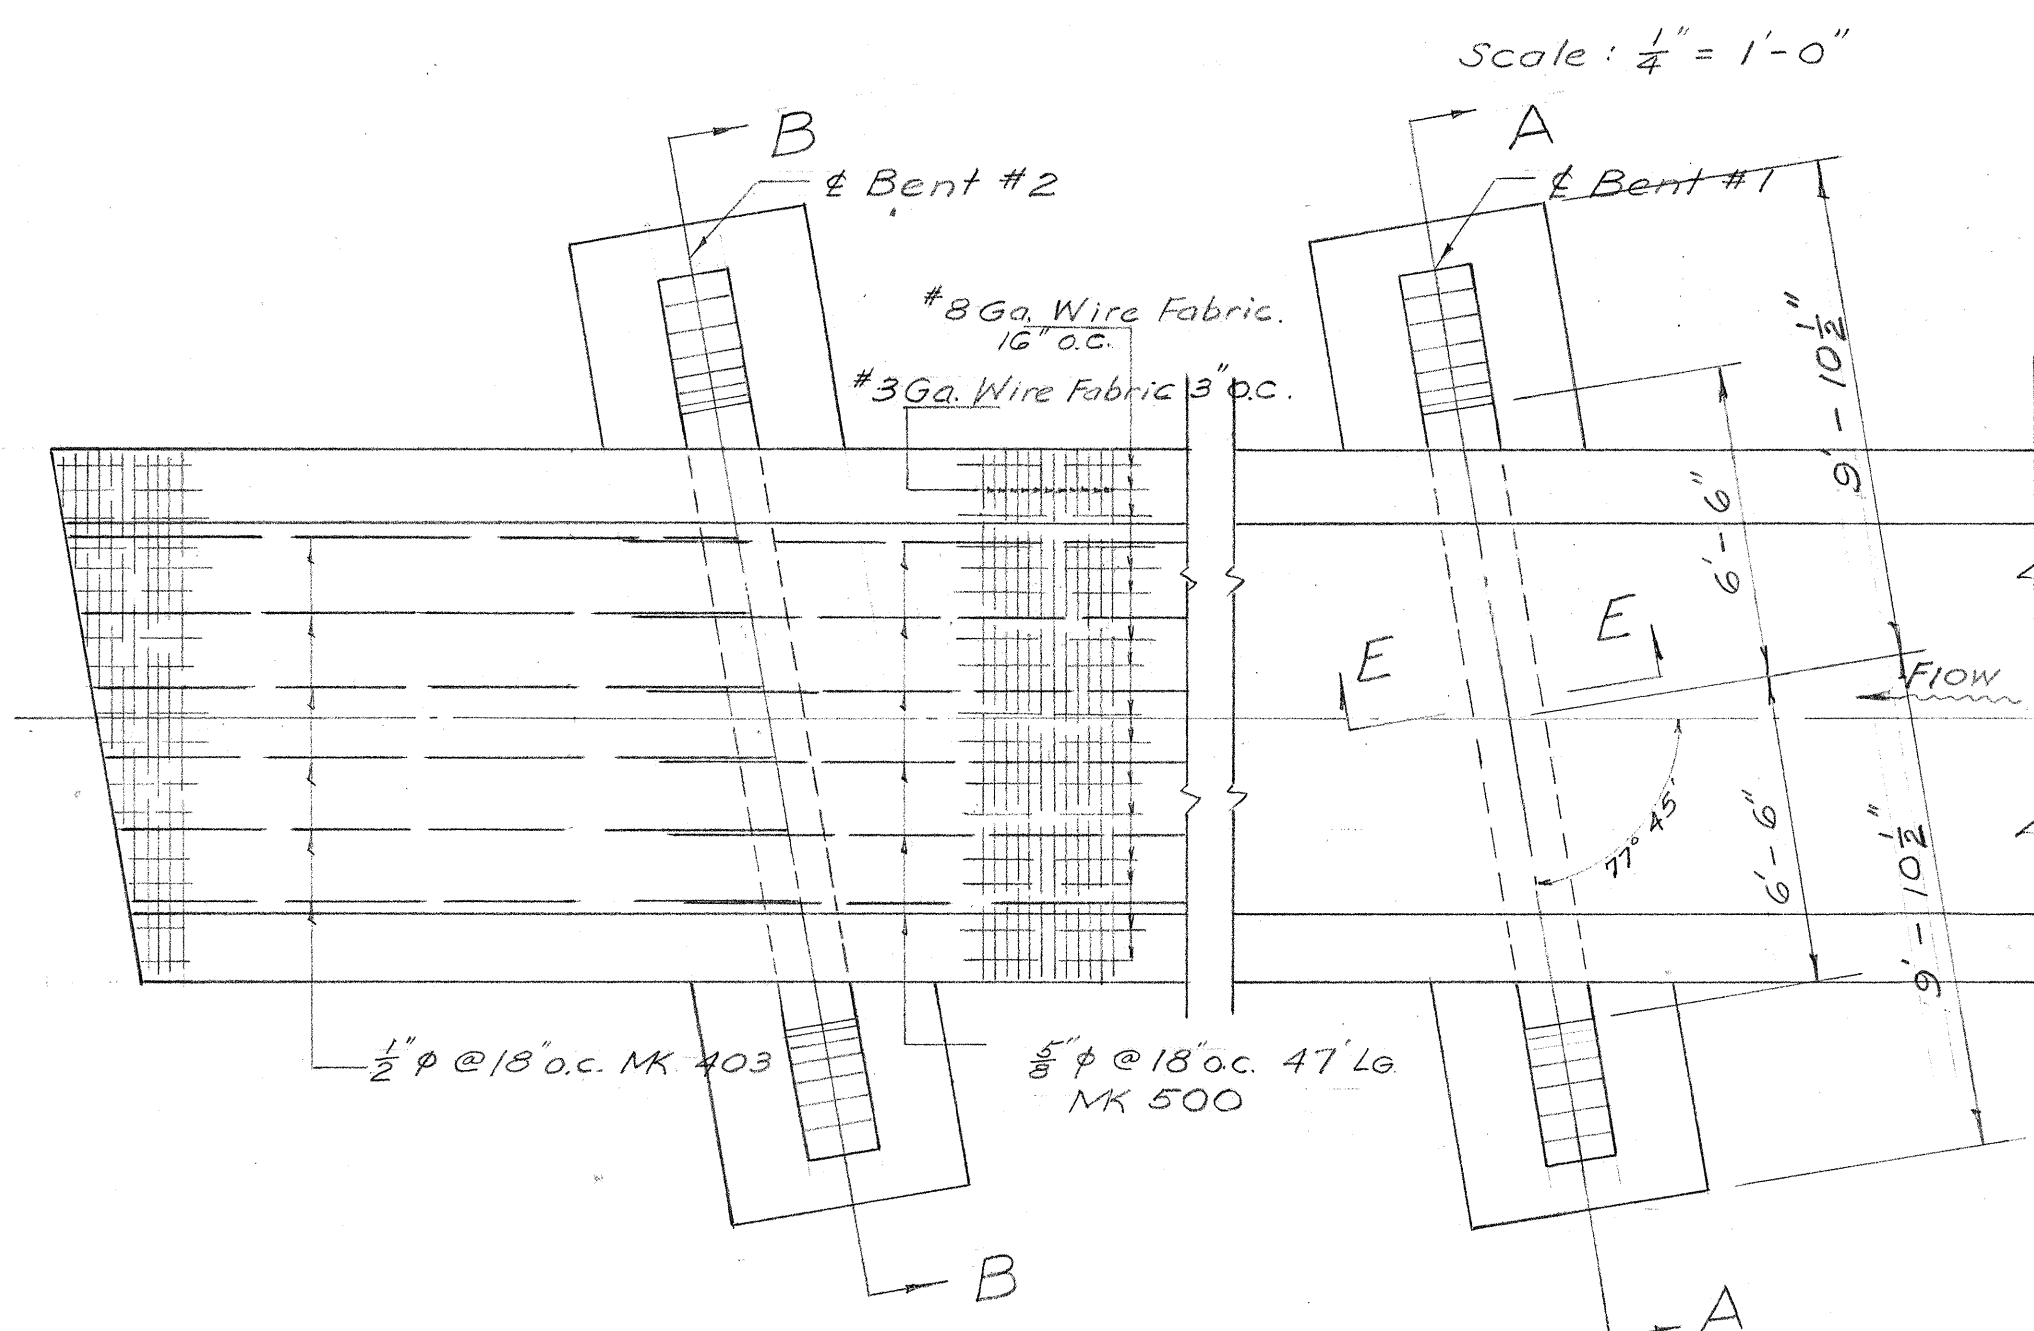


PLAN - SLAB REINFORCING


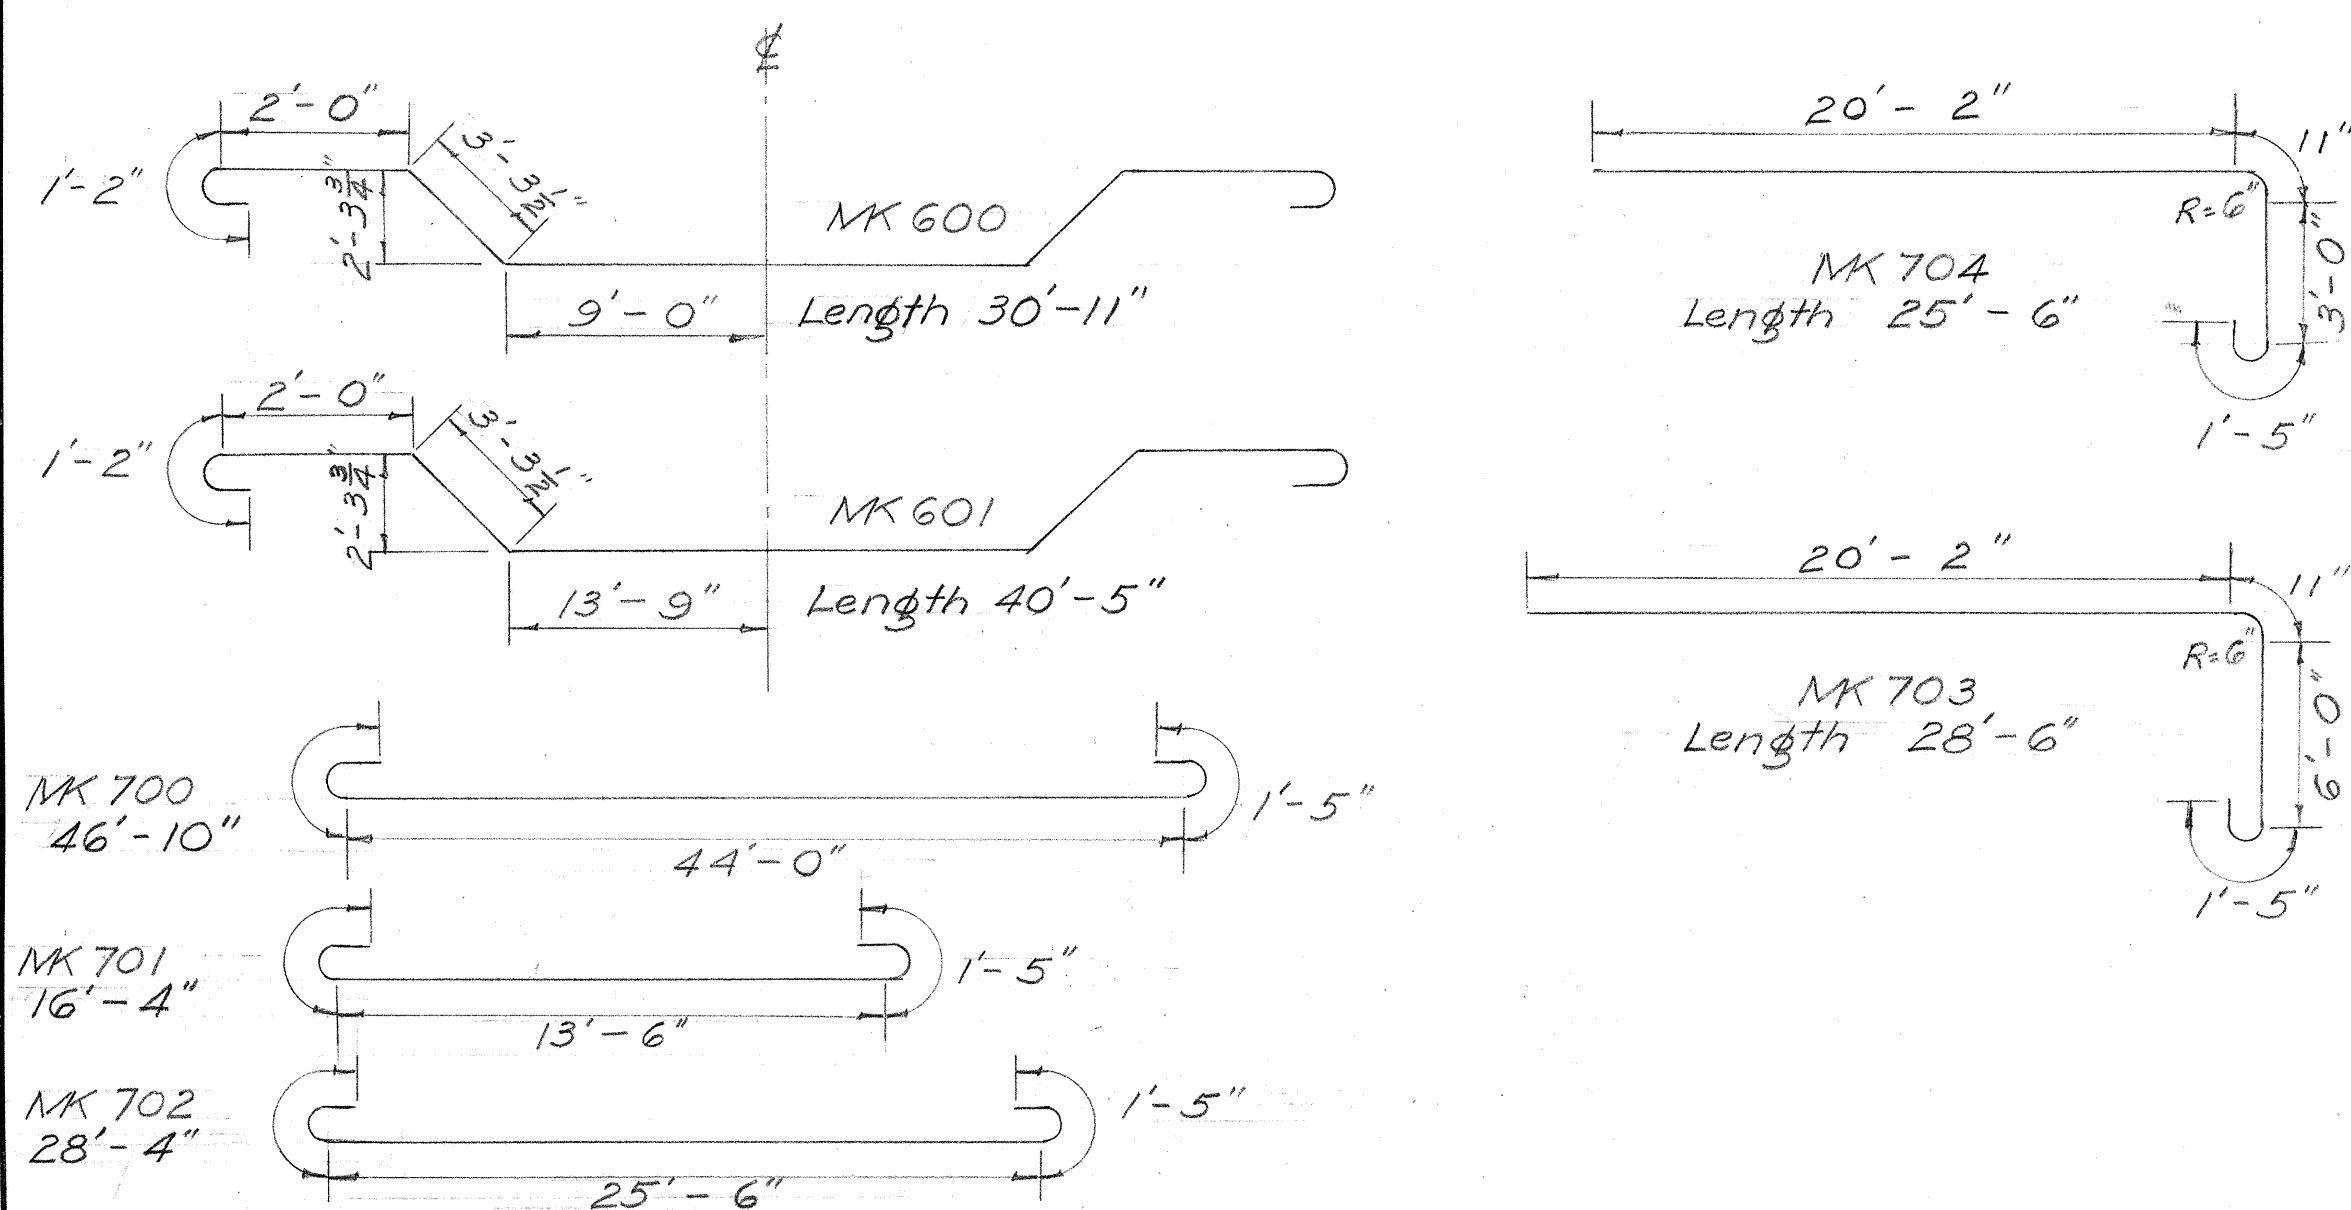


TYPICAL LAP OF WIRE FABRIC


SECTION G-G

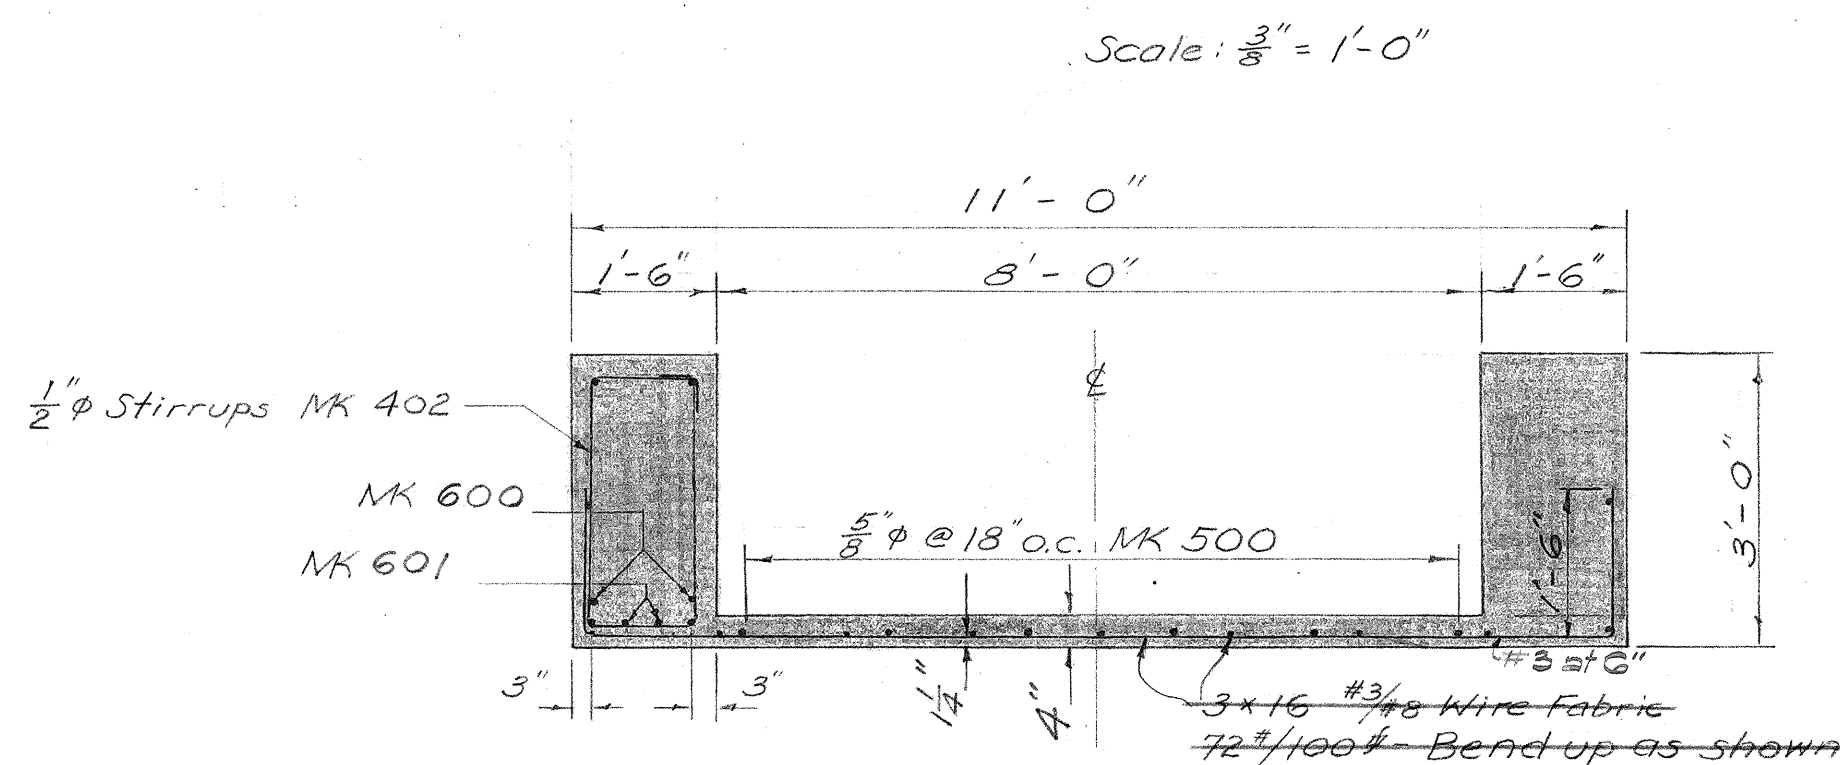


SECTION D-D

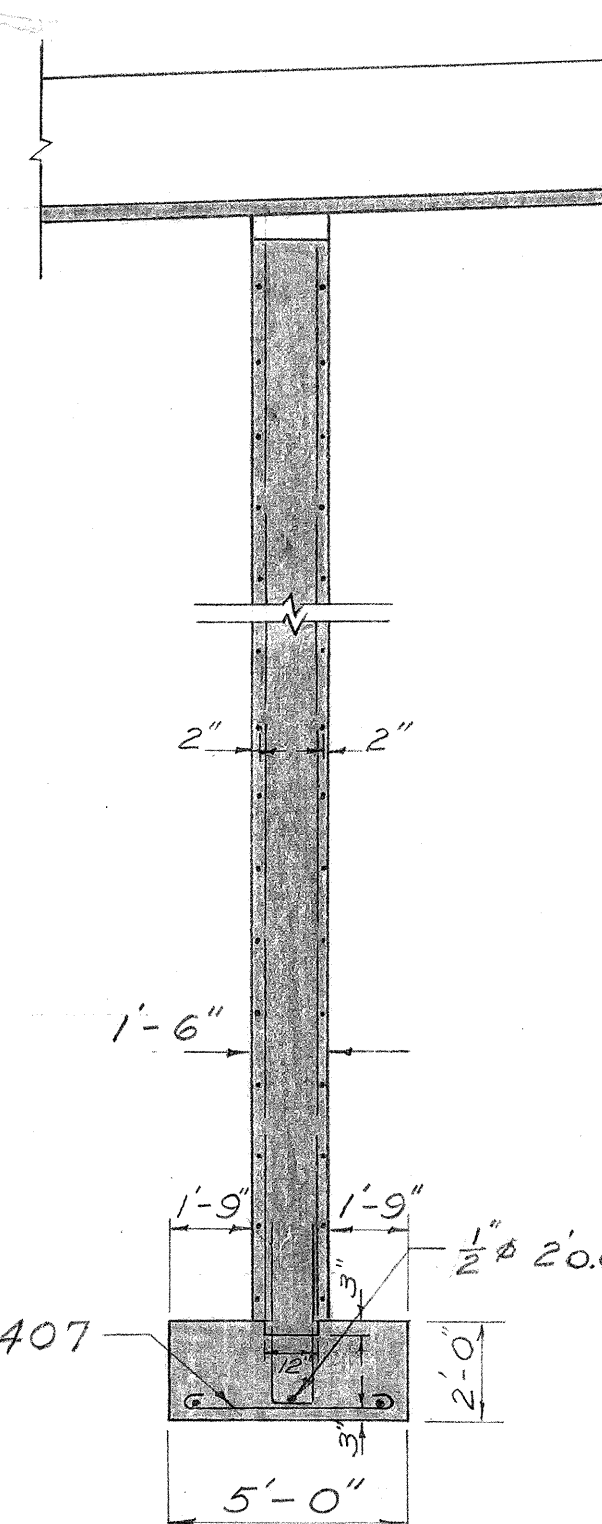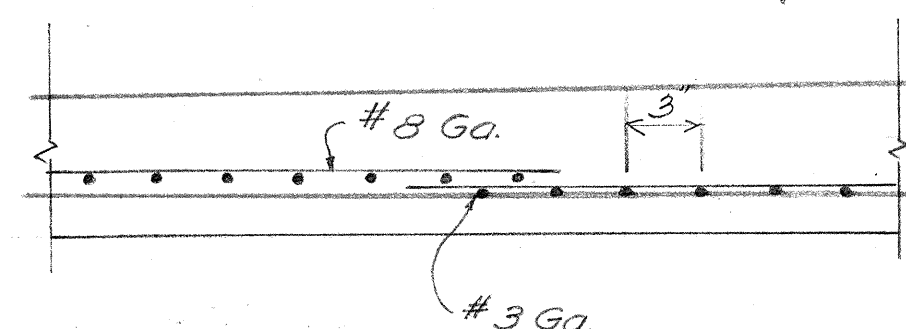

SECTION E-E

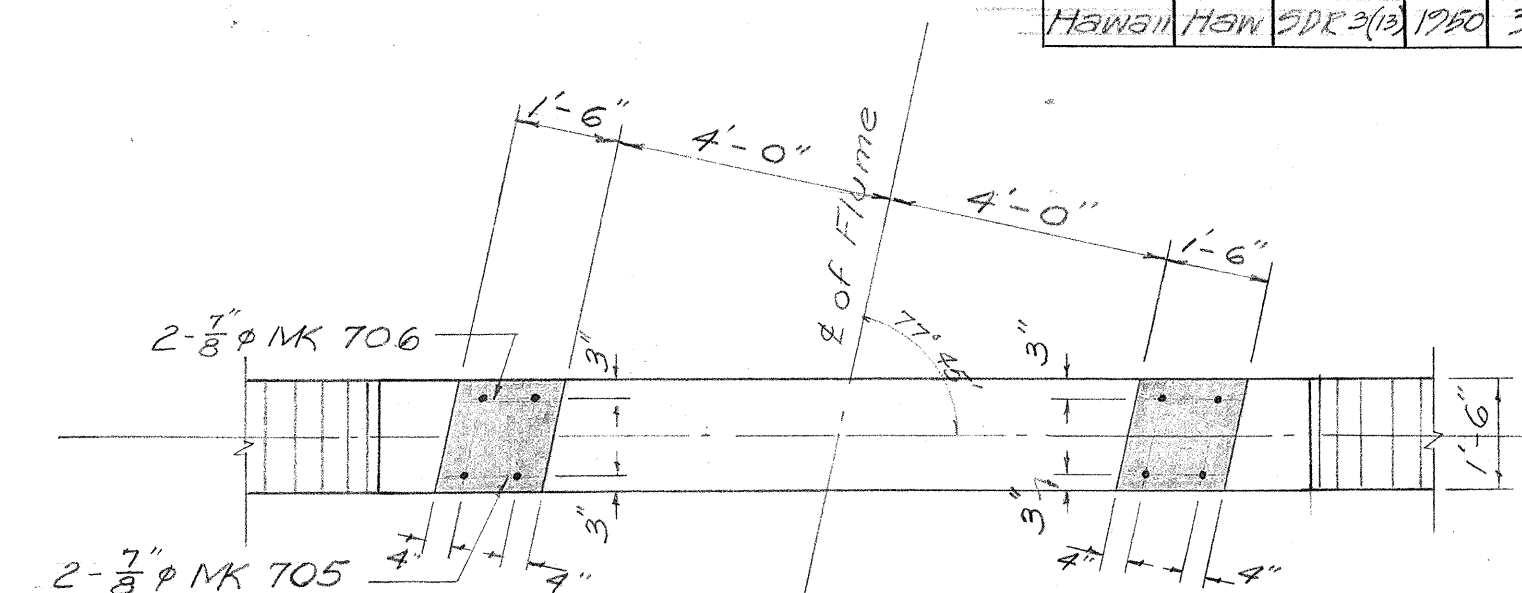

SECTION C-C

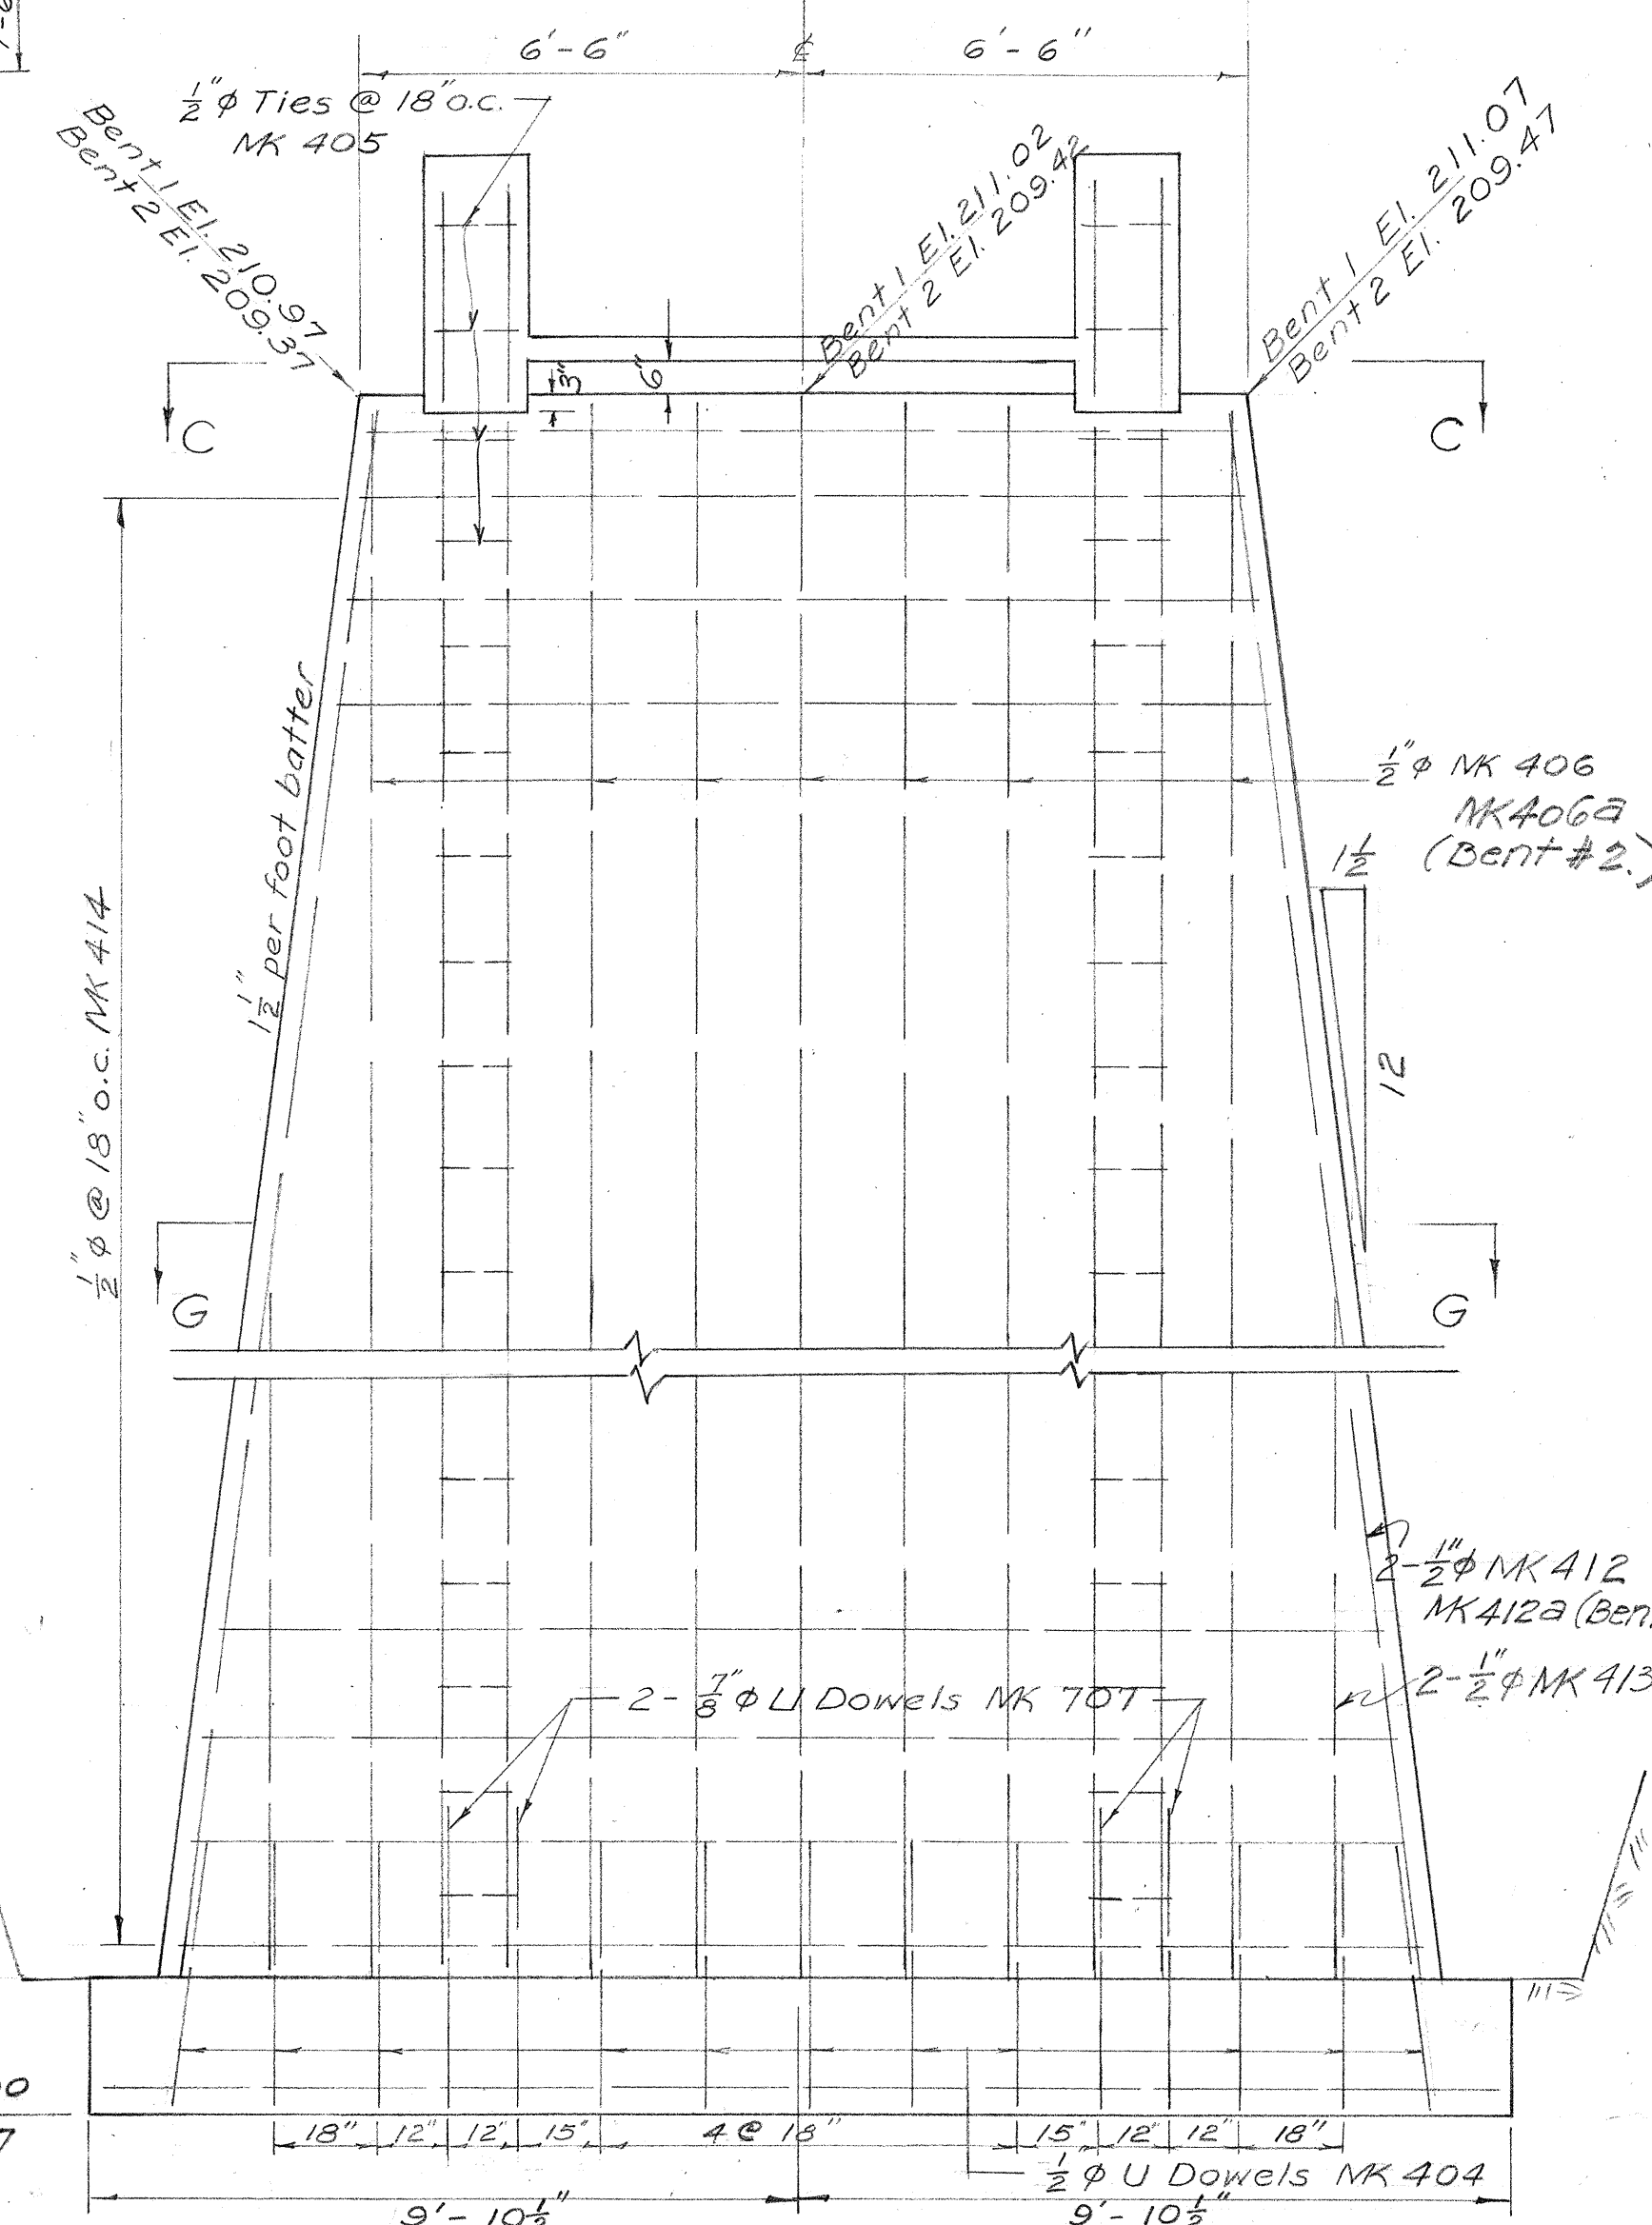

SECTION A-A BENT NO. 1  
SECTION B-B SIMILAR - EXCEPT AS NOTED

TERRITORIAL HIGHWAY DEPARTMENT  
TERRITORY OF HAWAII  
FLUME OVERCROSSING  
Sta. 123+00  
Hawaii Belt Road SDR 3(13)  
April 1950

SHEET No. 2 OF 3 SHEETS

5468.31

