

FED. ROAD DIST. NO.	STATE	FED. AID PROJ. NO.	FISCAL YEAR	SHEET NO.	TOTAL SHEETS
Hawaii	Haw	SDR 3(13)	1950	2	304


GENERAL NOTES ON PAVEMENT AND BASE COURSE

PAVEMENT- Pavement shall be Asphalt-Concrete Surface Course
2" compacted thickness- Use Mix III

BASE COURSE: Base Course shall be waterbound Macadam Base Course, of compacted thickness consisting of Mineral Aggregate (Coarse Rock Size No. 2 (2 1/2" - 3/4") and filler (1/2" #100).

SUB BASE: Sub Base shall be Select Material Sub Base 24" thick


All the above courses subject to Special Provisions & Specifications

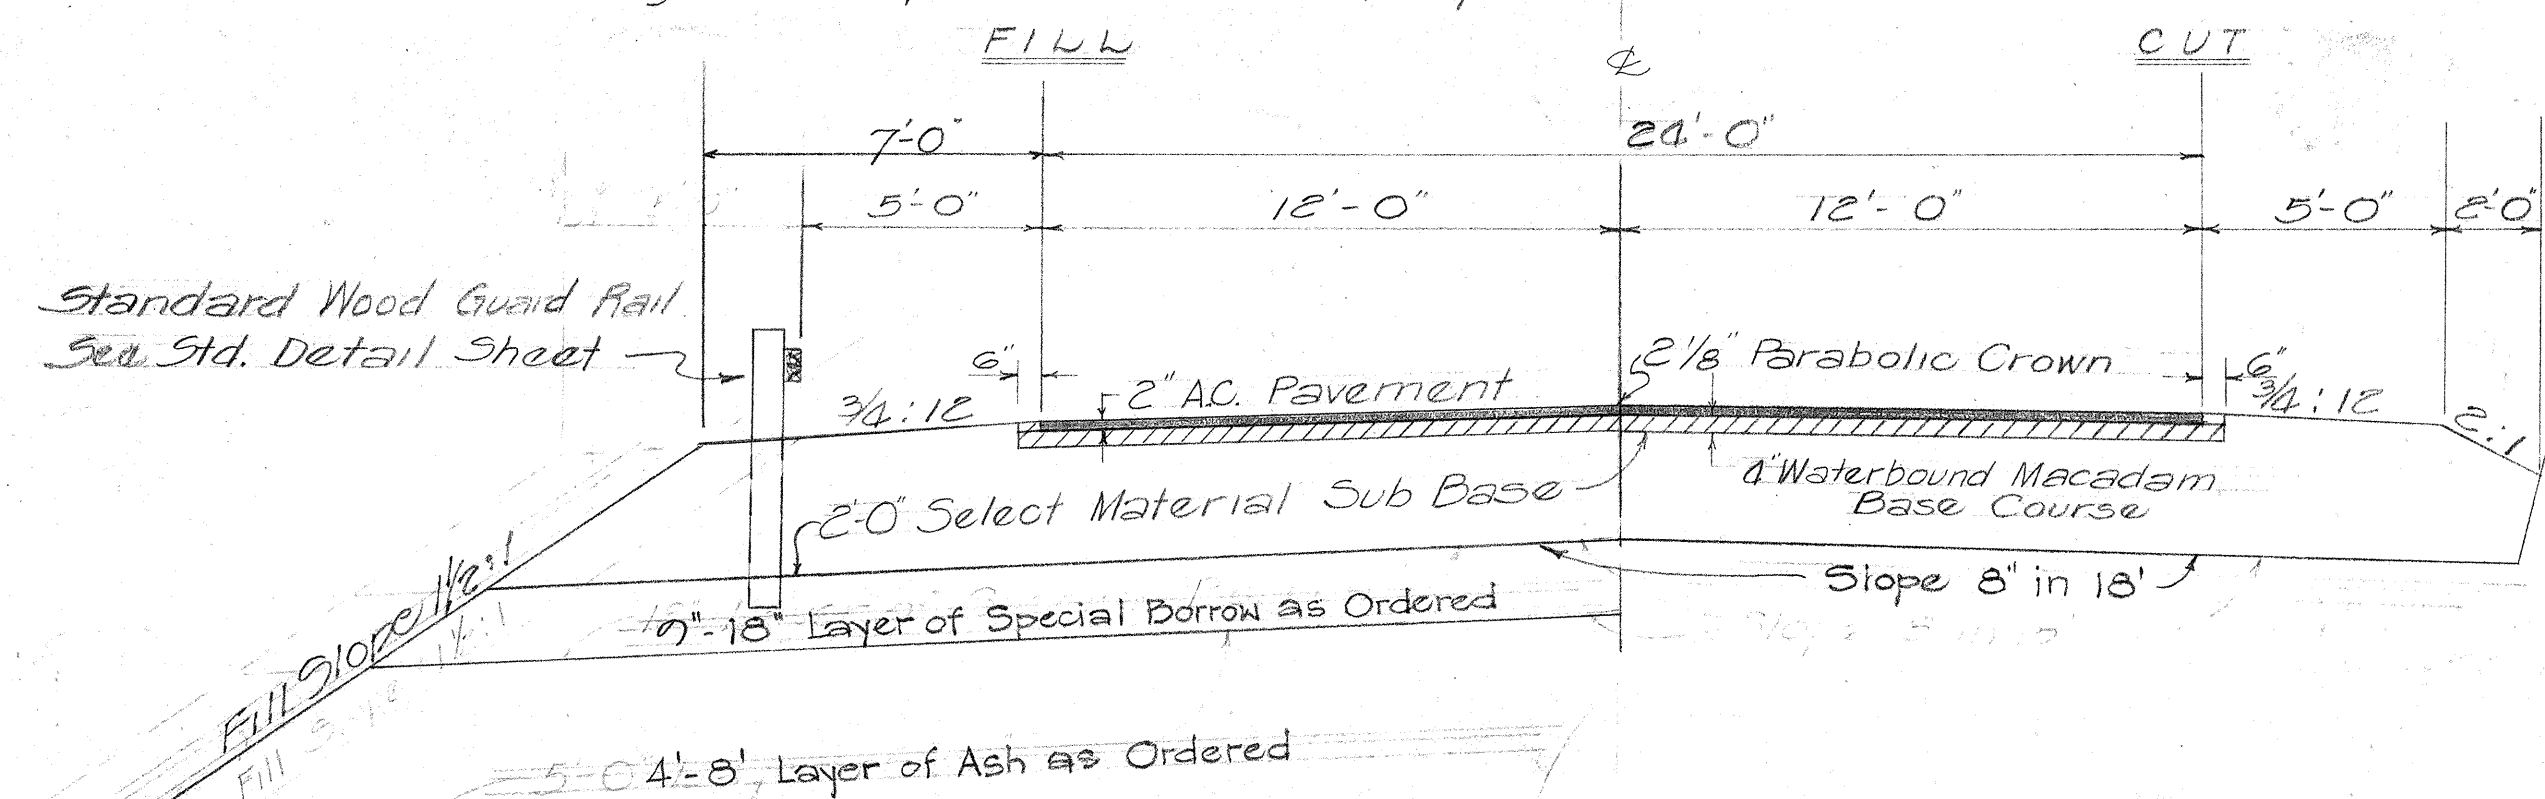

TYPICAL SECTION ON TANGENT
Scale: $\frac{1}{4}'' = 1'-0''$

NOTE:

Face of Guard Rail shall be a minimum of 5'-0" from edge of pavement.

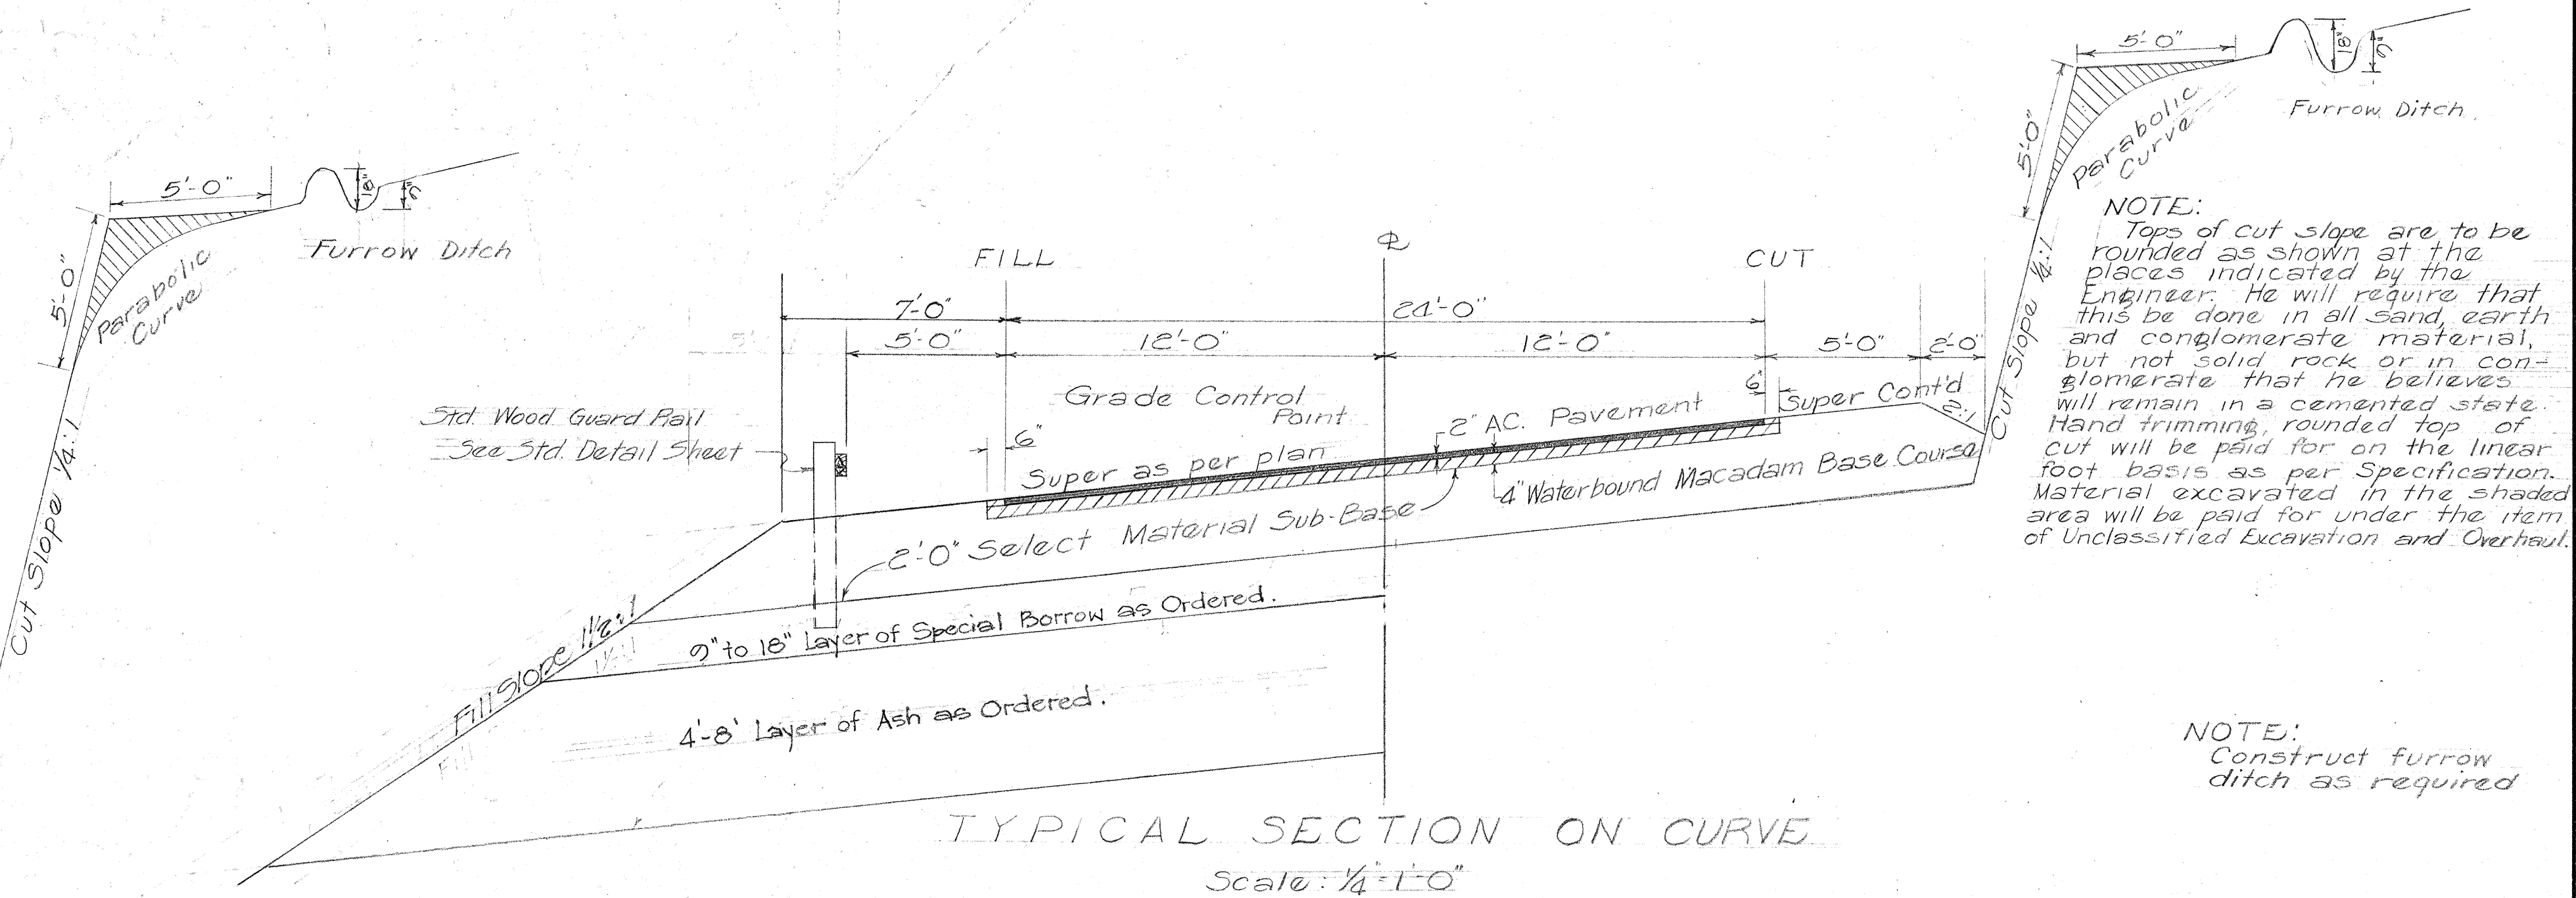


TYPICAL SECTION ON CURVE
Scale: 1/4" = 1'-0"


NOTE:
Construct furrow
ditch as required

NOTE:

When superelevation is less than 0.063' per ft, the slope of the shoulder on the lower side is 34:12 (min). When the super is greater than 0.063 per ft, the shoulder slope is equal to rate of super.

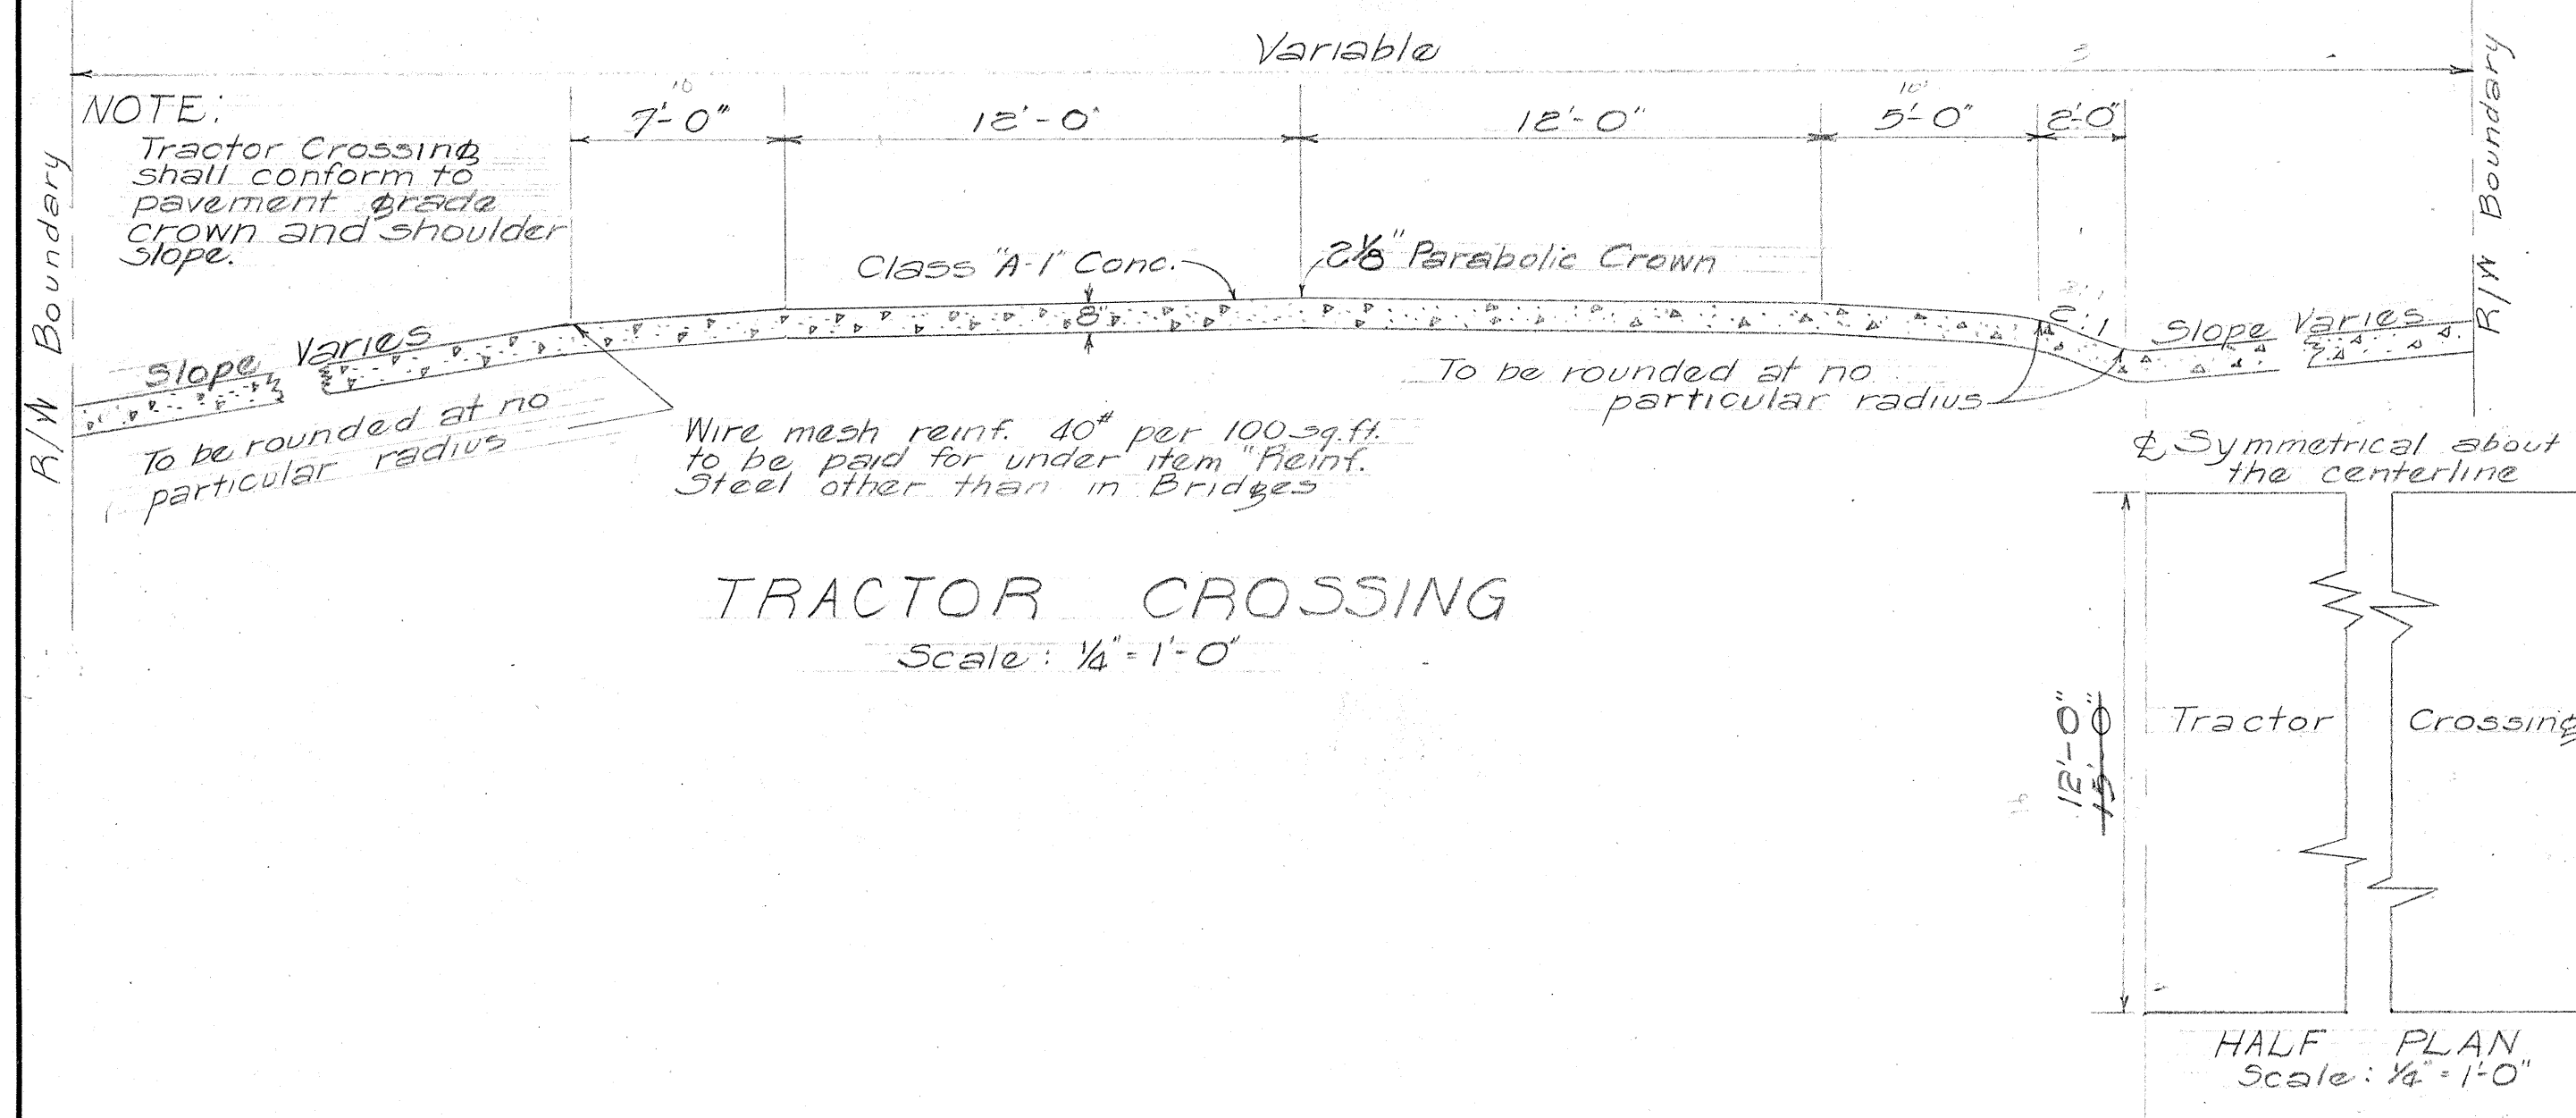

TRACTOR CROSSING
Scale: $\frac{1}{4}'' = 1'-0''$

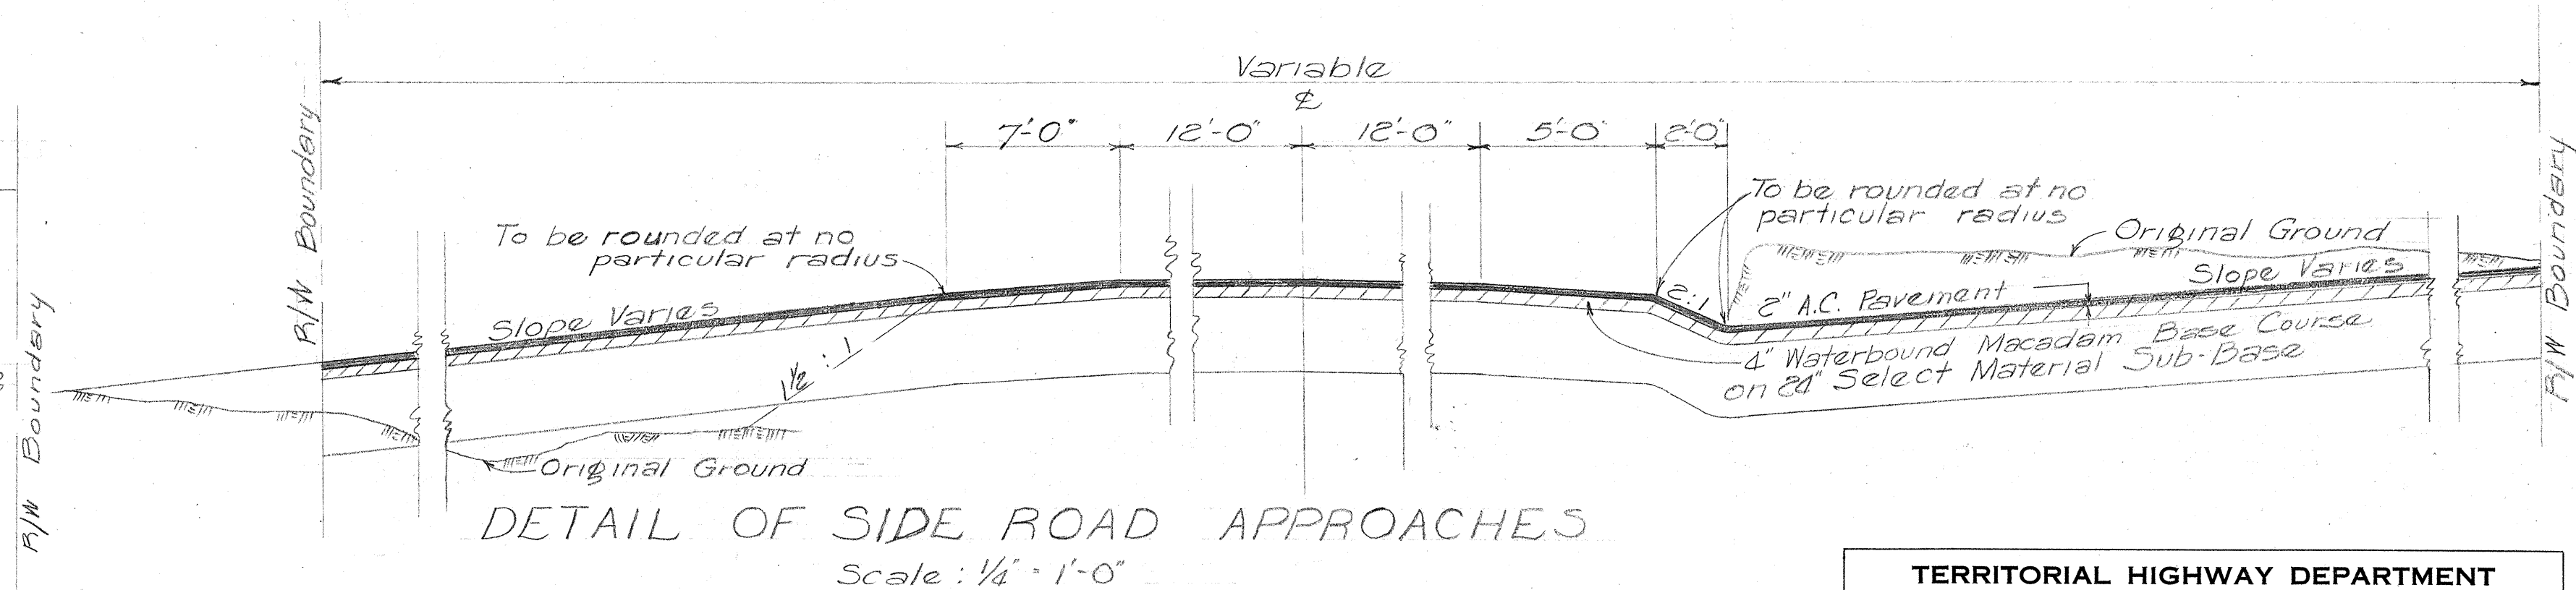

DETAIL OF SIDE ROAD APPROACHES
Scale: 1/4" = 1'-0"

TERRITORIAL HIGHWAY DEPARTMENT
TERRITORY OF HAWAII

TYPICAL SECTIONS

HAWAII BELT ROAD
PROJ. NO. SDR 3(13)

Scale as shown APRIL 1950

SHEET No. OF SHEETS

5468.2